



GB 2
 PEN TABLE = #plot72+lgser+mv80pp.tbl
 DATE OF PLOT = 07/13/99
 PLOT NO
 DESIGN FILE IS I:\440278\dgn\GENERAL.dgn

FILE NAME:
 SCALE:
 DATE: 2/3/99
 PLOT NAME:
 PROJECT NO: 440278.00
 LEVELS ON: 1, 2, 3, 48, 50, 51, 52, 53, 54, 55, 56, 57, 58, 59, 60, 61, 62.

ORIGINATOR: DJD

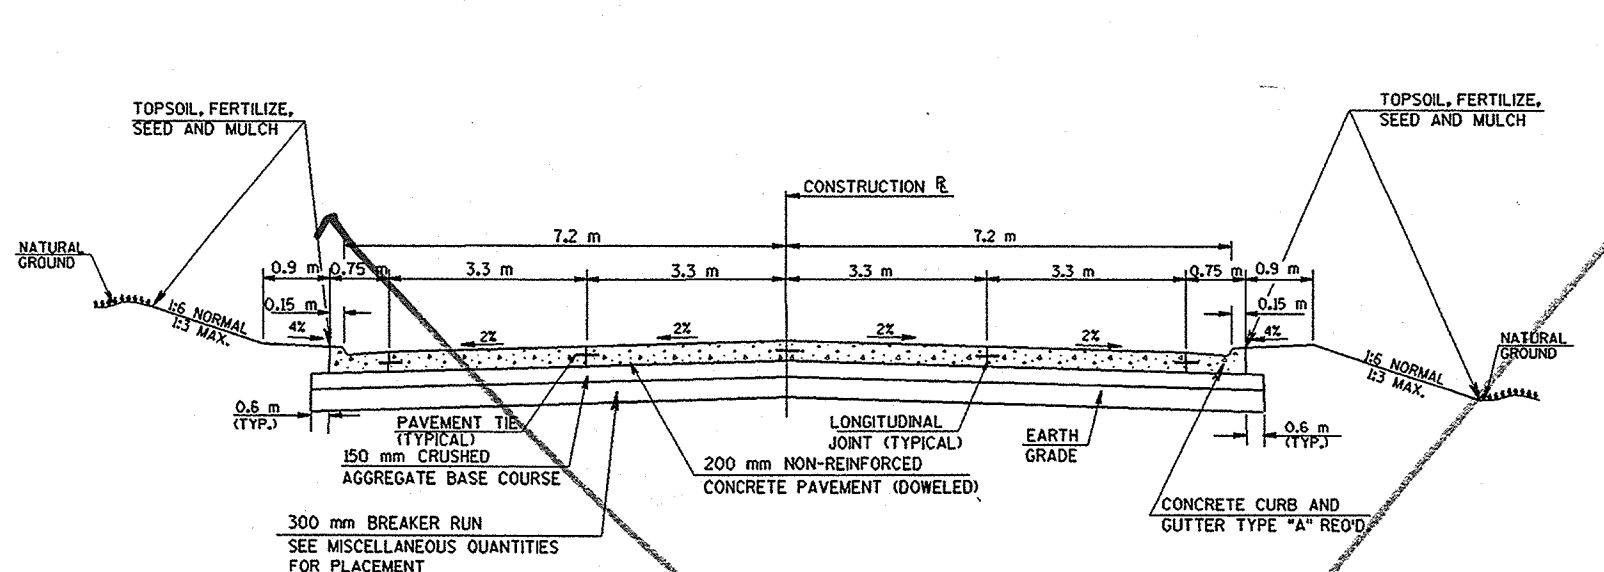

TYPICAL FINISHED CROSS SECTION FOR C.T.H. "A"
 STA 10+000 TO STA 13+331

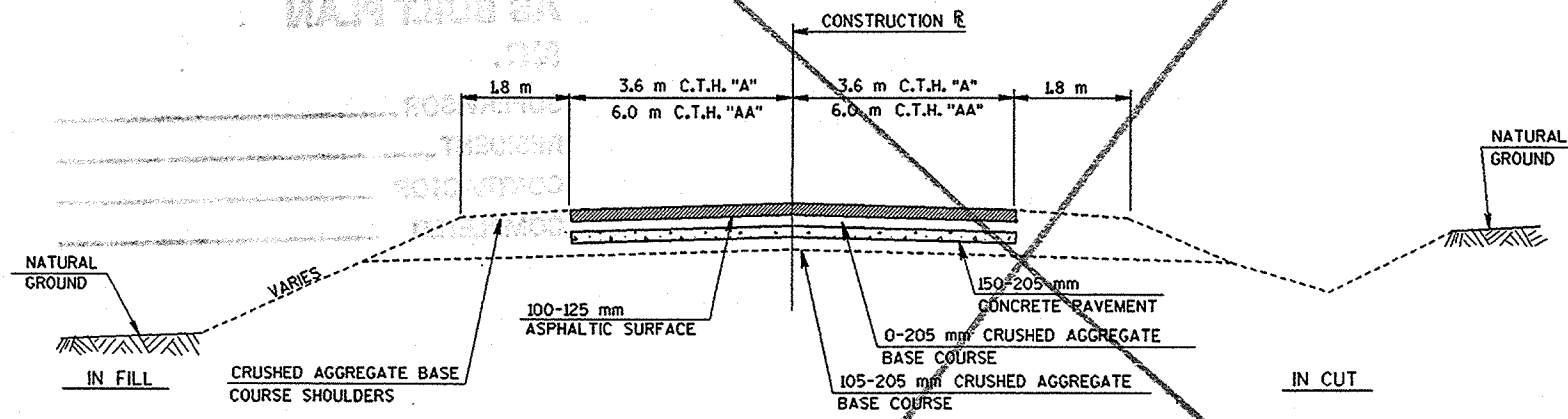

EXISTING TYPICAL FOR C.T.H. "A" AND C.T.H. "AA"

UTILITIES

AMERITECH
 221 WEST WASHINGTON STREET
 FOURTH FLOOR OSPE
 APPLETON, WISCONSIN 54911
 ATTENTION: JOE FEMLING

TIME WARNER CABLE
 1001 KENNEDY AVE.
 P.O. BOX 145
 KIMBERLY, WISCONSIN 54136-0145
 ATTENTION: STEVE POEHLIN

A.T. & T.
 W277 S4747 SAYLESVILLE ROAD.
 WAUKESHA, WISCONSIN 53188
 ATTENTION: TOM BOHTE

CITY OF OSHKOSH
 DEPARTMENT OF PUBLIC WORKS
 215 CHURCH AVENUE
 P.O. BOX 1130
 OSHKOSH, WISCONSIN 54902
 ATTENTION: MR. DAVID PATEK

WISCONSIN PUBLIC SERVICE CORPORATION
 (GAS AND ELECTRIC)
 700 NORTH ADAMS STREET
 P.O. BOX 19001
 GREEN BAY, WISCONSIN 54307-9001
 ATTENTION: STEVEN DeMERRITT

WISCONSIN CENTRAL LTD. RAILROAD
 1625 DEPOT STREET
 STEVENS POINT, WISCONSIN 54481
 ATTENTION: TERRY LEE

TELEPHONE 1-920-735-3250
 FAX 1-920-735-3073

NORLIGHT TELECOMMUNICATIONS INC.
 275 NORTH CORPORATE DRIVE
 BROOKFIELD, WI. 53045-5818
 ATTENTION: PAUL NEUMANN

TELEPHONE 1-920-831-9207

D.N.R. AREA LIAISON

DEPARTMENT OF NATURAL RESOURCES
 1125 N. MILITARY AVENUE
 P.O. BOX 10448
 GREEN BAY, WISCONSIN 54307
 ATTENTION: AL STRANZ

TELEPHONE 1-414-521-7730
 CELL 1-414-315-2023
 PAGER 1-414-318-5007

TELEPHONE 1-920-236-5065

TELEPHONE 1-920-433-1716

TELEPHONE 1-715-345-2503



CALL DIGGERS HOTLINE
 1-800-242-8511
 TOLL FREE
 TELEFAX (414) 259-0947
 TDD (FOR HEARING IMPAIRED) 1-800-542-2289
 WIS. STATUTE 182.0175 (1974)
 REQUIRES MIN. OF 3 WORK DAYS
 NOTICE BEFORE YOU EXCAVATE.

GENERAL NOTES

SILT FENCE DELIVERED SHALL MEET THE MATERIAL SPECIFICATIONS FOR SILTY SOILS.
 THE LOCATION OF EXISTING AND PROPOSED UTILITY FACILITIES AS SHOWN ON THE PLAN ARE APPROXIMATE.
 THERE MAY BE OTHER UTILITY FACILITIES WITHIN THE PROJECT AREA THAT ARE NOT SHOWN.
 INLET AND DISCHARGE ELEVATIONS FOR DRAINAGE STRUCTURES SHOWN ON THE PLAN SHEETS ARE APPROXIMATE AND SHALL BE DETERMINED BY THE ENGINEER IN THE FIELD.
 THE EXACT LOCATION AND LIMITS OF PRIVATE ENTRANCES SHALL BE DETERMINED BY THE ENGINEER IN THE FIELD.
 PROPERTY LINES AS SHOWN ARE APPROXIMATE.
 ALL DISTANCES ARE GROUND DISTANCES.
 CURVE DATA IS BASED ON RADIUS DEFINITION.
 NO TREES OR SHRUBS ARE TO BE REMOVED WITHOUT APPROVAL OF THE ENGINEER.
 WHEN THE QUANTITY OF THE ITEM OF BASE COURSE OR SURFACE COURSE IS MEASURED BY THE m OR Mg3, THE DEPTH OR THICKNESS AS SHOWN IS APPROXIMATE. THE ACTUAL THICKNESS WILL DEPEND ON THE DISTRIBUTION OF MATERIALS AS DIRECTED BY THE ENGINEER.
 THE REMOVAL OF ASPHALT DRIVEWAYS WILL BE PAID AS UNCLASSIFIED EXCAVATION.
 ALL TIES ON THIS PLAN ARE HORIZONTAL UNLESS DESCRIBED OTHERWISE.
 MEETING EXISTING PAVEMENT WITH NEW PAVEMENT SHALL BE PERFORMED WITH A BUTT JOINT. ALL BUTT JOINTS ARE TO BE SAW CUT.
 THE EXACT LOCATION AND WIDTH OF DRIVEWAYS SHALL BE DETERMINED BY THE ENGINEER IN THE FIELD.
 EXCAVATIONS BELOW SUBGRADE (E.B.S.) SHALL BE MEASURED AND PAID FOR AS UNCLASSIFIED EXCAVATION. THE EXACT LOCATION FOR E.B.S. IF REQUIRED, SHALL BE DETERMINED BY THE ENGINEER.
 CURB HEIGHTS AT THE END OF CURB AND GUTTER SHALL BE TAPER FROM 0 mm TO 150 mm IN 1.8 m UNLESS OTHERWISE NOTED.
 CONSTRUCTION PERMITS HAVE BEEN ACQUIRED FOR THE WORK TO BE PERFORMED OUTSIDE THE RIGHT-OF-WAY AND THESE RIGHTS HAVE BEEN EXTENDED TO THE CONTRACTOR. ALL RADIARE TO THE FACE OF CURB, UNLESS OTHERWISE NOTED.


RUNOFF COEFFICIENTS

NEW PAVEMENT	0.90	EXISTING PAVEMENT	0.80
NEW SLOPES	0.27	EXISTING SLOPES	0.27
TOTAL PROJECT AREA 7.4 HECTARES		TOTAL DISTURBED AREA 6.6 HECTARES	

METRIC STANDARD DETAIL DRAWINGS

- 8A5-15a,b,d
- 8B6-3
- 8B7-3
- 8C1-5
- 8D1-12
- 8E9-5
- 8F1-11
- 8F4-5
- 8F10-1
- 9A1-11a
- 9A1-11b
- 9B2-6
- 13B1-4
- 13C1-10
- 13C3-3
- 15C2-3
- 15C8-8a
- 15C8-8b
- 15C8-8e
- 15C9-3
- 15C11-5
- 15D6-2
- INLET COVERS
- MANHOLES, TYPE 1
- MANHOLES, TYPE 2 AND 3
- INLETS, TYPE 1, 2, 3, AND 4
- CONCRETE CURB, CONCRETE CURB AND GUTTER AND PAVEMENT TIES
- SILT FENCE
- APRON ENDWALLS FOR CULVERT PIPE
- JOINT TIES FOR CONCRETE PIPE
- CONCRETE MASONRY ENDWALLS FOR CULVERT PIPE AND PIPE ARCH
- AT-GRADE SIDE ROAD INTERSECTIONS, TYPES "B1", "B2", "C" AND "D" AND TEE INTERSECTION BYPASS LANE
- AT-GRADE SIDE ROAD INTERSECTIONS, TYPE "A"
- CONDUIT
- PAVEMENT DETAILS FOR RAILROAD APPROACH
- CONCRETE PAVEMENT LONGITUDINAL JOINTS AND PAVEMENT TIES
- URBAN DOWELED CONCRETE PAVEMENT
- BARRICADES AND SIGNS FOR ROAD CLOSURES
- PAVEMENT MARKING (MAINLINE)
- PAVEMENT MARKING (INTERSECTIONS)
- PAVEMENT MARKINGS (ISLANDS, STOPLINES, AND CROSSWALKS)
- PAVEMENT MARKING DETAILS FOR RAILROAD-HIGHWAY GRADE CROSSINGS
- FLEXIBLE TUBULAR MARKER POSTS, ANCHORS, AND BASES
- TRAFFIC CONTROL, TWO LANE TWO WAY OPERATION


WISDOT: MSHT42

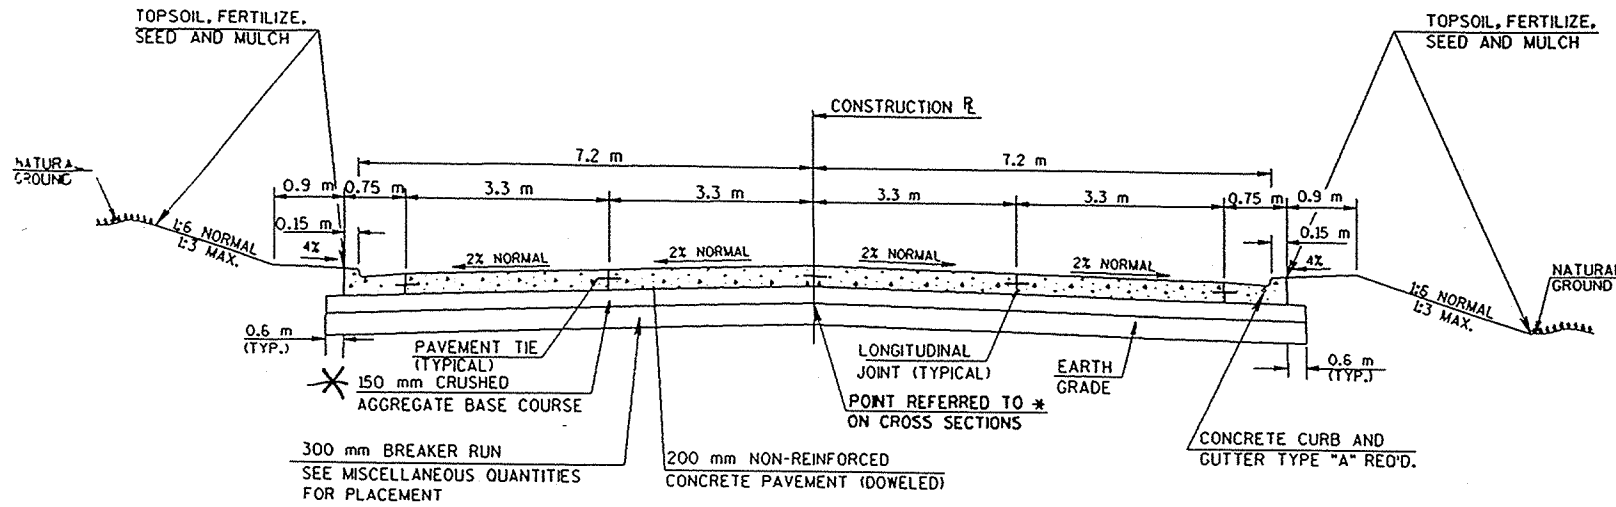

* STA. 10+000 - STA. 11+560
Typical section changed
from 150mm CABC to
300mm CABC.

TYPICAL FINISHED CROSS SECTION FOR C.T.H. "A"
STA 10+000 TO STA 13+331

* STA. 11+560 - STA. 13+326
TYPICAL SECTION CHANGED
FROM 150MM CABC TO
250MM CABC.

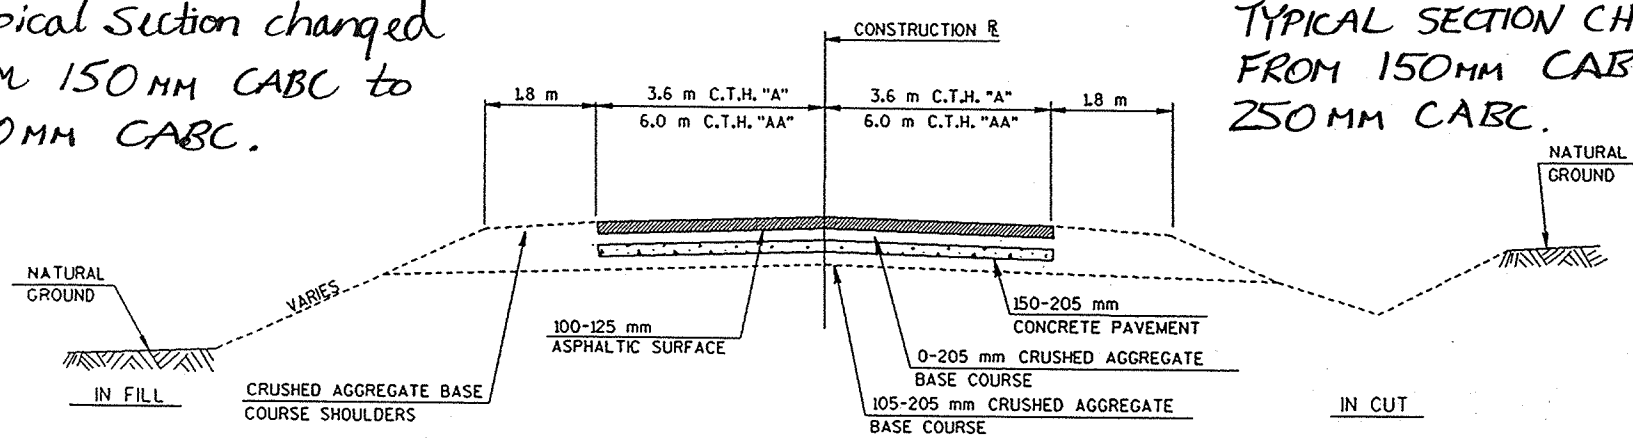

EXISTING TYPICAL FOR C.T.H. "A" AND C.T.H. "AA"

GENERAL NOTES

SILT FENCE DELIVERED SHALL MEET THE MATERIAL SPECIFICATIONS FOR SILTY SOILS.

THE LOCATION OF EXISTING AND PROPOSED UTILITY FACILITIES AS SHOWN ON THE PLAN ARE APPROXIMATE. THERE MAY BE OTHER UTILITY FACILITIES WITHIN THE PROJECT AREA THAT ARE NOT SHOWN.

INLET AND DISCHARGE ELEVATIONS FOR DRAINAGE STRUCTURES SHOWN ON THE PLAN SHEETS ARE APPROXIMATE AND SHALL BE DETERMINED BY THE ENGINEER IN THE FIELD.

THE EXACT LOCATION AND LIMITS OF PRIVATE ENTRANCES SHALL BE DETERMINED BY THE ENGINEER IN THE FIELD. PROPERTY LINES AS SHOWN ARE APPROXIMATE.

ALL DISTANCES ARE GROUND DISTANCES.

CURVE DATA IS BASED ON RADIUS DEFINITION.

NO TREES OR SHRUBS ARE TO BE REMOVED WITHOUT APPROVAL OF THE ENGINEER.

WHEN THE QUANTITY OF THE ITEM OF BASE COURSE OR SURFACE COURSE IS MEASURED BY THE m OR Mg, THE DEPTH OR THICKNESS AS SHOWN IS APPROXIMATE. THE ACTUAL THICKNESS WILL DEPEND ON THE DISTRIBUTION OF MATERIALS AS DIRECTED BY THE ENGINEER.

THE REMOVAL OF ASPHALT DRIVEWAYS WILL BE PAID AS UNCLASSIFIED EXCAVATION.

ALL TIES ON THIS PLAN ARE HORIZONTAL UNLESS DESCRIBED OTHERWISE.

MEETING EXISTING PAVEMENT WITH NEW PAVEMENT SHALL BE PERFORMED WITH A BUTT JOINT. ALL BUTT JOINTS ARE TO BE SAW CUT.

THE EXACT LOCATION AND WIDTH OF DRIVEWAYS SHALL BE DETERMINED BY THE ENGINEER IN THE FIELD.

EXCAVATIONS BELOW SUBGRADE (E.B.S.) SHALL BE MEASURED AND PAID FOR AS UNCLASSIFIED EXCAVATION. THE EXACT LOCATION FOR E.B.S. IF REQUIRED, SHALL BE DETERMINED BY THE ENGINEER.

CURB HEIGHTS AT THE END OF CURB AND GUTTER SHALL BE TAPER FROM 0 mm TO 150 mm IN 1.8 m UNLESS OTHERWISE NOTED.

CONSTRUCTION PERMITS HAVE BEEN ACQUIRED FOR THE WORK TO BE PERFORMED OUTSIDE THE RIGHT-OF-WAY AND THESE RIGHTS HAVE BEEN EXTENDED TO THE CONTRACTOR.

ALL RADII ARE TO THE FACE OF CURB, UNLESS OTHERWISE NOTED.

THE ELEVATION NOTED ON THE CROSS SECTIONS, IS THE SUBGRADE ELEVATION AT THE BOTTOM OF THE BASE COURSE, BUT ABOVE THE BREAKER RUN.

* MARSH EXCAVATION LIMITS SHALL BE DETERMINED BY THE ENGINEER IN THE FIELD.

* MARSH EXCAVATION CAN BE USED AS FILL ACCORDING TO THE TYPICAL MARSH EXCAVATION DETAIL.

RUNOFF COEFFICIENTS

NEW PAVEMENT	0.90	EXISTING PAVEMENT	0.80
NEW SLOPES	0.27	EXISTING SLOPES	0.27
TOTAL PROJECT AREA 7.4 HECTARES		TOTAL DISTURBED AREA 6.6 HECTARES	

METRIC STANDARD DETAIL DRAWINGS

- 8A5-15a,b,d
 - 8B6-3
 - 8B7-3
 - 8C1-5
 - 8D1-13
 - 8E9-4
 - 8F1-11
 - 8F4-5
 - 8F10-1
 - 9A1-11a
 - 9A1-11b
 - 9B2-6
 - 9B4-3
 - 13B1-4
 - 13C1-10
 - 13C13-3
 - 15C2-3
 - 15C8-8a
 - 15C8-8b
 - 15C8-8d
 - 15C8-8e
 - 15C9-3
 - 15C11-5
 - 15D6-2
 - 11B1-1
- INLET COVERS
 - MANHOLES, TYPE 1
 - MANHOLES, TYPE 2 AND 3
 - INLETS, TYPE 1, 2, 3, AND 4
 - CONCRETE CURB, CONCRETE CURB AND GUTTER AND PAVEMENT TIES
 - SILT FENCE
 - APRON ENDWALLS FOR CULVERT PIPE
 - JOINT TIES FOR CONCRETE PIPE
 - CONCRETE MASONRY ENDWALLS FOR CULVERT PIPE AND PIPE ARCH
 - AT-GRADE SIDE ROAD INTERSECTIONS, TYPES "B1", "B2", "C" AND "D"
 - AND TEE INTERSECTION BYPASS LANE
 - AT-GRADE SIDE ROAD INTERSECTIONS, TYPE "A"
 - CONDUIT
 - PULL BOX
 - PAVEMENT DETAILS FOR RAILROAD APPROACH
 - CONCRETE PAVEMENT LONGITUDINAL JOINTS AND PAVEMENT TIES
 - URBAN DOWELED CONCRETE PAVEMENT
 - BARRICADES AND SIGNS FOR ROAD CLOSURES
 - PAVEMENT MARKING (MAINLINE)
 - PAVEMENT MARKING (INTERSECTIONS)
 - PAVEMENT MARKING (LEFT TURN LANE)
 - PAVEMENT MARKINGS (ISLANDS, STOPLINES, AND CROSSWALKS)
 - PAVEMENT MARKING DETAILS FOR RAILROAD-HIGHWAY GRADE CROSSINGS
 - FLEXIBLE TUBULAR MARKER POSTS, ANCHORS, AND BASES
 - TRAFFIC CONTROL, TWO LANE TWO WAY OPERATION
 - CONCRETE CORRUGATED MEDIAN

UTILITIES

- AMERITECH
221 WEST WASHINGTON STREET
FOURTH FLOOR OSPE
APPLETON, WISCONSIN 54911
ATTENTION: JOE FEMLING
TELEPHONE 1-920-735-3250
FAX 1-920-735-3073
- NORLIGHT TELECOMMUNICATIONS INC.
275 NORTH CORPORATE DRIVE
BROOKFIELD, WI. 53045-5818
ATTENTION: PAUL NEUMANN
TELEPHONE 1-414-792-7932
- TIME WARNER CABLE
1001 KENNEDY AVE.
P.O. BOX 145
KIMBERLY, WISCONSIN 54136-0145
ATTENTION: STEVE POEHLIN
TELEPHONE 1-920-831-9207
- A.T. & T.
W277 54747 SAYLESVILLE ROAD.
WAUKESHA, WISCONSIN 53188
ATTENTION: TOM BOHTE
TELEPHONE 1-414-521-7730
CELL 1-414-315-2023
PAGER 1-414-318-5007
- CITY OF OSHKOSH
DEPARTMENT OF PUBLIC WORKS
215 CHURCH AVENUE
P.O. BOX 1130
OSHKOSH, WISCONSIN 54902
ATTENTION: MR. DAVID PATEK
TELEPHONE 1-920-236-5065
- WISCONSIN PUBLIC SERVICE CORPORATION
(GAS AND ELECTRIC)
700 NORTH ADAMS STREET
P.O. BOX 19001
GREEN BAY, WISCONSIN 54307-9001
ATTENTION: MIKE CERKAS *
TELEPHONE 1-920-433-4942*
- WISCONSIN CENTRAL LTD. RAILROAD
1625 DEPOT STREET
STEVENS POINT, WISCONSIN 54481
ATTENTION: TERRY LEE
TELEPHONE 1-715-345-2503
- DEPARTMENT OF NATURAL RESOURCES
1125 N. MILITARY AVENUE
P.O. BOX 10448
GREEN BAY, WISCONSIN 54307
ATTENTION: AL STRANZ
TELEPHONE 1-920-492-5800
- D.N.R. AREA LIAISON





CALL DIGGERS HOTLINE
1-800-242-8511
TOLL FREE
TELEFAX (414) 259-0947
TDD (FOR HEARING IMPAIRED) 1-800-542-2289
WIS. STATUTE 182.0175 (1974)
REQUIRES MIN. OF 3 WORK DAYS
NOTICE BEFORE YOU EXCAVATE.

ORIGINATOR: DJD
 PROJECT NO: 440278-00
 DATE: 2/3/99
 PLOT NAME:
 SCALE:
 LEVELS ON: 1, 2, 3, 99, 100
 DESIGN FILE IS: 1-440278-00-GENERAL.Dgn

REVISED SHEET

*-ADDED NOTES

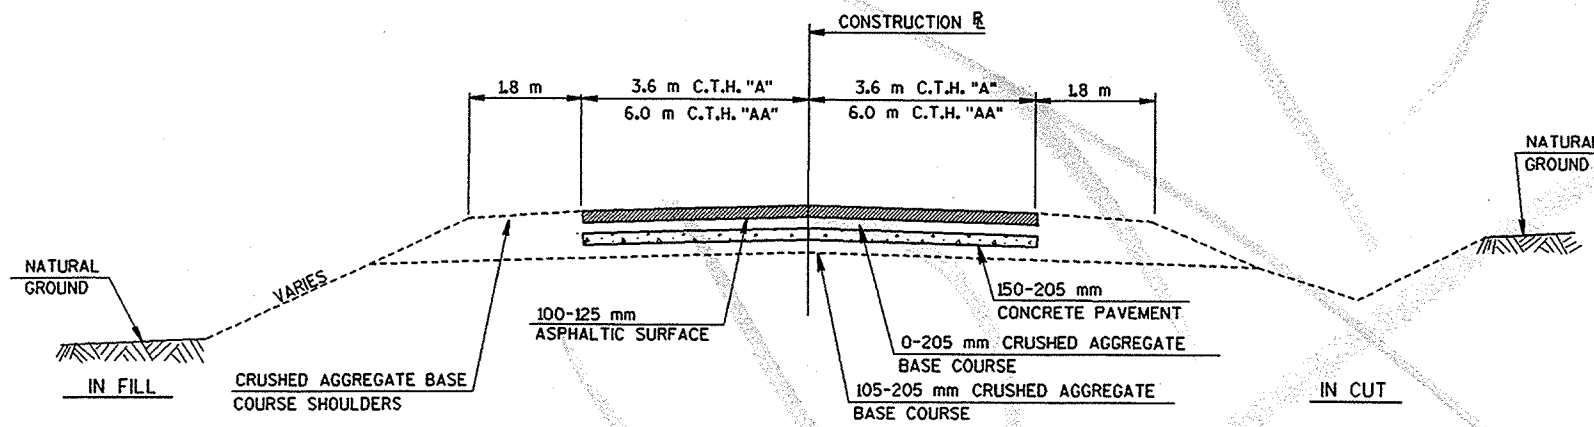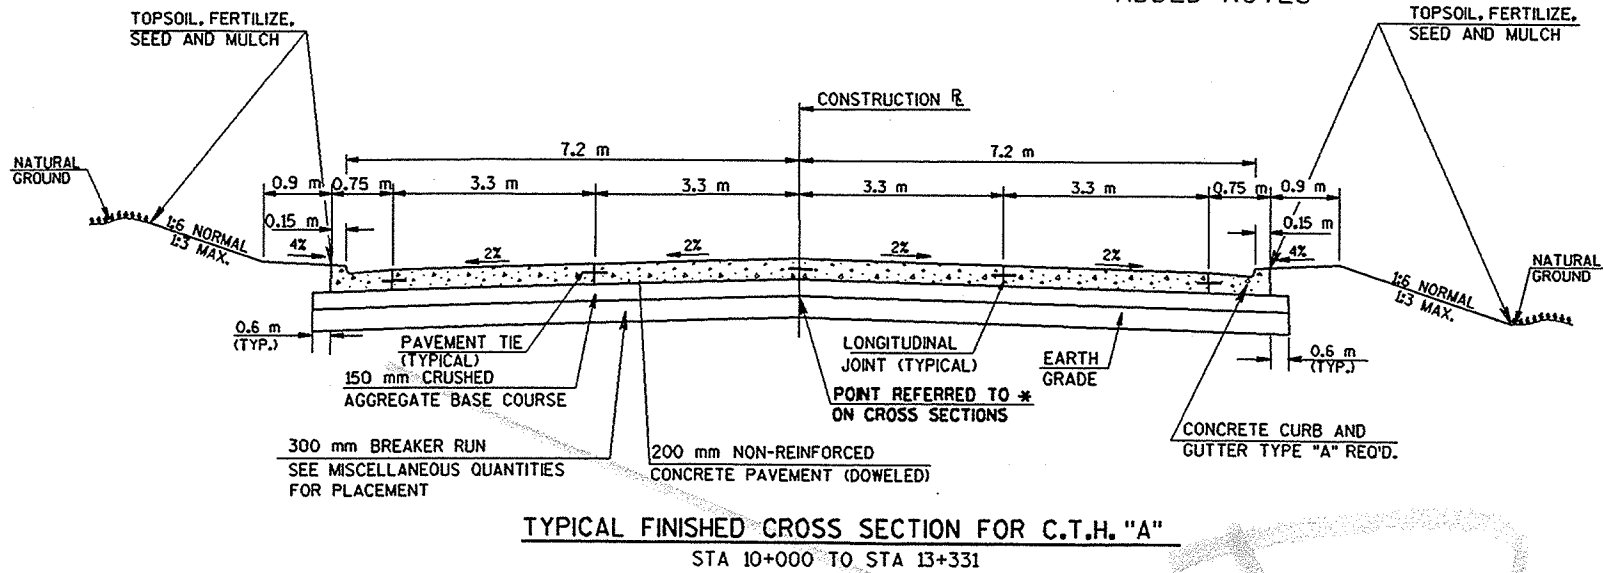

EXISTING TYPICAL FOR C.T.H. "A" AND C.T.H. "AA"

UTILITIES

- AMERITECH
221 WEST WASHINGTON STREET
FOURTH FLOOR OSPE
APPLETON, WISCONSIN 54911
ATTENTION: JOE FEMLING
TELEPHONE 1-920-735-3250
FAX 1-920-735-3073
- NORLIGHT TELECOMMUNICATIONS INC.
275 NORTH CORPORATE DRIVE
BROOKFIELD, WI. 53045-5818
ATTENTION: PAUL NEUMANN
TELEPHONE 1-920-831-9207
- D.N.R. AREA LIAISON
DEPARTMENT OF NATURAL RESOURCES
1125 N. MILITARY AVENUE
P.O. BOX 10448
GREEN BAY, WISCONSIN 54307
ATTENTION: AL STRANZ
TELEPHONE 1-920-492-5800
- TIME WARNER CABLE
1001 KENNEDY AVE.
P.O. BOX 145
KIMBERLY, WISCONSIN 54136-0145
ATTENTION: STEVE POEHLIN
TELEPHONE 1-920-236-5065
- A.T. & T.
W277 S4747 SAYLESVILLE ROAD,
WAUKESHA, WISCONSIN 53188
ATTENTION: TOM BOHTE
TELEPHONE 1-414-521-7730
CELL 1-414-315-2023
PAGER 1-414-318-5007
- CITY OF OSHKOSH
DEPARTMENT OF PUBLIC WORKS
215 CHURCH AVENUE
P.O. BOX 1130
OSHKOSH, WISCONSIN 54902
ATTENTION: MR. DAVID PATEK
TELEPHONE 1-920-433-4942*
- WISCONSIN PUBLIC SERVICE CORPORATION
(GAS AND ELECTRIC)
700 NORTH ADAMS STREET
P.O. BOX 19001
GREEN BAY, WISCONSIN 54307-9001
ATTENTION: MIKE CERKAS *
TELEPHONE 1-920-433-4942*
- WISCONSIN CENTRAL LTD. RAILROAD
1625 DEPOT STREET
STEVENS POINT, WISCONSIN 54481
ATTENTION: TERRY LEE
TELEPHONE 1-715-345-2503



CALL DIGGERS HOTLINE
1-800-242-8511
TOLL FREE
TELEFAX (414) 259-0947
TDD (FOR HEARING IMPAIRED) 1-800-542-2289
WIS. STATUTE 182.0175 (1974)
REQUIRES MIN. OF 3 WORK DAYS
NOTICE BEFORE YOU EXCAVATE.

- ### GENERAL NOTES
- SILT FENCE DELIVERED SHALL MEET THE MATERIAL SPECIFICATIONS FOR SILTY SOILS.
 - THE LOCATION OF EXISTING AND PROPOSED UTILITY FACILITIES AS SHOWN ON THE PLAN ARE APPROXIMATE.
 - THERE MAY BE OTHER UTILITY FACILITIES WITHIN THE PROJECT AREA THAT ARE NOT SHOWN.
 - INLET AND DISCHARGE ELEVATIONS FOR DRAINAGE STRUCTURES SHOWN ON THE PLAN SHEETS ARE APPROXIMATE AND SHALL BE DETERMINED BY THE ENGINEER IN THE FIELD.
 - THE EXACT LOCATION AND LIMITS OF PRIVATE ENTRANCES SHALL BE DETERMINED BY THE ENGINEER IN THE FIELD.
 - PROPERTY LINES AS SHOWN ARE APPROXIMATE.
 - ALL DISTANCES ARE GROUND DISTANCES.
 - CURVE DATA IS BASED ON RADIUS DEFINITION.
 - NO TREES OR SHRUBS ARE TO BE REMOVED WITHOUT APPROVAL OF THE ENGINEER.
 - WHEN THE QUANTITY OF THE ITEM OF BASE COURSE OR SURFACE COURSE IS MEASURED BY THE M OR M₃, THE DEPTH OR THICKNESS AS SHOWN IS APPROXIMATE. THE ACTUAL THICKNESS WILL DEPEND ON THE DISTRIBUTION OF MATERIALS AS DIRECTED BY THE ENGINEER.
 - THE REMOVAL OF ASPHALT DRIVEWAYS WILL BE PAID AS UNCLASSIFIED EXCAVATION.
 - ALL TIES ON THIS PLAN ARE HORIZONTAL UNLESS DESCRIBED OTHERWISE.
 - MEETING EXISTING PAVEMENT WITH NEW PAVEMENT SHALL BE PERFORMED WITH A BUTT JOINT. ALL BUTT JOINTS ARE TO BE SAW CUT.
 - THE EXACT LOCATION AND WIDTH OF DRIVEWAYS SHALL BE DETERMINED BY THE ENGINEER IN THE FIELD.
 - EXCAVATIONS BELOW SUBGRADE (E.B.S.) SHALL BE MEASURED AND PAID FOR AS UNCLASSIFIED EXCAVATION. THE EXACT LOCATION FOR E.B.S. IF REQUIRED, SHALL BE DETERMINED BY THE ENGINEER.
 - CURB HEIGHTS AT THE END OF CURB AND GUTTER SHALL BE TAPER FROM 0 mm TO 150 mm IN 1.8 m UNLESS OTHERWISE NOTED.
 - CONSTRUCTION PERMITS HAVE BEEN ACQUIRED FOR THE WORK TO BE PERFORMED OUTSIDE THE RIGHT-OF-WAY AND THESE RIGHTS HAVE BEEN EXTENDED TO THE CONTRACTOR.
 - ALL RADII ARE TO THE FACE OF CURB, UNLESS OTHERWISE NOTED.
 - * THE ELEVATION NOTED ON THE CROSS SECTIONS, IS THE SUBGRADE ELEVATION AT THE BOTTOM OF THE BASE COURSE, BUT ABOVE THE BREAKER RUN.
 - * MARSH EXCAVATION LIMITS SHALL BE DETERMINED BY THE ENGINEER IN THE FIELD.
 - * MARSH EXCAVATION CAN BE USED AS FILL ACCORDING TO THE TYPICAL MARSH EXCAVATION DETAIL.

RUNOFF COEFFICIENTS

NEW PAVEMENT	0.90	EXISTING PAVEMENT	0.80
NEW SLOPES	0.27	EXISTING SLOPES	0.27
TOTAL PROJECT AREA 7.4 HECTARES		TOTAL DISTURBED AREA 6.6 HECTARES	


METRIC STANDARD DETAIL DRAWINGS

- 8A5-15a,b,&d
 - 8B6-3
 - 8B7-3
 - 8C1-5
 - 8D1-12
 - 8E9-5
 - 8F1-11
 - 8F4-5
 - 8F10-1
 - 9A1-11a
 - 9A1-11b
 - 9B2-6
 - 13B1-4
 - 13C1-10
 - 13C13-3
 - 15C2-3
 - 15C8-8a
 - 15C8-8b
 - 15C8-8e
 - 15C9-3
 - 15C11-5
 - 1506-2
- INLET COVERS
 - MANHOLES, TYPE 1
 - MANHOLES, TYPE 2 AND 3
 - INLETS, TYPE 1, 2, 3, AND 4
 - CONCRETE CURB, CONCRETE CURB AND GUTTER AND PAVEMENT TIES
 - SILT FENCE
 - APRON ENDWALLS FOR CULVERT PIPE
 - JOINT TIES FOR CONCRETE PIPE
 - CONCRETE MASONRY ENDWALLS FOR CULVERT PIPE AND PIPE ARCH
 - AT-GRADE SIDE ROAD INTERSECTIONS, TYPES "B1", "B2", "C" AND "D"
 - AND TEE INTERSECTION BYPASS LANE
 - AT-GRADE SIDE ROAD INTERSECTIONS, TYPE "A"
 - CONDUIT
 - PAVEMENT DETAILS FOR RAILROAD APPROACH
 - CONCRETE PAVEMENT LONGITUDINAL JOINTS AND PAVEMENT TIES
 - URBAN DOWELED CONCRETE PAVEMENT
 - BARRICADES AND SIGNS FOR ROAD CLOSURES
 - PAVEMENT MARKING (MAINLINE)
 - PAVEMENT MARKING (INTERSECTIONS)
 - PAVEMENT MARKINGS (ISLANDS, STOPLINES, AND CROSSWALKS)
 - PAVEMENT MARKING DETAILS FOR RAILROAD-HIGHWAY GRADE CROSSINGS
 - FLEXIBLE TUBULAR MARKER POSTS, ANCHORS, AND BASES
 - TRAFFIC CONTROL, TWO LANE TWO WAY OPERATION

ORIGINAL: DUD
 PROJECT NO: 440278.00
 DATE: 2/3/99
 PLOT NAME: 150-TOTAL
 SCALE: 1:50
 FILE NAME: #16 DEC 14 1999
 PEN TABLE = #plot\ospr-smv80pp.tbl
 DATE OF PLOT = 11/23/99
 PLOT NO: 150-TOTAL
 DESIGN FILE IS: I:\440278\dgn\GENERAL.dgn


GR2
PLOT NAME: 4994-00-82-MSHT-22
DATE OF PLOT: 5/1/00
PLOT NO:
DESIGNER: J. L. B. / J. L. B. / J. L. B.

ORIGINATOR: J. L. B.
PROJECT NO: 4994-00-82
REVISIONS BY: J. L. B.
DATE REVISIONS: 5/1/00
LEVELS ON: 1, 2, 3, 99, 100

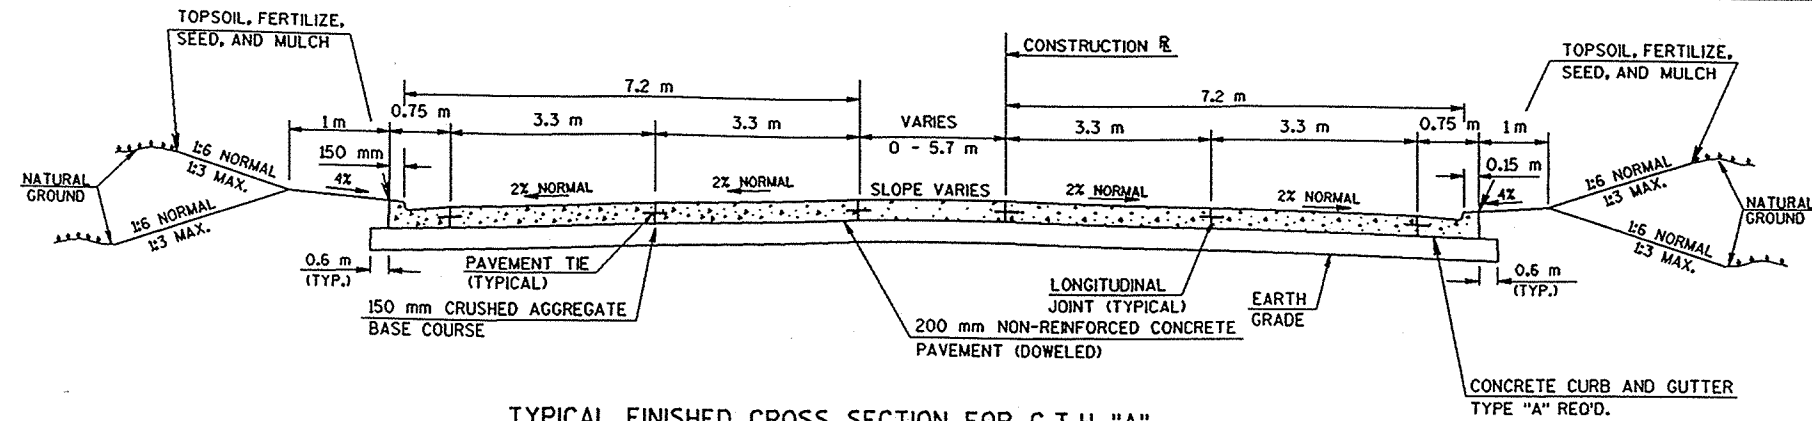


TYPICAL FINISHED CROSS SECTION FOR C.T.H. "A"

STA. 13+140 TO STA. 13+170
STA. 13+270 TO STA. 13+320
STA. 13+420 TO STA. 13+460

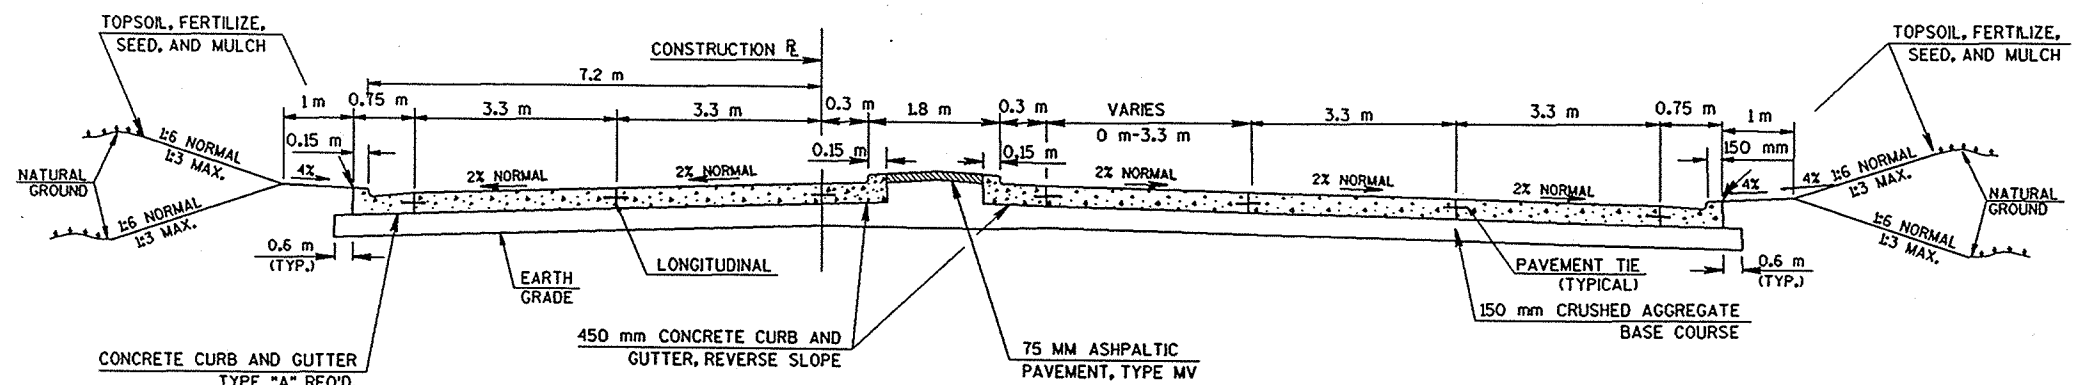


TYPICAL FINISHED CROSS SECTION FOR C.T.H. "A"

STA. 13+170 TO STA. 13+270

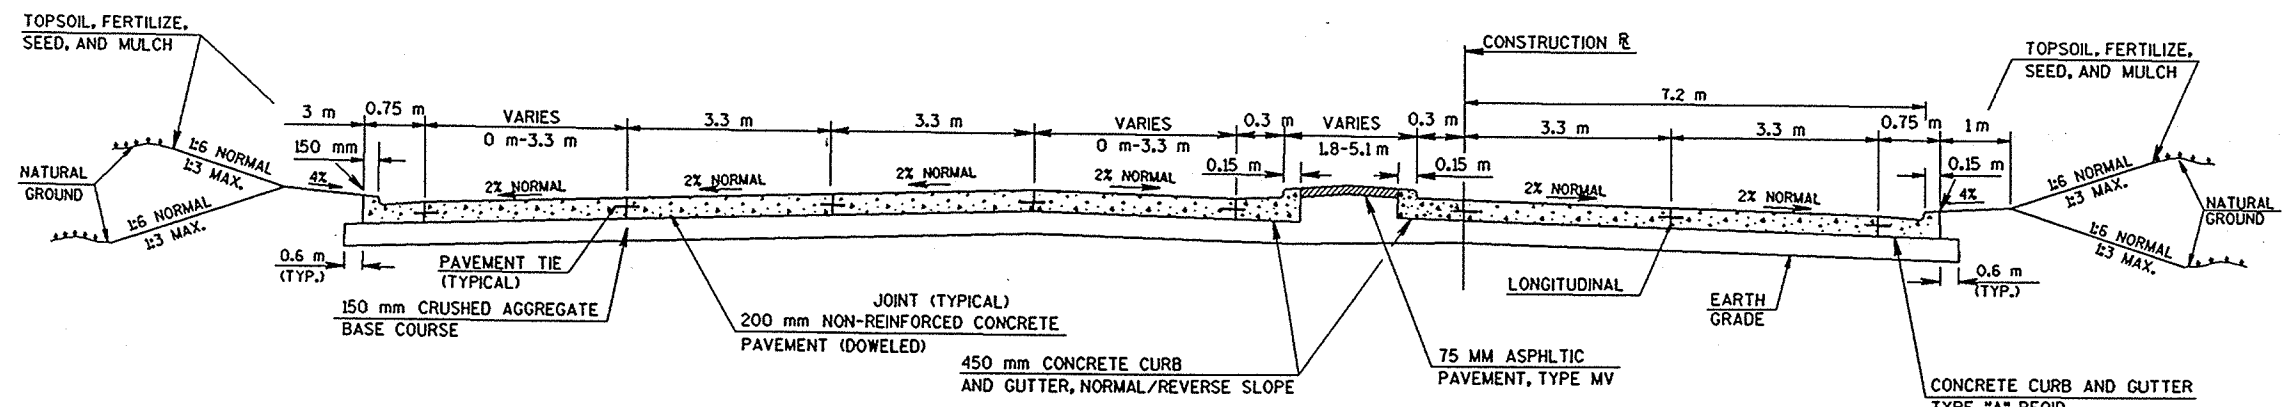


TYPICAL FINISHED CROSS SECTION FOR C.T.H. "A"

STA. 13+320 TO STA. 13+420

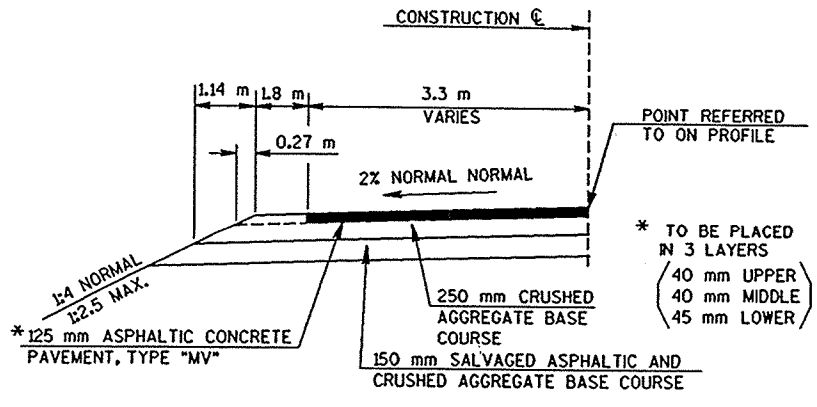

TYPICAL 1/2 SECTION FOR C.T.H. "A"

STA. 13+460-13+580

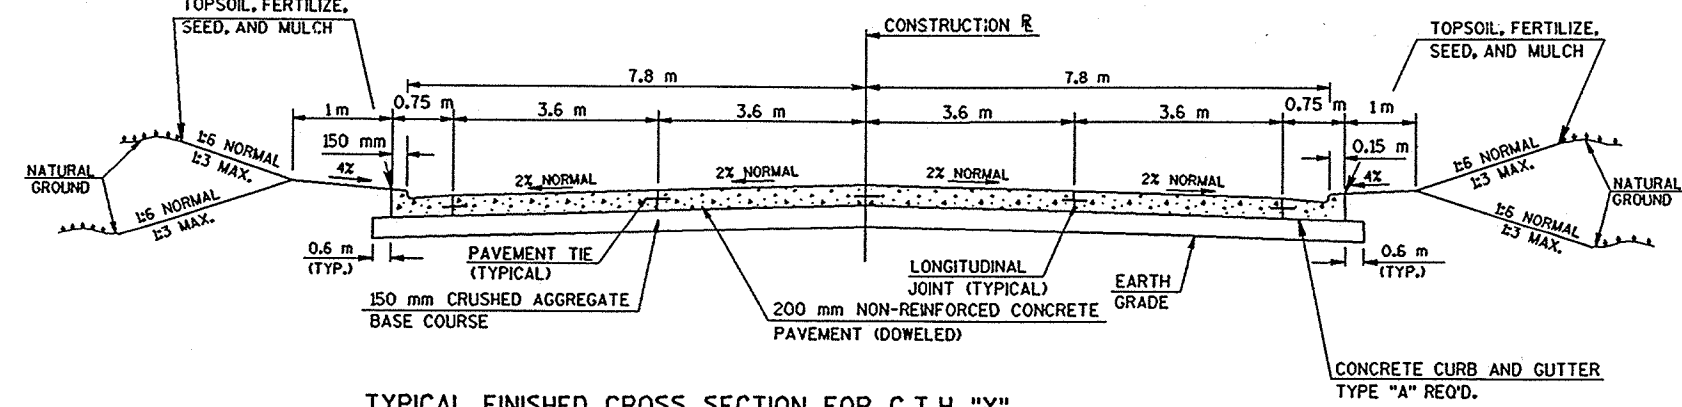

TYPICAL FINISHED CROSS SECTION FOR C.T.H. "Y"


STA. 9+965 TO STA. 9+985

GB2
 PLOT TABLE = 4ploc724loerfsmv80pp.tbl
 DATE OF PLOT = 11/25/98
 PLOT NUMBER = 440278.dgn
 DESIGN FILE IS I:\440278\440278.dgn\typical.dgn


50, 51, 52, 53, 54, 55, 56, 57, 58, 59, 60, 61, 62

PLOT NAME
 SCALE


DATE: 9/1/98
 PROJECT NO. 440278.00
 REVISION BY:
 DATE REVISION:
 LEVELS ON = 1, 2, 3, 4, 5, 6, 7, 8, 9, 10, 11, 12, 13, 14, 15, 16, 17, 18, 19, 20, 21, 22, 23, 24, 25, 26, 27, 28, 29, 30, 31, 32, 33, 34, 35, 36, 37, 38, 39, 40, 41, 42, 43, 44, 45, 46, 47, 48

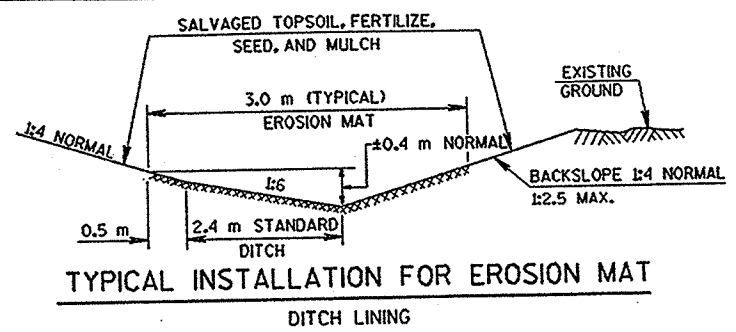


TYPICAL INSTALLATION FOR EROSION MAT DITCH LINING

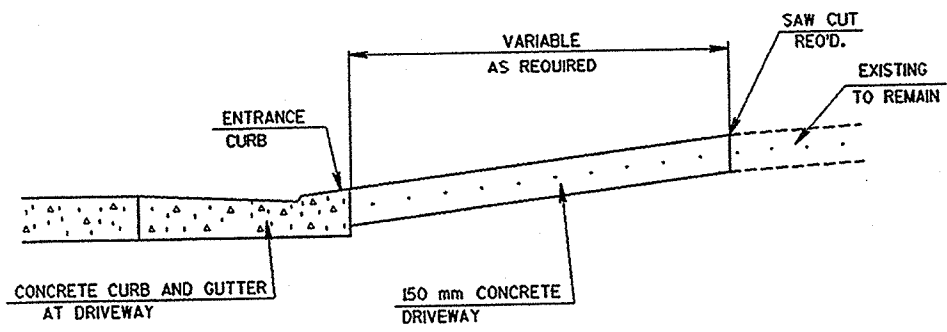

TYPICAL LONGITUDINAL SECTION AT CONCRETE SURFACE PRIVATE ENTRANCES

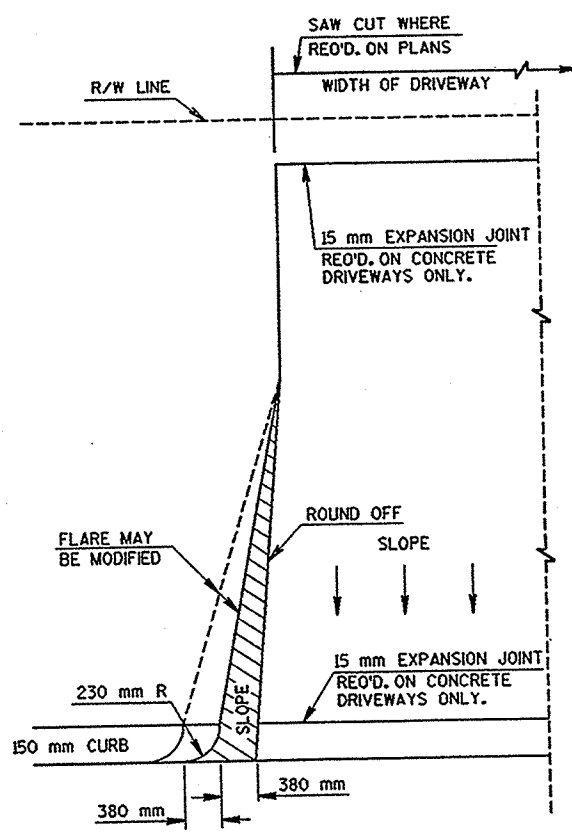


TYPICAL DRIVEWAY LAYOUT

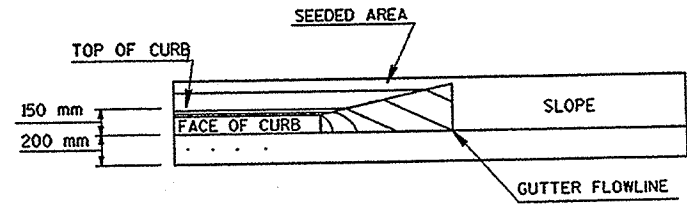


PROFILE (PARALLEL TO R. OF ROADWAY)

DRIVEWAY DETAILS


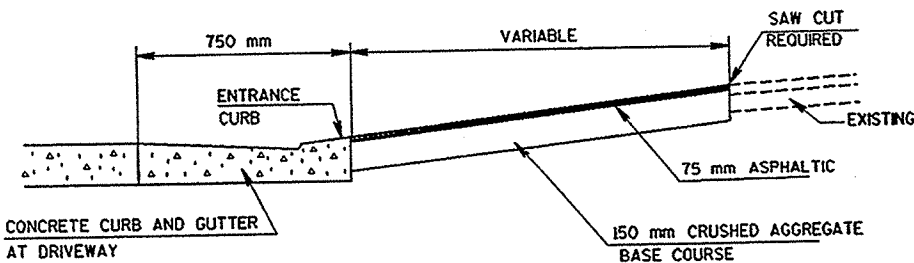


TYPICAL LONGITUDINAL SECTION AT ASPHALTIC SURFACE PRIVATE ENTRANCES

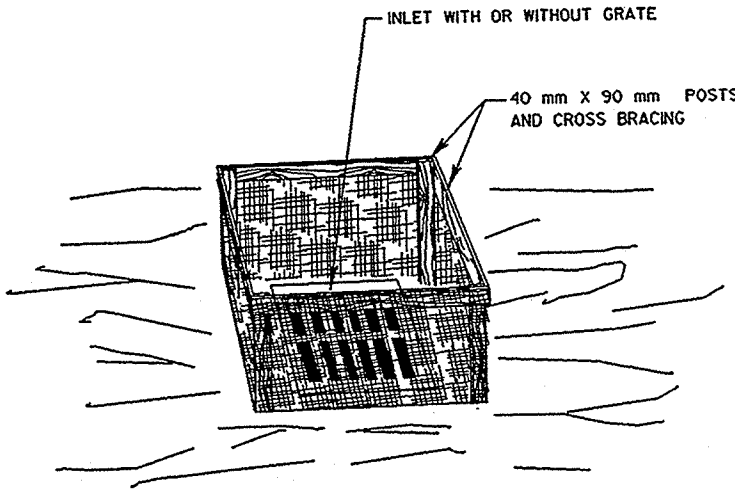


SILT FENCE AT INLET


NOTE: ATTACH FABRIC TO THE TOP OF POSTS AND CROSS BRACINGS.

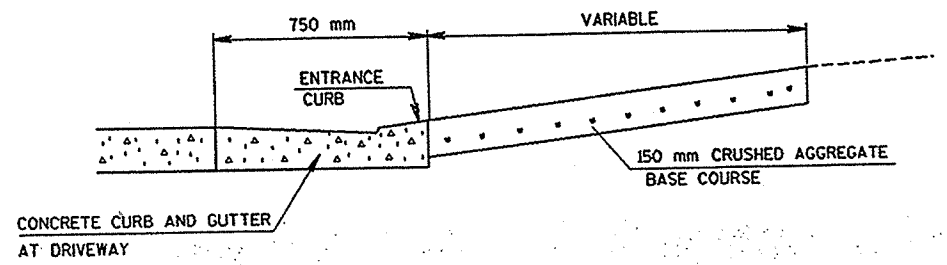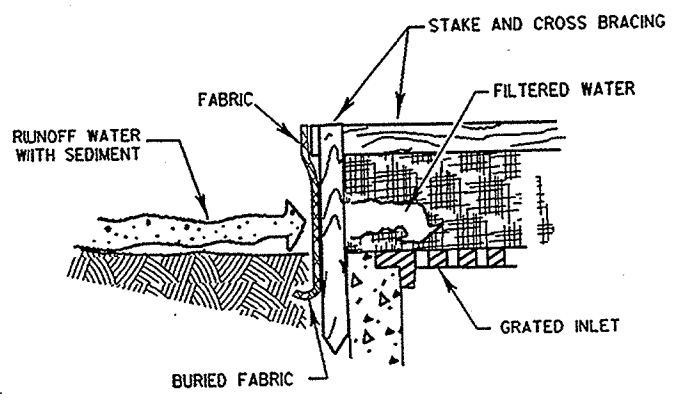


TYPICAL LONGITUDINAL SECTION AT CRUSHED AGGREGATE SURFACE PRIVATE ENTRANCES

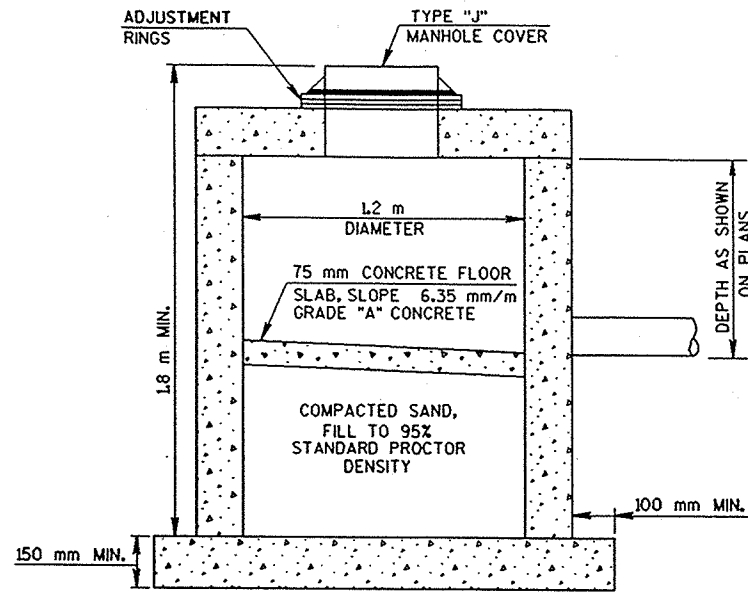



MANHOLE, TYPE 1, MODIFIED
SEE MISCELLANEOUS QUANTITIES FOR LOCATION

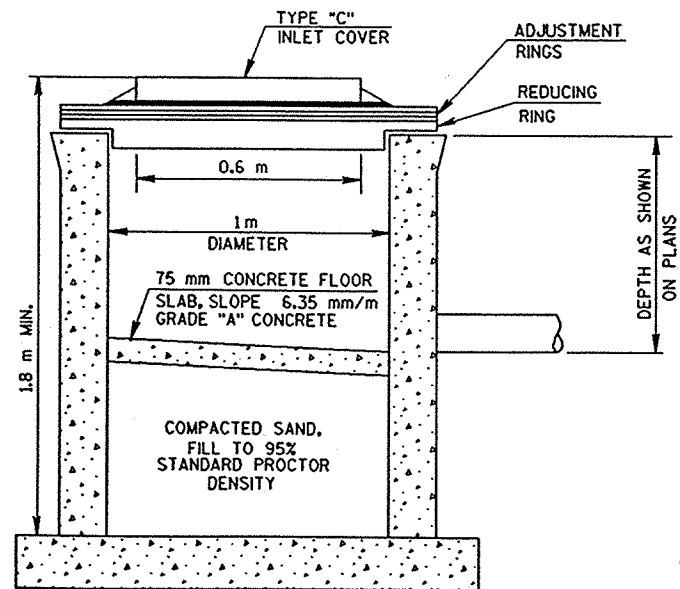

INLET, TYPE 1, MODIFIED
SEE MISCELLANEOUS QUANTITIES FOR LOCATION

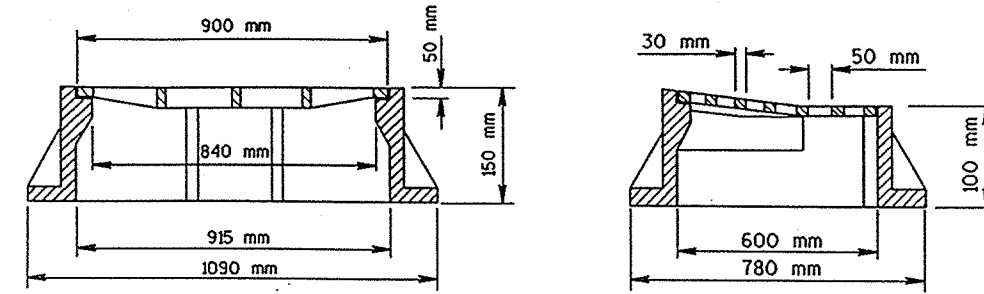

TYPE D INLET COVER
APPROXIMATE TOTAL WEIGHT-200 kg

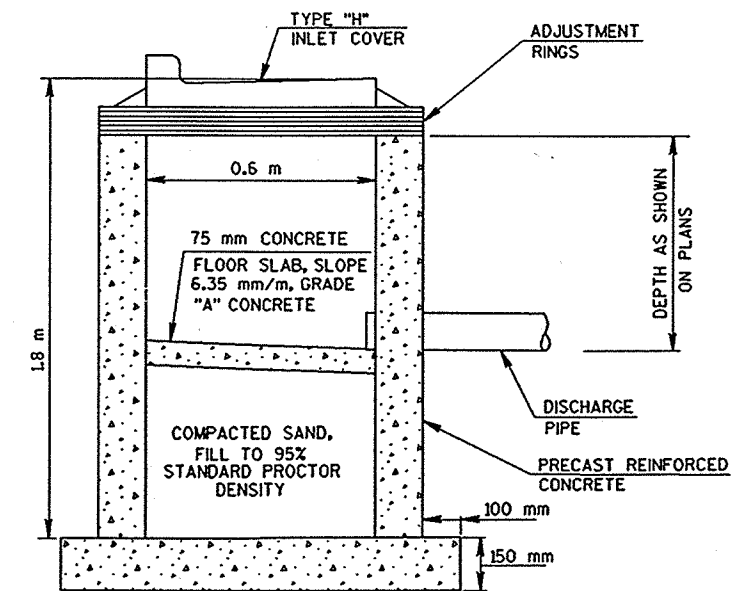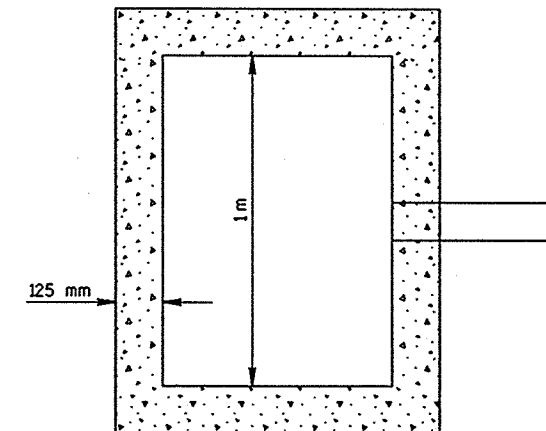


INLET, TYPE 3, MODIFIED
SEE MISCELLANEOUS QUANTITIES FOR LOCATION



ORIGINAL DTD PROJECT NO. 440278.00 DATE 9/1/98 FILE NAME: DATE REVISION BY: LEVELS ON - 1, 2, 3, 48, 50, 51, 52, 53, 54, 55, 56, 57, 58, 59, 60, 61, 62.
 PLOT NAME: SCALE: DATE: 4/7/00 DESIGN FILE IS: \\s440278\dm\typical.dgn

C92
 PEN TABLE = #plot72xiasef-mv80pp.tbl
 DATE OF PLOT = 01/29/99
 PLOT NA
 DESIGN FILE IS I:\440278\adp\typicoll.dgn


ORIGINATOR: D.D.
 PROJECT NO.: 440278-00
 REVISION BY:
 DATE REVISION:
 LEVELS ON = 1, 2, 3, 48, 50, 51, 52, 53, 54, 55, 56, 57, 58, 59, 60, 61, 62.
 PLOT NAME
 SCALE:
 DATE: 8/1/98
 FILE NAME

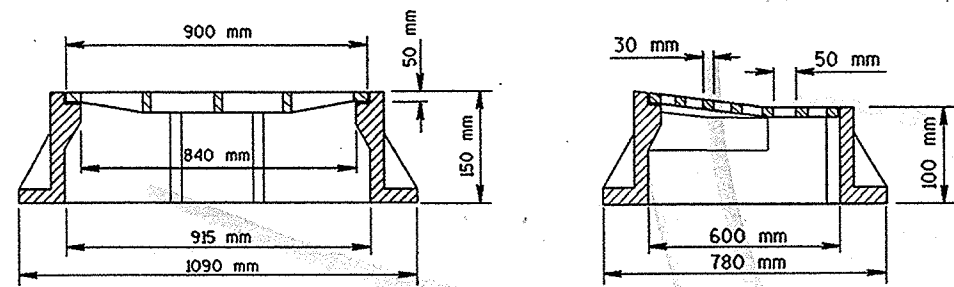

TYPE D INLET COVER
 APPROXIMATE TOTAL WEIGHT-200 kg

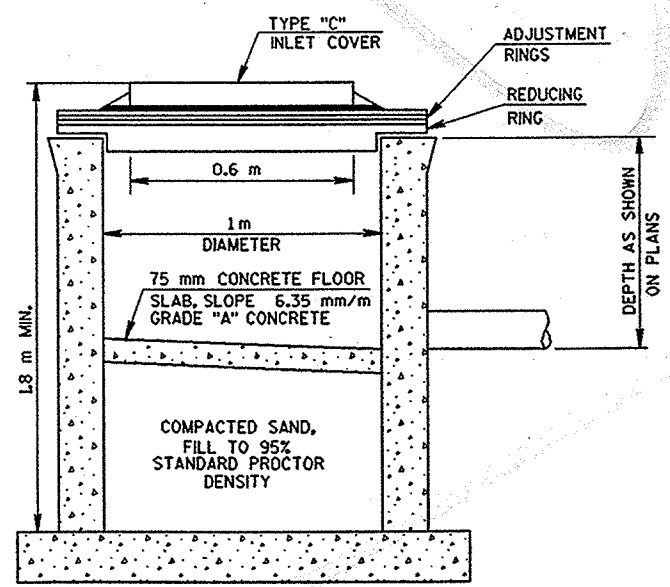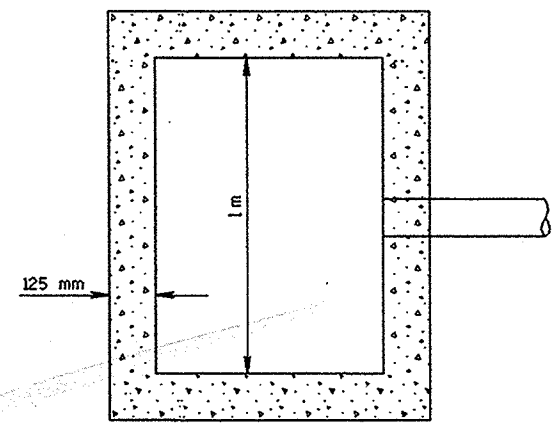


INLET, TYPE 1, MODIFIED
 SEE MISCELLANEOUS QUANTITIES FOR LOCATION

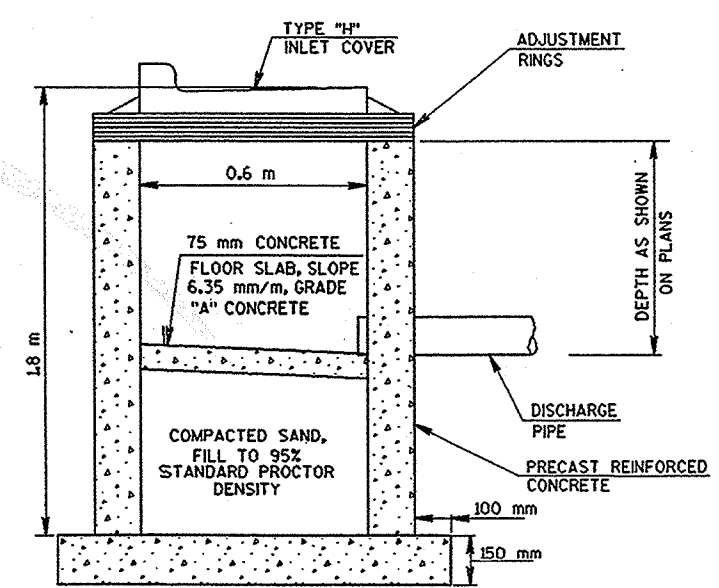

INLET, TYPE 3, MODIFIED
 SEE MISCELLANEOUS QUANTITIES FOR LOCATION

PAVEMENT GRADES WERE CHANGED TO MATCH THE RR CROSSING.
 THE PROPOSED \varnothing GRADE AT STA. 19+980.7 WAS FOUND TO BE 0.079 M
 HIGHER THAN THE RR TRACKS. THE RR TRACKS ALSO SLOPED FROM
 NORTH TO SOUTH. GRADES WERE REVISED AS FOLLOWS:

STA.	FIN. \varnothing	LT. EOP	RT. EOP	REMARKS
+940	230.814	230.694	230.694	
+950	230.910	230.750	230.790	
+960	230.918	230.780	230.843	H.P. RT. SIDE
+970	230.878	230.810	230.810	
+980.9	230.834	230.850	-	SOUTH RR TIE ELEV.
+984	230.859	-	230.793	NORTH RR TIE ELEV.
+990	230.823	230.877	-	

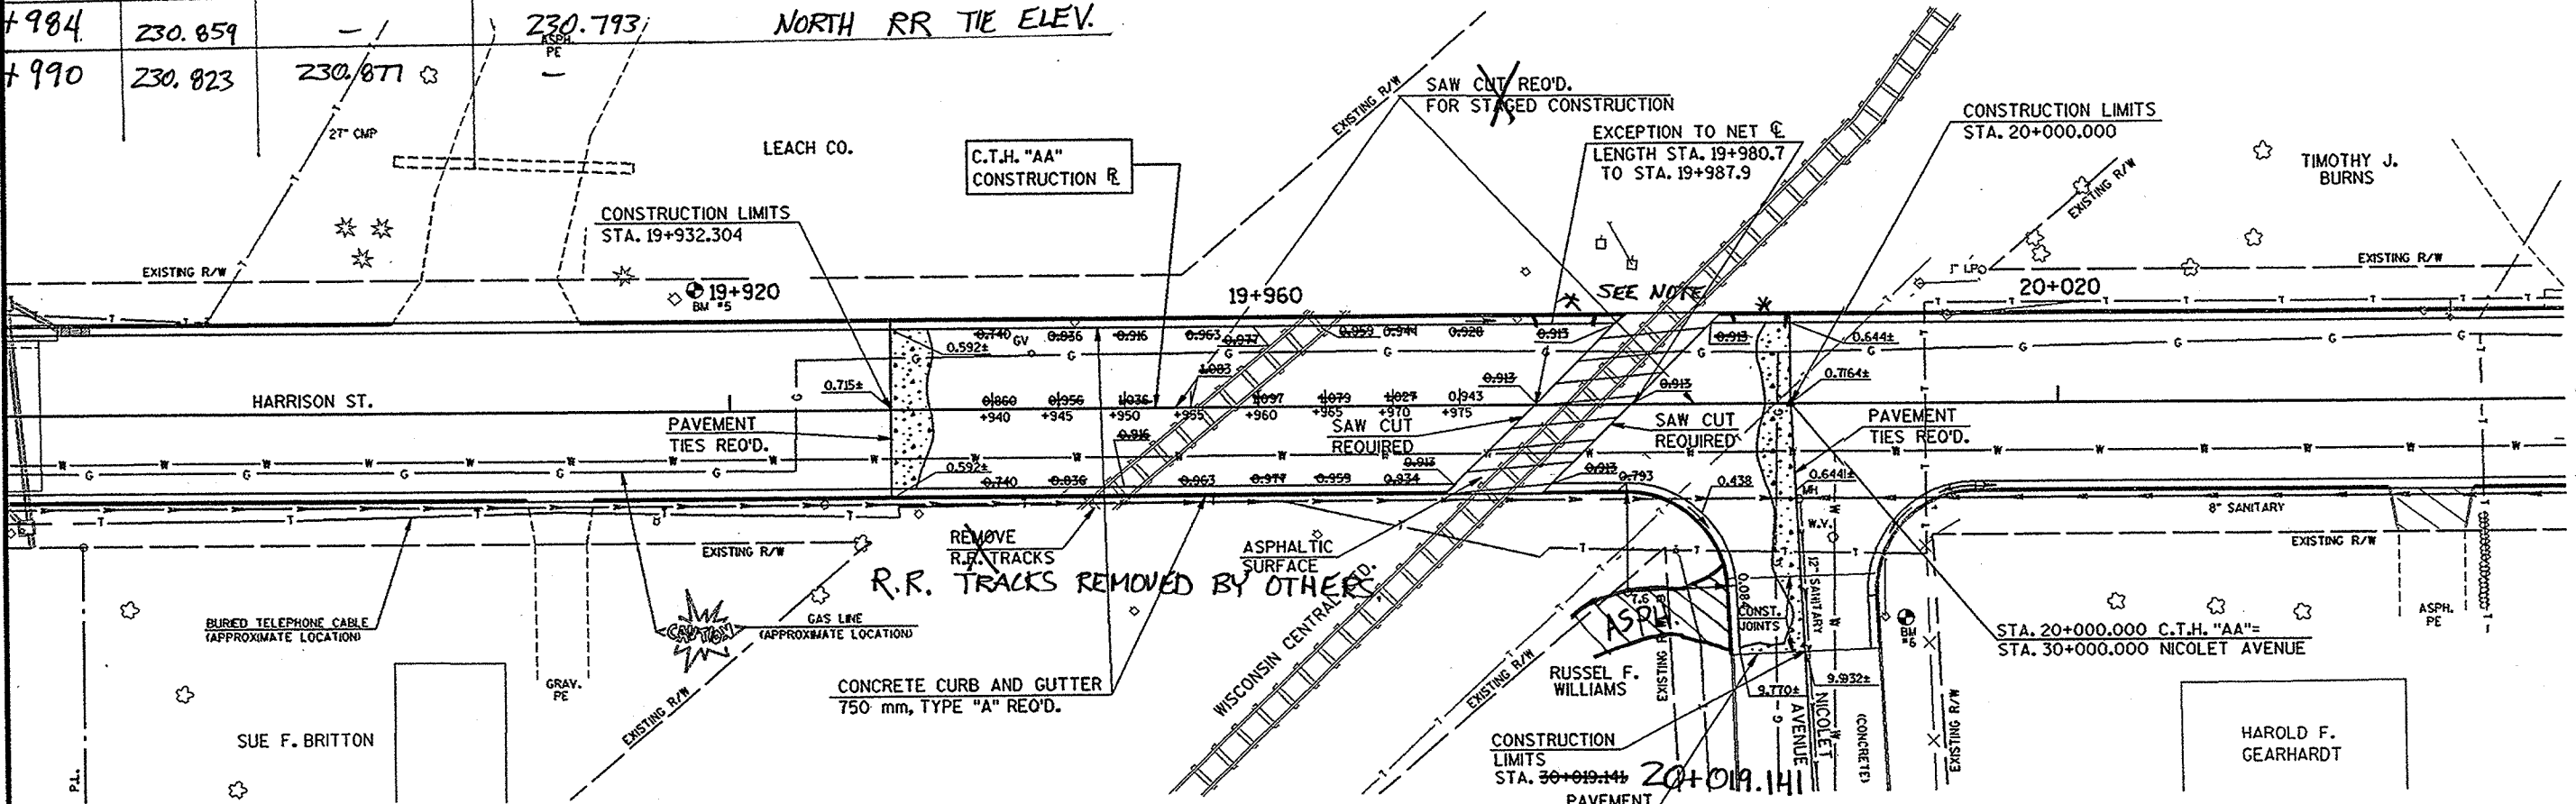

EARTHWORK VOLUME FOR HARRISON ST. NOT INCLUDED IN THE PLAN. CONCL. PAVEMENT REMOVAL AND SUBGRADE EXCAVATION TOTALED 369 M².

ASPH. DRIVEWAY REMOVED AND REPLACED AT STA. 20+017 RT., NICOLET AVE.

CONSTRUCTION DETAIL FOR HARRISON ST. AND W.C.L. R.R. CROSSING


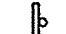




* CURB CUTS FOR WIS. CENTRAL ACCESS TO RR CONTROLLER AND SPUR LINE.


BENCH MARKS			
NO.	STA.	DESCRIPTION	ELEV.
5	19+235	150 mm NAIL IN PP-8.5 m LT.	230.383
6	20+008	150 mm NAIL IN PP-16.2 m RT.	230.103

ORIGINATOR: D.J.D. DATE: 9/1/98
 PROJECT NO: 440278.00
 REVISIONS: 1, 2, 3, 62, 63
 PLOT NAME: SCALE:
 FILE NAME:


GB2
 PEN TABLE = :plot172x10eet-smv80pp.tbl
 DATE OF PLOT = 03/22/99
 PLOT NO
 DESIGN FILE IS I:\440278\vdgn\TRAFFICA.dgn

ORIGINAL D.D.
 REVISIONS
 DATE 1.2.3.4.5.6.7.8.9.10.11.12.13.14.15.16.17.18.19.20.21.22.23.24.25.26.27.28.29.30.31.32.33.34.35.36.37.38.39.40.41.42.43.44.45.46.47.48.49.50.51.52.53.54.55.56.57.58.59.60.61.62.
 PLOT NAME
 SCALE
 DATE 1.2.3.4.5.6.7.8.9.10.11.12.13.14.15.16.17.18.19.20.21.22.23.24.25.26.27.28.29.30.31.32.33.34.35.36.37.38.39.40.41.42.43.44.45.46.47.48.49.50.51.52.53.54.55.56.57.58.59.60.61.62.
 FILE NAME
 DATE REVISIONS

SYMBOLS	
	STAGE CONSTRUCTION AREA
	SIGN ON PERMANENT SUPPORT
	NON-METALLIC DRUMS WITH TYPE "C" STEADY BURN LIGHTS, SPACED AT 15 m TYPICAL
	DIRECTION OF TRAFFIC FLOW
	TYPE III BARRICADE WITH SIGN ATTACHED
	FLEXIBLE TUBULAR MARKER POSTS AND BASES, 7.5 m TYPICAL

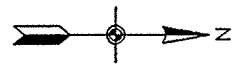

- GENERAL NOTES FOR TRAFFIC CONTROL**
1. THE EXACT NUMBER, LOCATION, AND SPACING OF ALL SIGNS AND DEVICES SHALL BE ADJUSTED TO FIT FIELD CONDITIONS DIRECTED BY THE ENGINEER.
 2. ALL SIGNS INAPPROPRIATE TO THE STATUS OF THE CONTROL ZONE INCLUDING PRE-EXISTING SIGNING IN THE VICINITY, SHALL BE COVERED AS SPECIFIED IN THE PLANS AND/OR THE SPECIAL PROVISIONS OR AS DIRECTED BY THE ENGINEER.
 3. ALL SIGNS ARE 1200 x 1200 mm UNLESS OTHERWISE NOTED.
 4. PAVEMENT MARKING NO LONGER APPLICABLE WHICH MIGHT CREATE CONFUSION IN THE MINDS OF VEHICLE OPERATORS SHALL BE REMOVED PRIOR TO OPENING TO TRAFFIC.
 5. ALL "WO" SIGNS ARE THE SAME AS "W" EXCEPT THE BACKGROUND IS ORANGE.
 6. ALL TYPE III BARRICADES ARE TO BE 2.4 m LONG.

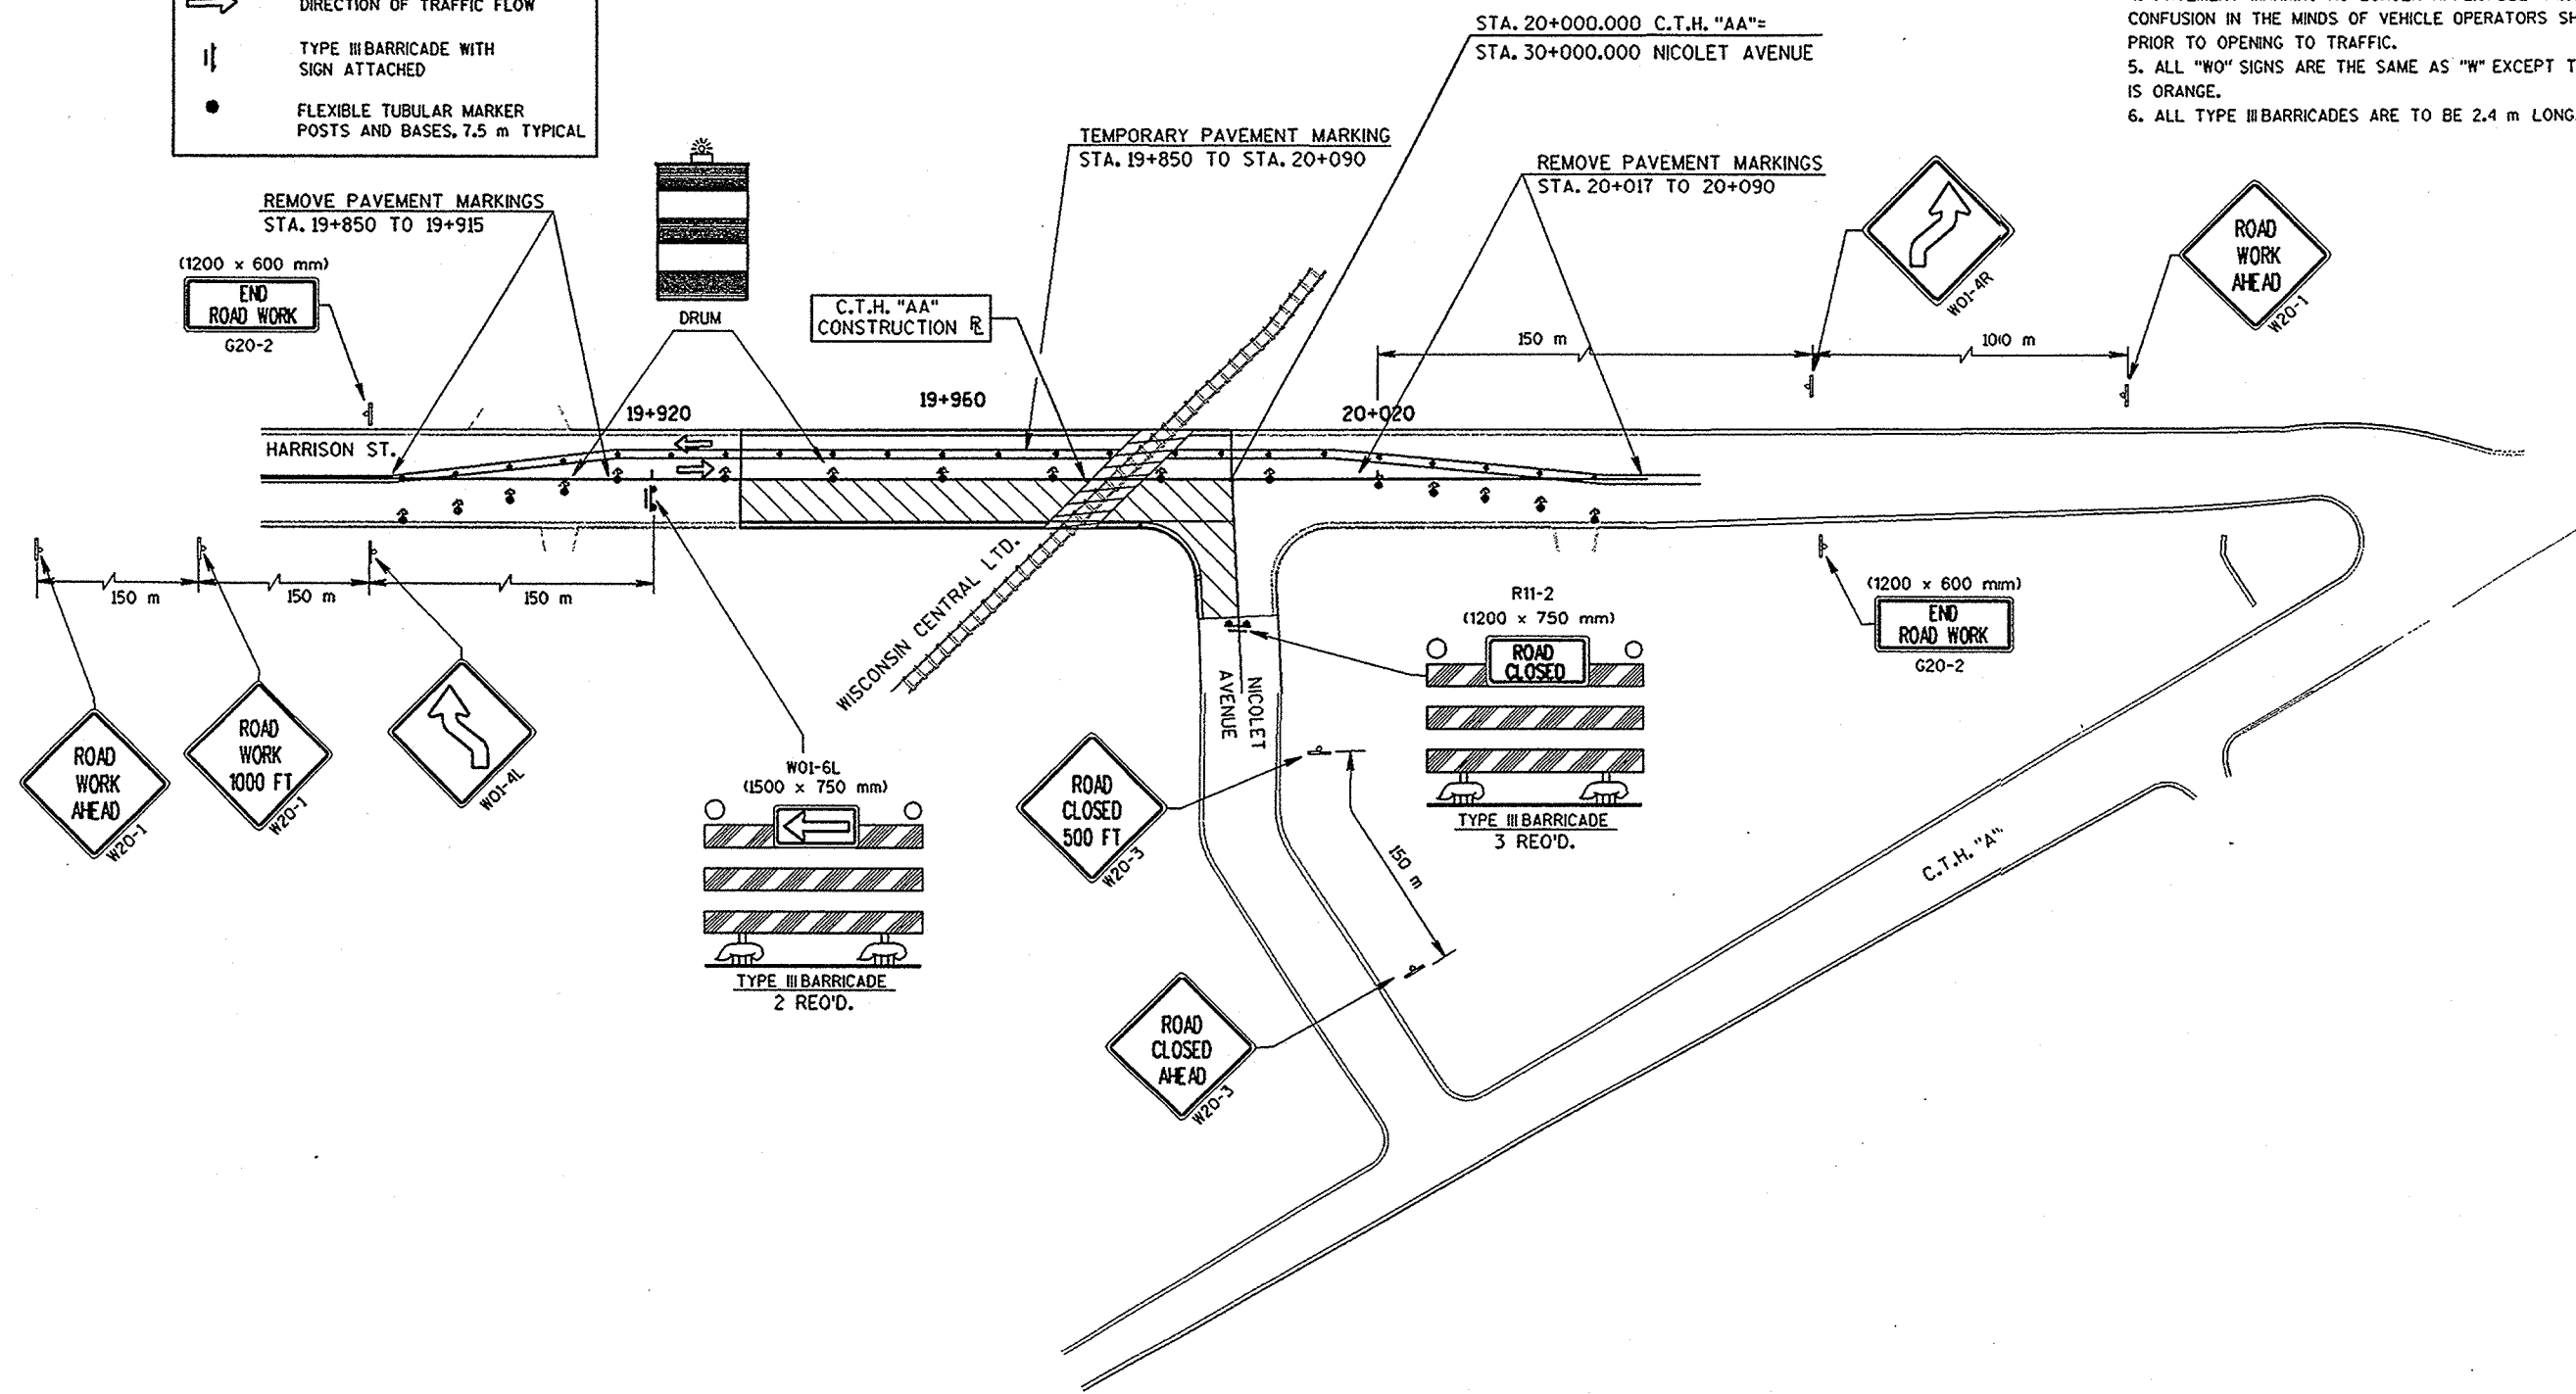


WISDOT: MS-T-1

GB2
 PEN TABLE = 4p1of72hlosser-amv80pp.tbl
 DATE OF PLOT = 07/14/99
 PLOT NAME
 DESIGN FILE IS I:\440278.dgn\traffic1.dgn



50.51.52.53.54.55.56.57.58.59.60.61.62.

ORIGINATOR: JLD
 PROJECT NO: 440278.00
 REVISION BY: [blank]
 DATE REVISED: [blank]
 LEVELS ON: 1, 2, 3, 4, 5, 6, 7, 8, 9, 10, 11, 12, 13, 14, 15, 16, 17, 18, 19, 20, 21, 22, 23, 24, 25, 26, 27, 28, 29, 30, 31, 32, 33, 34, 35, 36, 37, 38, 39, 40, 41, 42, 43, 44, 45, 46, 47, 48.

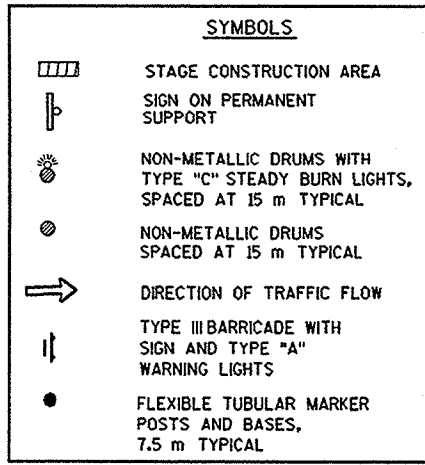

GENERAL NOTES FOR TRAFFIC CONTROL

1. THE EXACT NUMBER, LOCATION, AND SPACING OF ALL SIGNS AND DEVICES SHALL BE ADJUSTED TO FIT FIELD CONDITIONS DIRECTED BY THE ENGINEER.
2. ALL SIGNS INAPPROPRIATE TO THE STATUS OF THE CONTROL ZONE INCLUDING PRE-EXISTING SIGNING IN THE VICINITY, SHALL BE COVERED AS SPECIFIED IN THE PLANS AND/OR THE SPECIAL PROVISIONS OR AS DIRECTED BY THE ENGINEER.
3. ALL SIGNS ARE 1200 x 1200 mm UNLESS OTHERWISE NOTED.
4. PAVEMENT MARKING NO LONGER APPLICABLE WHICH MIGHT CREATE CONFUSION IN THE MINDS OF VEHICLE OPERATORS SHALL BE REMOVED PRIOR TO OPENING TO TRAFFIC.
5. ALL "W0" SIGNS ARE THE SAME AS "W" EXCEPT THE BACKGROUND IS ORANGE.
6. ALL TYPE III BARRICADES ARE TO BE 2.4 m LONG.

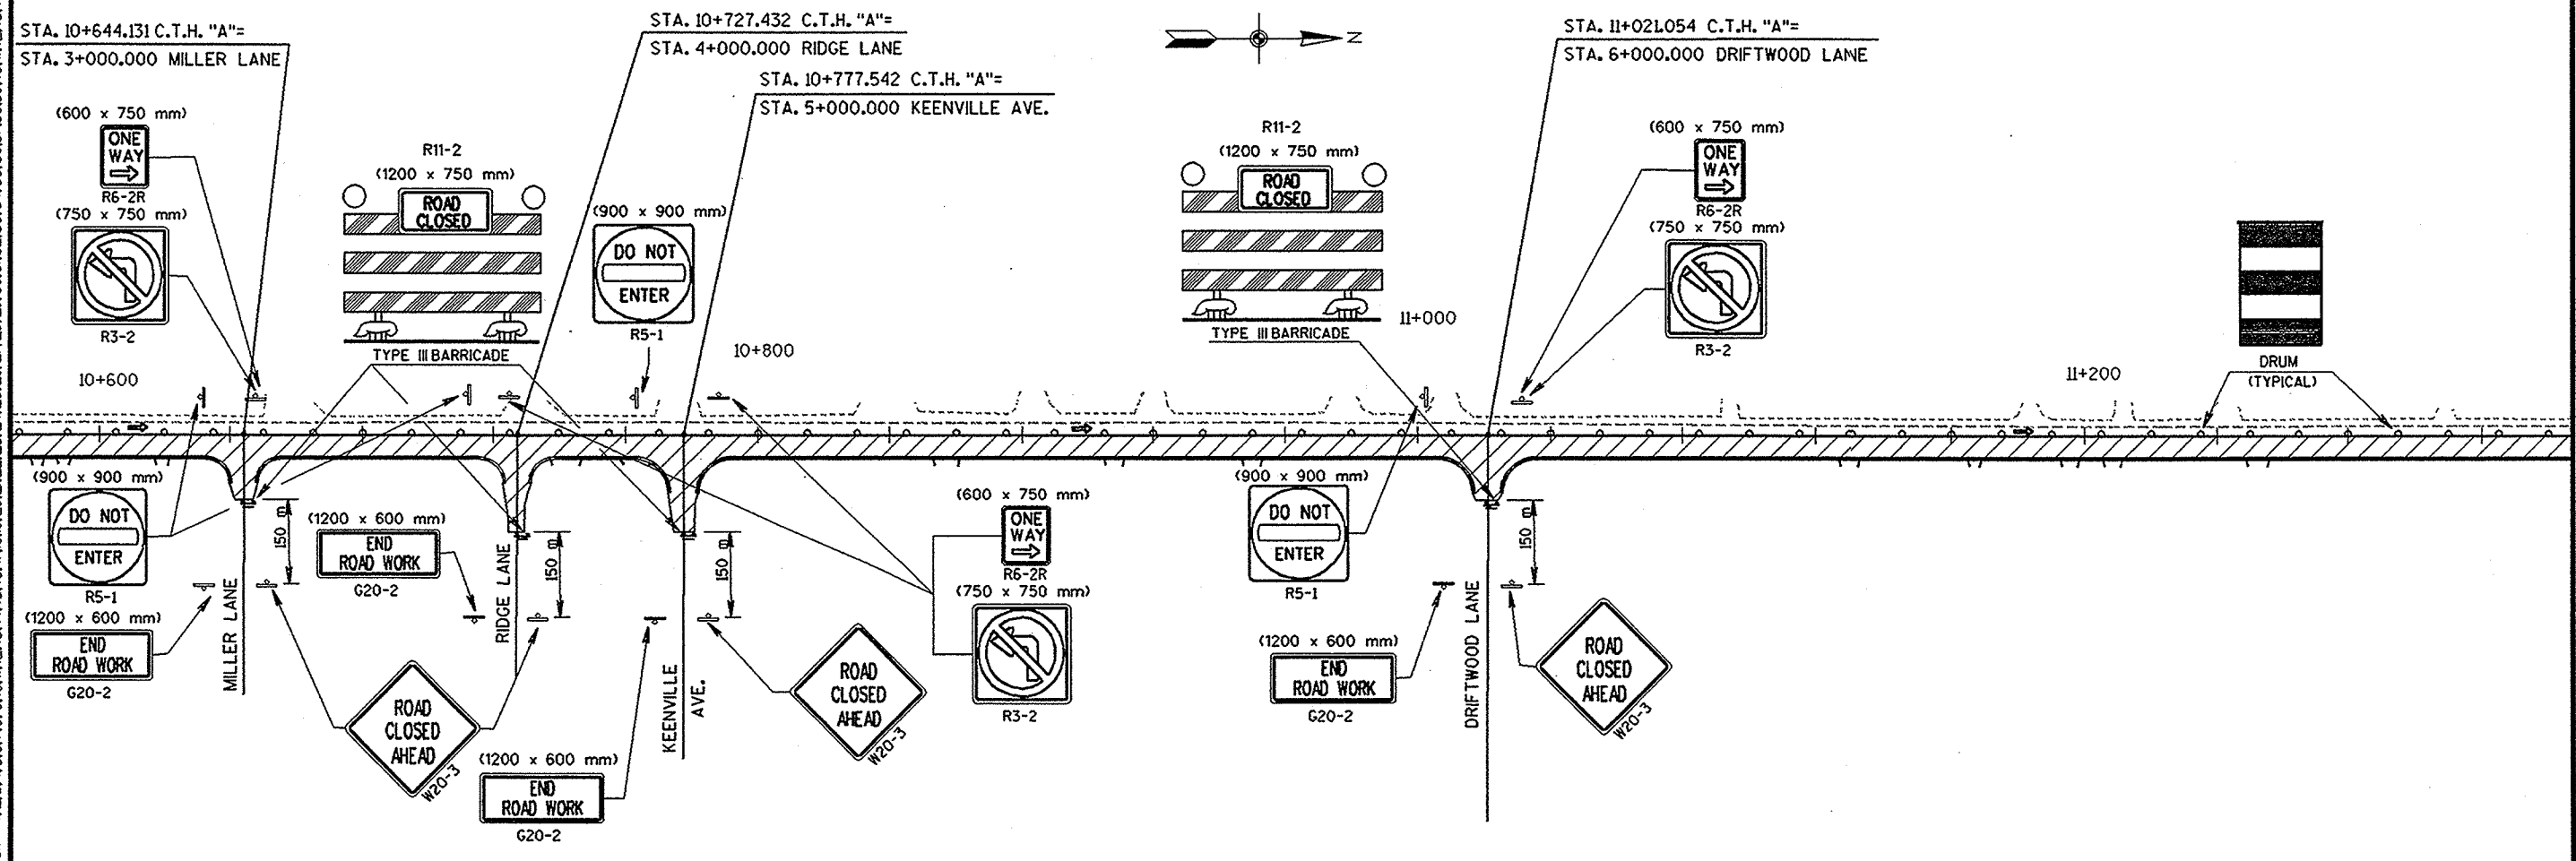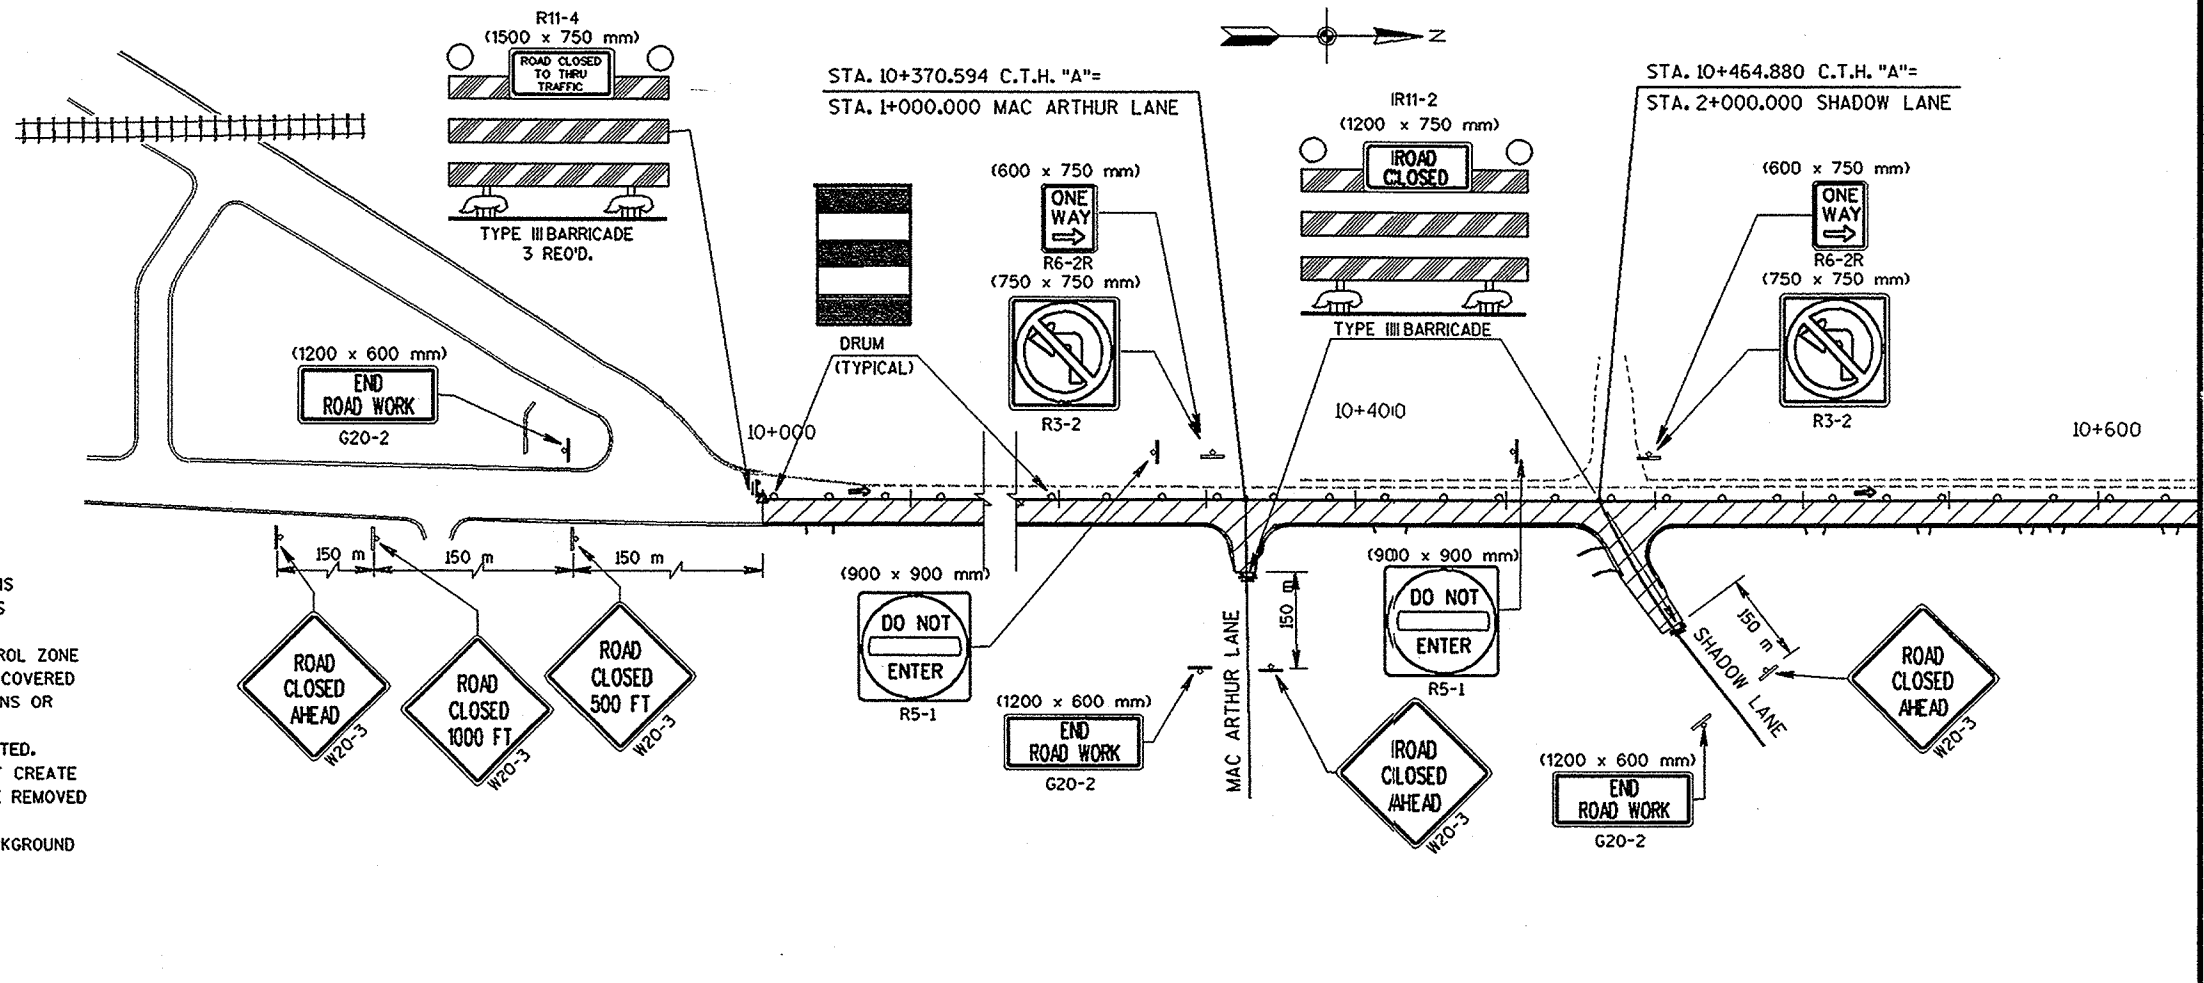


ORIGINATOR: D.J.D. DATE: 2/3/99
 PROJECT NO: 440278-00 FILE NAME:
 REVISIONS: BY: DATE: REVISIONS:
 LEVELS ON: 1, 2, 3, 48, 50, 51, 52, 53, 54, 55, 56, 57, 58, 59, 60, 61, 62.
 PLOT NAME: SCALE: 1:
 DESIGN FILE IS: I:\440278\CONTRACT\TRAFFIC2.DGN
 PEN TABLE = 4plot723user4mv80pp.tbl
 DATE OF PLOT = 07/14/99
 PLOT NO
 GB2

GENERAL NOTES FOR TRAFFIC CONTROL

1. THE EXACT NUMBER, LOCATION, AND SPACING OF ALL SIGNS AND DEVICES SHALL BE ADJUSTED TO FIT FIELD CONDITIONS DIRECTED BY THE ENGINEER.
2. ALL SIGNS INAPPROPRIATE TO THE STATUS OF THE CONTROL ZONE INCLUDING PRE-EXISTING SIGNING IN THE VICINITY, SHALL BE COVERED AS SPECIFIED IN THE PLANS AND/OR THE SPECIAL PROVISIONS OR AS DIRECTED BY THE ENGINEER.
3. ALL SIGNS ARE 1200 x 1200 mm UNLESS OTHERWISE NOTED.
4. PAVEMENT MARKING NO LONGER APPLICABLE WHICH MIGHT CREATE CONFUSION IN THE MINDS OF VEHICLE OPERATORS SHALL BE REMOVED PRIOR TO OPENING TO TRAFFIC.
5. ALL "W0" SIGNS ARE THE SAME AS "W" EXCEPT THE BACKGROUND IS ORANGE.
6. ALL TYPE III BARRICADES ARE TO BE 2.4 m LONG.





SYMBOLS	
	STAGE CONSTRUCTION AREA
	SIGN ON PERMANENT SUPPORT
	NON-METALLIC DRUMS WITH TYPE "C" STEADY BURN LIGHTS, SPACED AT 15 m TYPICAL
	NON-METALLIC DRUMS SPACED AT 15 m TYPICAL
	DIRECTION OF TRAFFIC FLOW
	TYPE III BARRICADE WITH SIGN AND TYPE "A" WARNING LIGHTS
	FLEXIBLE TUBULAR MARKER POSTS AND BASES, 7.5 m TYPICAL

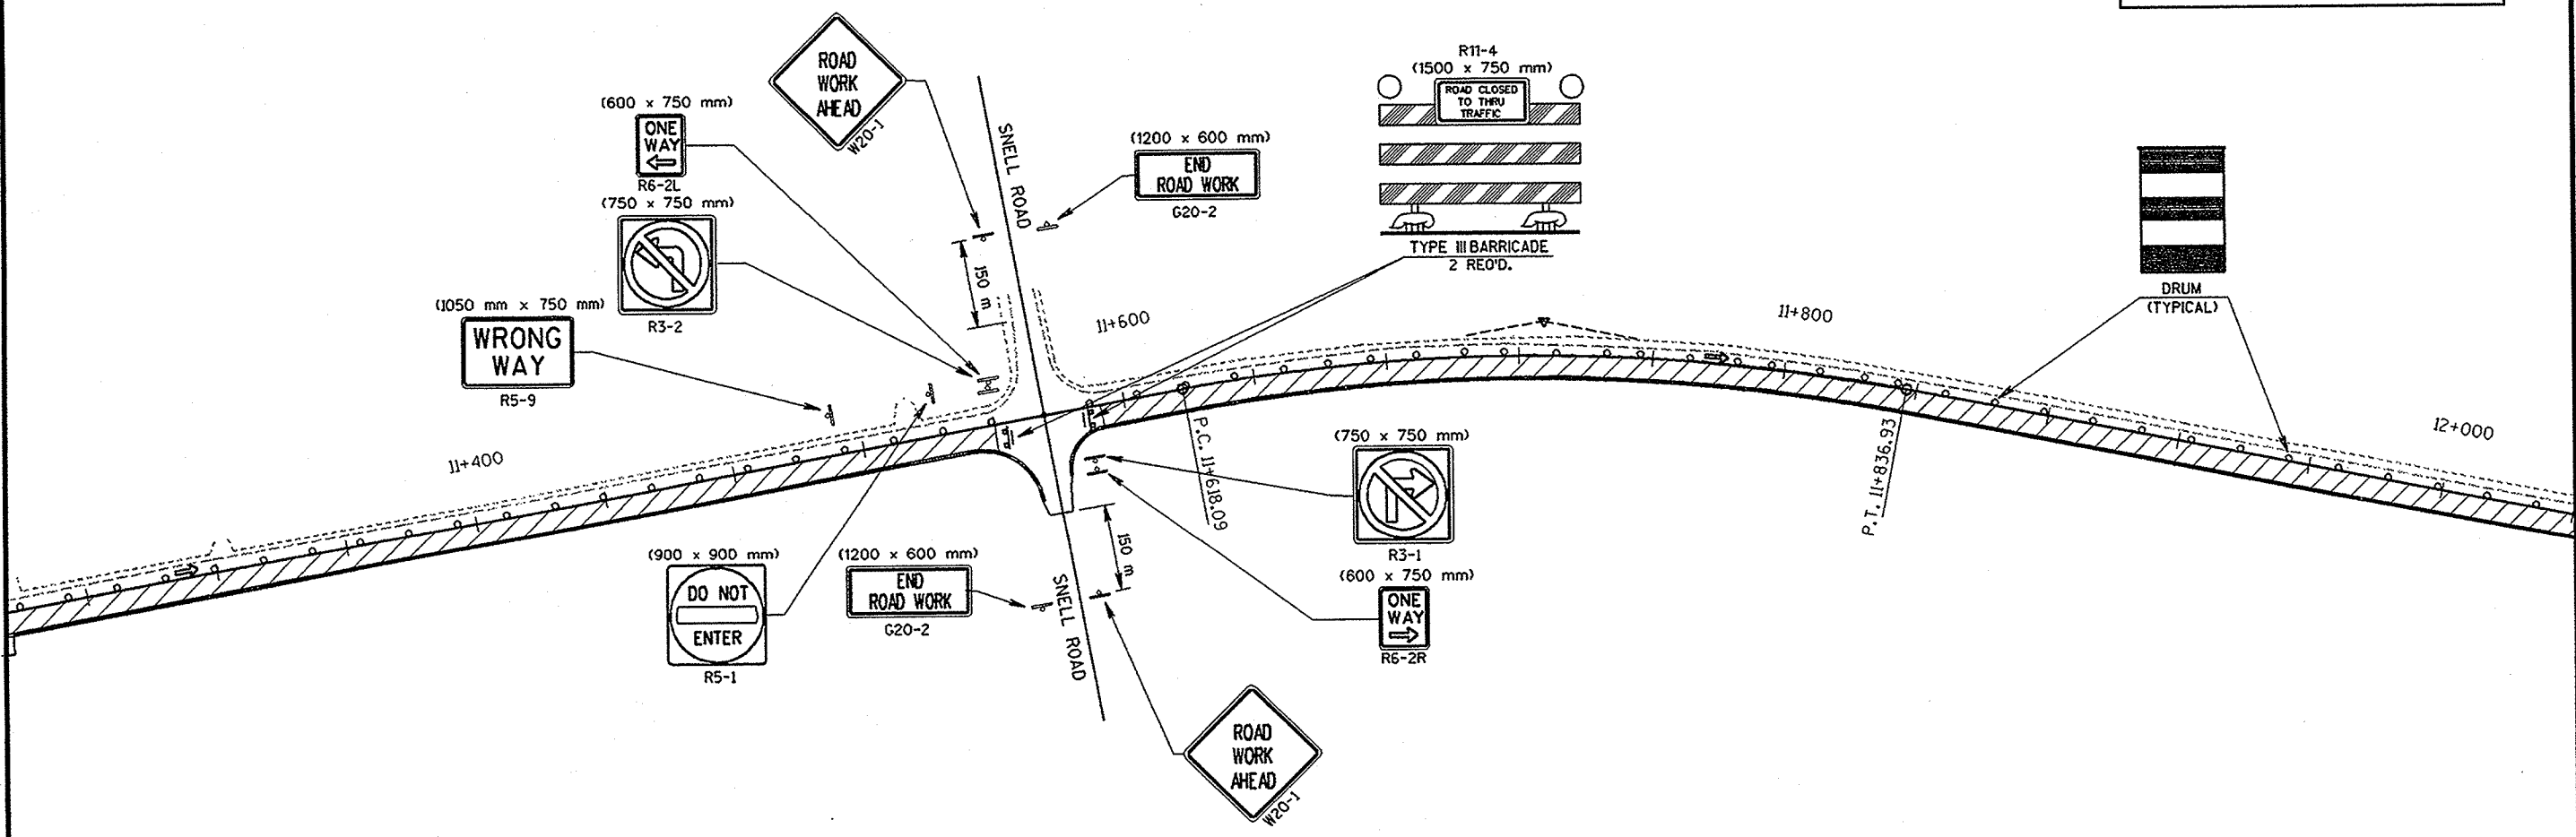

WISDOT: MSHT42

GB2
 PEN TABLE = aplot724toser+mv80pp.tbl
 DATE OF PLOT = 07/30/99
 PLOT NO.
 DESIGN FILE IS I:\440278.DGN\TRAFFIC3.DGN

50, 51, 52, 53, 54, 55, 56, 57, 58, 59, 60, 61, 62.
 17, 18, 19, 20, 21, 22, 23, 24, 25, 26, 27, 28, 29, 30, 31, 32, 33, 34, 35, 36, 37, 38, 39, 40, 41, 42, 43, 44, 45, 46, 47, 48.
 ORIGINAL D.D. DATE: 1/19/99
 PROJECT NO. 440278.00
 REVISIONS BY: FILE NAME:
 DATE REVISED:
 LEVELS ON - 1, 2, 3, 4, 5, 6, 7, 8, 9, 10, 11, 12, 13, 14, 15, 16, 17, 18, 19, 20, 21, 22, 23, 24, 25, 26, 27, 28, 29, 30, 31, 32, 33, 34, 35, 36, 37, 38, 39, 40, 41, 42, 43, 44, 45, 46, 47, 48.

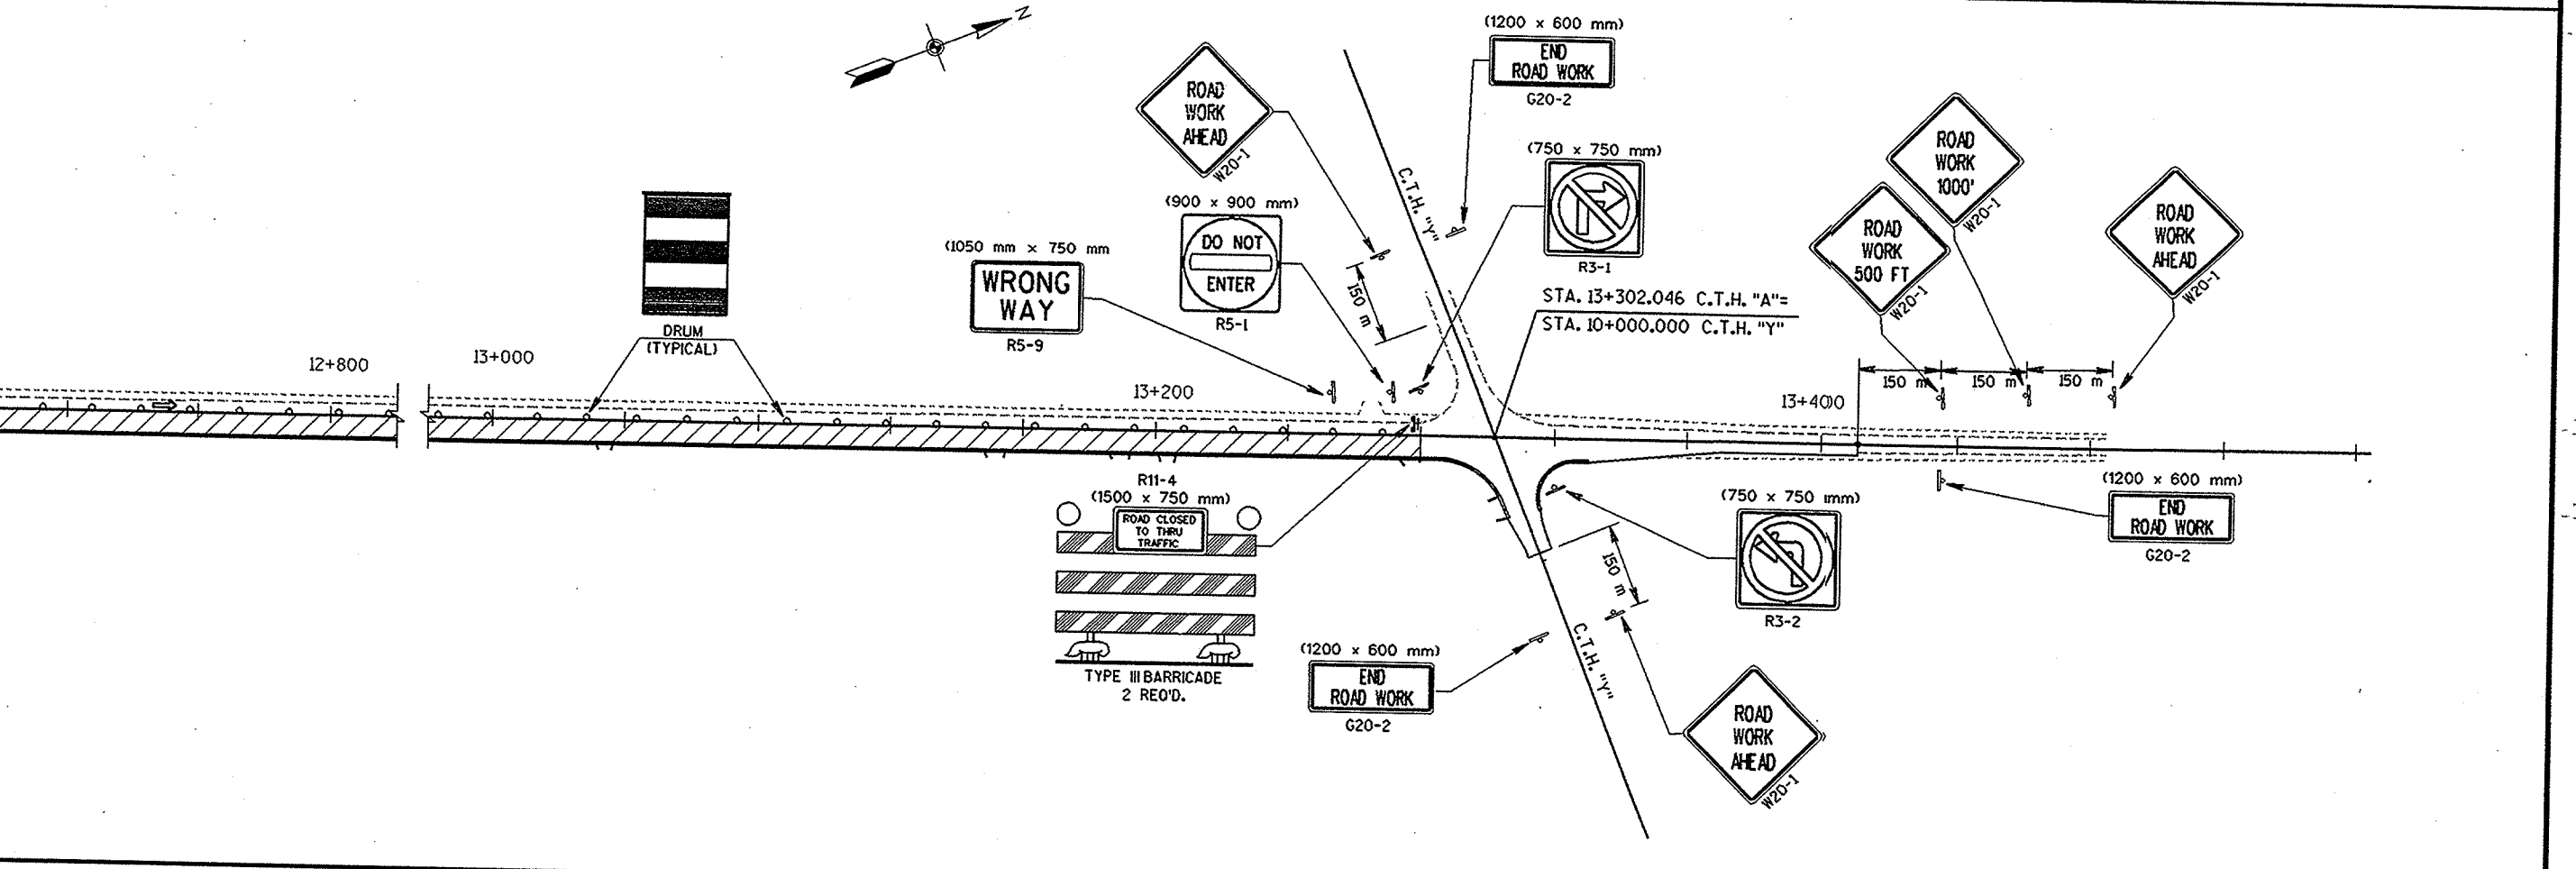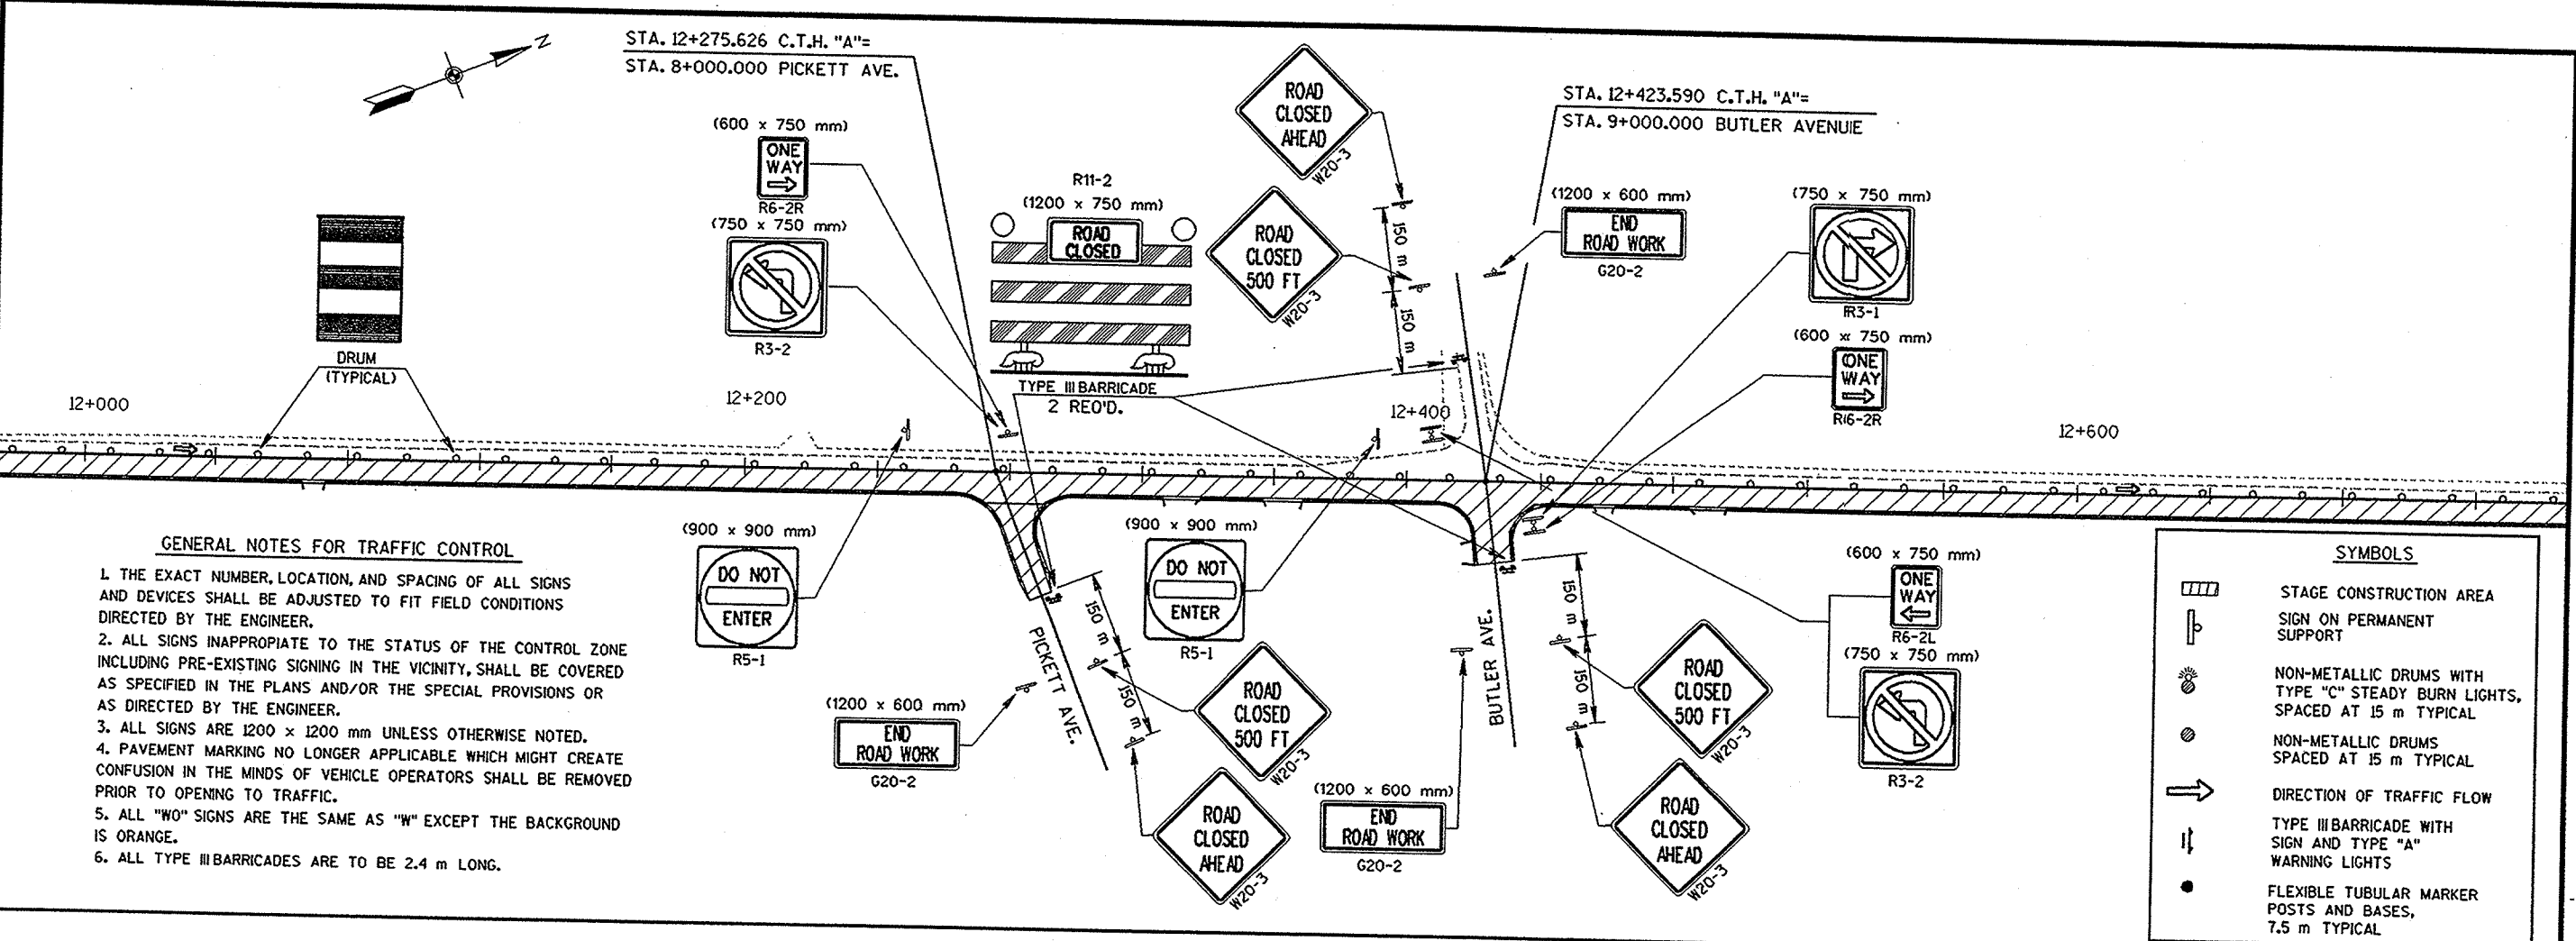

GB2
 PEN TABLE = plot724laser-1mv80pp.tbl
 DATE OF PLOT = 03/22/99
 PLOT NO
 DESIGN FILE IS I:\440278\ dgn\trfiff2-2.dgn


ORIGINATOR: DJD
 PROJECT NO.: 440278.00
 DATE: 2/3/99
 FILE NAME:
 PLOT NAME:
 SCALE:
 LEVELS ON - 1, 2, 3, 48, 50, 51, 52, 53, 54, 55, 56, 57, 58, 59, 60, 61, 62.

GENERAL NOTES FOR TRAFFIC CONTROL

1. THE EXACT NUMBER, LOCATION, AND SPACING OF ALL SIGNS AND DEVICES SHALL BE ADJUSTED TO FIT FIELD CONDITIONS DIRECTED BY THE ENGINEER.
2. ALL SIGNS INAPPROPRIATE TO THE STATUS OF THE CONTROL ZONE INCLUDING PRE-EXISTING SIGNING IN THE VICINITY, SHALL BE COVERED AS SPECIFIED IN THE PLANS AND/OR THE SPECIAL PROVISIONS OR AS DIRECTED BY THE ENGINEER.
3. ALL SIGNS ARE 1200 x 1200 mm UNLESS OTHERWISE NOTED.
4. PAVEMENT MARKING NO LONGER APPLICABLE WHICH MIGHT CREATE CONFUSION IN THE MINDS OF VEHICLE OPERATORS SHALL BE REMOVED PRIOR TO OPENING TO TRAFFIC.
5. ALL "WO" SIGNS ARE THE SAME AS "W" EXCEPT THE BACKGROUND IS ORANGE.
6. ALL TYPE III BARRICADES ARE TO BE 2.4 m LONG.



SYMBOLS	
	STAGE CONSTRUCTION AREA
	SIGN ON PERMANENT SUPPORT
	NON-METALLIC DRUMS WITH TYPE "C" STEADY BURN LIGHTS, SPACED AT 15 m TYPICAL
	NON-METALLIC DRUMS SPACED AT 15 m TYPICAL
	DIRECTION OF TRAFFIC FLOW
	TYPE III BARRICADE WITH SIGN AND TYPE "A" WARNING LIGHTS
	FLEXIBLE TUBULAR MARKER POSTS AND BASES, 7.5 m TYPICAL

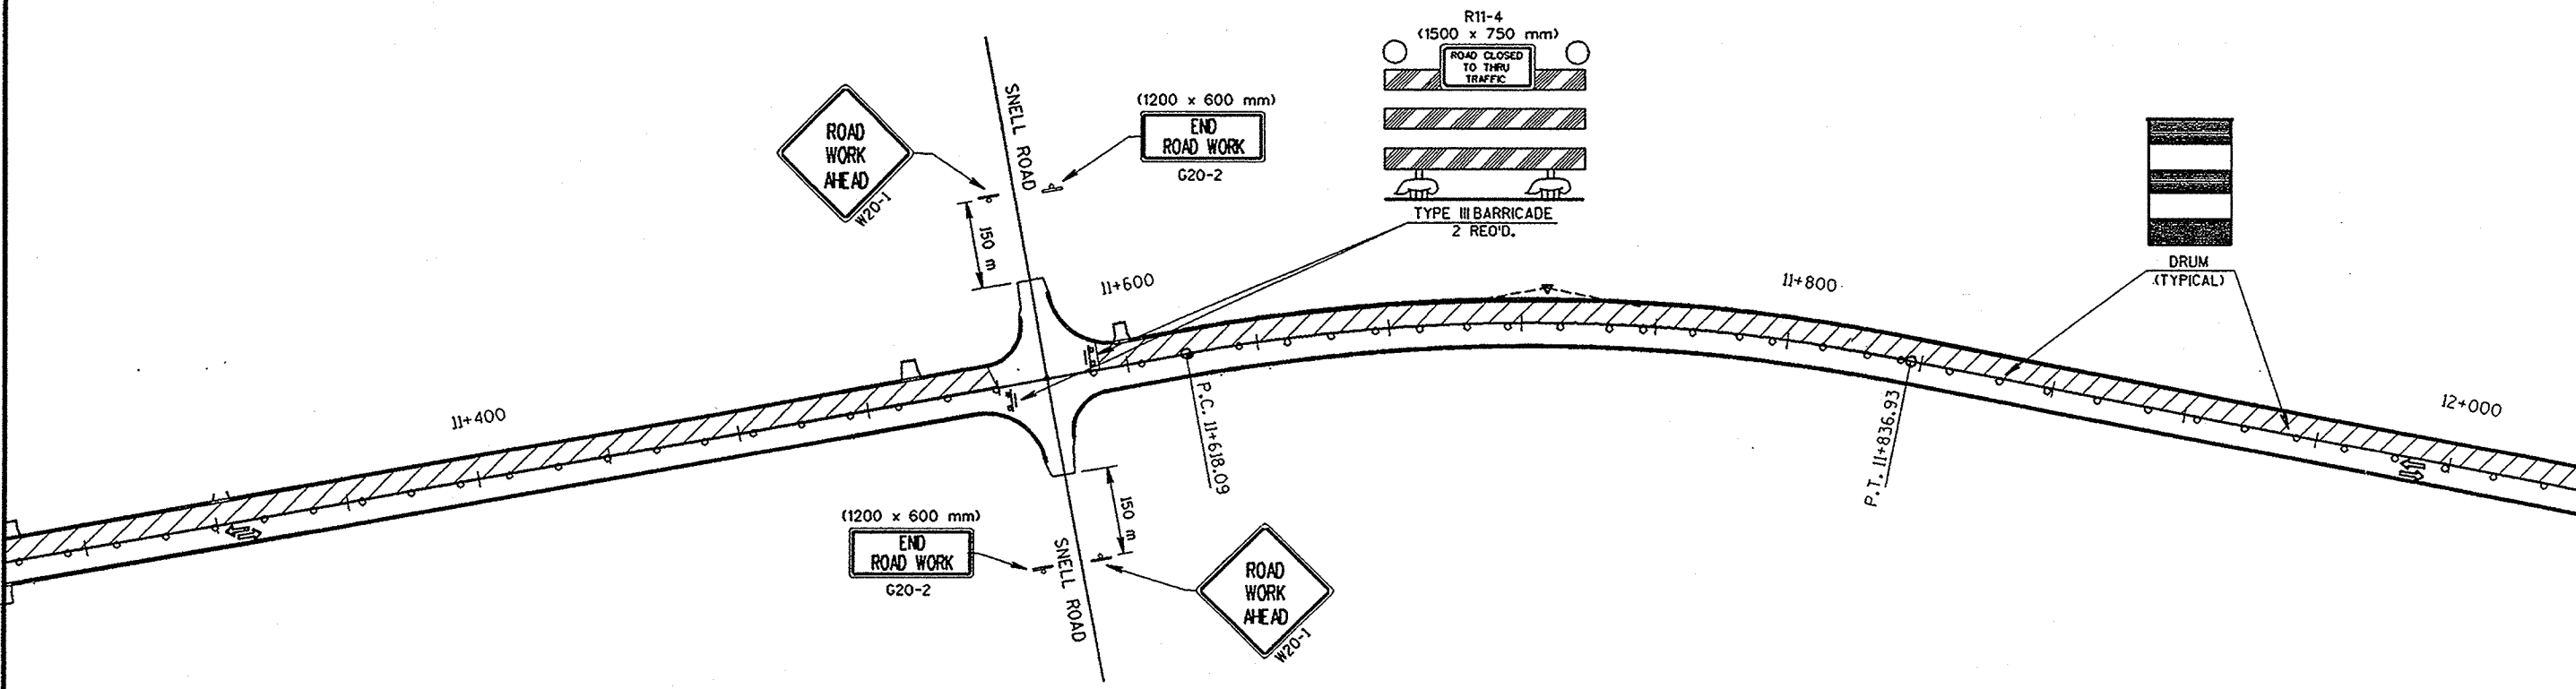

WISDOT: MSPT-42

GR2
 PEN TABLE = plot724hose+tm80pp.tbl
 DATE OF PLOT = 03/19/99
 PLOT NO = 440278
 DESIGN FILE IS EA440278\gn\traff2-1.dgn

ORIGINATOR: DJD
 DATE: 2/3/99
 FILE NAME: 440278.dwg
 REVISION: 1
 DATE REVISED: 1/2/99



ORIGINATOR: DJD
 DATE: 2/3/99
 FILE NAME: 440278.dwg
 REVISION: 1
 DATE REVISED: 1/2/99

SYMBOLS

- STAGE CONSTRUCTION AREA
- SIGN ON PERMANENT SUPPORT
- NON-METALLIC DRUMS WITH TYPE "C" STEADY BURN LIGHTS, SPACED AT 15 m TYPICAL
- NON-METALLIC DRUMS SPACED AT 15 m TYPICAL
- DIRECTION OF TRAFFIC FLOW
- TYPE III BARRICADE WITH SIGN AND TYPE "A" WARNING LIGHTS
- FLEXIBLE TUBULAR MARKER POSTS AND BASES, 7.5 m TYPICAL

GENERAL NOTES FOR TRAFFIC CONTROL

1. THE EXACT NUMBER, LOCATION, AND SPACING OF ALL SIGNS AND DEVICES SHALL BE ADJUSTED TO FIT FIELD CONDITIONS DIRECTED BY THE ENGINEER.
2. ALL SIGNS INAPPROPRIATE TO THE STATUS OF THE CONTROL ZONE INCLUDING PRE-EXISTING SIGNING IN THE VICINITY, SHALL BE COVERED AS SPECIFIED IN THE PLANS AND/OR THE SPECIAL PROVISIONS OR AS DIRECTED BY THE ENGINEER.
3. ALL SIGNS ARE 1200 x 1200 mm UNLESS OTHERWISE NOTED.
4. PAVEMENT MARKING NO LONGER APPLICABLE WHICH MIGHT CREATE CONFUSION IN THE MINDS OF VEHICLE OPERATORS SHALL BE REMOVED PRIOR TO OPENING TO TRAFFIC.
5. ALL "W0" SIGNS ARE THE SAME AS "W" EXCEPT THE BACKGROUND IS ORANGE.
6. ALL TYPE III BARRICADES ARE TO BE 2.4 m LONG.

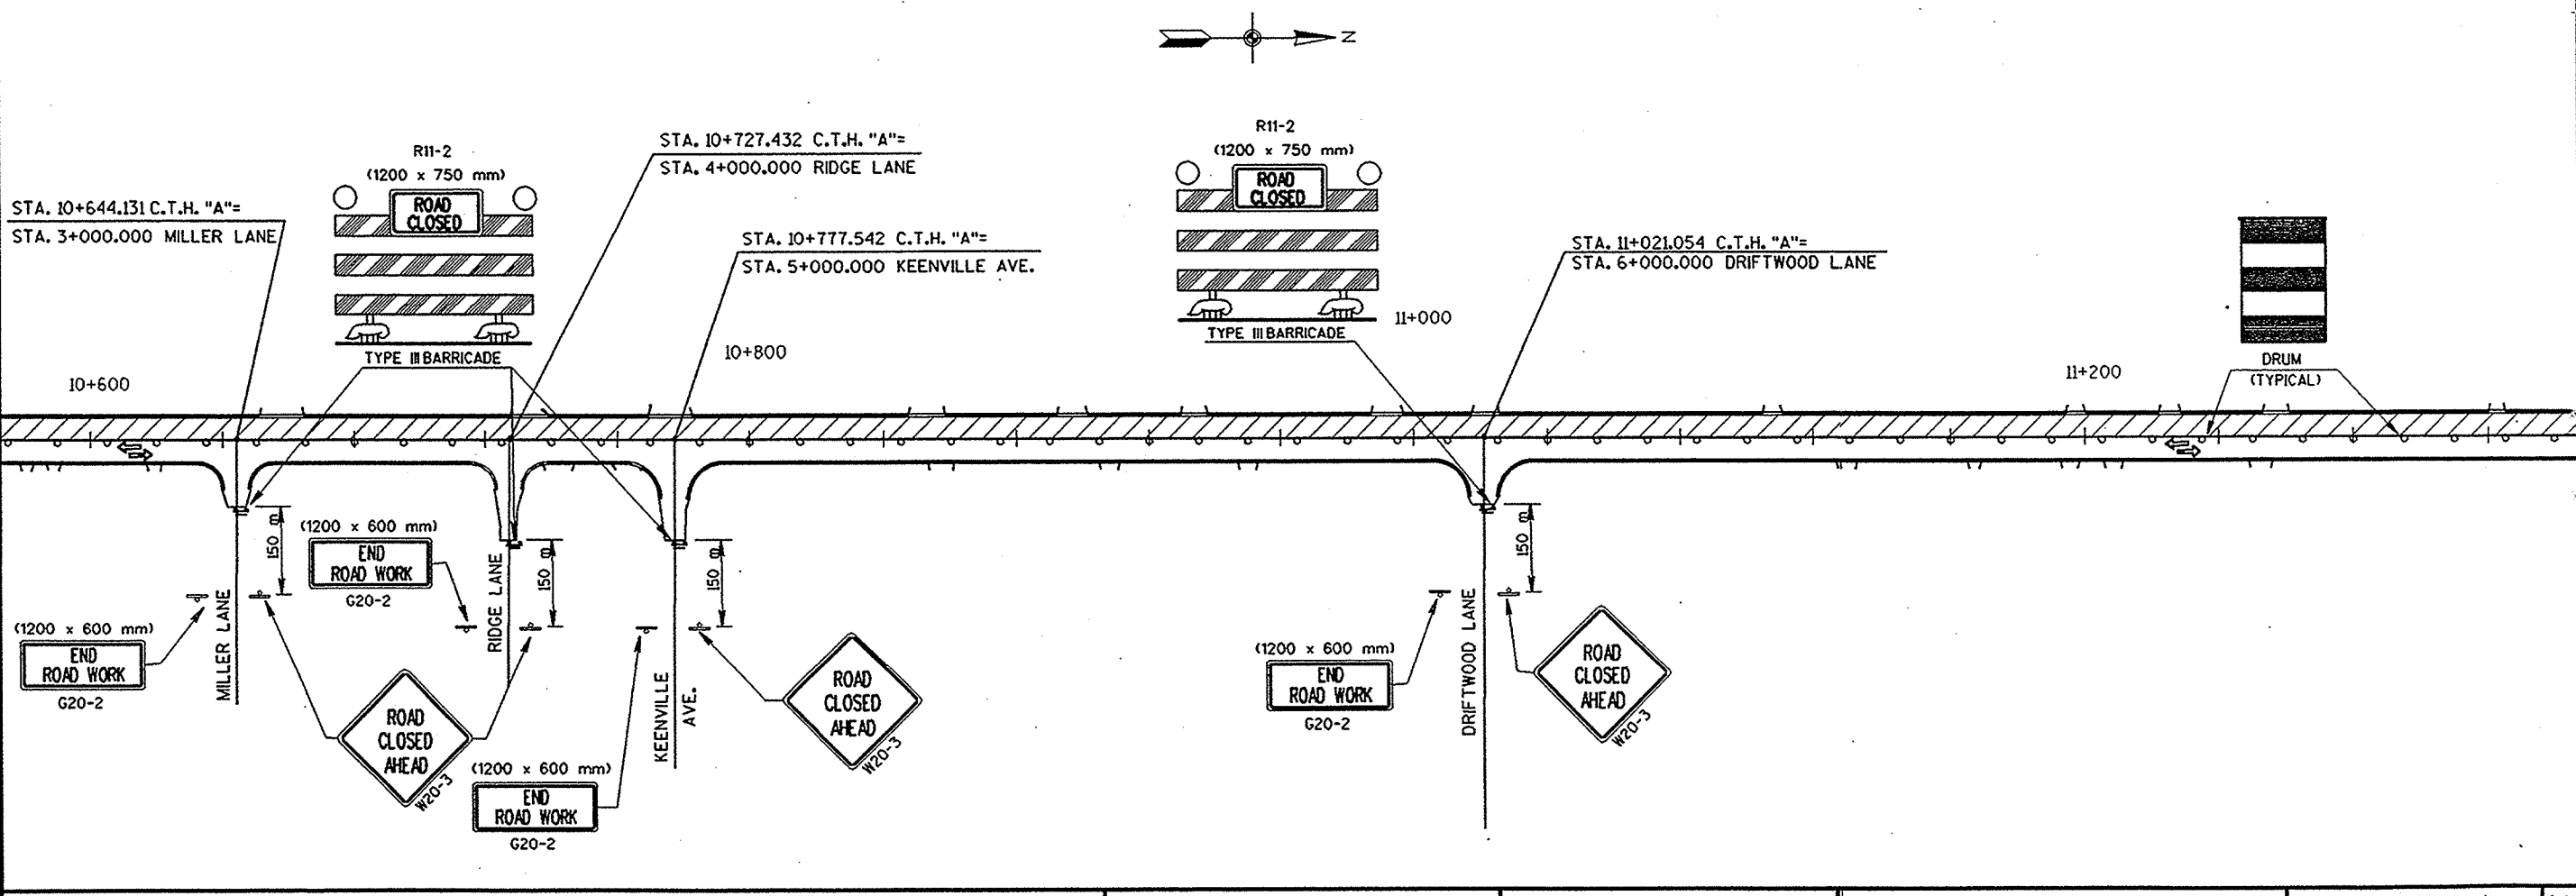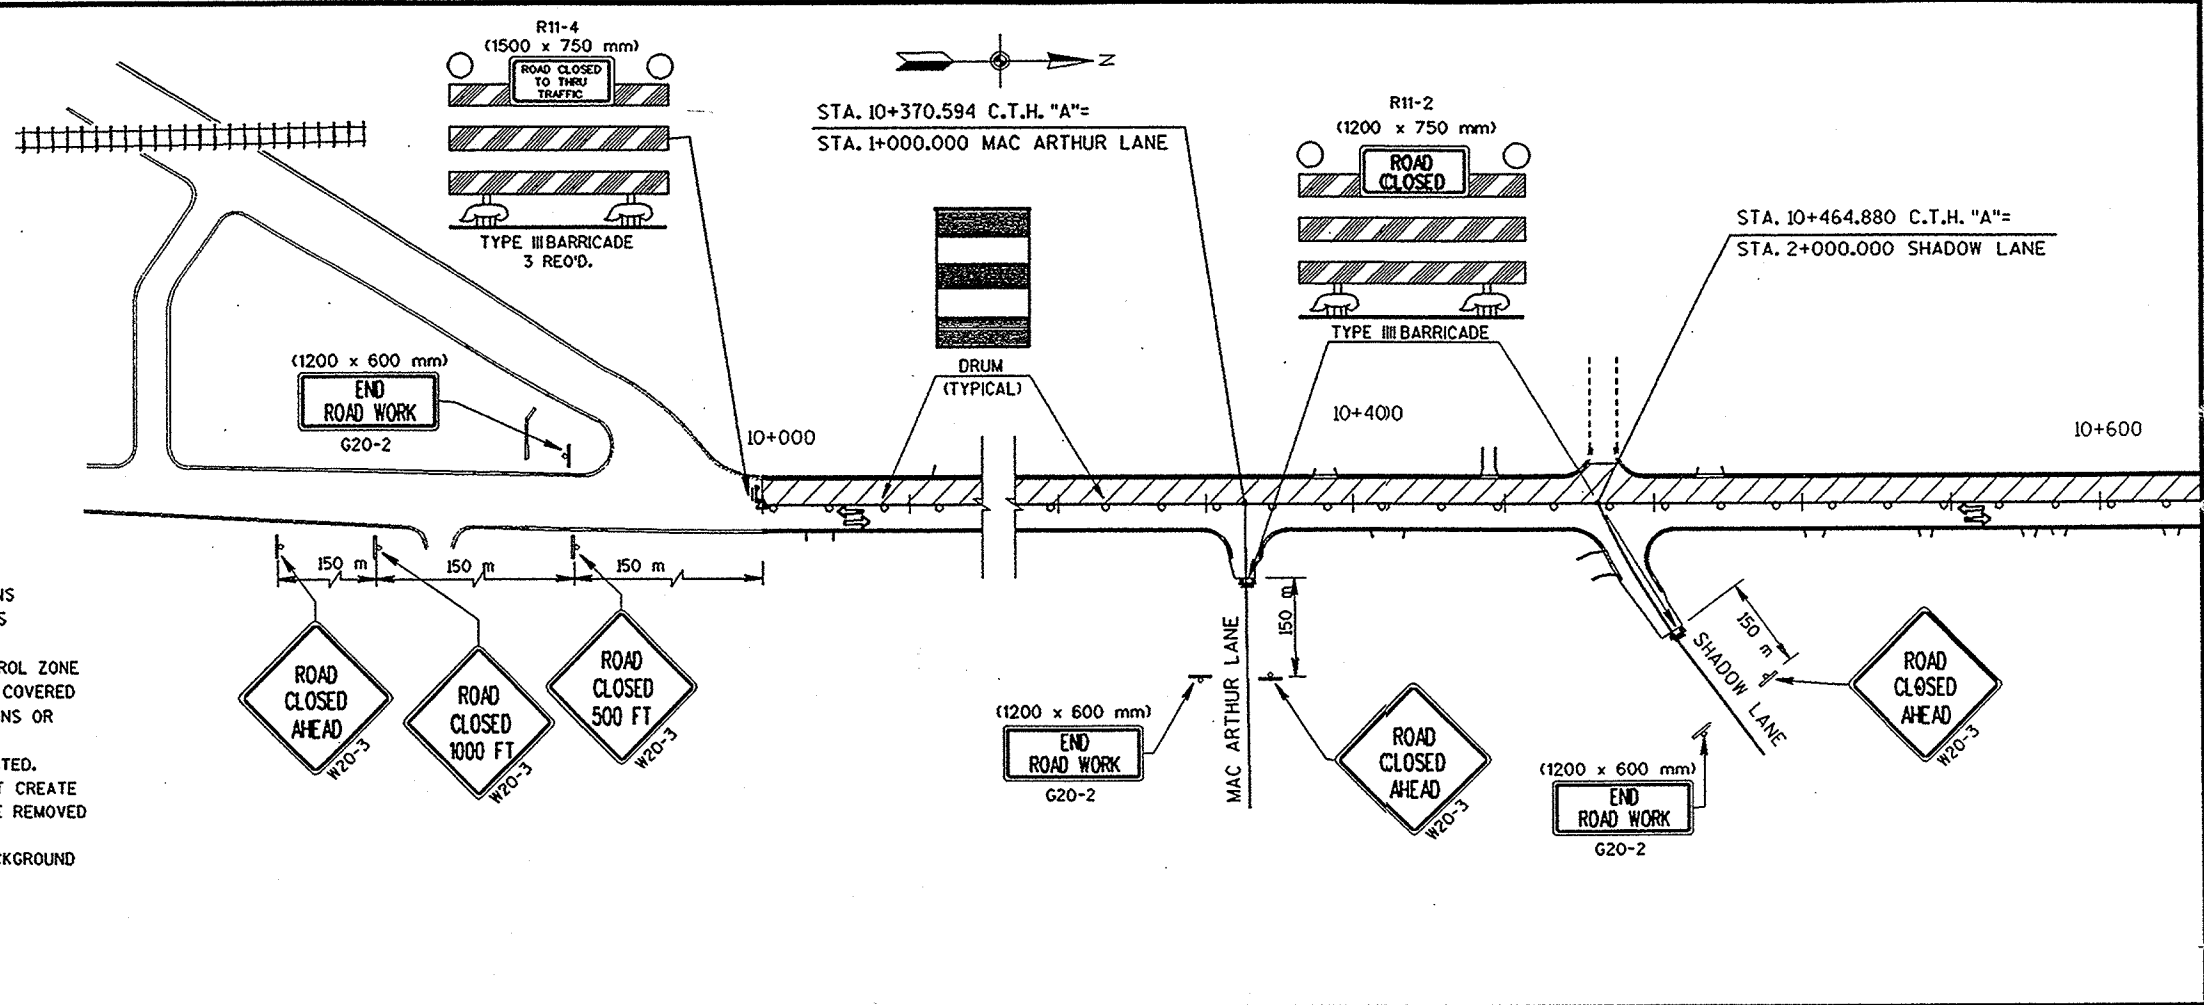

TRAFFIC CONTROL (PHASE 2)

HWY: C.T.H. "A"

COUNTY: WINNEBAGO


STATE PROJECT NO: 4994-00-78

SHEET NO: Z-11

M

CB2
 PEN TABLE = 4plot72laser-amv80pp.tbl
 DATE OF PLOT = 03/22/99
 PLOT NO
 DESIGN FILE IS I:\440278\dgn\trif2-3.dgn


ORIGINATOR: DJD
 PROJECT NO.: 440278.00
 DATE: 1/15/99
 FILE NAME:
 SCALE:
 LEVELS ON = 1, 2, 3, 48, 50, 51, 52, 53, 54, 55, 56, 57, 58, 59, 60, 61, 62.

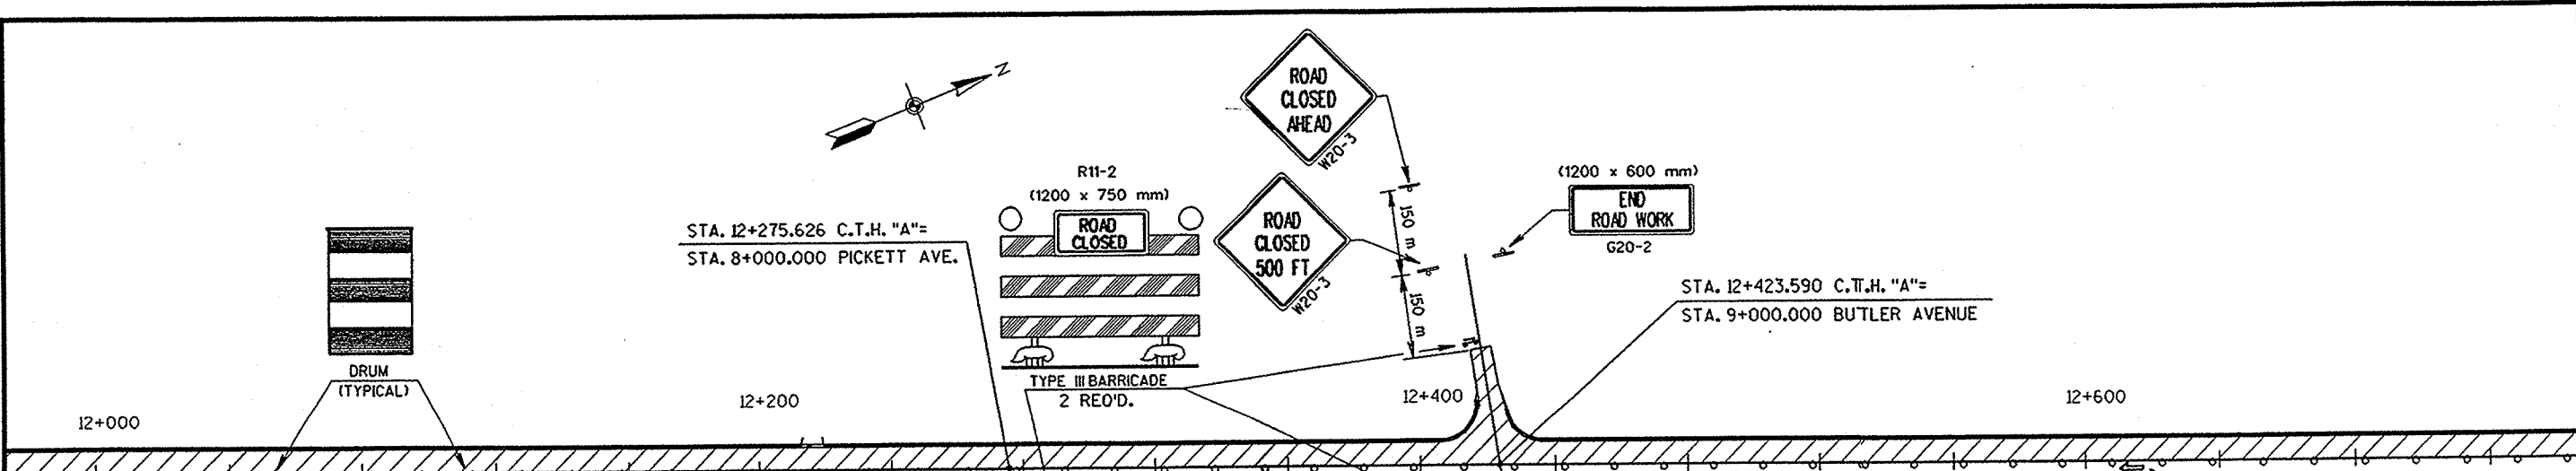

GENERAL NOTES FOR TRAFFIC CONTROL

1. THE EXACT NUMBER, LOCATION, AND SPACING OF ALL SIGNS AND DEVICES SHALL BE ADJUSTED TO FIT FIELD CONDITIONS DIRECTED BY THE ENGINEER.
2. ALL SIGNS INAPPROPRIATE TO THE STATUS OF THE CONTROL ZONE INCLUDING PRE-EXISTING SIGNING IN THE VICINITY, SHALL BE COVERED AS SPECIFIED IN THE PLANS AND/OR THE SPECIAL PROVISIONS OR AS DIRECTED BY THE ENGINEER.
3. ALL SIGNS ARE 1200 x 1200 mm UNLESS OTHERWISE NOTED.
4. PAVEMENT MARKING NO LONGER APPLICABLE WHICH MIGHT CREATE CONFUSION IN THE MINDS OF VEHICLE OPERATORS SHALL BE REMOVED PRIOR TO OPENING TO TRAFFIC.
5. ALL "WO" SIGNS ARE THE SAME AS "W" EXCEPT THE BACKGROUND IS ORANGE.
6. ALL TYPE III BARRICADES ARE TO BE 2.4 m LONG.

SYMBOLS	
	STAGE CONSTRUCTION AREA
	SIGN ON PERMANENT SUPPORT
	NON-METALLIC DRUMS WITH TYPE "C" STEADY BURN LIGHTS, SPACED AT 15 m TYPICAL
	NON-METALLIC DRUMS SPACED AT 15 m TYPICAL
	DIRECTION OF TRAFFIC FLOW
	TYPE III BARRICADE WITH SIGN AND TYPE "A" WARNING LIGHTS
	FLEXIBLE TUBULAR MARKER POSTS AND BASES, 7.5 m TYPICAL

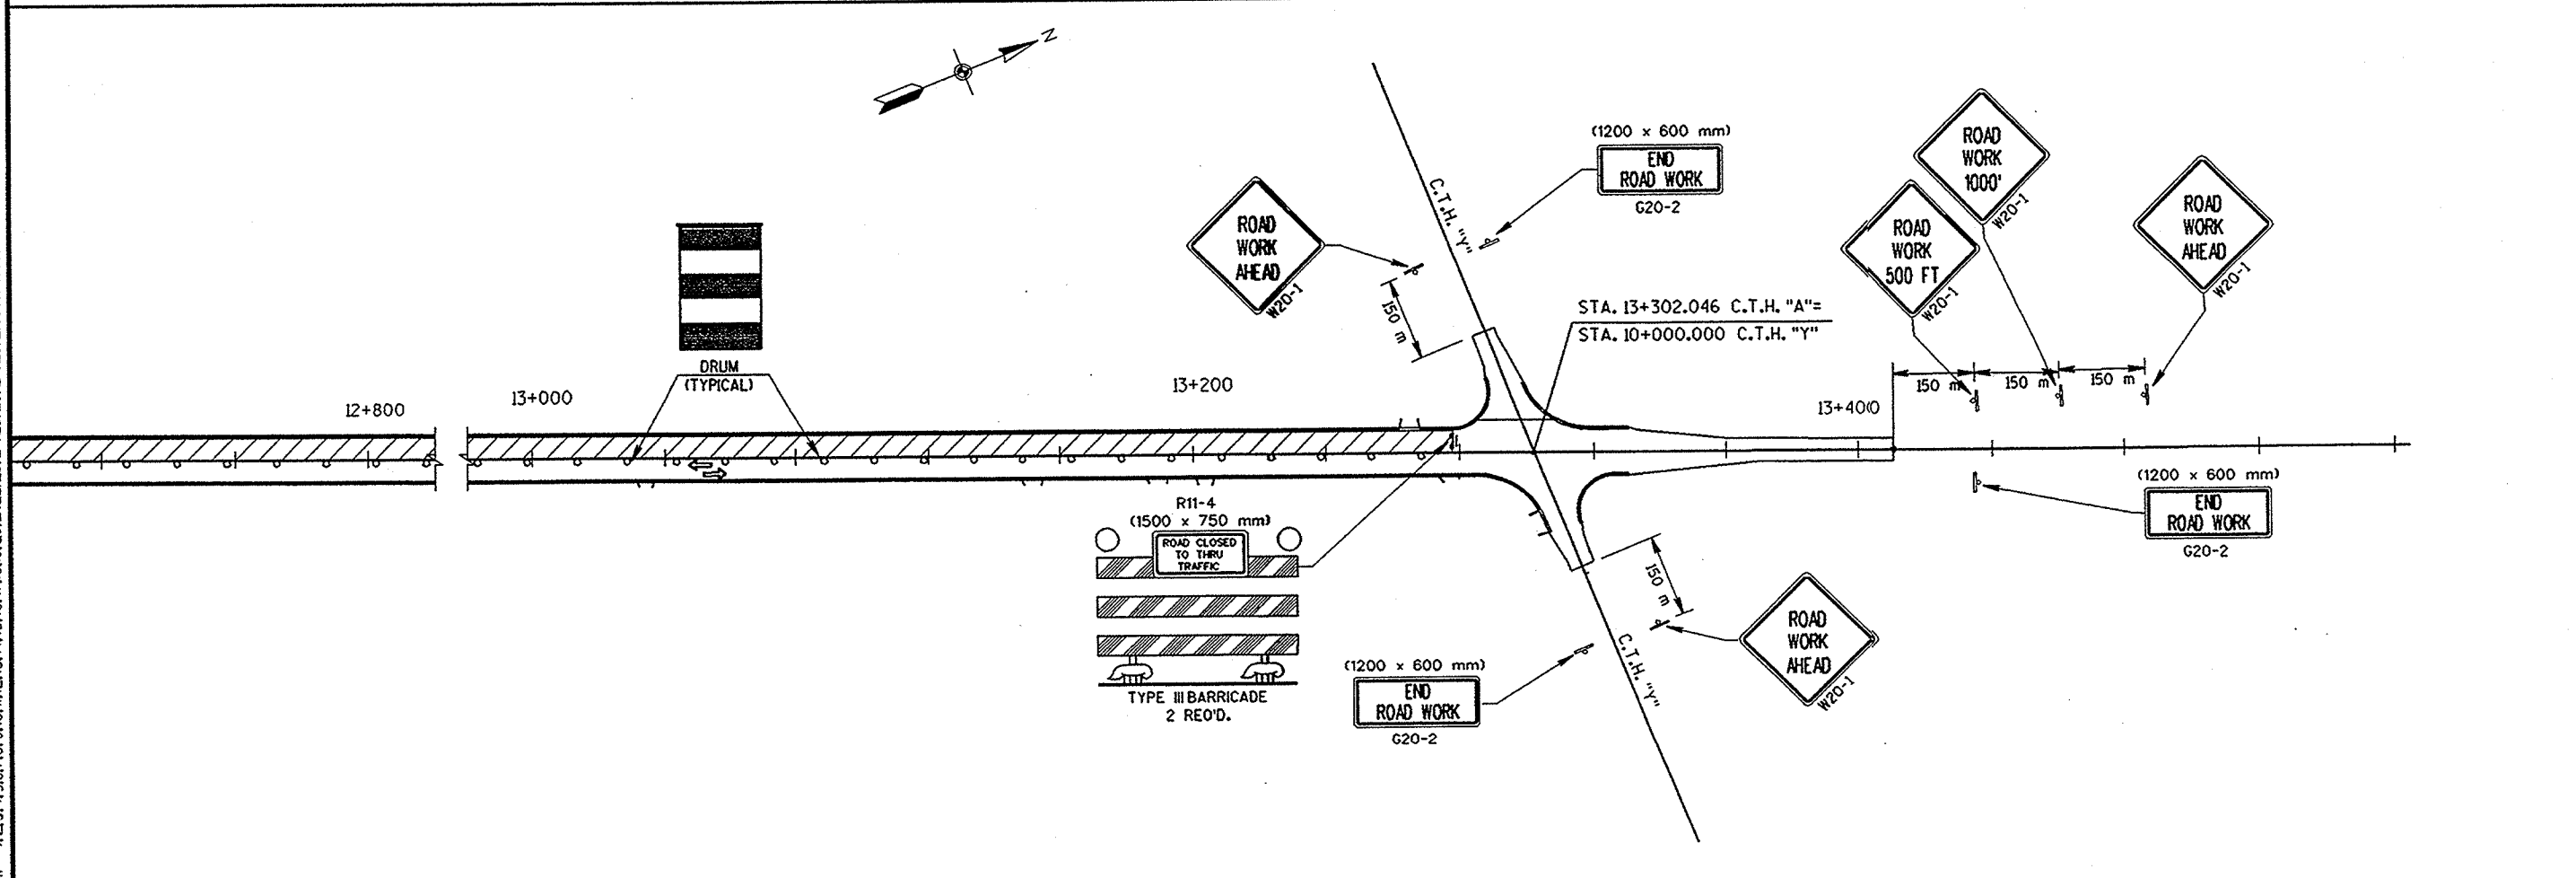


GB2
 PEN TABLE = p:\plot72\hasef4m\80pp.tbl
 DATE OF PLOT = 03/22/99
 PLOT NAME
 DESIGN FILE IS I:\440278\TRAFFIC.dgn\TRAFFIC.dgn

ORIGINATOR: D.J.D.
 DATE: 2/3/99
 FILE NAME:
 SCALE:
 REVISIONS:
 DATE REVISED:
 LEVELS ON - 1, 2, 3, 48, 50, 51, 52, 53, 54, 55, 56, 57, 58, 59, 60, 61, 62

SYMBOLS	
	STAGE CONSTRUCTION AREA
	SIGN ON PERMANENT SUPPORT
	NON-METALLIC DRUMS WITH TYPE "C" STEADY BURN LIGHTS, SPACED AT 15 m TYPICAL
	DIRECTION OF TRAFFIC FLOW
	TYPE III BARRICADE WITH SIGN ATTACHED
	FLEXIBLE TUBULAR MARKER POSTS AND BASES, 7.5 m TYPICAL




- GENERAL NOTES FOR TRAFFIC CONTROL**
1. THE EXACT NUMBER, LOCATION, AND SPACING OF ALL SIGNS AND DEVICES SHALL BE ADJUSTED TO FIT FIELD CONDITIONS DIRECTED BY THE ENGINEER.
 2. ALL SIGNS INAPPROPRIATE TO THE STATUS OF THE CONTROL ZONE INCLUDING PRE-EXISTING SIGNING IN THE VICINITY, SHALL BE COVERED AS SPECIFIED IN THE PLANS AND/OR THE SPECIAL PROVISIONS OR AS DIRECTED BY THE ENGINEER.
 3. ALL SIGNS ARE 1200 x 1200 mm UNLESS OTHERWISE NOTED.
 4. PAVEMENT MARKING NO LONGER APPLICABLE WHICH MIGHT CREATE CONFUSION IN THE MINDS OF VEHICLE OPERATORS SHALL BE REMOVED PRIOR TO OPENING TO TRAFFIC.
 5. ALL "WO" SIGNS ARE THE SAME AS "W" EXCEPT THE BACKGROUND IS ORANGE.
 6. ALL TYPE III BARRICADES ARE TO BE 2.4 m LONG.

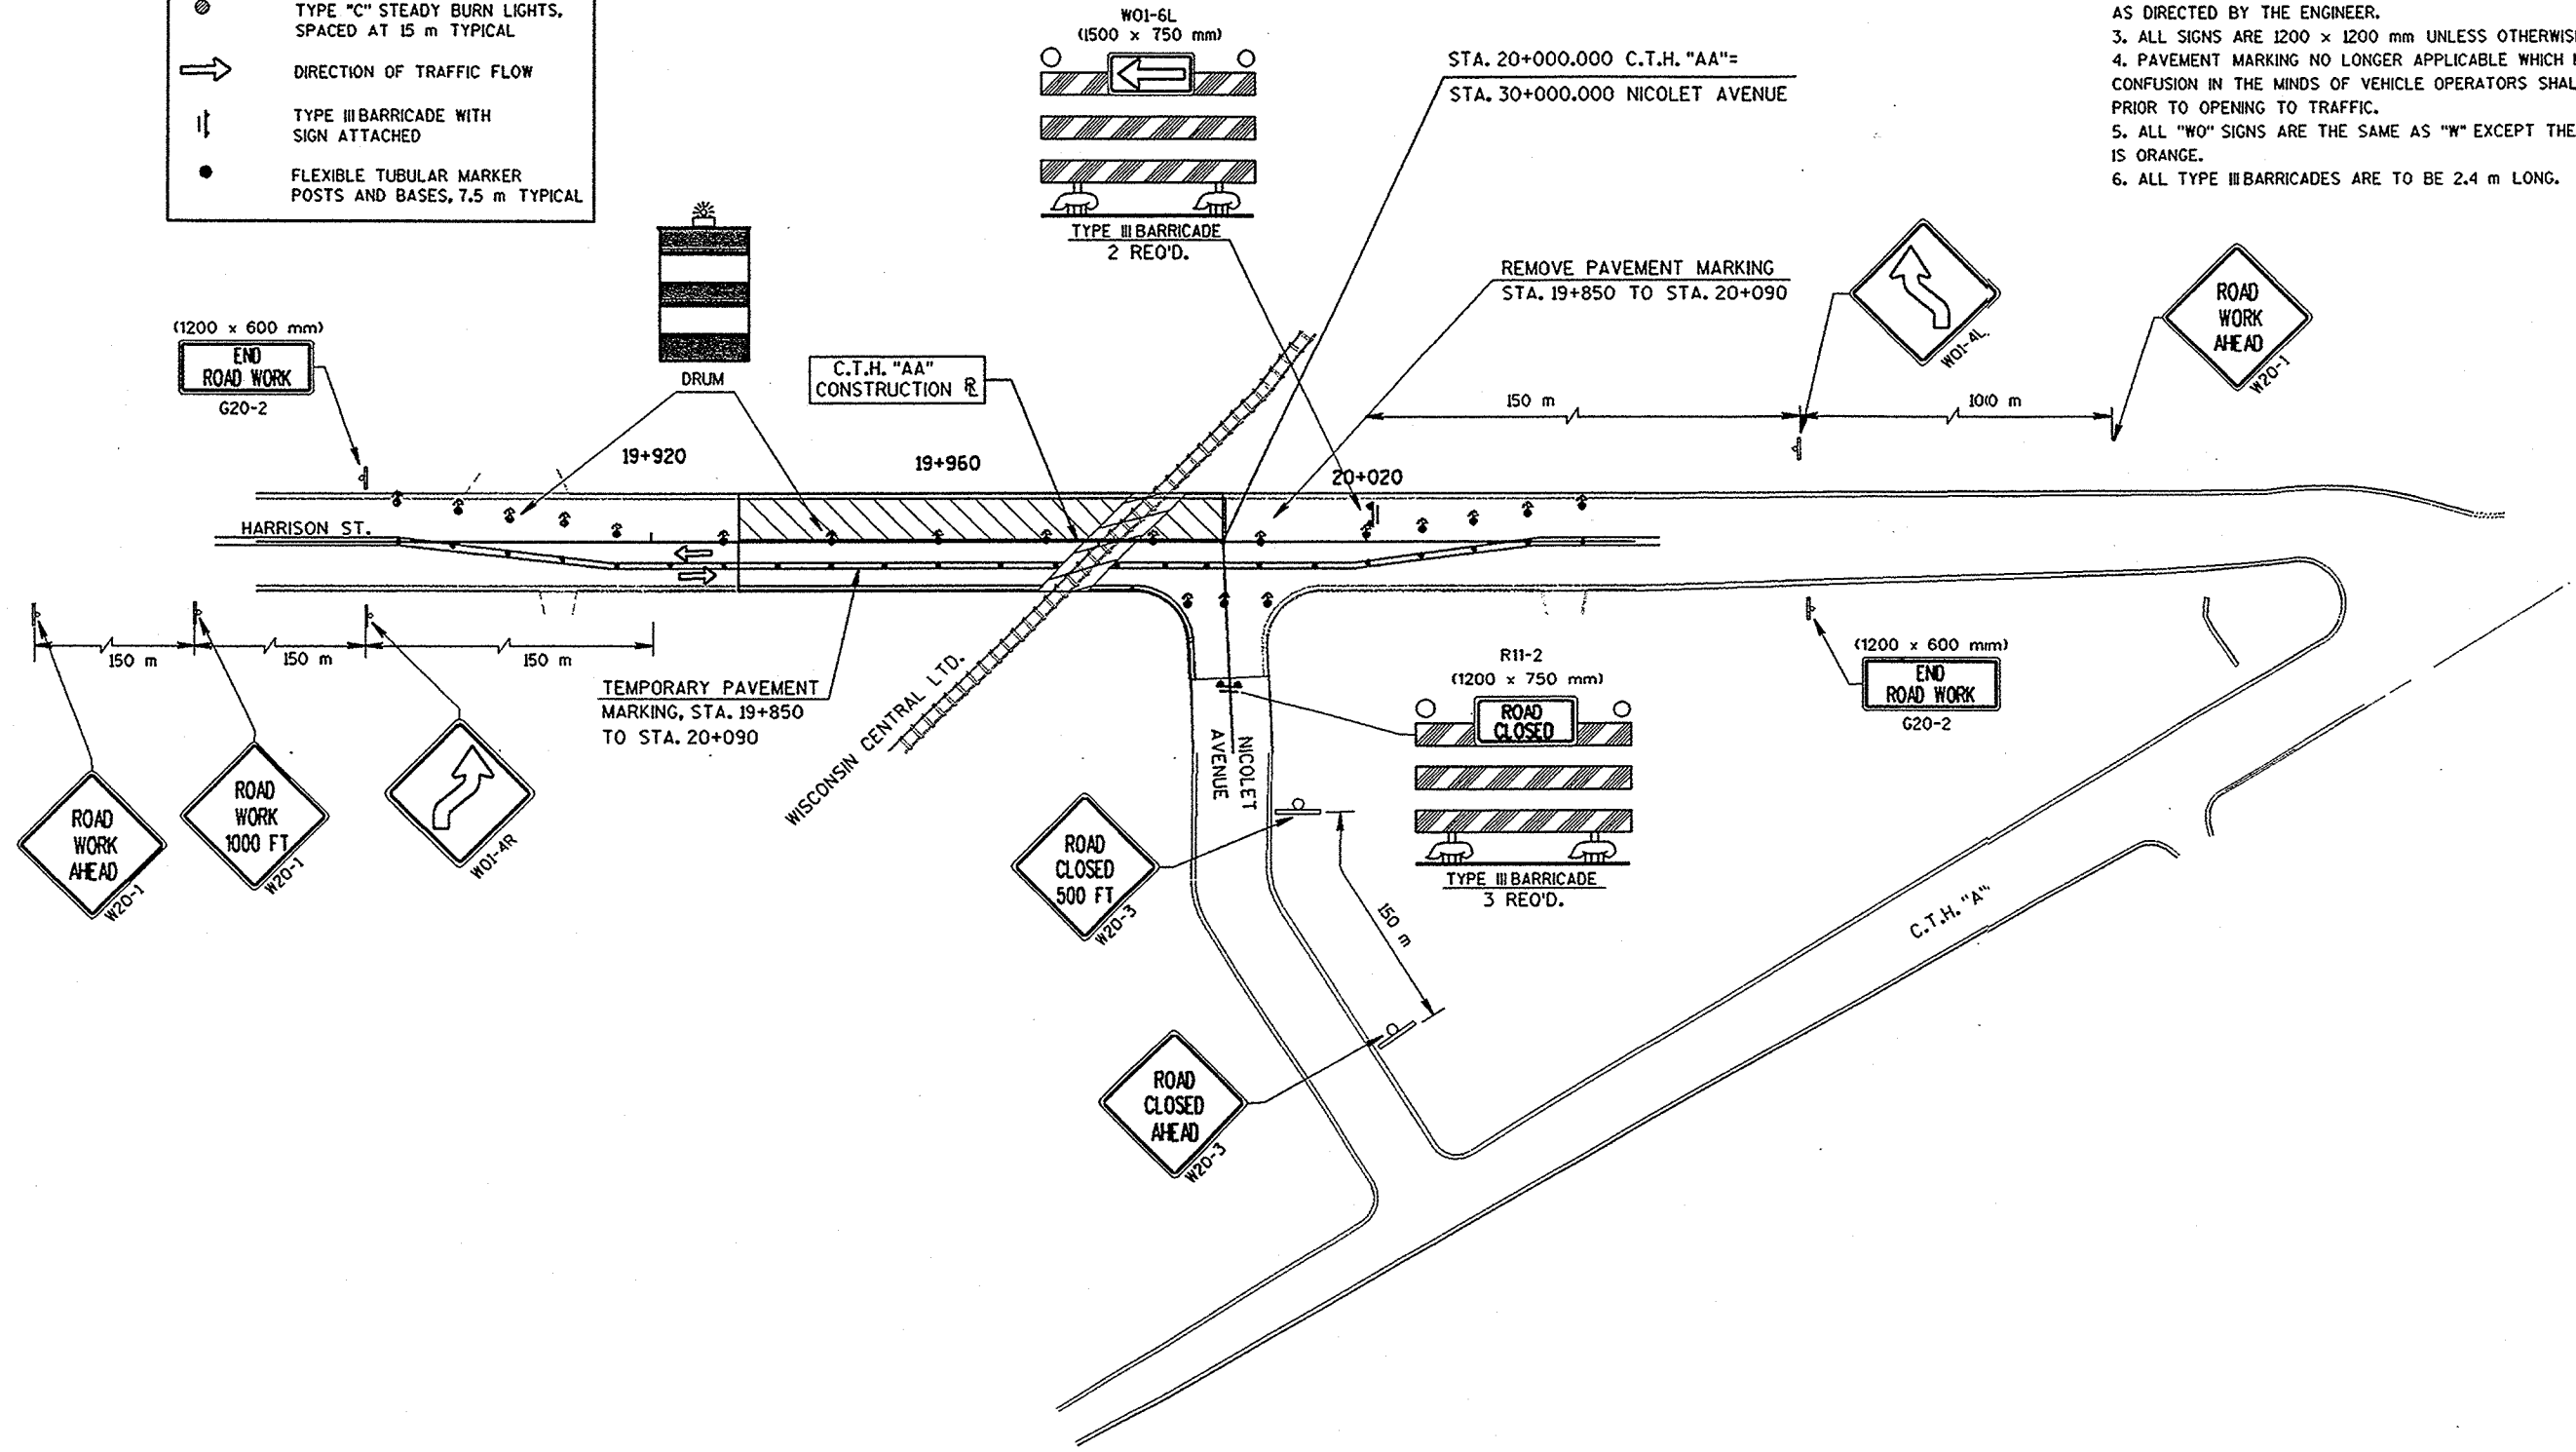


MSDOT: MS-T42

NEW SHEET

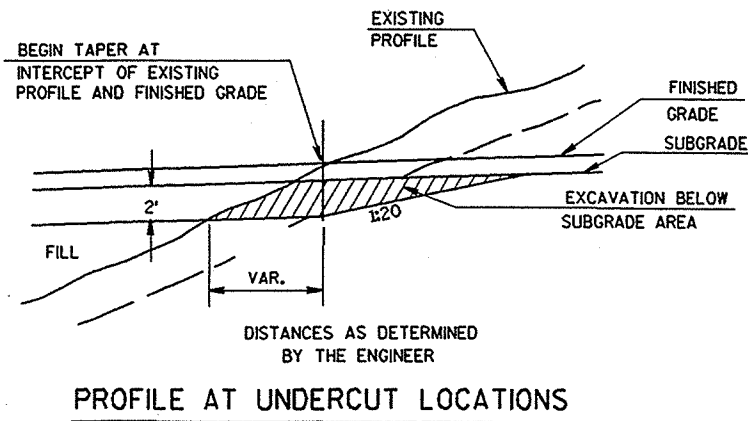


NOTE: EXCAVATE BELOW SUBGRADE ALL MOUTHS OF CUTS. EXACT LOCATIONS AND EXTENT OF EXCAVATION BELOW SUBGRADE (E.B.S.) SHALL BE DETERMINED BY ENGINEER IN THE FIELD. E.B.S. AREA TO BE BACKFILLED MUST BE HOMOGENEOUS WITH ADJOINING FILL MATERIAL ACCEPTABLE TO THE ENGINEER. THE FILL WITHIN 100-FT. OF THE MOUTH OF THE CUT MUST BE KEPT 2-FT. BELOW SUBGRADE UNTIL E.B.S. IS COMPLETED.

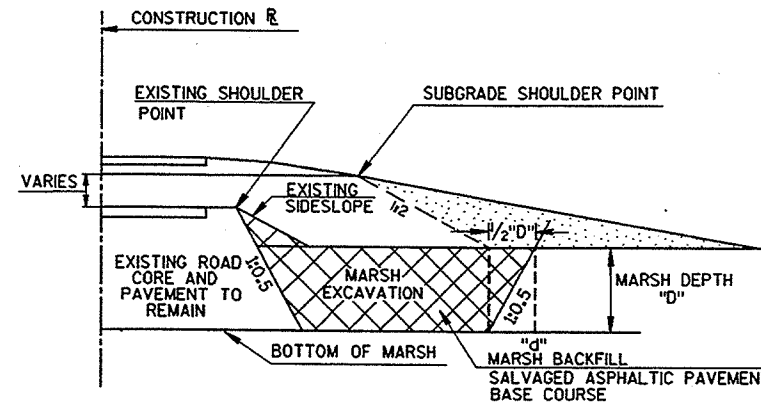


TYPICAL SECTION-MARSH EXCAVATION

NOTE: BACKFILL QUANTITIES COMPUTED FROM POINT "d" TO COMPENSATE FOR PROBABLE DISPLACED MARSH AREA.

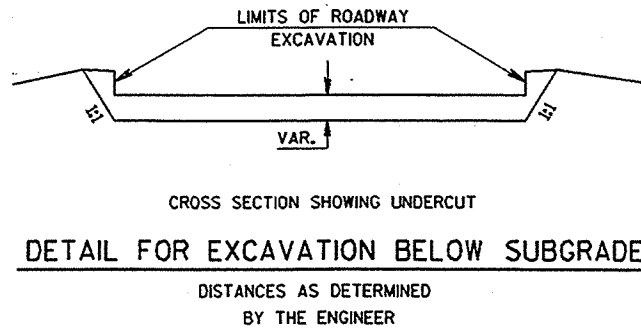

CONCRETE PAVEMENT LIMITS WERE CHANGED DUE TO THE GRADE / DRAINAGE PROBLEMS IN THE INTERSECTIONS. ASPHALT PROVIDED ADDITIONAL FLEXIBILITY FOR CORRECTING DRAINAGE.

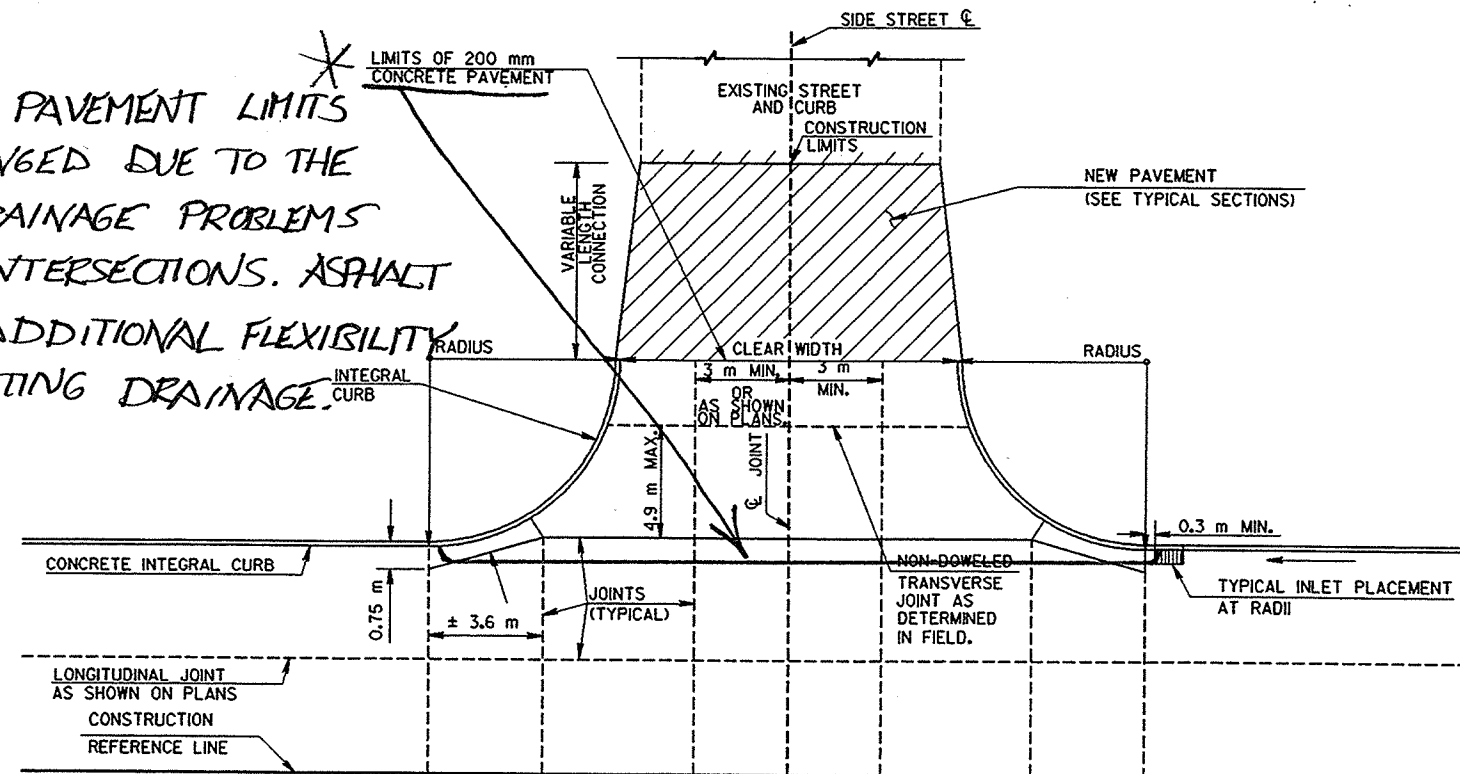

TYPICAL INTERSECTION JOINT LAYOUT

** PLAN / PROFILE SHEETS (SEE PLAN SHEETS FOR DIMENSIONS AND DETAILS) SHOW ENDING THE CONCRETE PAVEMENT AT MIDPOINTS OF THE RADIUS. THE LIMITS AS CONSTRUCTED WAS THE FLANGE LINE EXTENDED. SEE ABOVE.*

GB2 PEN TABLE = #plot+glosser.amv80pp.tbl DATE OF PLOT = 11/23/99 PLOT NA DESIGN FILE IS IN:440278.DGN:typical.dgn
 ORIGINATOR: DJD DATE: 9/1/98 PROJECT NO.: 440278.00 FILE NAME: LEVELS ON = 1, 2, 3, 48, 50, 51, 52, 53, 54, 55, 56, 57, 58, 59, 60, 61, 62.

DATE 21JUL99

ESTIMATE OF QUANTITIES

SHEET: 3.1

LINE NUMBER	ITEM	ITEM DESCRIPTION	UNIT	TOTAL	4994-00-78 QUANTITY	4994-00-82 QUANTITY
0010	20101	CLEARING	40M	7.00	5.00	2.00
0020	20102	CLEARING	25MM	328.00	220.00	108.00
0030	20104	GRUBBING	40M	7.00	5.00	2.00
0040	20105	GRUBBING	25MM	328.00	220.00	108.00
0050	20330	REMOVING OLD CULVERTS	EACH	59.00	45.00	14.00
0060	20401	REMOVING PAVEMENT	M2	24,673.00	11,340.00	13,333.00
0070	20405	REMOVING CURB AND GUTTER	M	81.00		81.00
0080	20410	REMOVING RAILROAD TRACK	M	23.00		23.00
0090	20503	UNCLASSIFIED EXCAVATION	M3	36,947.00	14,272.00	22,675.00
0100	21301	FINISHING ROADWAY	LS	1.00	0.50	0.50
0110	30404	CRUSHED AGGREGATE BASE COURSE	MG	21,941.00	10,430.00	11,511.00
0120	30426	BREAKER RUN STONE	MG	16,375.00	1,293.00	15,082.00
0130	40204	ASPHALTIC MATERIAL FOR TACK COAT	L	504.00	248.00	256.00
0140	40501	ASPHALTIC MATERIAL FOR PLANT MIXES	MG	43.00	19.00	24.00
0150	40713	ASPHALTIC CONCRETE PAVEMENT, TYPE MV	MG	708.00	283.00	425.00
0160	41508	CONCRETE PAVEMENT, 200 MM	M2	45,630.00	21,259.00	24,371.00
0170	41518	H.E.S. CONCRETE PAVEMENT, 200 MM	M2	726.00	528.00	198.00
0180	41605	CONCRETE DRIVEWAY, 150 MM	M2	204.00	62.00	142.00
0190	41653	PAVEMENT TIES	EACH	229.00	77.00	152.00
0200	41665	CONCRETE PAVEMENT GAPS	EACH	9.00	7.00	2.00
0210	50409	CONCRETE MASONRY, ENDWALLS	M3	12.00	12.00	
0220	52207	REINFORCED CONCRETE CULVERT PIPE, CLASS III, 750 MM	M	130.00	130.00	
0230	52210	REINFORCED CONCRETE CULVERT PIPE, CLASS III, 1050 MM	M	88.00	88.00	
0240	52260	REINFORCED CONCRETE APRON ENDWALLS FOR CULVERT PIPE, 300 MM	EACH	2.00	1.00	1.00
0250	52264	REINFORCED CONCRETE APRON ENDWALLS FOR CULVERT PIPE, 600 MM	EACH	4.00	4.00	
0260	52266	REINFORCED CONCRETE APRON ENDWALLS FOR CULVERT PIPE, 750 MM	EACH	4.00	4.00	
0270	60123	CONCRETE CURB AND GUTTER, 750 MM, TYPE A	M	6,899.00	3,184.00	3,715.00
0280	60604	MEDIUM RANDOM RIPRAP	M3	110.00	110.00	
0290	60825	REINFORCED CONCRETE PIPE, CLASS III, STORM SEWER, 300 MM	M	787.00	353.00	434.00
0300	60826	REINFORCED CONCRETE PIPE, CLASS III, STORM SEWER, 375 MM	M	284.00	284.00	

DATE 21JUL99

ESTIMATE OF QUANTITIES

SHEET: 3.2

LINE NUMBER	ITEM	ITEM DESCRIPTION	UNIT	TOTAL	4994-00-78 QUANTITY	4994-00-82 QUANTITY
0310	60827	REINFORCED CONCRETE PIPE, CLASS III, STORM SEWER, 450 MM	M	6.00		6.00
0320	60829	REINFORCED CONCRETE PIPE, CLASS III, STORM SEWER, 600 MM	M	1,799.00	60.00	1,739.00
0330	60831	REINFORCED CONCRETE PIPE, CLASS III, STORM SEWER, 750 MM	M	5.00	5.00	
0340	60853	REINFORCED CONCRETE PIPE, CLASS IV, STORM SEWER, 525 MM	M	7.00	7.00	
0350	60854	REINFORCED CONCRETE PIPE, CLASS IV, STORM SEWER, 600 MM	M	572.00	572.00	
0360	61110	MANHOLES, TYPE 1	EACH	35.00	12.00	23.00
0370	61112	MANHOLES, TYPE 3	EACH	7.00	6.00	1.00
0380	61121	INLETS, TYPE 1	EACH	21.00	14.00	7.00
0390	61122	INLETS, TYPE 3	EACH	74.00	36.00	38.00
0400	61151	MANHOLE COVERS, TYPE J	EACH	40.00	18.00	22.00
0410	61156	INLET COVERS, TYPE H-S	EACH	15.00	6.00	9.00
0420	61163	INLET COVERS, TYPE C	EACH	20.00	14.00	6.00
0430	61167	INLET COVERS, TYPE H	EACH	62.00	31.00	31.00
0440	61910	MOBILIZATION	LS	1.00	0.40	0.60
0450	62401	WATER	KL	927.00	441.00	486.00
0460	62501	TOPSOIL	M2	35,892.00	16,597.00	19,295.00
0470	62702	MULCHING	M2	35,892.00	16,597.00	19,295.00
0480	62815	SILT FENCE, DELIVERED	M	408.00	368.00	40.00
0490	62816	SILT FENCE, INSTALLED	M	408.00	368.00	40.00
0500	62817	SILT FENCE MAINTENANCE	M	204.00	184.00	20.00
0510	62819	MOBILIZATIONS, EROSION CONTROL	EACH	4.00	2.00	2.00
0520	62821	MOBILIZATIONS, EMERGENCY EROSION CONTROL	EACH	4.00	2.00	2.00
0530	62822	EROSION MAT, DELIVERED, CLASS I, TYPE A	M2	3,420.00	384.00	3,036.00
0540	62823	EROSION MAT, INSTALLED, CLASS I, TYPE A	M2	3,420.00	384.00	3,036.00
0550	62905	FERTILIZER, TYPE B	KG	1,261.00	583.00	678.00
0560	63011	SEEDING, MIXTURE NO. 40	KG	365.00	168.00	197.00
0570	63101	SODDING	M2	15.00		15.00
0580	64202	FIELD OFFICE, TYPE B	LS	1.00	0.50	0.50
0590	64301	TRAFFIC CONTROL	LS	1.00	0.50	0.50
0600	64313	TRAFFIC CONTROL, DRUMS	DAYS	31,506.00	14,628.00	16,878.00
0610	64318	TRAFFIC CONTROL, BARRICADES, TYPE III	DAYS	3,123.00	1,518.00	1,605.00
0620	64321	TRAFFIC CONTROL, WARNING LIGHTS, TYPE A	DAYS	9,597.00	4,416.00	5,181.00

DATE 21JUL99

ESTIMATE OF QUANTITIES

SHEET: 3.3

LINE NUMBER	ITEM	ITEM DESCRIPTION	UNIT	TOTAL	4994-00-78 QUANTITY	4994-00-82 QUANTITY
0630	64323	TRAFFIC CONTROL, WARNING LIGHTS, TYPE C	DAYS	870.00		870.00
0640	64326	TRAFFIC CONTROL, SIGNS	DAYS	10,635.00	5,568.00	5,067.00
0650	64329	TRAFFIC CONTROL, FLEXIBLE TUBULAR MARKER POSTS	EACH	44.00		44.00
0660	64333	TRAFFIC CONTROL, FLEXIBLE TUBULAR MARKER BASES	EACH	44.00		44.00
0670	64601	PAVEMENT MARKING, 100 MM, PAINT	M	15,463.00	6,821.00	8,642.00
0680	64642	REMOVING PAVEMENT MARKINGS	M	756.00		756.00
0690	64701	PAVEMENT MARKING, RAILROAD CROSSINGS, PAINT	EACH	2.00		2.00
0700	64709	PAVEMENT MARKING, STOP LINE, 450 MM, PAINT	M	60.00		60.00
0710	64904	TEMPORARY PAVEMENT MARKING, 100 MM, REMOVABLE TAPE	M	960.00		960.00
0720	65221	NONMETALLIC CONDUIT, SCHEDULE 40, 75 MM	M	155.00		155.00
0730	66501	SAWING EXISTING PAVEMENT	M	429.80	197.00	232.80
0740	66502	SAWING CONCRETE PAVEMENT, FULL DEPTH	M	9.40	9.40	
0750	90001	MISC ITEM 90001A, PRELIMINARY CONSTRUCTION STAKING	M	3,873.00	1,795.00	2,078.00
0760	90001	MISC ITEM 90001B, CONSTRUCTION STAKING, SUBGRADE, SPECIAL	M	3,873.00	1,795.00	2,078.00
0770	90001	MISC ITEM 90001C, CONST. STAKING, CURB, GUTTER, AND C&G, SPECIAL	M	129.00		129.00
0780	90001	MISC ITEM 90001C, CONSTRUCTION STAKING, CURB, GUTTER, AND CURB AND GUTTER, SPECIAL	M	6,770.00	3,184.00	3,586.00
0790	90001	MISC ITEM 90001D, CONSTRUCTION STAKING, CONCRETE PAVEMENT, SPECIAL	M	3,399.00	1,575.00	1,824.00
0800	90001	MISC ITEM 90001E, REINF. CONC. HORIZ. ELLIPT. PIPE, CL. HE-IV, STORM SEWER, 490 X 770 MM	M	128.00	128.00	
0810	90005	MISC ITEM 90005A, CONSTRUCTION STAKING, STORM SEWER SYSTEM	EACH	144.00	73.00	71.00
0820	90005	MISC ITEM 90005B, CONSTRUCTION STAKING, PIPE CULVERTS, SPECIAL	EACH	9.00	9.00	
0830	90005	MISC ITEM 90005C, INLET, TYPE 1, MODIFIED	EACH	11.00	10.00	1.00
0840	90005	MISC ITEM 90005D, INLET, TYPE 3, MODIFIED	EACH	13.00	12.00	1.00
0850	90005	MISC ITEM 90005E, SPECIAL INLET COVER, TYPE D	EACH	1.00		1.00
0860	90365	QMP, BASE COURSES	MG	21,941.00	10,430.00	11,511.00
0870	90401	QMP, PLACEMENT OF CONCRETE PAVEMENT	P.D.	26.00	12.00	14.00
0880	90421	QMP, AGGREGATE FOR CONCRETE PAVEMENT	M2	46,356.00	21,787.00	24,569.00

DATE 21JUL99

ESTIMATE OF QUANTITIES

SHEET: 3.4

LINE NUMBER	ITEM	ITEM DESCRIPTION	UNIT	TOTAL	4994-00-78 QUANTITY	4994-00-82 QUANTITY
----------------	------	------------------	------	-------	------------------------	------------------------

ORIGINAL D.J.D. DATE: 7/17/99
 PROJECT NO: 440278.00 FILE NAME:
 REVISIONS: DATE REVISED BY:
 LEVELS: 01 - 1, 2, 3, 48, 50, 51, 52, 53, 54, 55, 56, 57, 58, 59, 60, 61, 62
 CB2 PER TABLE = #plot72#loser+mv80pp.tbl
 DATE OF PLOT = 07/15/99
 PLOT NUMBER =
 DESIGN FILE IS I:\440278\dgn\MISC.dgn

TRAFFIC CONTROL DRUMS AND WARNING LIGHTS, AND SIGNS

STATION	LOCATION	DRUMS		WARNING LIGHTS TYPE "C"		BARRICADES TYPE III		WARNING LIGHTS, TYPE "A" BARRICADES		SIGNS		SIGN NO.	REMARKS	FLEXIBLE TUBULAR MARKERS (POSTS AND BASES) EACH		
		EACH	DAYS	EACH	DAYS	EACH	DAYS	EACH	DAYS	EACH	DAYS					
PROJ. 4994-00-82 CATEGORY 0010																
11+600	C.T.H. "A"					2	276	4	552			1	138	R11-4	ROAD CLOSED TO THRU TRAFFIC	
7+180	SNELL RD.											1	138	W20-1, G20-2	ROAD WORK AHEAD, END ROAD WORK	
8+040	PICKETT AVE.					2	276	4	552			1	138	R11-2	ROAD CLOSED	
8+190	PICKETT AVE.											1	138	W20-3, G20-2	ROAD CLOSED 500', END ROAD WORK	
8+340	PICKETT AVE.											1	138	W20-3	ROAD CLOSED AHEAD	
8+665	BUTLER AVE.											1	138	W20-3	ROAD CLOSED AHEAD	
8+815	BUTLER AVE.											1	138	W20-3, G20-2	ROAD CLOSED 500', END ROAD WORK	
8+965	BUTLER AVE.					2	276	4	552			1	138	R11-2	ROAD CLOSED	
9+025	BUTLER AVE.					2	276	4	552			1	138	R11-2	ROAD CLOSED	
9+175	BUTLER AVE.											1	138	W20-3, G20-2	ROAD CLOSED 500', END ROAD WORK	
9+325	BUTLER AVE.											1	138	W20-3	ROAD CLOSED AHEAD	
9+812	C.T.H. "Y"											1	138	W20-1, G20-2	ROAD WORK AHEAD, END ROAD WORK	
10+188	C.T.H. "Y"											1	138	W20-1, G20-2	ROAD WORK AHEAD, END ROAD WORK	
11+585	C.T.H. "A"											2	180	R3-1, R6-2R	NO RIGHT TURN SYMBOL, ONE WAY	
12+262	C.T.H. "A"											1	90	R5-1	DO NOT ENTER	
12+280	C.T.H. "A"											2	180	R3-2, R6-2R	NO LEFT TURN SYMBOL, ONE WAY	
12+403	C.T.H. "A"											1	90	R5-1	DO NOT ENTER	
12+410	C.T.H. "A"											2	180	R6-2L, R3-2	NO LEFT TURN SYMBOL, ONE WAY	
12+435	C.T.H. "A"											2	180	R3-1, R6-2R	NO RIGHT TURN SYMBOL, ONE WAY	
13+200	C.T.H. "A"											1	90	R5-9	WRONG WAY	
13+275	C.T.H. "A"											1	90	R5-1	DO NOT ENTER	
13+285	C.T.H. "A"											1	90	R3-1	NO RIGHT TURN SYMBOL	
13+318	C.T.H. "A"											1	90	R3-2	NO LEFT TURN SYMBOL	
13+320	C.T.H. "A"					2	276	4	552			1	138	R11-4	ROAD CLOSED TO THRU TRAFFIC	
13+560	C.T.H. "A"											2	276	W20-1, G20-2	ROAD WORK 500', END ROAD WORK	
13+710	C.T.H. "A"											1	138	W20-1	ROAD WORK 1000'	
13+860	C.T.H. "A"											1	138	W20-1	ROAD WORK AHEAD	
11+575-13+280	C.T.H. "A"	116	16,008												SPACING = 15 METERS	
SUBTOTALS			16,008					1,380	2,760		1,656		4,572			
PROJ. 4994-00-82 CATEGORY 0020																
30+030	NICOLET AVE.					3	135	6	270			1	45	R11-2	ROAD CLOSED	
30+180	NICOLET AVE.											1	45	W20-3	ROAD CLOSED 500'	
30+330	NICOLET AVE.											1	45	W20-3	ROAD CLOSED AHEAD	
19+470	C.T.H. "AA"											1	45	W20-1	ROAD WORK AHEAD	
19+620	C.T.H. "AA"											1	45	W20-3	ROAD WORK 1000'	
19+770	C.T.H. "AA"											1	45	W01-4L/R, G20-2	LEFT/RIGHT REVERSE CURVE SYMBOL, END ROAD WORK	
19+888-20+044	C.T.H. "AA"	39	870	39	870										PHASE 1 AND 2	44
19+920	C.T.H. "AA"					2	50	4	100			1	25	W01-6	ARROW, PHASE 1	
20+020	C.T.H. "AA"					2	40	4	80			1	20	W01-6	ARROW, PHASE 2	
20+170	C.T.H. "AA"											1	45	W01-4L/R, G20-2	LEFT/RIGHT REVERSE CURVE SYMBOL, END ROAD WORK	
20+270	C.T.H. "AA"											1	45	W20-1	ROAD WORK AHEAD	
SUBTOTAL			870		870		225		450		315		495			44
TOTALS			31,506		870		3,123		6,246		3,396		10,680			44

MISCELLANEOUS QUANTITIES

HWY: C.T.H. "A"

COUNTY: WINNEBAGO

STATE PROJECT NO: 4994-00-78, 4994-00-82

SHEET NO: 3A M

ORIGINATOR: DJD DATE: 7/1/99
 PROJECT NO: 440278.00 FILE NAME: 1
 DATE REVISION: 1
 LEVELS ON - 1, 2, 3, 48, 50, 51, 52, 53, 54, 55, 56, 57, 58, 59, 60, 61, 62
 PLOT NAME: SCALE: 1
 DESIGN FILE IS: I:\440278\dm\WISC.dgn
 PEN TABLE = splot72+laser+sm80pp.tbl
 DATE OF PLOT = 07/15/99
 PLOT NO: 1

CLEARING AND GRUBBING

STATION-STATION	LOCATION	CLEARING		GRUBBING	
		25 mm	40 m	25 mm	40 m
PROJ. 4994-00-78					
10+072	C.T.H. "A" 7.5 m RT.	20		20	
10+092	C.T.H. "A" 7.5 m RT.	20		20	
10+120-10+200	C.T.H. "A" RT.		2		2
10+196	C.T.H. "A" 8 m RT.	20		20	
10+423	C.T.H. "A" 9 m LT.	8		8	
10+458	C.T.H. "A" 9.5 m RT.	4		4	
10+638	C.T.H. "A" 11 m RT.	16		16	
10+651	C.T.H. "A" 11 m RT.	24		24	
11+218	C.T.H. "A" 13.5 m LT.	12		12	
11+240-11+280	C.T.H. "A" RT.		1		1
11+351	C.T.H. "A" 17 m LT.	12		12	
11+351	C.T.H. "A" 18.5 m LT.	12		12	
11+352	C.T.H. "A" 17.5 m LT.	12		12	
11+377	C.T.H. "A" 14.5 m LT.	8		8	
11+394	C.T.H. "A" 23 m LT.	6		6	
11+401	C.T.H. "A" 16 m LT.	6		6	
11+403	C.T.H. "A" 16.5 m LT.	6		6	
11+407	C.T.H. "A" 15.5 m LT.	6		6	
11+416	C.T.H. "A" 14.5 m LT.	4		4	
11+421	C.T.H. "A" 14.5 m LT.	4		4	
11+440-11+520	C.T.H. "A" LT.		2		2
1+015	MacARTHUR LN. 10 m LT.	12		12	
1+017	MacARTHUR LN. 11.5 m LT.	8		8	
SUBTOTALS		220	5	220	5
PROJ. 4994-00-82 CATEGORY 0010					
12+401	C.T.H. "A" 9 m RT.	16		16	
7+026	SNELL RD. 8 m LT.	4		4	
9+020	BUTLER AVE. 7.5 m LT.	28		28	
12+578	C.T.H. "A" 13.5 m LT.	12		12	
12+582	C.T.H. "A" 11.5 m LT.	12		12	
12+640-12+720	C.T.H. "A" RT.		2		2
12+718	C.T.H. "A" 11 m LT.	8		8	
12+720	C.T.H. "A" 10.5 m LT.	28		28	
SUBTOTALS		108	2	108	2
TOTALS		328	7	328	7

REMOVING CONCRETE CURB AND GUTTER

STATION-STATION	LOCATION	LENGTH m
PROJ. 4994-00-82 CATEGORY 0010		
12+388-12+453	C.T.H. "A" RT.	81

PAVEMENT REMOVAL

STATION-STATION	LOCATION	QUANTITY m2
PROJ. 4994-00-78		
10+000-11+575	C.T.H. "A"	11,340
PROJ. 4994-00-82 CATEGORY 0010		
11+575-13+410	C.T.H. "A"	13,212
PROJ. 4994-00-82 CATEGORY 0020		
19+955-19+985	C.T.H. "AA"	121
TOTAL		24,673

REMOVING R.R. TRACKS

STATION	LOCATION	QUANTITY m
PROJ. 4994-00-82 CATEGORY 0020		
19+957	C.T.H. "AA"	23

SAWING EXISTING PAVEMENT

STATION	LOCATION	QUANTITY m
PROJ. 4994-00-78		
1+020	MacARTHUR LN.	5.5
2+040	SHADOW LN.	6.7
10+495	C.T.H. "A" LT.	10.5
10+553	C.T.H. "A" RT.	2.7
10+581	C.T.H. "A" RT.	2.8
3+020	MILLER LN.	5.6
4+030	RIDGE LN.	5.2
5+030	KEENVILLE LN.	6.2
6+770-10+834	C.T.H. "A" LT.	70.1
10+897	C.T.H. "A" LT.	7.9
10+934	C.T.H. "A" LT.	6.4
10+991	C.T.H. "A" LT.	8.8
11+021	C.T.H. "A" LT.	7.0
6+020	DRIFTWOOD LN.	6.7
11+195	C.T.H. "A" RT.	7.3
11+209	C.T.H. "A" RT.	5.0
11+226	C.T.H. "A" LT.	9.0
11+323	C.T.H. "A" LT.	9.0
7+030	SNELL RD.	6.7
6+970	SNELL RD.	7.9
SUBTOTAL		197.0
PROJ. 4994-00-82 CATEGORY 0010		
8+040	PICKETT AVE.	6.9
12+327-12+377	C.T.H. "A" RT.	53.0
8+965	BUTLER AVE.	6.2
9+025	BUTLER AVE.	10.6
12+491	C.T.H. "A" RT.	9.0
13+190	C.T.H. "A" RT.	6.0
13+280	C.T.H. "A" RT.	13.5
9+063	C.T.H. "Y"	6.9
10+017-10+024	C.T.H. "Y" RT.	6.5
10+038	C.T.H. "Y"	7.4
13+410	C.T.H. "A"	6.8
SUBTOTAL		132.8
PROJ. 4994-00-82 CATEGORY 0020		
19+932-19+980	C.T.H. "AA"	48.0
19+988-20+000	C.T.H. "AA"	12.0
19+974-19+986	C.T.H. "AA"	20.0
19+982-19+994	C.T.H. "AA"	20.0
SUBTOTAL		100.0
TOTAL		429.8

SAWING EXISTING CONCRETE PAVEMENT, FULL DEPTH

STATION	LOCATION	QUANTITY m
PROJ. 4994-00-78		
10+436	C.T.H. "A" LT.	3.4
11+253	C.T.H. "A" RT.	6.0
TOTAL		9.4

EARTHWORK SUMMARY

STATION	LOCATION	UNCLASSIFIED EXCAVATION (m3)	FILL (m3)	WASTE (m3)
PROJ. 4994-00-78				
10+000-11+575	C.T.H. "A"	13,660	3,468	10,192
1+000-1+020	MACARTHUR LANE	28	19	9
2+000-2+040	SHADOW LANE	92	0	92
3+000-3+020	MILLER LANE	11	0	11
4+000-4+030	RIDGE LANE	28	0	28
5+000-5+030	KEENVILLE AVE.	43	4	39
6+000-6+020	DRIFTWOOD LANE	6	1	5
6+970-7+030	SNELL ROAD	404	35	369
SUBTOTALS		14,272	3,527	10,745
PROJ. 4994-00-82 CATEGORY 0010				
11+575-13+410	C.T.H. "A"	21,718	1,242	20,476
8+000-8+040	PICKET AVE.	102	0	102
8+965-9+025	BUTLER AVE.	331	1	330
9+962.5-10+037.5	C.T.H. "Y"	524	17	507
SUBTOTALS		22,675	1,260	21,415
TOTALS		36,947	4,787	32,160

REMOVING OLD CULVERT PIPES

STATION	LOCATION	QUANTITY EACH	REMARKS
PROJ. 4994-00-78			
10+216	C.T.H. "A" RT.	1	1-300 mm C.P.
10+256	C.T.H. "A" RT.	1	1-300 mm C.P.
10+370	C.T.H. "A" RT.	1	1-450 mm C.P.
10+392	C.T.H. "A" LT.	1	1-375 mm C.P.
10+410	C.T.H. "A" RT.	1	1-450 mm C.P.
10+472	C.T.H. "A" RT.	1	1-450 mm C.P.
10+495	C.T.H. "A" LT.	1	1-300 mm C.P.
10+525	C.T.H. "A" RT.	1	1-375 mm C.P.
10+537	C.T.H. "A" LT./RT.	1	1-600x1200 mm BOX CULV.
10+553	C.T.H. "A" RT.	1	1-450 mm C.P.
10+581	C.T.H. "A" RT.	1	1-450 mm C.P.
10+590	C.T.H. "A" RT.	1	1-450 mm C.P.
10+620	C.T.H. "A" RT.	1	1-450 mm C.P.
10+644	C.T.H. "A" RT.	1	1-300 mm C.P.
10+658	C.T.H. "A" LT.	1	1-450 mm C.P.
10+727	C.T.H. "A" RT.	1	1-375 mm C.P.
10+732	C.T.H. "A" LT.	1	1-450 mm C.P.
10+740	C.T.H. "A" RT.	1	1-375 mm C.P.
10+768	C.T.H. "A" LT./RT.	1	1-375 mm C.P.
10+777	C.T.H. "A" LT.	1	1-525 mm C.P.
10+777	C.T.H. "A" RT.	1	1-450 mm C.P.
10+853	C.T.H. "A" LT.	1	1-450 mm C.P.
10+858	C.T.H. "A" RT.	1	1-375 mm C.P.
10+897	C.T.H. "A" LT.	1	1-600 mm C.P.
10+909	C.T.H. "A" RT.	1	1-375 mm C.P.
10+934	C.T.H. "A" LT.	1	1-450 mm C.P.
10+950	C.T.H. "A" RT.	1	1-375 mm C.P.
10+991	C.T.H. "A" LT.	1	1-450 mm C.P.
11+108	C.T.H. "A" LT.	1	1-450 mm C.P.
11+130	C.T.H. "A" RT.	1	1-450 mm C.P.
11+166	C.T.H. "A" RT.	1	1-450 mm C.P.
11+195	C.T.H. "A" RT.	1	1-450 mm C.P.
11+197	C.T.H. "A" LT.	1	1-450 mm C.P.
11+209	C.T.H. "A" RT.	1	1-450 mm C.P.
11+226	C.T.H. "A" LT.	1	1-450 mm C.P.
11+253	C.T.H. "A" RT.	1	1-450 mm C.P.
11+257	C.T.H. "A" LT.	1	1-450 mm C.P.
11+323	C.T.H. "A" LT.	4	4-900 mm C.P.
11+350	C.T.H. "A" LT./RT.	3	3-1200 mm C.P.
11+575	C.T.H. "A" RT.	1	1-450 mm C.P.
SUBTOTAL		45	
PROJ. 4994-00-82 CATEGORY 0010			
11+600	C.T.H. "A" LT.	1	1-300 mm C.P.
12+070	C.T.H. "A" RT.	1	1-450 mm C.P.
12+216	C.T.H. "A" LT.	1	1-450 mm C.P.
12+290	C.T.H. "A" RT.	1	1-300 mm C.P.
12+332	C.T.H. "A" RT.	1	1-450 mm C.P.
12+423	C.T.H. "A" LT.	1	1-600 mm C.P.
12+491	C.T.H. "A" RT.	1	1-450 mm C.P.
13+034	C.T.H. "A" RT.	1	1-300 mm C.P.
13+152	C.T.H. "A" RT.	1	1-300 mm C.P.
13+190	C.T.H. "A" RT.	1	1-300 mm C.P.
13+204	C.T.H. "A" RT.	1	1-300 mm C.P.
13+265	C.T.H. "A" LT.	1	1-375 mm C.P.
13+277	C.T.H. "A" RT.	1	1-450 mm C.P.
13+304	C.T.H. "A" RT.	1	1-375 mm C.P.
SUBTOTAL		14	
TOTAL		59	

NON-METALLIC CONDUIT, SCHEDULE 40, 75 mm

STATION	LOCATION	QUANTITY m
PROJ. 4994-00-82 CATEGORY 0010		
11+560	ACROSS C.T.H. "A"	19
11+590	ACROSS C.T.H. "A"	18
13+285	ACROSS C.T.H. "A"	20
13+320	ACROSS C.T.H. "A"	20
6+987	ACROSS SNELL ROAD	21
7+013	ACROSS SNELL ROAD	21
9+983	ACROSS C.T.H. "Y"	17
10+015	ACROSS C.T.H. "Y"	19
TOTAL		155

MISCELLANEOUS QUANTITIES

HWY: C.T.H. "A"

COUNTY: WINNEBAGO

STATE PROJECT NO: 4994-00-78, 4994-00-82

SHEET NO: 38 M

REVISED SHEET

*-DENOTES REVISED MISCELLANEOUS QUANTITY

CLEARING AND GRUBBING

STATION-STATION	LOCATION	CLEARING		GRUBBING	
		25 mm	40 m	25 mm	40 m
PROJ. 4994-00-78					
10+072	C.T.H. "A" 7.5 m RT.	20		20	
10+092	C.T.H. "A" 7.5 m RT.	20		20	
10+120-10+200	C.T.H. "A" RT.		2		2
10+196	C.T.H. "A" 8 m RT.	20		20	
10+423	C.T.H. "A" 9 m LT.	8		8	
10+458	C.T.H. "A" 9.5 m RT.	4		4	
10+638	C.T.H. "A" 11 m RT.	16		16	
10+651	C.T.H. "A" 11 m RT.	24		24	
11+218	C.T.H. "A" 13.5 m LT.	12		12	
11+240-11+280	C.T.H. "A" RT.		1		1
11+351	C.T.H. "A" 17 m LT.	12		12	
11+351	C.T.H. "A" 18.5 m LT.	12		12	
11+352	C.T.H. "A" 17.5 m LT.	12		12	
11+377	C.T.H. "A" 14.5 m LT.	8		8	
11+394	C.T.H. "A" 23 m LT.	6		6	
11+401	C.T.H. "A" 16 m LT.	6		6	
11+403	C.T.H. "A" 16.5 m LT.	6		6	
11+407	C.T.H. "A" 15.5 m LT.	6		6	
11+416	C.T.H. "A" 14.5 m LT.	4		4	
11+421	C.T.H. "A" 14.5 m LT.	4		4	
11+440-11+520	C.T.H. "A" LT.		2		2
1+015	MacARTHUR LN. 10 m LT.	12		12	
1+017	MacARTHUR LN. 11.5 m LT.	8		8	
SUBTOTALS		220	5	220	5
PROJ. 4994-00-82 CATEGORY 0010					
12+401	C.T.H. "A" 9 m RT.	16		16	
7+026	SNELL RD. 8 m LT.	4		4	
9+020	BUTLER AVE. 7.5 m LT.	28		28	
12+578	C.T.H. "A" 13.5 m LT.	12		12	
12+582	C.T.H. "A" 11.5 m LT.	12		12	
12+640-12+720	C.T.H. "A" RT.		2		2
12+718	C.T.H. "A" 11 m LT.	8		8	
12+720	C.T.H. "A" 10.5 m LT.	28		28	
SUBTOTALS		108	2	108	2
TOTALS		328	7	328	7

REMOVING CONCRETE CURB AND GUTTER

STATION-STATION	LOCATION	LENGTH m
PROJ. 4994-00-82 CATEGORY 0010		
12+388-12+453	C.T.H. "A" RT.	81

PAVEMENT REMOVAL

STATION-STATION	LOCATION	QUANTITY m2
PROJ. 4994-00-78		
10+000-11+575	C.T.H. "A"	11,340
PROJ. 4994-00-82 CATEGORY 0010		
11+575-13+410	C.T.H. "A"	13,212
PROJ. 4994-00-82 CATEGORY 0020		
19+955-19+985	C.T.H. "AA"	121
TOTAL		24,673

REMOVING R.R. TRACKS

STATION	LOCATION	QUANTITY m
PROJ. 4994-00-82 CATEGORY 0020		
19+957	C.T.H. "AA"	23

SAWING EXISTING CONCRETE PAVEMENT, FULL DEPTH

STATION	LOCATION	QUANTITY m
PROJ. 4994-00-78		
10+436	C.T.H. "A" LT.	3.4
11+253	C.T.H. "A" RT.	6.0
TOTAL		9.4

SAWING EXISTING PAVEMENT

STATION	LOCATION	QUANTITY m
PROJ. 4994-00-78		
1+020	MacARTHUR LN.	5.5
2+040	SHADOW LN.	6.7
10+495	C.T.H. "A" LT.	10.5
10+553	C.T.H. "A" RT.	2.7
10+581	C.T.H. "A" RT.	2.8
3+020	MILLER LN.	5.6
4+030	RIDGE LN.	5.2
5+030	KEENVILLE LN.	6.2
6+770-10+834	C.T.H. "A" LT.	70.1
10+897	C.T.H. "A" LT.	7.9
10+934	C.T.H. "A" LT.	6.4
10+991	C.T.H. "A" LT.	8.8
11+021	C.T.H. "A" LT.	7.0
6+020	DRIFTWOOD LN.	6.7
11+195	C.T.H. "A" RT.	7.3
11+209	C.T.H. "A" RT.	5.0
11+226	C.T.H. "A" LT.	9.0
11+323	C.T.H. "A" LT.	9.0
7+030	SNELL RD.	6.7
6+970	SNELL RD.	7.9
SUBTOTAL		197.0
PROJ. 4994-00-82 CATEGORY 0010		
8+040	PICKETT AVE.	6.9
12+327-12+377	C.T.H. "A" RT.	53.0
8+965	BUTLER AVE.	6.2
9+025	BUTLER AVE.	10.6
12+491	C.T.H. "A" RT.	9.0
13+190	C.T.H. "A" RT.	6.0
13+280	C.T.H. "A" RT.	13.5
9+063	C.T.H. "Y"	6.9
10+017-10+024	C.T.H. "Y" RT.	6.5
10+038	C.T.H. "Y"	7.4
13+410	C.T.H. "A"	6.8
SUBTOTAL		132.8
PROJ. 4994-00-82 CATEGORY 0020		
19+932-19+980	C.T.H. "AA"	48.0
19+988-20+000	C.T.H. "AA"	12.0
19+974-19+986	C.T.H. "AA"	20.0
19+982-19+994	C.T.H. "AA"	20.0
SUBTOTAL		100.0
TOTAL		429.8

*-REVISED MISCELLANEOUS QUANTITY

EARTHWORK SUMMARY

STATION	LOCATION	UNCLASSIFIED EXCAVATION (m3)	FILL (m3)	MARSH (m3)	WASTE (m3)	EBS (m3)
PROJ. 4994-00-78						
10+000-11+575	C.T.H. "A"	13,660	3,468	2,040	12,232	960
EXCAVATION FOR BREAKER RUN						
1+000-1+020	MACARTHUR LANE	616	0	0	616	
2+000-2+040	SHADOW LANE	92	0	0	92	
3+000-3+020	MILLER LANE	11	0	0	11	
4+000-4+030	RIDGE LANE	28	0	0	28	
5+000-5+030	KEENVILLE AVE.	43	4	1	39	
6+000-6+020	DRIFTWOOD LANE	6	1	0	5	
6+970-7+030	SNELL ROAD	404	35	0	369	
SUBTOTALS		14,888	3,527	2,040	13,401	960
PROJ. 4994-00-82 CATEGORY 0010						
11+575-13+410	C.T.H. "A"	21,718	1,242	0	20,476	480
EXCAVATION FOR BREAKER RUN						
8+000-8+040	PICKET AVE.	102	0	0	102	
8+965-9+025	BUTLER AVE.	331	1	0	330	
9+962.5-10+037.5	C.T.H. "Y"	524	17	0	507	
SUBTOTALS		29,857	1,260	0	28,597	480
TOTALS		44,745	4,787	2,040	41,998	1,440

REMOVING OLD CULVERT PIPES

STATION	LOCATION	QUANTITY EACH	REMARKS
PROJ. 4994-00-78			
10+216	C.T.H. "A" RT.	1	1-300 mm C.P.
10+256	C.T.H. "A" RT.	1	1-300 mm C.P.
10+370	C.T.H. "A" RT.	1	1-450 mm C.P.
10+392	C.T.H. "A" LT.	1	1-375 mm C.P.
10+410	C.T.H. "A" RT.	1	1-450 mm C.P.
10+472	C.T.H. "A" RT.	1	1-450 mm C.P.
10+495	C.T.H. "A" LT.	1	1-300 mm C.P.
10+525	C.T.H. "A" RT.	1	1-375 mm C.P.
10+537	C.T.H. "A" LT./RT.	1	1-600x1200 mm BOX CULV.
10+553	C.T.H. "A" RT.	1	1-450 mm C.P.
10+581	C.T.H. "A" RT.	1	1-450 mm C.P.
10+590	C.T.H. "A" RT.	1	1-450 mm C.P.
10+620	C.T.H. "A" RT.	1	1-450 mm C.P.
10+644	C.T.H. "A" RT.	1	1-300 mm C.P.
10+658	C.T.H. "A" LT.	1	1-450 mm C.P.
10+727	C.T.H. "A" RT.	1	1-375 mm C.P.
10+732	C.T.H. "A" LT.	1	1-450 mm C.P.
10+740	C.T.H. "A" RT.	1	1-375 mm C.P.
10+768	C.T.H. "A" LT./RT.	1	1-375 mm C.P.
10+777	C.T.H. "A" LT.	1	1-525 mm C.P.
10+777	C.T.H. "A" RT.	1	1-450 mm C.P.
10+853	C.T.H. "A" LT.	1	1-450 mm C.P.
10+858	C.T.H. "A" RT.	1	1-375 mm C.P.
10+897	C.T.H. "A" LT.	1	1-600 mm C.P.
10+909	C.T.H. "A" RT.	1	1-375 mm C.P.
10+934	C.T.H. "A" LT.	1	1-450 mm C.P.
10+950	C.T.H. "A" RT.	1	1-375 mm C.P.
10+991	C.T.H. "A" LT.	1	1-450 mm C.P.
11+108	C.T.H. "A" LT.	1	1-450 mm C.P.
11+130	C.T.H. "A" RT.	1	1-450 mm C.P.
11+166	C.T.H. "A" RT.	1	1-450 mm C.P.
11+195	C.T.H. "A" RT.	1	1-450 mm C.P.
11+197	C.T.H. "A" LT.	1	1-450 mm C.P.
11+209	C.T.H. "A" RT.	1	1-450 mm C.P.
11+226	C.T.H. "A" LT.	1	1-450 mm C.P.
11+253	C.T.H. "A" RT.	1	1-450 mm C.P.
11+257	C.T.H. "A" LT.	1	1-450 mm C.P.
11+323	C.T.H. "A" LT.	4	4-900 mm C.P.
11+350	C.T.H. "A" LT./RT.	3	3-1200 mm C.P.
11+575	C.T.H. "A" RT.	1	1-450 mm C.P.
SUBTOTAL		45	
PROJ. 4994-00-82 CATEGORY 0010			
11+600	C.T.H. "A" LT.	1	1-300 mm C.P.
12+070	C.T.H. "A" RT.	1	1-450 mm C.P.
12+216	C.T.H. "A" LT.	1	1-450 mm C.P.
12+290	C.T.H. "A" RT.	1	1-300 mm C.P.
12+332	C.T.H. "A" RT.	1	1-450 mm C.P.
12+423	C.T.H. "A" LT.	1	1-600 mm C.P.
12+491	C.T.H. "A" RT.	1	1-450 mm C.P.
13+034	C.T.H. "A" RT.	1	1-300 mm C.P.
13+152	C.T.H. "A" RT.	1	1-300 mm C.P.
13+190	C.T.H. "A" RT.	1	1-300 mm C.P.
13+204	C.T.H. "A" RT.	1	1-300 mm C.P.
13+265	C.T.H. "A" LT.	1	1-375 mm C.P.
13+277	C.T.H. "A" RT.	1	1-450 mm C.P.
13+304	C.T.H. "A" RT.	1	1-375 mm C.P.
SUBTOTAL		14	
TOTAL		59	

NON-METALLIC CONDUIT, SCHEDULE 40, 75 mm

STATION	LOCATION	QUANTITY m
PROJ. 4994-00-82 CATEGORY 0010		
11+560	ACROSS C.T.H. "A"	19
11+590	ACROSS C.T.H. "A"	18
13+285	ACROSS C.T.H. "A"	20
13+320	ACROSS C.T.H. "A"	20
6+987	ACROSS SNELL ROAD	21
7+013	ACROSS SNELL ROAD	21
9+983	ACROSS C.T.H. "Y"	17
10+015	ACROSS C.T.H. "Y"	19
TOTAL		155

MISCELLANEOUS QUANTITIES

HWY: C.T.H. "A"

COUNTY: WINNEBAGO

STATE PROJECT NO: 4994-00-78, 4994-00-82

SHEET NO: 3.8



WSDOT: MSHT42

ORIGINAL D.D. DATE: 7/1/99
 PROJECT NO: 440278.00
 REVISIONS: 1, 2, 3, 61, 62.
 LEVELS ON: 1, 2, 3, 61, 62.
 DESIGNER: J. J. K. DATE: 11/23/99
 CHECKER: J. J. K. DATE: 11/23/99
 PLOT NAME: I:\440278.dgn
 FILE NAME: I:\440278.dgn
 MISC.DGN: I:\440278.dgn

CONCRETE CURB AND GUTTER, 750 mm TYPE 'A'

STATION-STATION	LOCATION	QUANTITY m
PROJ. 4994-00-78		
10+000-11+571	C.T.H. "A" LT.	1,577
10+000-10+367	C.T.H. "A" RT.	371
10+375-10+471	C.T.H. "A" RT.	108
10+477-10+641	C.T.H. "A" RT.	182
10+648-10+724	C.T.H. "A" RT.	84
10+732-10+773	C.T.H. "A" RT.	53
10+781-11+017	C.T.H. "A" RT.	247
11+026-11+570	C.T.H. "A" RT.	562
SUBTOTAL		3,184
PROJ. 4994-00-82 CATEGORY 0010		
11+580-12+418	C.T.H. "A" LT.	854
11+580-12+279	C.T.H. "A" RT.	727
12+426-13+289	C.T.H. "A" LT.	879
12+288-12+422	C.T.H. "A" RT.	166
12+432-13+307	C.T.H. "A" RT.	896
13+299-13+331	C.T.H. "A" LT.	38
13+315-13+331	C.T.H. "A" RT.	26
SUBTOTAL		3,586
PROJ. 4994-00-82 CATEGORY 0020		
19+932-19+988	C.T.H. "AA" LT.	56
19+932-19+975	C.T.H. "AA" RT.	43
19+932-19+995	C.T.H. "AA" RT.	24
19+994-20+000	C.T.H. "AA" LT.	6
SUBTOTAL		129
TOTAL		6,899

*-NEW MISCELLANEOUS QUANTITY
SALVAGED ASPHALTIC PAVEMENT, BASE COURSE

STATION-STATION	LOCATION	QUANTITY (m3)	REMARKS
10+000-11+575	C.T.H. "A"	2,550	DISPLACES CRUSHED AGGREGATE BASE COURSE
11+270-11+440	C.T.H. "A"	1,929	MARSH EXCAVATION BACKFILL
11+575-13+410	C.T.H. "A"	1,929	DISPLACES CRUSHED AGGREGATE BASE COURSE
TOTAL		6,408	

*-REVISED MISCELLANEOUS QUANTITY
CRUSHED AGGREGATE BASE COURSE (150 mm)

STATION-STATION	LOCATION	CRUSHED AGGREGATE BASE COURSE MAINLINE Mg	WATER KL
PROJ. 4994-00-78			
10+000-11+575	C.T.H. "A"	4,330	377
1+010-10+020	MacARTHUR LN.	44	2
2+008-2+040	SHADOW LN.	124	6
3+007-3+020	MILLER LN.	44	2
4+007-4+030	RIDGE LN.	75	3
5+007-5+030	KEENVILLE AVE.	91	4
6+007-6+020	DRIFTWOOD LN.	52	3
6+970-7+030	SNELL RD.	300	13
	P.E.'s	740	31
SUBTOTALS		5,800	441
PROJ. 4994-00-82 CATEGORY 0010			
11+575-13+410	C.T.H. "A"	5,575	429
8+008-8+040	PICKETT AVE.	139	6
8+965-9+025	BUTLER AVE.	201	9
9+062.5-10+037.5	C.T.H. "Y"	368	16
	P.E.'s	254	11
SUBTOTALS		6,537	471
PROJ. 4994-00-82 CATEGORY 0020			
19+932-20+000	C.T.H. "AA"	344	15
SUBTOTALS		344	15
TOTALS		12,681	927

CROSS DRAINS

STATION	LOCATION	DIAMETER		R.C.C.P. CLASS	ELEVATION		ENDWALLS 750 mm R.C.C.P. EACH
		750 mm	1050 mm		INLET	OUTLET	
PROJ. 4994-00-78							
10+380	C.T.H. "A"	88		III	227.200	227.100	
11+300	C.T.H. "A"	46		III	227.700	227.600	4
11+440	C.T.H. "A"	84		III	227.900	227.800	4
TOTALS		130	88				

REVISED SHEET

*-DENOTES REVISED OR NEW MISCELLANEOUS QUANTITY

ASPHALTIC CONCRETE PAVEMENT, TYPE "MV",
ASPHALTIC MATERIAL FOR PLANT MIXES, AND TACK COAT

STATION-STATION	LOCATION	ASPHALTIC CONCRETE PAVEMENT TYPE "MV"		ASPHALTIC MATERIAL FOR PLANT MIXES FOR TACK COAT	
		Mg	Mg	5.6% Mg	L
PROJ. 4994-00-78					
1+009.5-1+020	MacARTHUR LN.	9	1	9	
2+010-2+040	SHADOW LN.	27	2	26	
3+009.5-3+020	MILLER LN.	9	1	9	
4+009.5-4+030	RIDGE LN.	16	1	16	
5+009.5-5+030	KEENVILLE AVE.	20	1	19	
6+009.5-6+020	DRIFTWOOD LN.	11	1	11	
6+970-7+030	SNELL RD.	80	5	51	
	P.E.'s	111	7	107	
SUBTOTALS		283	19	248	
PROJ. 4994-00-82 CATEGORY 0010					
13+331-13+410	C.T.H. "A"	209	12	81	
8+010-8+040	PICKETT AVE.	30	2	29	
8+965-8+990	BUTLER AVE.	23	1	22	
9+009.5-9+025	BUTLER AVE.	21	1	20	
9+062.5-9+090	C.T.H. "Y"	50	3	32	
10+010-10+37.5	C.T.H. "Y"	49	3	31	
	P.E.'s	43	2	41	
SUBTOTALS		425	24	256	
TOTALS		708	43	504	

TOPSOIL, MULCHING, FERTILIZER, AND SEEDING

STATION-STATION	LOCATION	TOPSOIL m2	MULCH m2	FERTILIZER TYPE "B"		SEEDING NO 40 kg
				kg	kg	
PROJ. 4994-00-78						
10+00-11+575	C.T.H. "A"	15,331	15,331	537		154
1+00-1+020	MacARTHUR LN.	77	77	3		1
2+000-2+040	SHADOW LN.	161	161	6		2
3+000-3+020	MILLER LN.	55	55	2		1
4+000-4+030	RIDGE LN.	96	96	4		1
5+000-5+030	KEENVILLE AVE.	210	210	8		2
6+000-6+020	DRIFTWOOD LN.	91	91	3		1
6+970-7+030	SNELL RD.	576	576	20		6
SUBTOTALS		16,597	16,597	583		168
PROJ. 4994-00-82 CATEGORY 0010						
11+575-13+410	C.T.H. "A"	17,854	17,854	625		179
8+000-8+040	PICKETT AVE.	257	257	9		3
8+965-9+025	BUTLER AVE.	382	382	14		4
9+962.5-10+037.5	C.T.H. "Y"	432	432	15		5
SUBTOTALS		18,925	18,925	663		191
PROJ. 4994-00-82 CATEGORY 0020						
19+932-19+987	C.T.H. "AA" LT.	165	165	6		2
19+32-19+972	C.T.H. "AA" RT.	120	120	5		2
19+971-19+992	C.T.H. "AA" RT.	70	70	3		1
19+995-20+000	C.T.H. "AA" LT.	15	15	1		1
SUBTOTALS		370	370	15		6
TOTALS		35,892	35,892	1,261		365

PAVEMENT TIES

STATION	LOCATION	QUANTITY EACH	REMARKS
PROJ. 4994-00-78			
10+000	C.T.H. "A"	45	
10+436	C.T.H. "A" LT.	12	
11+253	C.T.H. "A" RT.	20	
SUBTOTAL		77	
PROJ. 4994-00-82 CATEGORY 0020			
19+932	C.T.H. "AA"	46	
19+994-20+000	C.T.H. "AA" RT.	18	ALONG NICOLET AVE.
20+000	C.T.H. "AA"	88	
SUBTOTAL		152	
TOTAL		229	

CONCRETE PAVEMENT, 200 mm

STATION-STATION	LOCATION	QUANTITY m2
PROJ. 4994-00-78		
10+000-11+575	C.T.H. "A"	20,790
1+006.5-1+009.5	MacARTHUR LN.	47
2+007-2+010	SHADOW LN.	58
3+006.5-3+009.5	MILLER LN.	44
4+006.5-4+009.5	RIDGE LN.	44
5+006.5-5+009.5	KEENVILLE AVE.	57
6+006.5-6+009.5	DRIFTWOOD LN.	57
6+990.5-6+993.5	SNELL RD.	81
7+006.5-7+009.5	SNELL RD.	81
SUBTOTAL		21,259
PROJ. 4994-00-82 CATEGORY 0010		
11+575-13+331	C.T.H. "A"	23,182
8+007-8+010	PICKETT AVE.	73
8+990-8+993	BUTLER AVE.	61
9+006.5-9+009.5	BUTLER AVE.	67
9+990-9+993	C.T.H. "Y"	86
10+007-10+010	C.T.H. "Y"	85
SUBTOTAL		23,554
PROJ. 4994-00-82 CATEGORY 0020		
19+932-20+000	C.T.H. "AA"	817
SUBTOTAL		817
TOTAL		45,630

PAVEMENT GAPS

STATION-STATION	LOCATION	QUANTITY EACH	REMARKS
PROJ. 4994-00-78			
10+370	C.T.H. "A"- RT.	1	MACARTHUR LANE
10+464	C.T.H. "A"- RT.	1	SHADOW LANE
10+658	C.T.H. "A"- LT.	1	
10+776	C.T.H. "A"- LT.	1	
10+934	C.T.H. "A"- LT.	1	
10+993	C.T.H. "A"- LT.	1	
11+575	C.T.H. "A"- LT./RT.	1	SNELL ROAD
SUBTOTAL		7	
PROJ. 4994-00-82 CATEGORY 0010			
12+331	C.T.H. "A"- LT	1	
13+300	C.T.H. "A"- LT./RT.	1	C.T.H. "Y"
SUBTOTAL		2	
TOTAL		9	

CONCRETE DRIVEWAYS, 150 mm

STATION-STATION	LOCATION	QUANTITY m2
PROJ. 4994-00-78		
10+436	C.T.H. "A" LT.	28
11+253	C.T.H. "A" RT.	34
SUBTOTAL		62
PROJ. 4994-00-82 CATEGORY 0010		
9+021	BUTLER AVE. RT.	50
9+007-9+025	BUTLER AVE. RT.	70
9+012-9+025	BUTLER AVE. LT.	22
SUBTOTAL		142
TOTAL		204

CONCRETE MASONRY, ENDWALLS

STATION-STATION	LOCATION	QUANTITY m3
PROJ. 4994-00-78		
10+376	C.T.H. "A" LT.	4
10+387	C.T.H. "A" RT.	4
11+432	C.T.H. "A" RT.	2
11450	C.T.H. "A" LT.	2
TOTAL		12

ORIGINATOR: DJD
 PROJECT NO: 440278.00
 REVISION BY: [blank]
 DATE REVISION: [blank]
 LEVELS ON: 1, 2, 3, 48, 50, 51, 52, 53, 54, 55, 56, 57, 58, 59, 60, 61, 62.
 PLOT NAME: [blank]
 SCALE: [blank]
 DATE: 7/1/99
 FILE NAME: [blank]

CONCRETE CURB AND GUTTER, 750 mm TYPE 'A'

STATION-STATION	LOCATION	QUANTITY m
PROJ. 4994-00-78		
10+000-11+571	C.T.H. "A" LT.	1,577
10+000-10+367	C.T.H. "A" RT.	371
10+375-10+471	C.T.H. "A" RT.	108
10+477-10+641	C.T.H. "A" RT.	182
10+648-10+724	C.T.H. "A" RT.	84
10+732-10+773	C.T.H. "A" RT.	53
10+781-11+017	C.T.H. "A" RT.	241
11+026-11+570	C.T.H. "A" RT.	562
SUBTOTAL		3,184
PROJ. 4994-00-82 CATEGORY 0010		
11+580-12+418	C.T.H. "A" LT.	854
11+580-12+279	C.T.H. "A" RT.	727
12+426-13+289	C.T.H. "A" LT.	879
12+288-12+422	C.T.H. "A" RT.	166
12+432-13+307	C.T.H. "A" RT.	896
13+299-13+331	C.T.H. "A" LT.	38
13+315-13+331	C.T.H. "A" RT.	26
SUBTOTAL		3,586
PROJ. 4994-00-82 CATEGORY 0020		
19+932-19+988	C.T.H. "AA" LT.	56
19+932-19+975	C.T.H. "AA" RT.	43
19+932-19+995	C.T.H. "AA" RT.	24
19+994-20+000	C.T.H. "AA" LT.	6
SUBTOTAL		129
TOTAL		6,899

CRUSHED AGGREGATE BASE COURSE (150 mm)

STATION-STATION	LOCATION	CRUSHED AGGREGATE BASE COURSE MAINLINE Mg	WATER KL
PROJ. 4994-00-78			
10+000-11+575	C.T.H. "A"	8,960	377
1+010-10+020	MacARTHUR LN.	44	2
2+008-2+040	SHADOW LN.	124	6
3+007-3+020	MILLER LN.	44	2
4+007-4+030	RIDGE LN.	75	3
5+007-5+030	KEENVILLE AVE.	91	4
6+007-6+020	DRIFTWOOD LN.	52	3
6+970-7+030	SNELL RD. P.E.'s	300 740	13 31
SUBTOTALS		10,430	441
PROJ. 4994-00-82 CATEGORY 0010			
11+575-13+410	C.T.H. "A"	10,205	429
8+008-8+040	PICKETT AVE.	139	6
8+965-9+025	BUTLER AVE.	201	9
9+062.5-10+037.5	C.T.H. "Y" P.E.'s	368 254	16 11
SUBTOTALS		11,167	471
PROJ. 4994-00-82 CATEGORY 0020			
19+932-20+000	C.T.H. "AA"	344	15
SUBTOTALS		344	15
TOTALS		21,941	927

CROSS DRAINS

STATION	LOCATION	DIAMETER		R.C.C.P. CLASS	ELEVATION		ENDWALLS 750 mm R.C.C.P.
		750 mm	1050 mm		INLET	OUTLET	
PROJ. 4994-00-78							
10+380	C.T.H. "A"	88		III	227.200	227.100	
11+300	C.T.H. "A"	46		III	227.700	227.600	4
11+440	C.T.H. "A"	84		III	227.900	227.800	
TOTALS		130	88				4

**ASPHALTIC CONCRETE PAVEMENT, TYPE "MV",
ASPHALTIC MATERIAL FOR PLANT MIXES, AND TACK COAT**

STATION-STATION	LOCATION	ASPHALTIC CONCRETE PAVEMENT		ASPHALTIC MATERIAL FOR PLANT MIXES		TACK COAT FOR
		TYPE "MV" Mg	FOR PLANT MIXES Mg	FOR PLANT MIXES @ 5.6% Mg	TACK COAT L	
PROJ. 4994-00-78						
1+009.5-1+020	MacARTHUR LN.	9	1			
2+010-2+040	SHADOW LN.	27	2			26
3+009.5-3+020	MILLER LN.	9	1			9
4+009.5-4+030	RIDGE LN.	16	1			16
5+009.5-5+030	KEENVILLE AVE.	20	1			19
6+009.5-6+020	DRIFTWOOD LN.	11	1			11
6+970-7+030	SNELL RD.	80	5			51
P.E.'s		111	7			107
SUBTOTALS		283	15			248
PROJ. 4994-00-82 CATEGORY 0010						
13+331-13+410	C.T.H. "A"	209	12			81
8+010-8+040	PICKETT AVE.	30	2			29
8+965-8+990	BUTLER AVE.	23	1			22
9+009.5-9+025	BUTLER AVE.	21	1			20
9+062.5-9+090	C.T.H. "Y"	50	3			32
10+010-10+37.5	C.T.H. "Y"	49	3			31
P.E.'s		43	2			41
SUBTOTALS		425	24			256
TOTALS		708	43			504

TOPSOIL, MULCHING, FERTILIZER, AND SEEDING

STATION-STATION	LOCATION	TOPSOIL m2	MULCH m2	FERTILIZER TYPE "B" kg	SEEDING NO 40 kg
10+00-11+575	C.T.H. "A"	15,331	15,331	537	154
1+00-1+020	MacARTHUR LN.	77	77	3	1
2+000-2+040	SHADOW LN.	161	161	6	2
3+000-3+020	MILLER LN.	55	55	2	1
4+000-4+030	RIDGE LN.	96	96	4	1
5+000-5+030	KEENVILLE AVE.	210	210	8	2
6+000-6+020	DRIFTWOOD LN.	91	91	3	1
6+970-7+030	SNELL RD.	576	576	20	6
SUBTOTALS		16,597	16,597	583	168
PROJ. 4994-00-82 CATEGORY 0010					
11+575-13+410	C.T.H. "A"	17,854	17,854	625	179
8+000-8+040	PICKETT AVE.	257	257	9	3
8+965-9+025	BUTLER AVE.	382	382	14	4
9+962.5-10+037.5	C.T.H. "Y"	432	432	15	5
SUBTOTALS		18,925	18,925	663	191
PROJ. 4994-00-82 CATEGORY 0020					
19+932-19+987	C.T.H. "AA" LT.	165	165	6	2
19+32-19+972	C.T.H. "AA" RT.	120	120	5	2
19+971-19+992	C.T.H. "AA" RT.	70	70	3	1
19+995-20+000	C.T.H. "AA" LT.	15	15	1	1
SUBTOTALS		370	370	15	6
TOTALS		35,892	35,892	1,261	365

PAVEMENT TIES

STATION	LOCATION	QUANTITY EACH	REMARKS
PROJ. 4994-00-78			
10+000	C.T.H. "A"	45	
10+436	C.T.H. "A" LT.	12	
11+253	C.T.H. "A" RT.	20	
SUBTOTAL		77	
PROJ. 4994-00-82 CATEGORY 0020			
19+932	C.T.H. "AA"	46	
19+994-20+000	C.T.H. "AA" RT.	18	ALONG NICOLET AVE.
20+000	C.T.H. "AA"	88	
SUBTOTAL		152	
TOTAL		229	

CONCRETE PAVEMENT, 200 mm

STATION-STATION	LOCATION	QUANTITY m2
PROJ. 4994-00-78		
10+000-11+575	C.T.H. "A"	20,790
1+006.5-1+009.5	MacARTHUR LN.	47
2+007-2+010	SHADOW LN.	58
3+006.5-3+009.5	MILLER LN.	44
4+006.5-4+009.5	RIDGE LN.	44
5+006.5-5+009.5	KEENVILLE AVE.	57
6+006.5-6+009.5	DRIFTWOOD LN.	57
6+990.5-6+993.5	SNELL RD.	81
7+006.5-7+009.5	SNELL RD.	81
SUBTOTAL		21,259
PROJ. 4994-00-82 CATEGORY 0010		
11+575-13+331	C.T.H. "A"	23,182
8+007-8+010	PICKETT AVE.	73
8+990-8+993	BUTLER AVE.	61
9+006.5-9+009.5	BUTLER AVE.	67
9+990-9+993	C.T.H. "Y"	86
10+007-10+010	C.T.H. "Y"	85
SUBTOTAL		23,554
PROJ. 4994-00-82 CATEGORY 0020		
19+932-20+000	C.T.H. "AA"	817
SUBTOTAL		817
TOTAL		45,630

PAVEMENT GAPS

STATION-STATION	LOCATION	QUANTITY EACH	REMARKS
PROJ. 4994-00-78			
10+370	C.T.H. "A"- RT.	1	MACARTHUR LANE
10+464	C.T.H. "A"- RT.	1	SHADOW LANE
10+658	C.T.H. "A"- LT.	1	
10+776	C.T.H. "A"- LT.	1	
10+934	C.T.H. "A"- LT.	1	
10+993	C.T.H. "A"- LT.	1	
11+575	C.T.H. "A"- LT./RT.	1	SNELL ROAD
SUBTOTAL		7	
PROJ. 4994-00-82 CATEGORY 0010			
12+331	C.T.H. "A"- LT	1	
13+300	C.T.H. "A"- LT./RT.	1	C.T.H. "Y"
SUBTOTAL		2	
TOTAL		9	

CONCRETE DRIVEWAYS, 150 mm

STATION-STATION	LOCATION	QUANTITY m2
PROJ. 4994-00-78		
10+436	C.T.H. "A" LT.	28
11+253	C.T.H. "A" RT.	34
SUBTOTAL		62
PROJ. 4994-00-82 CATEGORY 0010		
9+021	BUTLER AVE. RT.	50
9+007-9+025	BUTLER AVE. RT.	70
9+012-9+025	BUTLER AVE. LT.	22
SUBTOTAL		142
TOTAL		204

CONCRETE MASONRY, ENDWALLS

STATION-STATION	LOCATION	QUANTITY m3
PROJ. 4994-00-78		
10+376	C.T.H. "A" LT.	4
10+387	C.T.H. "A" RT.	4
11+432	C.T.H. "A" RT.	2
11+450	C.T.H. "A" LT.	2
TOTAL		12

GB2
 PEN TABLE = #plot724locser-amv80pp.tbl
 DATE OF PLOT = 07/15/99
 PLOT NO.
 DESIGN FILE IS I:\440278\dgn\MISC.dgn

ORIGINATOR: D.J.D.
 PROJECT NO: 440278.00
 REVISIONS BY: 1, 2, 3, 48, 50, 51, 52, 53, 54, 55, 56, 57, 58, 59, 60, 61, 62.
 DATE REVISIONS: 7/1/99
 FILE NAME: PLOT NAME: SCALE:

STORM SEWER SUMMARY

LOCATION		DIAMETER						TYPE	ELEVATIONS		REMARKS
FROM	TO	300 mm R.C.C.P.	375 mm R.C.C.P.	525 mm R.C.C.P.	600 mm R.C.C.P.	750 mm R.C.C.P.	490x770 R.C.H.E.		INLET	DISCHARGE	
PROJ. 4994-00-78											
1A	1				8			R.C.P., CLASS IV, S.S.	227.923	227.900	
2	1A				12			R.C.P., CLASS IV, S.S.	227.958	227.923	
2A	2	10						R.C.P., CLASS III, S.S.	228.253	227.960	
2B	2	9						R.C.P., CLASS III, S.S.	227.990	227.960	
2C	2B	5						R.C.P., CLASS III, S.S.	228.021	227.990	
3	2		89					R.C.P., CLASS III, S.S.	228.295	227.960	
3A	3	9						R.C.P., CLASS III, S.S.	228.326	228.295	
3B	3	6						R.C.P., CLASS III, S.S.	228.326	228.295	
4	3		75					R.C.P., CLASS III, S.S.	228.509	228.295	
4A	4	10						R.C.P., CLASS III, S.S.	228.539	228.509	
4B	4	7						R.C.P., CLASS III, S.S.	228.539	228.509	
6	5				9			R.C.P., CLASS IV, S.S.	227.137	227.137	
7	6				51			R.C.P., CLASS IV, S.S.	227.198	227.137	
7A	7	10						R.C.P., CLASS III, S.S.	227.289	227.259	
7B	7	8						R.C.P., CLASS III, S.S.	227.289	227.259	
8	7				40			R.C.P., CLASS IV, S.S.	227.244	227.198	
8A	8		13					R.C.P., CLASS III, S.S.	227.350	227.289	
8B	8A	15						R.C.P., CLASS III, S.S.	227.396	227.350	
8C	8	5						R.C.P., CLASS III, S.S.	227.305	227.289	
9	8				58			R.C.P., CLASS IV, S.S.	227.314	227.244	
9A	9	9						R.C.P., CLASS III, S.S.	227.408	227.381	
9B	9			5				R.C.P., CLASS IV, S.S.	227.396	227.381	
9C	9B			2				R.C.P., CLASS IV, S.S.	MATCH	227.396	
10	9				55			R.C.P., CLASS IV, S.S.	227.378	227.314	
10A	10	12						R.C.P., CLASS III, S.S.	227.478	227.442	
11	10					44		R.C.P., CLASS IV, S.S.	227.433	227.378	
11A	11	9						R.C.P., CLASS III, S.S.	227.509	227.472	
11B	11A	3						R.C.P., CLASS III, S.S.	227.497	227.472	
11C	11	9						R.C.P., CLASS III, S.S.	227.928	227.564	
11D	11C	13						R.C.P., CLASS III, S.S.	227.722	227.564	
11E	11C	10						R.C.P., CLASS III, S.S.	----	----	
12	11					44		R.C.P., CLASS IV, S.S.	227.484	227.433	
12A	12	9						R.C.P., CLASS III, S.S.	227.561	227.533	
12B	12	6						R.C.P., CLASS III, S.S.	227.576	227.533	
12C	12B	4						R.C.P., CLASS III, S.S.	227.548	227.533	
13	12					40		R.C.P., CLASS IV, S.S.	227.533	227.484	
13A	13	11						R.C.P., CLASS III, S.S.	227.628	227.594	
13B	13A	5						R.C.P., CLASS III, S.S.	227.740	227.686	
13C	13A	9						R.C.P., CLASS III, S.S.	227.728	227.686	
13D	13C	8						R.C.P., CLASS III, S.S.	227.887	227.807	
14	13				46			R.C.P., CLASS IV, S.S.	227.585	227.533	
14A	14	11						R.C.P., CLASS III, S.S.	227.658	227.625	
14B	14A	3						R.C.P., CLASS III, S.S.	227.731	227.716	
14C	14	17						R.C.P., CLASS III, S.S.	227.676	227.625	
14D	14C	5						R.C.P., CLASS III, S.S.	227.771	227.747	
14E	14D	14						R.C.P., CLASS III, S.S.	227.875	227.808	
15	14				60			R.C.P., CLASS IV, S.S.	227.658	227.585	
15A	15				9			R.C.P., CLASS IV, S.S.	227.744	227.716	
15C	15A					5		R.C.P., CLASS III, S.S.	MATCH	227.744	
15B	15	5						R.C.P., CLASS III, S.S.	227.731	227.716	
16	15				70			R.C.P., CLASS IV, S.S.	227.869	227.658	
16A	16		9					R.C.P., CLASS III, S.S.	227.975	227.929	
16B	16A		4					R.C.P., CLASS III, S.S.	228.073	228.051	
16C	16B	15						R.C.P., CLASS III, S.S.	228.216	228.143	
16D	16	6						R.C.P., CLASS III, S.S.	227.960	227.929	
17	16		79					R.C.P., CLASS III, S.S.	228.408	227.929	
17A	17	9						R.C.P., CLASS III, S.S.	228.524	228.478	
17B	17A	5						R.C.P., CLASS III, S.S.	228.621	228.600	
17C	17	5						R.C.P., CLASS III, S.S.	228.509	228.478	
20	19				54			R.C.P., CLASS IV, S.S.	227.533	227.442	
20A	20		9					R.C.P., CLASS III, S.S.	227.594	227.533	
20B	20		6					R.C.P., CLASS III, S.S.	227.564	227.533	
21	20				100			R.C.P., CLASS IV, S.S.	227.655	227.533	
21A	21	9						R.C.P., CLASS III, S.S.	227.716	227.655	
21B	21	6						R.C.P., CLASS III, S.S.	227.687	227.655	
22B	22A	14						R.C.P., CLASS III, S.S.	228.465	227.765	
22A	22	3						R.C.P., CLASS III, S.S.	227.765	227.750	
25	24				60			R.C.P., CLASS III, S.S.	228.051	227.869	
25A	25	9						R.C.P., CLASS III, S.S.	228.112	228.051	
25B	25	6						R.C.P., CLASS III, S.S.	228.082	228.051	
SUBTOTALS		353	284	7	632	5	128				

STORM SEWER SUMMARY

LOCATION	FROM	TO	300 mm	375 mm	450 mm	525mm	600 mm	750 mm	490 X 770 mm	TYPE	ELEVATIONS	
			(RCCP)	(RCCP)	(RCCP)	(RCCP)	(RCCP)	(RCCP)	(RCCP)		(RCHE)	INLET
PROJECT	4994-00-78		m	m	m	m	m	m	m			
1A	1						8			RCCP, CLASS IV,	227.600	227.600
2	1A						12			RCCP, CLASS IV,	227.881	227.600
2A	2	10								RCCP, CLASS III,	227.926	227.881
2B	2	9								RCCP, CLASS III,	227.921	227.881
2C	2B	5								RCCP, CLASS III,	227.931	227.921
3	2			89						RCCP, CLASS III,	228.145	227.881
3A	3	9								RCCP, CLASS III,	228.185	228.145
3B	3	6								RCCP, CLASS III,	228.185	228.145
4	3			75						RCCP, CLASS III,	258.520	228.145
4A	4	10								RCCP, CLASS III,	228.565	228.520
4B	4	7								RCCP, CLASS III,	228.565	228.520
6	5						9			RCCP, CLASS IV,	227.205	227.205
7	6						51			RCCP, CLASS IV,	227.266	227.205
7A	7	10								RCCP, CLASS III,	227.310	227.266
7B	7	8								RCCP, CLASS III,	227.310	227.266
8	7						40			RCCP, CLASS IV,	227.315	227.266
8A	8			13						RCCP, CLASS III,	227.340	227.315
8B	8A	15								RCCP, CLASS III,	227.410	227.340
8C	8	5								RCCP, CLASS III,	227.340	227.315
9	8						58			RCCP, CLASS IV,	227.385	227.315
9A	9	9								RCCP, CLASS III,	227.430	227.385
9B	9					5				RCCP, CLASS IV,	227.430	227.385
9C	9B					2				RCCP, CLASS IV,	MATCH	227.430
10	9						55			RCCP, CLASS IV,	227.450	227.385
10A	10	12								RCCP, CLASS III,	227.490	227.450
11	10							44		RCCP, CLASS IV,	227.503	227.450
11A	11	9								RCCP, CLASS III,	227.550	227.503
11B	11A	3								RCCP, CLASS III,	227.570	227.550
11C	11	9								RCCP, CLASS III,	227.530	227.503
11D	11C	13								RCCP, CLASS III,	227.570	227.530
11E	11C	10								RCCP, CLASS III,	227.580	227.530
12	11						44			RCCP, CLASS IV,	227.556	227.503
12A	12	9								RCCP, CLASS III,	227.600	227.556
12B	12	6								RCCP, CLASS III,	227.580	227.556
12C	12B	4								RCCP, CLASS III,	227.600	227.580
13	12						40			RCCP, CLASS IV,	227.604	227.556
13A	13	11								RCCP, CLASS III,	227.660	227.604
13B	13A	5								RCCP, CLASS III,	227.680	227.660
13C	13A	9								RCCP, CLASS III,	227.700	227.660
13D	13C	8								RCCP, CLASS III,	227.740	227.700
14	13						46			RCCP, CLASS IV,	227.739	227.604
14A	14	11								RCCP, CLASS III,	227.790	227.739
14B	14A	3								RCCP, CLASS III,	227.800	227.790
14C	14	17								RCCP, CLASS III,	227.790	227.739
14D	14C	5								RCCP, CLASS III,	227.810	227.790
14E	14D	14								RCCP, CLASS III,	227.850	227.810
15	14						60			RCCP, CLASS IV,	227.919	227.739
15A	15						9			RCCP, CLASS IV,	227.950	227.919
15C	15A							5		RCCP, CLASS III,	MATCH	227.950
15B	15	5								RCCP, CLASS III,	227.950	227.919
16	15						70			RCCP, CLASS IV,	228.269	227.919
16A	16			9						RCCP, CLASS III,	228.300	228.269
16B	16A			4						RCCP, CLASS III,	228.320	228.300
16C	16B	15								RCCP, CLASS III,	228.370	228.320
16D	16	6								RCCP, CLASS III,	228.300	228.269
17	16			79						RCCP, CLASS III,	228.669	228.269
17A	17	9								RCCP, CLASS III,	228.700	228.669
17B	17A	5								RCCP, CLASS III,	228.720	228.700
17C	17	5								RCCP, CLASS III,	228.700	228.669
19	18						9			RCCP, CLASS IV,	227.442	227.381
20	19						50			RCCP, CLASS IV,	227.533	227.442
20A	20			9						RCCP, CLASS III,	227.594	227.533
20B	20			6						RCCP, CLASS III,	227.564	227.533
21	20						100			RCCP, CLASS IV,	227.655	227.533
21A	21	9								RCCP, CLASS III,	227.716	227.655
21B	21	6								RCCP, CLASS III,	227.687	227.655
22B	22A	14								RCCP, CLASS III,	228.200	228.170
22A	22	3								RCCP, CLASS III,	228.170	228.150
24	23						10			RCCP, CLASS III,	227.869	227.810
25	24						56			RCCP, CLASS III,	228.051	227.869
25A	25	9								RCCP, CLASS III,	228.112	228.051
25B	25	6								RCCP, CLASS III,	228.082	228.051
SUBTOTALS			353	284		7	643	5	128			

MANHOLE COVERS TYPE J

PROJECT NO.	QUANTITY EACH
4994-00-78	20
4994-00-82 CATEGORY 0010	23
TOTAL	43

INLET COVERS

PROJECT NO.	TYPE H QUANTITY EACH	TYPE H-S QUANTITY EACH	TYPE C QUANTITY EACH	TYPE D QUANTITY EACH
4994-00-78	30	6	13	0
4994-00-82 CATEGORY 0010	35	7	6	1
TOTAL	65	13	19	1

MODIFIED INLETS

PROJECT NO.	QUANTITY TYPE 1 EACH	QUANTITY TYPE 3 EACH
4994-00-78	9	12
4994-00-82 CATEGORY 0010	3	1
TOTAL	12	13

MANHOLES

PROJECT NO.	QUANTITY TYPE 1 EACH	QUANTITY TYPE 3 EACH
4994-00-78	15	6
4994-00-82 CATEGORY 0010	22	2
TOTAL	37	8

INLETS

PROJECT NO.	QUANTITY TYPE 1 EACH	QUANTITY TYPE 3 EACH
4994-00-78	4	23
4994-00-82 CATEGORY 0010	8	37
TOTAL	12	60

REINFORCED CONCRETE ENDWALLS

PROJECT NO.	QUANTITY 300 mm EACH	QUANTITY 600 mm EACH
4994-00-78	2	4
4994-00-82 CATEGORY 0010	1	-
TOTAL	3	4

STORM SEWER SUMMARY

PROJ.	CLASS III	CLASS III	CLASS III	CLASS IV	CLASS III	CLASS IV	CLASS III	CLASS IV
	300 mm R.C.C.P.	375 mm R.C.C.P.	450 mm R.C.C.P.	525 mm R.C.C.P.	600 mm R.C.C.P.	600 mm R.C.C.P.	750 mm R.C.C.P.	490x770 R.C.H.E.
	m	m	m	m	m	m	m	m
PROJ. 4994-00-78								
SUBTOTALS	353	284	0	7	66	577	5	128
PROJ. 4994-00-82 CATEGORY 0010								
SUBTOTALS	477	69	6	0	1,794	0	0	0
TOTALS	830	353	6	7	1,860	577	5	128

ORIGINATOR: DJD DATE: 7/1/99
 PROJECT NO. 440276.00 FILE NAME:
 REVISION BY: SCALE:
 DATE REVISION:
 LEVELS ON = 1, 2, 3, 99, 100
 PLOT NAME: 4994-00-78
 SCALE: 1"=40'
 DATE: 4/7/00
 REVISION BY: [blank]
 DATE REVISION: [blank]

STORM SEWER SUMMARY

LOCATION	300 mm (RCCP)	375 mm (RCCP)	450 mm (RCCP)	525mm (RCCP)	600 mm (RCCP)	750 mm (RCCP)	490 X 770 mm (RCHE)	ELEVATIONS	REMARKS
FROM TO	m	m	m	m	m	m	m	INLET DISCHARGE	
PROJECT 4994-00-78									
26 25					85			RCCP, CLASS III, 228.356	228.051
26A 26	12							RCCP, CLASS III, 228.417	228.356
26B 26	18							RCCP, CLASS III, 228.417	228.356
26C 26B	5							RCCP, CLASS III, 228.448	228.417
26D 26B	14							RCCP, CLASS III, 228.478	228.417
27 26					78			RCCP, CLASS III, 229.057	228.356
27A 27	9							RCCP, CLASS III, 230.276	229.057
27B 27	6							RCCP, CLASS III, 230.276	229.057
28 27					79			RCCP, CLASS III, 230.124	229.057
28A 28	9							RCCP, CLASS III, 230.734	230.124
28B 28	6							RCCP, CLASS III, 230.734	230.124
29 28					124			RCCP, CLASS III, 231.038	230.124
29A 29	9							RCCP, CLASS III, 231.404	231.038
29B 29	6							RCCP, CLASS III, 231.404	231.038
30 29					56			RCCP, CLASS III, 231.648	231.038
30A 30	9							RCCP, CLASS III, 232.258	231.648
30B 30	6							RCCP, CLASS III, 232.258	231.648
31 30					100			RCCP, CLASS III, 232.258	231.648
31A 31	9							RCCP, CLASS III, 232.867	232.258
31B 31	6							RCCP, CLASS III, 232.562	232.258
32 31					72			RCCP, CLASS III, 232.562	232.258
33 32					70			RCCP, CLASS III, 232.867	232.562
33A 33	9							RCCP, CLASS III, 233.020	232.867
33B 33	6							RCCP, CLASS III, 233.020	232.867
34 33					56			RCCP, CLASS III, 233.172	232.867
34A 34	9							RCCP, CLASS III, 233.020	233.172
34B 34	6							RCCP, CLASS III, 233.233	233.172
35 34					75			RCCP, CLASS III, 233.629	233.172
35A 35	14							RCCP, CLASS III, 233.782	233.629
35B 35	12							RCCP, CLASS III, 233.782	233.629
35C 35	21							RCCP, CLASS III, 233.782	233.629
35D 35C	9							RCCP, CLASS III, 233.843	233.782
36 36D			3		3			RCCP, CLASS III, 232.800	232.787
36 36C					6			RCCP, CLASS III, 232.837	232.800
36A 36					10			RCCP, CLASS III, 232.867	232.837
36B 36A			3		3			RCCP, CLASS III, 232.898	232.867
37 36					81			RCCP, CLASS III, 233.050	232.837
38 37					100			RCCP, CLASS III, 233.294	233.050
38A 38	9							RCCP, CLASS III, 233.354	233.294
38B 38	6							RCCP, CLASS III, 233.324	233.294
39 38					66			RCCP, CLASS III, 233.446	233.294
40 39					64			RCCP, CLASS III, 233.599	233.446
40A 40	12							RCCP, CLASS III, 233.660	233.599
40B 40A	12							RCCP, CLASS III, 233.680	233.660
40C 40A	16							RCCP, CLASS III, 233.721	233.660
40D 40C	5							RCCP, CLASS III, 234.485	233.721
40E 40	6							RCCP, CLASS III, 233.629	233.599
41 36					100			RCCP, CLASS III, 233.081	232.837
41A 41	9							RCCP, CLASS III, 233.111	233.081
41B 41	6							RCCP, CLASS III, 233.111	233.081
42 41					100			RCCP, CLASS III, 233.385	233.081
42A 42	9							RCCP, CLASS III, 233.416	233.385
42B 42	6							RCCP, CLASS III, 233.416	233.385
43 42					100			RCCP, CLASS III, 233.934	233.385
43A 43	9							RCCP, CLASS III, 234.500	233.934
43B 43	6							RCCP, CLASS III, 234.500	233.934
44 43					80			RCCP, CLASS III, 235.134	233.934
44A 44	9							RCCP, CLASS III, 236.200	235.134
44B 44	6							RCCP, CLASS III, 236.200	235.134
45 44					100			RCCP, CLASS III, 236.634	235.134
45A 45	9							RCCP, CLASS III, 237.200	236.634
45B 45	6							RCCP, CLASS III, 237.200	236.634
45C 45B	3							RCCP, CLASS III, 237.500	237.200
46 45					95			RCCP, CLASS III, 237.110	236.634
46B 46	13							RCCP, CLASS III, 237.180	237.110
46C 46B	22							RCCP, CLASS III, 237.290	237.180
46D 46C	12							RCCP, CLASS III, 237.350	237.290
46E 46		24						RCCP, CLASS III, 237.200	237.110
46F 46E	25							RCCP, CLASS III, 237.300	237.200
47 46					90			RCCP, CLASS III, 237.218	237.110
47A 47	7							RCCP, CLASS III, 237.300	237.218
48 47		45						RCCP, CLASS III, 237.353	237.218
48A 48	12							RCCP, CLASS III, 237.380	237.218
48B 48	30							RCCP, CLASS III, 237.380	237.353
48C 48B	2							RCCP, CLASS III, 237.400	237.380
SUBTOTALS	477	69	6		1794				
TOTALS	830	353	6	7	2437	5	128		

ORIGINAL D.D. DATE: 7/1/99
 PROJECT NO. 440278.00 FILE NAME:
 REVISIONS BY: DATE REVISIONS:
 LEVELS ON - 1, 2, 3, 48, 50, 51, 52, 99, 100
 PLOT NAME: SCALE:
 DATE: 7/1/99
 FILE NAME:
 REVISIONS BY: DATE REVISIONS:
 LEVELS ON - 1, 2, 3, 48, 50, 51, 52, 99, 100
 CRP: PLOT NAME: SCALE:
 DATE: 7/1/99
 FILE NAME:
 REVISIONS BY: DATE REVISIONS:
 LEVELS ON - 1, 2, 3, 48, 50, 51, 52, 99, 100

MISCELLANEOUS QUANTITIES

HWY: C.T.H. "A"

COUNTY: WINNEBAGO

STATE PROJECT NO: 4994-00-78, 4994-00-82

SHEET NO: 3.E



CB2
 PEN TABLE = #plot72\user\m80pp.tbl
 DATE OF PLOT = 07/15/99
 PLOT NA
 DESIGN FILE IS F:\440278\dgn\MISC.dgn
 50.51.52.53.54.55.56.57.58.59.60.61.62
 ORIGINATOR: DJD
 PROJECT NO. 440278-00
 DATE: 7/1/99
 FILE NAME:
 SCALE:
 PLOT NAME:
 DATE REVISION:
 LEVELS ON - 1, 2, 3, 4, 5, 6, 7, 8, 9, 10, 11, 12, 13, 14, 15, 16, 17, 18, 19, 20, 21, 22, 23, 24, 25, 26, 27, 28, 29, 30, 31, 32, 33, 34, 35, 36, 37, 38, 39, 40, 41, 42, 43, 44, 45, 46, 47, 48

STORM SEWER SUMMARY

LOCATION		DIAMETER			TYPE	ELEVATIONS		REMARKS
FROM	TO	300 mm	450 mm	600 mm		INLET	DISCHARGE	
		R.C.C.P.	R.C.C.P.	R.C.C.P.				
		m	m	m				
PROJ. 4994-00-82 CATEGORY 0010								
26	25			85	R.C.P., CLASS III, S.S.	228.356	228.051	
26A	26	12			R.C.P., CLASS III, S.S.	228.417	228.356	
26B	26	18			R.C.P., CLASS III, S.S.	228.417	228.356	
26C	26B	5			R.C.P., CLASS III, S.S.	228.448	228.417	
26D	26B	14			R.C.P., CLASS III, S.S.	228.478	228.417	
27	26			78	R.C.P., CLASS III, S.S.	229.057	228.356	
27A	27	9			R.C.P., CLASS III, S.S.	230.276	229.057	
27B	27	6			R.C.P., CLASS III, S.S.	230.276	229.057	
28	27			79	R.C.P., CLASS III, S.S.	230.124	229.057	
28A	28	9			R.C.P., CLASS III, S.S.	230.734	230.124	
28B	28	6			R.C.P., CLASS III, S.S.	230.734	230.124	
29	28			82	R.C.P., CLASS III, S.S.	231.038	230.124	
29A	29	9			R.C.P., CLASS III, S.S.	231.404	231.038	
29B	29	6			R.C.P., CLASS III, S.S.	231.404	231.038	
30	29			99	R.C.P., CLASS III, S.S.	231.648	231.038	
30A	30	9			R.C.P., CLASS III, S.S.	232.258	231.648	
30B	30	6			R.C.P., CLASS III, S.S.	232.258	231.648	
31	30			100	R.C.P., CLASS III, S.S.	232.258	231.648	
31A	31	9			R.C.P., CLASS III, S.S.	232.867	232.258	
31B	31	6			R.C.P., CLASS III, S.S.	232.562	232.258	
32	31			72	R.C.P., CLASS III, S.S.	232.562	232.258	
33	32			70	R.C.P., CLASS III, S.S.	232.867	232.562	
33A	33	9			R.C.P., CLASS III, S.S.	233.020	262.867	
33B	33	6			R.C.P., CLASS III, S.S.	233.020	232.867	
34	33			56	R.C.P., CLASS III, S.S.	233.172	232.867	
34A	34	9			R.C.P., CLASS III, S.S.	233.020	233.172	
34B	34	6			R.C.P., CLASS III, S.S.	233.233	233.172	
35	34			75	R.C.P., CLASS III, S.S.	233.629	233.172	
35A	35	14			R.C.P., CLASS III, S.S.	233.782	233.629	
35B	35	12			R.C.P., CLASS III, S.S.	233.782	233.629	
35C	35	21			R.C.P., CLASS III, S.S.	233.782	233.629	
35D	35C	9			R.C.P., CLASS III, S.S.	233.843	233.782	
36	36D		3	3	R.C.P., CLASS III, S.S.	232.800	232.787	
36C	36C			6	R.C.P., CLASS III, S.S.	232.837	232.800	
36A	36		10		R.C.P., CLASS III, S.S.	232.867	232.837	
36B	36A		3	3	R.C.P., CLASS III, S.S.	232.898	232.867	
37	36			81	R.C.P., CLASS III, S.S.	233.050	232.837	
38	37			100	R.C.P., CLASS III, S.S.	233.294	233.050	
38A	38	9			R.C.P., CLASS III, S.S.	233.354	233.294	
38B	38	6			R.C.P., CLASS III, S.S.	233.324	233.294	
39	38			66	R.C.P., CLASS III, S.S.	233.446	233.294	
40	39			64	R.C.P., CLASS III, S.S.	233.599	233.446	
40A	40	12			R.C.P., CLASS III, S.S.	233.660	233.599	
40B	40A	12			R.C.P., CLASS III, S.S.	234.600	233.660	
40C	40A	16			R.C.P., CLASS III, S.S.	233.721	233.660	
40D	40C	5			R.C.P., CLASS III, S.S.	234.485	233.721	
40E	40	6			R.C.P., CLASS III, S.S.	233.629	233.599	
41	36			100	R.C.P., CLASS III, S.S.	233.081	232.837	
41A	41	9			R.C.P., CLASS III, S.S.	233.111	233.081	
41B	41	6			R.C.P., CLASS III, S.S.	233.111	233.081	
42	41			100	R.C.P., CLASS III, S.S.	233.385	233.081	
42A	42	9			R.C.P., CLASS III, S.S.	233.416	233.385	
42B	42	6			R.C.P., CLASS III, S.S.	233.416	233.385	
43	42			100	R.C.P., CLASS III, S.S.	233.934	233.385	
43A	43	9			R.C.P., CLASS III, S.S.	233.965	233.934	
43B	43	6			R.C.P., CLASS III, S.S.	233.965	233.934	
44	43			80	R.C.P., CLASS III, S.S.	235.134	233.934	
44A	44	9			R.C.P., CLASS III, S.S.	236.200	235.134	
44B	44	6			R.C.P., CLASS III, S.S.	236.200	235.134	
45	44			100	R.C.P., CLASS III, S.S.	236.634	235.134	
45A	45	9			R.C.P., CLASS III, S.S.	237.200	236.634	
45B	45	6			R.C.P., CLASS III, S.S.	237.200	236.634	
45C	45B	3			R.C.P., CLASS III, S.S.	237.500	237.200	
46	45			95	R.C.P., CLASS III, S.S.	237.110	236.634	
46A	46	16			R.C.P., CLASS III, S.S.	237.180	237.110	
46B	46	13			R.C.P., CLASS III, S.S.	237.180	237.110	
46C	46B	22			R.C.P., CLASS III, S.S.	237.290	237.180	
46D	46C	12			R.C.P., CLASS III, S.S.	237.350	237.290	
47	46			35	R.C.P., CLASS III, S.S.	237.285	237.110	
47A	47	9			R.C.P., CLASS III, S.S.	237.330	237.285	
47B	47A	1			R.C.P., CLASS III, S.S.	238.750	237.330	
47C	47	6			R.C.P., CLASS III, S.S.	237.330	237.285	
47D	47C	1			R.C.P., CLASS III, S.S.	238.550	237.330	
TOTALS		434	6	1,739				

MANHOLE COVERS TYPE J

PROJECT NO.	QUANTITY EACH
4994-00-78	18
4994-00-82 CATEGORY 0010	22
TOTAL	40

INLET COVERS

PROJECT NO.	TYPE H QUANTITY EACH	TYPE H-S QUANTITY EACH	TYPE C QUANTITY EACH	TYPE D QUANTITY EACH
4994-00-78	31	6	14	0
4994-00-82 CATEGORY 0010	31	9	6	1
TOTAL	62	15	20	1

MODIFIED INLETS

PROJECT NO.	QUANTITY TYPE 1 EACH	QUANTITY TYPE 3 EACH
4994-00-78	9	12
4994-00-82 CATEGORY 0010	1	1
TOTAL	10	13

MANHOLES

PROJECT NO.	TYPE 1 QUANTITY EACH	TYPE 3 QUANTITY EACH
4994-00-78	12	6
4994-00-82 CATEGORY 0010	23	1
TOTAL	35	7

INLETS

PROJECT NO.	TYPE 1 QUANTITY EACH	TYPE 3 QUANTITY EACH
4994-00-78	14	36
4994-00-82 CATEGORY 0010	7	38
TOTAL	21	74

REINFORCED CONCRETE ENDWALLS

PROJECT NO.	300 mm QUANTITY EACH	600 mm QUANTITY EACH
4994-00-78	1	4
4994-00-82 CATEGORY 0010	1	-
TOTAL	2	4

STORM SEWER SUMMARY

PROJ.	CLASS III CLASS III CLASS III CLASS IV CLASS III CLASS IV CLASS III CLASS IV							
	DIAMETER							
	300 mm	375 mm	450 mm	525 mm	600 mm	600 mm	750 mm	490x770
	R.C.C.P.	R.C.C.P.	R.C.C.P.	R.C.C.P.	R.C.C.P.	R.C.C.P.	R.C.C.P.	R.C.H.E.
	m	m	m	m	m	m	m	m
PROJ. 4994-00-78								
SUBTOTALS	353	284	0	7	60	572	5	128
PROJ. 4994-00-82 CATEGORY 0010								
SUBTOTALS	434	0	6	0	1,739	0	0	0
TOTALS	787	284	6	7	1,799	572	5	128

MISCELLANEOUS QUANTITIES

HWY: C.T.H. "A"

COUNTY: WINNEBAGO

STATE PROJECT NO: 4994-00-78, 4994-00-82

SHEET NO: 3E

WISDOT: MSHT 42

MANHOLES, INLETS, AND COVERS

STRUCTURE NUMBER	STATION	LOCATION	STRUCTURE	DISTANCE			COVER	GRATE	ELEVATIONS			REMARKS
				LT/RT	TYPE	TYPE			PAVEMENT	FLOWLINE	DEPTH	
1	10+383	CTH A	ENDWALL	12.5	RT	---	---	---	---	227.600	---	ENDWALL, 600mm
1A	10+377	CTH A	INLET	9.2	RT	3	H	LT	228.932	227.600	0.877	
2	10+369	CTH A	MANHOLE	1.5	RT	1	J	---	229.206	227.881	0.794	
2A	10+364	CTH A	INLET	7.0	LT	3	H	RT	229.125	227.926	0.744	
2B	10+364	CTH A	INLET	9.2	RT	3	H	LT	228.969	227.921	0.593	Modified Inlet
2C	10+362	CTH A	INLET	12.6	RT	1	C	---	228.600	227.931	0.138	Modified Inlet
3	10+280	CTH A	MANHOLE	1.5	RT	1	J	---	229.676	228.145	1.000	
3A	10+280	CTH A	INLET	7.0	LT	3	H	RT	229.574	228.185	0.934	
3B	10+280	CTH A	INLET	7.0	RT	3	H	LT	229.574	228.185	0.934	
4	10+205	CTH A	MANHOLE	1.5	RT	1	J	---	230.287	228.520	1.236	
4A	10+200	CTH A	INLET	7.0	LT	3	H	RT	230.221	228.565	1.201	
4B	10+200	CTH A	INLET	7.0	RT	3	H	LT	230.221	228.565	1.201	
5	10+397	CTH A	ENDWALL	10.0	RT	---	---	---	---	227.205	---	ENDWALL, 600mm
6	10+400	CTH A	MANHOLE	1.5	RT	1	J	---	229.038	227.205	1.302	
7	10+451	CTH A	MANHOLE	1.5	RT	3	J	---	228.770	227.266	0.973	
7A	10+451	CTH A	INLET	7.0	LT	3	H	RT	228.668	227.310	0.903	
7B	10+457	CTH A	INLET	7.0	RT	3	H	LT	228.639	227.310	0.874	
8	10+491	CTH A	MANHOLE	1.5	RT	3	J	---	228.643	227.315	0.797	
8A	10+500	CTH A	INLET	7.0	LT	3	H-S	RT	228.488	227.340	0.693	Modified Inlet
8B	10+514	CTH A	INLET	9.5	LT	1	C	---	228.550	227.410	0.609	Modified Inlet
8C	10+491	CTH A	INLET	7.0	RT	3	H	RT	228.458	227.340	0.663	Modified Inlet
9	10+548	CTH A	MANHOLE	1.5	RT	3	J	---	228.734	227.385	0.818	
9A	10+548	CTH A	INLET	7.0	LT	3	H	LT	228.632	227.430	0.747	
9B	10+548	CTH A	INLET	7.0	RT	3	H	RT	228.632	227.430	0.747	
9C	10+548	CTH A	CONNECT TO EXI	8.5	RT	---	---	---	---	MATCH	---	CONNECT TO EXISTING, 525mm
10	10+602	CTH A	MANHOLE	1.5	RT	1	J	---	228.823	227.450	0.842	
10A	10+602	CTH A	INLET	9.8	LT	1	C	---	228.500	227.490	0.479	Modified Inlet
11	10+646	CTH A	MANHOLE	1.5	RT	3	J	---	228.725	227.503	0.691	
11A	10+649	CTH A	INLET	7.0	LT	3	H-S	RT	228.566	227.550	0.561	Modified Inlet
11B	10+649	CTH A	INLET	9.8	LT	1	C	---	228.800	227.570	0.699	
11C	10+650	CTH A	INLET	9.2	RT	3	H	RT	228.560	227.530	0.575	Modified Inlet
11D	10+638	CTH A	INLET	9.2	RT	3	H	LT	228.608	227.570	0.583	Modified Inlet
11E	10+648	CTH A	INLET	19.3	RT	1	C	---	228.650	227.580	0.539	Modified Inlet
12	10+690	CTH A	MANHOLE	1.5	RT	1	J	---	228.797	227.556	0.710	
12A	10+690	CTH A	INLET	7.0	LT	3	H	LT	228.695	227.600	0.640	Modified Inlet
12B	10+690	CTH A	INLET	7.0	RT	3	H	RT	228.695	227.580	0.660	Modified Inlet
12C	10+687	CTH A	INLET	9.3	RT	1	C	---	228.570	227.600	0.439	Modified Inlet
13	10+729	CTH A	MANHOLE	1.5	RT	1	J	---	228.997	227.604	0.862	
13A	10+731	CTH A	INLET	12.4	RT	3	H	RT	228.842	227.660	0.727	
13B	10+731	CTH A	INLET	17.4	RT	1	C	---	228.800	227.680	0.589	Modified Inlet
13C	10+723	CTH A	INLET	12.2	RT	3	H	RT	228.842	227.700	0.687	Modified Inlet
13D	10+723	CTH A	INLET	19.7	RT	1	C	---	228.800	227.740	0.529	Modified Inlet
14	10+775	CTH A	MANHOLE	1.5	RT	3	J	---	229.294	227.739	1.024	
14A	10+768	CTH A	INLET	7.0	LT	3	H	LT	229.159	227.790	0.914	
14B	10+767	CTH A	INLET	9.6	LT	1	C	---	228.800	227.800	0.469	Modified Inlet
14C	10+782	CTH A	INLET	17.4	LT	3	H	RT	229.090	227.790	0.845	
14D	10+784	CTH A	INLET	21.8	RT	1	C	---	228.950	227.810	0.609	Modified Inlet
14E	10+771	CTH A	INLET	21.8	RT	1	C	---	229.210	227.850	0.829	
15	10+835	CTH A	MANHOLE	1.5	RT	3	J	---	229.479	227.919	1.029	
15A	10+835	CTH A	INLET	7.0	LT	3	H	LT	229.377	227.950	0.972	
15B	10+835	CTH A	INLET	7.0	RT	3	H	RT	229.377	227.950	0.972	
15C	10+835	CTH A	CONNECT TO EXI	11.5	LT	---	---	---	---	MATCH	---	CONNECT TO EXISTING, 750mm
16	10+905	CTH A	MANHOLE	1.5	RT	1	J	---	229.807	228.269	1.007	
16A	10+905	CTH A	INLET	7.0	LT	3	H	LT	229.705	228.300	0.950	
16B	10+905	CTH A	INLET	11.3	LT	1	C	---	229.500	228.320	0.649	
16C	10+890	CTH A	INLET	11.3	LT	1	C	---	229.450	228.370	0.549	Modified Inlet
16D	10+902	CTH A	INLET	7.0	RT	3	H	RT	229.690	228.300	0.935	
17	10+983	CTH A	MANHOLE	1.5	RT	1	J	---	230.180	228.669	0.980	
17A	10+983	CTH A	INLET	7.0	LT	3	H	LT	230.072	228.700	0.917	
17B	10+983	CTH A	INLET	11.7	LT	1	C	---	230.150	228.720	0.899	
17C	10+983	CTH A	INLET	7.0	RT	3	H	RT	230.072	228.700	0.917	
19	11+294	CTH A	ENDWALL	11.0	RT	---	---	---	---	227.381	---	ENDWALL, 600mm
20	11+240	CTH A	MANHOLE	1.5	RT	1	J	---	228.870	227.533	0.806	
20A	11+240	CTH A	INLET	7.0	LT	3	H-S	RT	228.743	227.594	0.694	Modified Inlet
20B	11+240	CTH A	INLET	7.0	RT	3	H-S	LT	228.743	227.564	0.724	
21	11+140	CTH A	MANHOLE	1.5	RT	1	J	---	229.593	227.655	1.407	
21A	11+140	CTH A	INLET	7.0	LT	3	H	RT	229.491	227.716	1.320	
21B	11+140	CTH A	INLET	7.0	RT	3	H	LT	229.491	227.687	1.349	
22	11+400	CTH A	ENDWALL	9.7	RT	---	---	---	---	228.150	---	ENDWALL, 300mm
22A	11+400	CTH A	INLET	7.0	LT	3	H-S	RT	229.154	228.170	0.529	Modified Inlet
22B	11+400	CTH A	INLET	7.0	RT	3	H-S	LT	229.154	228.200	0.499	Modified Inlet
24	11+440	CTH A	ENDWALL	11.0	RT	---	---	---	---	227.810	---	ENDWALL, 600mm
25	11+500	CTH A	MANHOLE	1.5	RT	1	J	---	229.786	228.051	1.204	
25A	11+500	CTH A	INLET	7.0	LT	3	H	LT	229.681	228.112	1.114	
25B	11+500	CTH A	INLET	7.0	RT	3	H	RT	229.681	228.082	1.144	

ORIGINATOR: D.J.D. DATE: 7/11/99
 PROJECT NO: 440278.00 FILE NAME:
 REVISION: 1, 2, 3, 48, 50, 51, 52, 53, 54, 55, 56, 57, 58, 59, 60, 61, 62.
 LEVELS ON: 1, 2, 3, 48, 50, 51, 52, 53, 54, 55, 56, 57, 58, 59, 60, 61, 62.
 PLOT NAME: 440278.dgn
 SCALE: 1"=40'
 DATE: 7/11/99
 FILE NAME: 440278.tbl
 DESIGN FILE IS: 440278.dgn

MISCELLANEOUS QUANTITIES

STORM SEWER CHANGES

- ① Str. 2C was originally planned to be a modified inlet. The revised sheet from 5/16/00 changed 2C to an endwall. The flowline was not changed. The correct endwall flowline was changed to 228.550.
- ② Joint ties added on endwalls per Contract Modification. Endwall no.: ①, ⑤, ⑱, ⑳ and the cross drains at STA. 11+300 LT. + RT.
- ③ MH ⑱ did not appear on the plan/profile sheets. Endwall ⑱ was not shown on the plan/profile sheets. The endwall offset from Φ of 9.3 m RT. had to be moved to 11 m RT. for sloping. The plan grade for the endwall of 227.381 was 0.369 m below the ditch @ STA. 11+300 RT. The endwall grade and pipe slope from MH 20 had to be changed.
- ④ Inlet 4B flowline changed to 228.887 to clear force main conflict.
- ⑤ Inlet 14E grate flowline lowered to 229.150 to match existing ditch grade.
- ⑥ Inlet 11E flowline raised to 227.64. Also pipe run from 11E to 11C was changed to 250 mm PVC due to a conflict with a gas main.

- ⑦ Inlet 11D was moved S.W. along the radius to avoid a gas main conflict.
- ⑧ Concrete collars were poured around the connection from ⑨C to the existing 525 mm Storm sewer, and at the connection of the new 525 mm Storm to inlet ⑨B. The new 525 mm Storm was laid at approx. 35% thus collars were required.
- ⑨ Manholes ⑦ + ⑧ moved approx. 1m towards E due to utility conflicts. (Forcemain + Forcemain manholes).
- ⑩ Inlet ②1B Flowline raised by 0.61m to clear watermain
- ⑪ Inlets ④B + ④2B structure depths and flowline grades had to be modified to clear sanitary sewer.
- ⑫ Inlet ⑧B casting flowline was lowered by 0.218m to match the existing swale.
- ⑬ Inlet ⑩A top of casting (flowline) was lowered 0.11m to match swale
- ⑭ Inlet ③6C installed per plan then Sanitary sewer was located directly below the inlet. The inlet could not be placed directly on the PVC sewer main. The inlet was removed.

(15) Manhole (46) had to be moved 3M North due to conflict with the 300mm run from (46) to (46B). A gas Main crossed C.T.H. "A" R/W in the S.E. corner of "Y" + "A"

(16) Inlet (45C) was eliminated, Not needed.

(17) Inlet (43A) was lowered to 234.000 to avoid a conflict with the Sanitary Sewer. FE lowered by 0.50 M.

(18) Inlet flowlines for (46B), (46C) and (46D) were raised due to conflicts with Ameritech's buried facilities. Each Inlet was raised approx. 0.26 M.

(19) Inlet 46F was moved South along the radius due to a conflict with the Sprint F.O. package crossing C.T.H. "Y".


(20) Str. (36A) was changed from a type 3 inlet to a type 1 Manhole. 600mm RCP storm through a type 3 inlet was not possible.

(21) Manholes (10), (12) and (13) were planned to be type 1 structures. The 490mm x 770mm storm sewer will not fit in a type 1 Manhole. (10), (12) and (13) were changed to type 3 Manholes.

(22) MH 36B and 36D covers were changed to type C. Existing covers could not be salvaged due to poor condition.

(23) Inlets 46E, 46F and 47A were changed to Type 3 inlets. The planned type 1 inlets cannot accommodate the planned H or H-S inlet covers.

MH 15c was added to provide clearance for the slipform paver. See below.

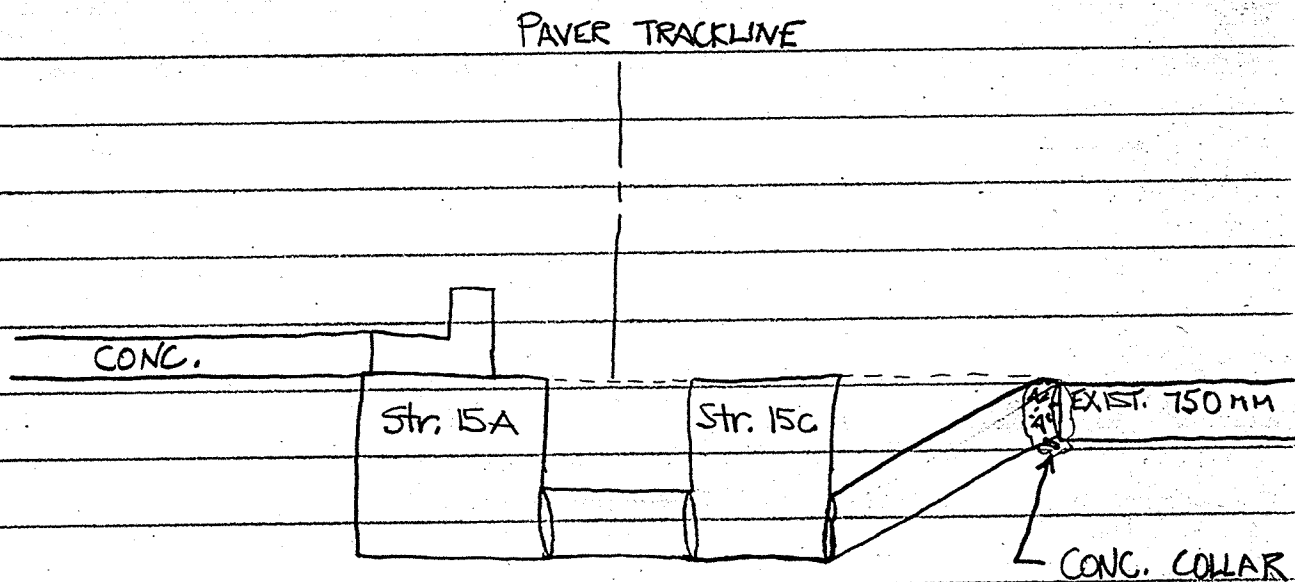

MANHOLES, INLETS, AND COVERS

STRUCTURE NUMBER	STATION	LOCATION	STRUCTURE	DISTANCE		COVER	GRATE LT/RT	ELEVATIONS	FLOWLINE	DEPTH	REMARKS	
				LT/RT	TYPE							
2	1	10+383	CTH A	ENDWALL	12.5	RT	---	---	227.600	---	ENDWALL, 600mm	
1A	10+377	CTH A	INLET	9.2	RT	3	H	LT	228.932	227.600	1.030	
2	10+369	CTH A	MANHOLE	1.5	RT	1	J	---	229.206	227.881	0.750 0.950	
2A	10+364	CTH A	INLET	7.0	LT	3	H	RT	229.125	227.926	0.897	
2B	10+364	CTH A	INLET	9.2	RT	3	H	LT	228.969	227.921	0.746	
1	2C	10+362	CTH A	ENDWALL	12.6	RT	---	---	227.931	---	ENDWALL, 300mm	
3	10+280	CTH A	MANHOLE	1.5	RT	1	J	---	229.676	228.145	0.956 1.156	
3A	10+280	CTH A	INLET	7.0	LT	3	H	RT	229.574	228.185	1.087	
3B	10+280	CTH A	INLET	7.0	RT	3	H	LT	229.574	228.185	1.087	
4	10+205	CTH A	MANHOLE	1.5	RT	1	J	---	230.287	228.520	1.192 1.392	
4A	10+200	CTH A	INLET	7.0	LT	3	H	RT	230.221	228.565	1.354	
4B	10+200	CTH A	INLET	7.0	RT	3	H	LT	230.221	228.565	1.354	
2	5	10+397	CTH A	ENDWALL	10.0	RT	---	---	---	227.205	---	ENDWALL, 600mm
6	10+400	CTH A	MANHOLE	1.5	RT	1	J	---	229.038	227.205	1.258 1.458	
7	10+451	CTH A	MANHOLE	0.5	RT	3	J	---	228.770	227.266	0.929 1.129	
7A	10+451	CTH A	INLET	7.0	LT	3	H	RT	228.668	227.310	1.056	
7B	10+457	CTH A	INLET	7.0	RT	3	H	LT	228.639	227.310	1.027	
8	10+491	CTH A	MANHOLE	0.5	RT	3	J	---	228.643	227.315	0.753 0.953	
8A	10+500	CTH A	INLET	7.0	LT	3	H-S	RT	228.488	227.340	0.846	
8B	10+514	CTH A	INLET	9.5	LT	1	C	---	228.550	227.410	0.761	
8C	10+491	CTH A	INLET	7.0	RT	3	H	RT	228.458	227.340	0.816	
9	10+548	CTH A	MANHOLE	1.5	RT	3	J	---	228.734	227.385	0.774 0.974	
9A	10+548	CTH A	INLET	7.0	LT	3	H	LT	228.632	227.430	0.900	
9B	10+548	CTH A	INLET	7.0	RT	3	H	RT	228.632	227.430	0.900	
9C	10+548	CTH A	CONNECT TO EXI	8.5	RT	---	---	---	---	---	CONNECT TO EXISTING, 525mm	
10	10+602	CTH A	MANHOLE	1.5	RT	1	J	---	228.823	227.450	0.798 0.998	
10A	10+602	CTH A	INLET	9.8	LT	1	C	---	228.500	227.490	0.631	
11	10+646	CTH A	MANHOLE	1.5	RT	3	J	---	228.725	227.503	0.647 0.847	
11A	10+649	CTH A	INLET	7.0	LT	3	H-S	RT	228.566	227.550	0.714	
11B	10+649	CTH A	INLET	9.8	LT	1	C	---	228.800	227.570	0.851	
11C	10+650	CTH A	INLET	9.2	RT	3	H	RT	228.560	227.530	0.728	
11D	10+638	CTH A	INLET	9.2	RT	3	H	LT	228.608	227.570	0.736	
11E	10+648	CTH A	INLET	19.3	RT	1	C	---	228.650	227.500	0.691	
12	10+690	CTH A	MANHOLE	1.5	RT	1	J	---	228.797	227.556	0.660 0.860	
12A	10+690	CTH A	INLET	7.0	LT	3	H	LT	228.695	227.600	0.793	
12B	10+690	CTH A	INLET	7.0	RT	3	H	RT	228.695	227.580	0.813	
12C	10+687	CTH A	INLET	9.3	RT	1	C	---	228.570	227.600	0.591	
13	10+729	CTH A	MANHOLE	1.5	RT	1	J	---	228.997	227.604	0.818 1.018	
13A	10+731	CTH A	INLET	12.4	RT	3	H	RT	228.842	227.660	0.880	
13B	10+731	CTH A	INLET	17.4	RT	1	C	---	228.800	227.680	0.741	
13C	10+723	CTH A	INLET	12.2	RT	3	H	RT	228.842	227.700	0.840	
13D	10+723	CTH A	INLET	19.7	RT	1	C	---	228.800	227.740	0.681	
14	10+775	CTH A	MANHOLE	1.5	RT	3	J	---	229.294	227.739	0.980 1.180	
14A	10+768	CTH A	INLET	7.0	LT	3	H	LT	229.159	227.790	1.067	
14B	10+767	CTH A	INLET	9.6	LT	1	C	---	228.800	227.800	0.621	
14C	10+782	CTH A	INLET	17.4	LT	3	H	RT	229.090	227.790	0.998	
14D	10+784	CTH A	INLET	21.8	RT	1	C	---	228.950	227.810	0.761	
14E	10+771	CTH A	INLET	21.8	RT	1	C	---	229.210	227.860	0.981	
15	10+835	CTH A	MANHOLE	1.5	RT	3	J	---	229.479	227.919	0.905 1.185	
15A	10+835	CTH A	MANHOLE	7.0	LT	1	H	LT	229.377	227.950	1.125 1.325	
15B	10+835	CTH A	INLET	7.0	RT	3	H	RT	229.377	227.950	1.125	
15C	10+835	CTH A	CONNECT TO EXI	11.5	LT	---	---	---	229.600	MATCH	CONNECT TO EXISTING, 750mm	
16	10+905	CTH A	MANHOLE	1.5	RT	1	J	---	229.807	228.269	0.963 1.163	
16A	10+905	CTH A	INLET	7.0	LT	3	H	LT	229.705	228.300	1.103	
16B	10+905	CTH A	INLET	11.3	LT	1	C	---	229.500	228.320	0.801	
16C	10+890	CTH A	INLET	11.3	LT	1	C	---	229.450	228.370	0.701	
16D	10+902	CTH A	INLET	7.0	RT	3	H	RT	229.690	228.300	1.088	
17	10+983	CTH A	MANHOLE	1.5	RT	1	J	---	230.180	228.669	0.936 1.136	
17A	10+983	CTH A	INLET	7.0	LT	3	H	LT	230.072	228.700	1.070	
17B	10+983	CTH A	INLET	11.7	LT	1	C	---	230.150	228.720	1.051	
17C	10+983	CTH A	INLET	7.0	RT	3	H	RT	230.072	228.700	1.070	
18	11+294	CTH A	ENDWALL	11.9	RT	---	---	---	227.750	227.301	---	
19	11+290	CTH A	MANHOLE	1.5	RT	1	J	---	229.199	227.442	1.182 1.382	
20	11+240	CTH A	MANHOLE	1.5	RT	1	J	---	228.870	227.533	0.762 0.962	
20A	11+240	CTH A	INLET	7.0	LT	3	H-S	RT	228.743	227.594	0.847	
20B	11+240	CTH A	INLET	7.0	RT	3	H-S	LT	228.743	227.564	0.877	
21	11+140	CTH A	MANHOLE	1.5	RT	1	J	---	229.593	227.655	1.305 1.565	
21A	11+140	CTH A	INLET	7.0	LT	3	H	RT	229.491	227.716	1.473	
21B	11+140	CTH A	INLET	7.0	RT	3	H	LT	229.491	227.602	1.502	
22	11+400	CTH A	ENDWALL	9.7	RT	---	---	---	---	228.150	---	
22A	11+400	CTH A	INLET	7.0	RT	3	H-S	RT	229.154	228.170	0.682	
22B	11+400	CTH A	INLET	7.0	RT	3	H-S	LT	229.154	228.200	0.652	
23	11+440	CTH A	ENDWALL	10.6	RT	---	---	---	---	227.810	---	
24	11+445	CTH A	MANHOLE	1.5	RT	1	J	---	229.451	227.869	1.007 1.207	
25	11+500	CTH A	MANHOLE	1.5	RT	1	J	---	229.786	228.051	1.100 1.360	
25A	11+500	CTH A	INLET	7.0	LT	3	H	LT	229.681	228.112	1.267	
25B	11+500	CTH A	INLET	7.0	RT	3	H	RT	229.681	228.082	1.297	

← SEE ATTACHED SHEETS FOR STORM SEWER CHANGES.




Str. 24 Planned to be a Manhole
Str. did not exist on Plan / Profile sheets.

ORIGINAL DTD: 7/11/99
 PROJECT NO: 440278.00
 DATE REVISION: 1, 2, 3, 99, 100
 DATE: 7/11/99
 FILE: NAME
 SCALE: 1"=40'
 PLOT NAME: 440278.00
 GBD: 440278.00
 PLOT NO: 440278.00
 DATE: 7/11/99
 FILE: NAME
 SCALE: 1"=40'
 PLOT NAME: 440278.00

MANHOLES, INLETS, AND COVERS

STRUCTURE NUMBER	STATION	LOCATION	STRUCTURE	DISTANCE			COVER	GRATE LT/RT	ELEVATIONS			REMARKS
				LT/RT	TYPE	COVER			PAVEMENT	FLOWLINE	DEPTH	
26	11+585	CTH A	MANHOLE	1.5	RT	1	J	---	230.748	228.356	1.811	2.077
26A	11+589	CTH A	INLET	9.6	LT	3	H	LT	230.829	228.417	2.110	
26B	11+580	CTH A	INLET	19.0	RT	3	H	RT	230.642	228.417	1.923	
26C	11+581	CTH A	INLET	23.4	RT	1	C	---	230.470	228.448	1.643	
26D	11+567	CTH A	INLET	23.4	RT	1	C	---	230.650	228.478	1.793	
27	11+662	CTH A	MANHOLE	1.5	RT	1	J	---	231.659	229.057	2.027	2.227
27A	11+662	CTH A	INLET	7.0	RT	3	H	RT	231.964	230.276	1.386	0.911
27B	11+662	CTH A	INLET	7.0	RT	3	H	RT	231.467	230.276	0.889	
28	11+740	CTH A	MANHOLE	1.5	RT	1	J	---	232.455	230.124	1.766	1.956
28A	11+740	CTH A	INLET	7.0	RT	3	H	RT	232.759	230.738	1.723	1.237
28B	11+740	CTH A	INLET	7.0	RT	3	H	RT	232.263	230.734	1.227	
29	11+822	CTH A	MANHOLE	1.5	RT	1	J	---	233.050	231.038	1.417	1.509
29A	11+740	CTH A	INLET	7.0	LT	3	H	LT	233.334	231.404	1.628	1.558
29B	11+740	CTH A	INLET	7.0	RT	3	H	RT	232.838	231.404	1.132	1.407
30	11+920	CTH A	MANHOLE	1.5	RT	1	J	---	233.790	231.648	1.567	1.767
30A	11+920	CTH A	INLET	7.0	LT	3	H	LT	233.688	232.258	1.128	
30B	11+920	CTH A	INLET	7.0	RT	3	H	RT	233.688	232.258	1.128	
31	12+019	CTH A	MANHOLE	1.5	RT	1	J	---	234.710	232.258	1.077	2.077
31A	12+019	CTH A	INLET	7.0	LT	3	H	LT	234.608	232.867	1.439	
31B	12+019	CTH A	INLET	7.0	RT	3	H	RT	234.608	232.562	1.744	
32	12+090	CTH A	MANHOLE	1.5	RT	1	J	---	235.155	232.562	2.018	2.218
33	12+160	CTH A	MANHOLE	1.5	RT	1	J	---	235.163	232.867	1.721	1.921
33A	12+160	CTH A	INLET	7.0	LT	3	H	RT	234.990	233.020	1.668	
33B	12+160	CTH A	INLET	7.0	RT	3	H	LT	234.990	233.020	1.668	
34	12+215	CTH A	MANHOLE	1.5	RT	1	J	---	235.000	233.172	1.253	1.453
34A	12+215	CTH A	INLET	7.0	LT	3	D	---	234.810	233.020	1.640	
34B	12+215	CTH A	INLET	7.0	RT	3	H-S	RT	234.810	233.233	1.275	
35	12+290	CTH A	MANHOLE	1.5	RT	1	J	---	235.224	233.629	1.020	1.720
35A	12+300	CTH A	INLET	7.0	LT	3	H	LT	235.153	233.782	1.069	
35B	12+300	CTH A	INLET	7.0	RT	3	H	RT	235.153	233.782	1.069	
35C	12+289	CTH A	INLET	21.2	RT	3	H	RT	234.952	233.782	0.868	
35D	12+281	CTH A	INLET	24.6	RT	3	H	LT	234.952	233.843	0.807	MODIFIED INLET
36	12+721	CTH A	MANHOLE	1.5	RT	3	J	---	234.969	232.837	1.557	1.757
36A	12+726	CTH A	INLET	7.0	LT	3	H	RT	234.850	232.867	1.681	1.102
36B	12+728	CTH A	MANHOLE	9.5	LT	1	Salvage	---	233.950	232.898	0.902	MATCH TO EXISTING, 600mm
36C	12+717	CTH A	INLET	7.0	RT	3	H	LT	234.876	232.800	1.774	1.773
36D	12+716	CTH A	MANHOLE	9.5	RT	1	Salvage	---	234.450	232.787	1.513	MATCH TO EXISTING, 600mm
37	12+640	CTH A	MANHOLE	1.5	RT	1	J	---	235.210	233.050	1.505	1.785
38	12+540	CTH A	MANHOLE	1.5	RT	1	J	---	234.865	233.294	0.996	1.196
38A	12+540	CTH A	INLET	7.0	LT	3	H-S	LT	234.763	233.354	1.107	
38B	12+540	CTH A	INLET	7.0	RT	3	H-S	RT	234.763	233.324	1.137	
39	12+475	CTH A	MANHOLE	1.5	RT	1	J	---	235.060	233.446	1.039	1.239
40	12+411	CTH A	MANHOLE	1.5	RT	1	J	---	235.251	233.599	1.077	1.277
40A	12+414	CTH A	INLET	10.3	LT	3	H	RT	235.289	233.660	1.327	
40B	12+407	CTH A	INLET	12.0	LT	1	C	---	234.450	233.680	0.391	MODIFIED INLET
40C	12+430	CTH A	INLET	9.4	LT	3	H	RT	235.133	233.721	1.110	
40D	12+435	CTH A	ENDWALL	9.5	LT	---	---	---	234.405	---	---	ENDWALL, 300mm.
40E	12+409	CTH A	INLET	7.0	RT	3	H	LT	235.155	233.629	1.224	
41	12+820	CTH A	MANHOLE	1.5	RT	1	J	---	234.670	233.081	1.014	1.214
41A	12+820	CTH A	INLET	7.0	LT	3	H-S	LT	234.568	233.111	1.155	
41B	12+820	CTH A	INLET	7.0	RT	3	H-S	RT	234.568	233.111	1.155	
42	12+920	CTH A	MANHOLE	1.5	RT	1	J	---	235.048	233.385	1.000	1.200
42A	12+920	CTH A	INLET	7.0	LT	3	H	LT	234.946	233.416	1.220	
42B	12+920	CTH A	INLET	7.0	RT	3	H	RT	234.946	233.416	1.220	
43	13+020	CTH A	MANHOLE	1.5	RT	1	J	---	236.522	233.934	2.013	2.213
43A	13+020	CTH A	INLET	7.0	LT	3	H	LT	236.420	234.500	1.618	
43B	13+020	CTH A	INLET	7.0	RT	3	H	RT	236.420	234.500	1.618	
44	13+100	CTH A	MANHOLE	1.5	RT	1	J	---	237.867	235.134	2.150	2.350
44A	13+100	CTH A	INLET	7.0	LT	3	H	LT	237.765	236.200	1.263	
44B	13+100	CTH A	INLET	7.0	RT	3	H	RT	237.765	236.200	1.263	
45	13+200	CTH A	MANHOLE	1.5	RT	1	J	---	238.936	236.634	1.727	1.927
45A	13+200	CTH A	INLET	7.0	LT	3	H	LT	238.834	237.200	1.332	
45B	13+200	CTH A	INLET	7.0	RT	3	H	RT	238.834	237.200	1.332	
45C	13+199	CTH A	INLET	9.0	RT	1	C	---	239.250	237.500	1.371	
46	13+295	CTH A	MANHOLE	1.5	RT	3	J	---	239.033	237.110	1.348	1.548
46A	---	---	---	---	---	---	---	---	---	---	---	INLET REMOVED
46B	13+302	CTH A	INLET	13.5	RT	3	H-S	LT	238.813	237.100	1.331	
46C	13+308	CTH A	INLET	31.8	RT	1	C	---	239.100	237.200	1.431	
46D	13+320	CTH A	INLET	27.5	RT	1	C	---	238.750	237.350	1.021	
46E	13+306	CTH A	INLET	17.6	LT	1	H	RT	238.778	237.200	1.276	
47	13+282	CTH A	INLET	19.8	LT	1	H-S	RT	238.810	237.300	1.208	
47A	13+385	CTH A	MANHOLE	1.5	RT	1	J	---	238.598	237.218	0.805	1.005
47B	13+385	CTH A	INLET	5.0	LT	1	H	LT	238.708	237.300	1.106	
48	13+460	CTH A	MANHOLE	1.5	RT	1	J	---	238.498	237.353	0.570	MODIFIED MANHOLE
48A	13+430	CTH A	INLET	10.0	LT	1	H	RT	238.417	237.380	0.735	MODIFIED INLET
48B	13+460	CTH A	INLET	6.6	RT	1	H	LT	238.264	237.380	0.582	MODIFIED INLET
48C	13+460	CTH A	STUB OUT	7.6	RT	---	---	---	---	237.400	---	

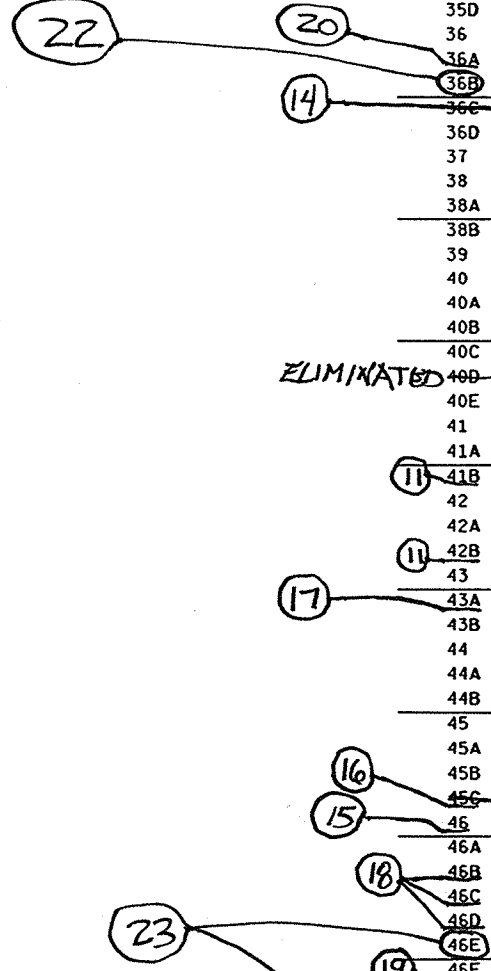

ELIMINATED

ORIGINATOR: J.D. DATE: 7/1/99
 REVISION: 440278.00 FILE NAME: PLOT NAME: SCALE:
 DATE REVISION: 5/1/00
 LEVELS: 01 - 1, 2, 3, 99, 100

GB2
 PEN TABLE = #plot721cser#mv80pp.tbl
 DATE OF PLOT = 07/15/99
 PLOT NO
 DESIGN FILE IS F:\440278.dgn\WISC.dgn

ORIGINATOR: DJD
 PROJECT NO: 440278-00
 REVISION: BY: DATE: 7/1/99
 FILE NAME: SCALE:
 LEVELS ON - 1, 2, 3, 48, 50, 51, 52, 53, 54, 55, 56, 57, 58, 59, 60, 61, 62.

MANHOLES, INLETS, AND COVERS

STRUCTURE NUMBER	STATION	LOCATION	STRUCTURE	DISTANCE		COVER	GRATE LT/RT	ELEVATIONS			REMARKS	
				LT/RT	TYPE			PAVEMENT	FLOWLINE	DEPTH		
26	11+585	CTH A	MANHOLE	1.5	RT	1	J	---	230.748	228.356	1.861	
26A	11+589	CTH A	INLET	9.6	LT	3	H	LT	230.829	228.417	1.957	
26B	11+580	CTH A	INLET	19.0	RT	3	H	RT	230.642	228.417	1.770	
26C	11+581	CTH A	INLET	23.4	RT	1	C	---	230.470	228.448	1.491	
26D	11+567	CTH A	INLET	23.4	RT	1	C	---	230.650	228.478	1.641	
27	11+662	CTH A	MANHOLE	1.5	RT	1	J	---	231.659	229.057	2.071	
27A	11+662	CTH A	INLET	7.0	LT	3	H	LT	231.964	230.276	1.233	
27B	11+662	CTH A	INLET	7.0	RT	3	H	RT	231.467	230.276	0.736	
28	11+740	CTH A	MANHOLE	1.5	RT	1	J	---	232.455	230.124	1.800	
28A	11+740	CTH A	INLET	7.0	LT	3	H	LT	232.759	230.734	1.570	
28B	11+740	CTH A	INLET	7.0	RT	3	H	RT	232.263	230.734	1.074	
29	11+822	CTH A	MANHOLE	1.5	RT	1	J	---	233.030	231.038	1.461	
29A	11+740	CTH A	INLET	7.0	LT	3	H	LT	233.334	231.404	1.475	
29B	11+740	CTH A	INLET	7.0	RT	3	H	RT	232.838	231.404	0.979	
30	11+920	CTH A	MANHOLE	1.5	RT	1	J	---	233.790	231.648	1.611	
30A	11+920	CTH A	INLET	7.0	LT	3	H	LT	233.688	232.258	0.975	
30B	11+920	CTH A	INLET	7.0	RT	3	H	RT	233.688	232.258	0.975	
31	12+019	CTH A	MANHOLE	1.5	RT	1	J	---	234.710	232.258	1.921	
31A	12+019	CTH A	INLET	7.0	LT	3	H	LT	234.608	232.867	1.286	
31B	12+019	CTH A	INLET	7.0	RT	3	H	RT	234.608	232.562	1.591	
32	12+090	CTH A	MANHOLE	1.5	RT	1	J	---	235.155	232.562	2.062	
33	12+160	CTH A	MANHOLE	1.5	RT	1	J	---	235.163	232.867	1.765	
33A	12+160	CTH A	INLET	7.0	LT	3	H	RT	234.990	233.020	1.515	
33B	12+160	CTH A	INLET	7.0	RT	3	H	LT	234.990	233.020	1.515	
34	12+215	CTH A	MANHOLE	1.5	RT	1	J	---	235.000	233.172	1.297	
34A	12+215	CTH A	INLET	7.0	LT	3	D	---	234.810	233.020	1.640	
34B	12+215	CTH A	INLET	7.0	RT	3	H-S	RT	234.810	233.233	1.122	
35	12+290	CTH A	MANHOLE	1.5	RT	1	J	---	235.224	233.629	1.064	
35A	12+300	CTH A	INLET	7.0	LT	3	H	LT	235.153	233.782	0.916	
35B	12+300	CTH A	INLET	7.0	RT	3	H	RT	235.153	233.782	0.916	
35C	12+289	CTH A	INLET	21.2	RT	3	H	RT	234.952	233.782	0.715	
35D	12+281	CTH A	INLET	24.6	RT	3	H	LT	234.952	233.843	0.654	Modified Inlet
36	12+721	CTH A	MANHOLE	1.5	RT	3	J	---	234.969	232.837	1.601	
36A	12+726	CTH A	INLET	7.0	LT	3	H	RT	234.850	232.867	1.528	
36B	12+728	CTH A	MANHOLE	9.5	LT	1	Solvo	RT	233.950	232.898	0.902	MATCH TO EXISTING, 600mm
36C	12+717	CTH A	INLET	7.0	RT	3	H	LT	234.876	232.800	1.621	
36D	12+716	CTH A	MANHOLE	9.5	RT	1	Solvo	LT	234.450	232.787	1.513	MATCH TO EXISTING, 600mm
37	12+640	CTH A	MANHOLE	1.5	RT	1	J	---	235.210	233.050	1.629	
38	12+540	CTH A	MANHOLE	1.5	RT	1	J	---	234.865	233.294	1.040	
38A	12+540	CTH A	INLET	7.0	LT	3	H-S	LT	234.763	233.354	0.954	
38B	12+540	CTH A	INLET	7.0	RT	3	H-S	RT	234.763	233.324	0.984	
39	12+475	CTH A	MANHOLE	1.5	RT	1	J	---	235.060	233.446	1.083	
40	12+411	CTH A	MANHOLE	1.5	RT	1	J	---	235.251	233.599	1.121	
40A	12+414	CTH A	INLET	10.3	LT	3	H	RT	235.289	233.660	1.174	
40B	12+407	CTH A	INLET	12.0	LT	1	C	---	234.450	233.680	0.239	Modified Inlet
40C	12+430	CTH A	INLET	9.4	LT	3	H	RT	235.133	233.721	0.957	
40D	12+435	CTH A	ENDWALL	9.5	LT	---	---	---	---	234.485	---	ENDWALL, 300mm
40E	12+409	CTH A	INLET	7.0	RT	3	H	LT	235.155	233.629	1.071	
41	12+820	CTH A	MANHOLE	1.5	RT	1	J	---	234.670	233.081	1.058	
41A	12+820	CTH A	INLET	7.0	LT	3	H-S	LT	234.568	233.111	1.002	
41B	12+820	CTH A	INLET	7.0	RT	3	H-S	RT	234.568	233.111	1.002	
42	12+920	CTH A	MANHOLE	1.5	RT	1	J	---	235.048	233.385	1.132	
42A	12+920	CTH A	INLET	7.0	LT	3	H	LT	234.946	233.416	1.075	
42B	12+920	CTH A	INLET	7.0	RT	3	H	RT	234.946	233.416	1.075	
43	13+020	CTH A	MANHOLE	1.5	RT	1	J	---	236.522	233.934	2.057	
43A	13+020	CTH A	INLET	7.0	LT	3	H	LT	236.420	234.500	1.465	
43B	13+020	CTH A	INLET	7.0	RT	3	H	RT	236.420	234.500	1.465	
44	13+100	CTH A	MANHOLE	1.5	RT	1	J	---	237.867	235.134	2.202	
44A	13+100	CTH A	INLET	7.0	LT	3	H	LT	237.765	236.200	1.110	
44B	13+100	CTH A	INLET	7.0	RT	3	H	RT	237.765	236.200	1.110	
45	13+200	CTH A	MANHOLE	1.5	RT	1	J	---	238.936	236.634	1.771	
45A	13+200	CTH A	INLET	7.0	LT	3	H	LT	238.834	237.200	1.179	
45B	13+200	CTH A	INLET	7.0	RT	3	H	RT	238.834	237.200	1.179	
45C	13+199	CTH A	INLET	9.0	RT	1	C	---	239.250	237.500	1.219	
46	13+295	CTH A	MANHOLE	1.5	RT	1	J	---	239.033	237.110	1.392	
46A	13+287	CTH A	INLET	11.6	LT	3	H-S	RT	238.864	237.180	1.229	
46B	13+302	CTH A	INLET	13.5	RT	3	H-S	LT	238.813	237.180	1.178	
46C	13+308	CTH A	INLET	31.8	RT	1	C	---	239.100	237.290	1.279	
46D	13+320	CTH A	INLET	27.5	RT	1	C	---	238.750	237.350	0.869	
47	13+330	CTH A	MANHOLE	1.5	RT	1	J	---	238.928	237.285	1.112	
47A	13+330	CTH A	INLET	7.0	LT	1	H-S	RT	238.813	237.330	1.028	
47B	13+336	CTH A	STUB END	8.0	LT	---	---	---	---	238.750	---	
47C	13+330	CTH A	INLET	7.0	RT	1	H-S	LT	238.813	237.330	1.028	
47D	13+336	CTH A	STUB END	8.0	RT	---	---	---	---	238.550	---	

MISCELLANEOUS QUANTITIES

HWY: C.T.H. "A"

COUNTY: WINNEBAGO

STATE PROJECT NO: 4994-00-78, 4994-00-82

SHEET NO: 36 M

ORIGINATOR: DJD
 PROJECT NO.: 440278.00
 REVISED BY: [blank]
 DATE REVISED: [blank]
 LEVELS ON: 1, 2, 3, 48, 50, 51, 52, 53, 54, 55, 56, 57, 58, 59, 60, 61, 62.
 PLOT NAME: [blank]
 SCALE: [blank]
 DATE: 7/1/99
 FILE NAME: [blank]

GB2
 PEN TABLE = #plot72i\user\mv80pp.tbl
 DATE OF PLOT = 07/15/99
 PLOT NO. [blank]
 DESIGN FILE IS F:\440278\dgn\MISC.dgn

EROSION CONTROL

STATION-STATION	LOCATION	SILT FENCE, SILTY SOILS			EROSION MAT, CLASS I TYPE "A"		SOD m2
		DELIVERED m	INSTALLED m	MAINTAINED m	DELIVERED m2	INSTALLED m2	
PROJ. 4994-00-78							
10+368	C.T.H. "A" LT.	10	10	5			
10+383	C.T.H. "A" LT.	6	6	3			
10+383	C.T.H. "A" RT.	4	4	2			
10+400-10+405	C.T.H. "A" RT.	8	8	4			
11+260-11+318	C.T.H. "A" RT.	60	60	30			
11+265-11+453	C.T.H. "A" LT.	200	200	100			
11+460	C.T.H. "A" LT.	10	10	5			
INLETS	C.T.H. "A"	70	70	35			
10+300-10+365	C.T.H. "A" RT.				210	210	
10+513	C.T.H. "A" LT.				21	21	
10+602	C.T.H. "A" LT.				18	18	
10+648	C.T.H. "A" LT.				15	15	
10+983	C.T.H. "A" LT.				15	15	
3+020-3+025	MILLER LN. LT.				15	15	
4+020-4+025	RIDGE LN. LT./RT.				30	30	
5+023-5+028	KEENVILLE AVE LT./RT.				30	30	
7+024-7+034	SNELL ROAD RT.				30	30	
SUBTOTAL		368	368	184	384	384	
PROJ. 4994-00-82	CATEGORY 0010						
INLETS	C.T.H. "A"	40	40	20			
6+970	SNELL RD. LT.						15
7+024-7+034	SNELL RD. LT./RT.				60	60	
11+580-12+040	C.T.H. "A" LT.				1,380	1,380	
12+728-13+180	C.T.H. "A" LT.				1,356	1,356	
13+330-13+370	C.T.H. "A" LT./RT.				240	240	
SUBTOTAL		40	40	20	3,036	3,036	15
TOTAL		408	408	204	3,420	3,420	15

MEDIUM RANDOM RIPRAP

STATION-STATION	LOCATION	QUANTITY m3
PROJ. 4994-00-78		
10+368-10+402	C.T.H. "A" LT./RT.	50
11+293-11+303	C.T.H. "A" RT.	20
11+427-11+455	C.T.H. "A" LT./RT.	40
TOTAL		110

BREAKER RUN STONE

STATION-STATION	LOCATION	QUANTITY Mg
PROJ. 4994-00-78		
10+760-10+880	C.T.H. "A"	1,293
PROJ. 4994-00-82	CATEGORY 0010	
11+600-13+000	C.T.H. "A"	15,082
TOTAL		16,375

CONSTRUCTION STAKING, CONCRETE PAVEMENT

STATION-STATION	LOCATION	QUANTITY m
PROJ. 4994-00-78		
10+000-11+575	C.T.H. "A"	1,575
PROJ. 4994-00-82	CATEGORY 0010	
11+575-13+331	C.T.H. "A"	1,756
PROJ. 4994-00-82	CATEGORY 0020	
19-932-20+000	C.T.H. "AA"	68
TOTAL		3,399

CONSTRUCTION STAKING, CULVERT PIPES

STATION-STATION	LOCATION	QUANTITY EACH
PROJ. 4994-00-78		
10+380	C.T.H. "A"	4
11+300	C.T.H. "A"	2
11+440	C.T.H. "A"	3
TOTAL		9

H.E.S. CONCRETE, 200 mm

STA	LOCATION	QUANTITY m2
PROJ. 4994-00-78		
10+370	C.T.H. "A" RT.	66
10+464	C.T.H. "A" RT.	66
10+658	C.T.H. "A" LT.	66
10+776	C.T.H. "A" LT.	66
10+934	C.T.H. "A" LT.	66
10+993	C.T.H. "A" LT.	66
11+575	C.T.H. "A" LT./RT.	132
SUBTOTAL		528
PROJ. 4994-00-82	CATEGORY 0010	
12+331	C.T.H. "A" RT.	66
13+300	C.T.H. "A" LT./RT.	132
SUBTOTAL		198
TOTAL		726

CONSTRUCTION STAKING, CURB AND GUTTER

STATION-STATION	LOCATION	QUANTITY m
PROJ. 4994-00-78		
10+000-11+575	C.T.H. "A"	3,184
PROJ. 4994-00-82	CATEGORY 0010	
11+575-13+410	C.T.H. "A"	3,586
PROJ. 4994-00-82	CATEGORY 0020	
19-932-20+000	C.T.H. "AA"	129
TOTAL		6,899

CONSTRUCTION STAKING: INLETS, CATCH BASINS, MANHOLES, AND STORM SEWER PIPES

STATION-STATION	LOCATION	QUANTITY EACH
PROJ. 4994-00-78		
10+000-11+575	C.T.H. "A"	73
PROJ. 4994-00-82	CATEGORY 0010	
11+575-13+410	C.T.H. "A"	71
TOTAL		144

MISCELLANEOUS QUANTITIES

HWY: C.T.H. "A"

COUNTY: WINNEBAGO

STATE PROJECT NO: 4994-00-78, 4994-00-82

SHEET NO: 34 M

GB2
 PEN TABLE = 4plot724laser-fmv80pp.tbl
 DATE OF PLOT = 07/15/99
 PLOT NA
 DESIGN FILE IS F:\440278\dgn\MISC.dgn

50.51,52,53,54,55,56,57,58,59,60,61,62.
 50.51,52,53,34,35,36,37,38,39,40,41,42,43,44,45,46,47,48.
 19.18,19,20,21,22,23,24,25,26,27,28,29,30,31,32,33,34,35,36,37,38,39,40,41,42,43,44,45,46,47,48.
 DATE: 7/1/99
 FILE NAME:
 PLOT NAME:
 SCALE:

PAVEMENT MARKING, PAINT

STATION-STATION	LOCATION	100 mm SOLID YELLOW CENTERLINE m	100 mm SOLID WHITE EDGE LINE m	100 mm DASHED WHITE LANE LINE m	450 mm SOLID WHITE STOPLINE m	RAILROAD CROSSING EACH
PROJ. 4994-00-78						
10+000-10+359	C.T.H. "A"	718	718	180		
10+359-10+383	C.T.H. "A"	48	24	12		
10+383-10+457	C.T.H. "A"	148	148	37		
10+457-10+478	C.T.H. "A"	42		11		
10+478-10+486	C.T.H. "A"	16	8	4		
10+486-10+633	C.T.H. "A"	294	294	74		
10+633-10+656	C.T.H. "A"	46	23	12		
10+656-10+716	C.T.H. "A"	120	120	30		
10+716-10+739	C.T.H. "A"	46	23	12		
10+739-10+762	C.T.H. "A"	46	46	12		
10+762-10+792	C.T.H. "A"	60	30	15		
10+792-11+006	C.T.H. "A"	428	428	107		
11+006-11+036	C.T.H. "A"	60	30	15		
11+036-11+555	C.T.H. "A"	1,038	1,038	260		
SUBTOTALS		3,110	2,930	781		
PROJ. 4994-00-82 CATEGORY 0010						
11+595-12+264	C.T.H. "A"	1,338	1,338	335		
12+264-12+299	C.T.H. "A"	70	35	18		
12+299-12+409	C.T.H. "A"	220	220	55		
12+409-12+438	C.T.H. "A"	58		15		
12+438-13+282	C.T.H. "A"	1,688	1,688	422		
13+323-13+410	C.T.H. "A"	174	174			
8+965-9+025	BUTLER AVE.	88			18	
9+962-10+10+038	C.T.H. "Y"	118			24	
6+970-7+030	SNELL RD.	88			18	
SUBTOTALS		3,842	3,455	845	60	
PROJ. 4994-00-82 CATEGORY 0020						
19+850-20+090	C.T.H. "AA"	480				
19+911	C.T.H. "AA"					1
20+055	C.T.H. "AA"					1
29+981-29+991	NICOLET AVE.	20				
SUBTOTALS		500	0	0	0	2
TOTALS		7,452	6,385	1,626	60	2

100 mm white edgeline eliminated in the curb + gutter sections.

CONSTRUCTION STAKING, SUBGRADE

STATION-STATION	LOCATION	QUANTITY m
PROJ. 4994-00-78		
10+000-11+575	C.T.H. "A"	1,575
1+00-1+020	MacARTHUR LN.	20
2+000-2+040	SHADOW LN.	40
3+000-3+020	MILLER LN.	20
4+000-4+030	RIDGE LN.	30
5+000-5+030	KEENVILLE AVE.	30
6+000-6+020	DRIFTWOOD LN.	20
6+970-7+030	SNELL RD.	60
SUBTOTAL		1,795
PROJ. 4994-00-82 CATEGORY 0010		
11+575-13+410	C.T.H. "A"	1,835
8+000-8+040	PICKETT AVE.	40
8+965-9+025	BUTLER AVE.	60
9+062.5-10+037.5	C.T.H. "Y"	75
SUBTOTAL		2,010
PROJ. 4994-00-82 CATEGORY 0020		
19+932-20+000	C.T.H. "AA"	68
SUBTOTAL		68
TOTAL		3,873

PRELIMINARY CONSTRUCTION STAKING

STATION-STATION	LOCATION	QUANTITY m
PROJ. 4994-00-78		
10+000-11+575	C.T.H. "A"	1,575
1+00-1+020	MacARTHUR LN.	20
2+000-2+040	SHADOW LN.	40
3+000-3+020	MILLER LN.	20
4+000-4+030	RIDGE LN.	30
5+000-5+030	KEENVILLE AVE.	30
6+000-6+020	DRIFTWOOD LN.	20
6+970-7+030	SNELL RD.	60
SUBTOTAL		1,795
PROJ. 4994-00-82 CATEGORY 0010		
11+575-13+410	C.T.H. "A"	1,835
8+000-8+040	PICKETT AVE.	40
8+965-9+025	BUTLER AVE.	60
9+062.5-10+037.5	C.T.H. "Y"	75
SUBTOTAL		2,010
PROJ. 4994-00-82 CATEGORY 0020		
19+932-20+000	C.T.H. "AA"	68
SUBTOTAL		68
TOTAL		3,873

ORIGINAL FOR: DJG
 REVISIONS:
 REVISION BY: 440278.00
 DATE: 7/1/99
 FILE NAME:
 PLOT NAME:
 SCALE:
 LEVELS ON = 1, 2, 3, 4, 5, 6, 7, 8, 9, 10, 11, 12, 13, 14, 15, 16, 17, 18, 19, 20, 21, 22, 23, 24, 25, 26, 27, 28, 29, 30, 31, 32, 33, 34, 35, 36, 37, 38, 39, 40, 41, 42, 43, 44, 45, 46, 47, 48.

GB2
 PEN TABLE = #plot723\user\mv80pp.tbl
 DATE OF PLOT = 07/15/99
 PLOT NO
 DESIGN FILE IS I:\440278\dpn\WISC.dgn

ORIGINATOR: DJD
 PROJECT NO. 440278-00
 REVISIONS BY:
 DATE REVISIONS:
 LEVELS ON - 1, 2, 3, 48, 50, 51, 52, 53, 54, 55, 56, 57, 58, 59, 60, 61, 62

TEMPORARY PAVEMENT MARKING, REMOVABLE TAPE, SOLID YELLOW, 100 mm

STATION-STATION	LOCATION	QUANTITY m	REMARKS
PROJ. 4994-00-82	CATEGORY 0020		
19+850-20+090	C.T.H. "AA"	960	PHASES 1 AND 2

REMOVING PAVEMENT MARKINGS

STATION-STATION	LOCATION	QUANTITY m	REMARKS
PROJ. 4994-00-82	CATEGORY 0020		
19+850-19+915	C.T.H. "AA"	130	PHASE 1
20+017-20+090	C.T.H. "AA"	146	PHASE 1
19+850-20+090	C.T.H. "AA"	480	PHASE 2
TOTAL		756	

TRAFFIC CONTROL DRUMS AND WARNING LIGHTS, AND SIGNS

STATION	LOCATION	DRUMS		WARNING LIGHTS TYPE "C"		BARRICADES TYPE III		WARNING LIGHTS, TYPE "A" BARRICADES SIGN		SIGNS		SIGN NO.	REMARKS	FLEXIBLE TUBULAR MARKERS (POSTS AND BASES) EACH
		EACH	DAYS	EACH	DAYS	EACH	DAYS	EACH	DAYS	EACH	DAYS			
PROJ. 4994-00-78														
9+450	C.T.H. "A"							1	138	1	138	W20-3	ROAD CLOSED AHEAD	
9+600	C.T.H. "A"							1	138	1	138	W20-3	ROAD CLOSED 1000'	
9+850	C.T.H. "A"							1	138	2	276	W20-3, G20-2	ROAD CLOSED 500', END ROAD WORK	
10+000	C.T.H. "A"			3	414	6	828			1	138	R11-4	ROAD CLOSED TO THRU TRAFFIC	
1+020	MACARTHUR LN.			1	138	2	276			1	138	R11-2	ROAD CLOSED	
1+170	MACARTHUR LN.							1	138	2	276	W20-3, G20-2	ROAD CLOSED AHEAD, END ROAD WORK	
2+040	SHADOW LN.			1	138	2	276			1	138	R11-2	ROAD CLOSED	
2+190	SHADOW LN.							1	138	2	276	W20-3, G20-2	ROAD CLOSED AHEAD, END ROAD WORK	
3+020	MILLER LN.			1	138	2	276			1	138	R11-2	ROAD CLOSED	
3+170	MILLER LN.							1	138	2	276	W20-3, G20-2	ROAD CLOSED AHEAD, END ROAD WORK	
4+030	RIDGE LN.			1	138	2	276			1	138	R11-2	ROAD CLOSED	
4+180	RIDGE LN.							1	138	2	276	W20-3, G20-2	ROAD CLOSED AHEAD, END ROAD WORK	
5+030	KEENVILLE AVE.			1	138	2	276			1	138	R11-2	ROAD CLOSED	
5+180	KEENVILLE AVE.							1	138	2	276	W20-3, G20-2	ROAD CLOSED AHEAD, END ROAD WORK	
6+020	DRIFTWOOD LN.			1	138	2	276			1	138	R11-2	ROAD CLOSED	
6+170	DRIFTWOOD LN.							1	138	2	276	W20-3, G20-2	ROAD CLOSED AHEAD, END ROAD WORK	
6+820	SNELL RD.							1	138	2	276	W20-1, G20-2	ROAD WORK AHEAD, END ROAD WORK	
10+355	C.T.H. "A"									1	90	R5-1	DO NOT ENTER	
10+367	C.T.H. "A"									2	180	R3-2, R6-2R	NO LEFT TURN SYMBOL, ONE WAY	
10+452	C.T.H. "A"									1	90	R5-1	DO NOT ENTER	
10+477	C.T.H. "A"									2	180	R3-2, R6-2R	NO LEFT TURN SYMBOL, ONE WAY	
10+630	C.T.H. "A"									1	90	R5-1	DO NOT ENTER	
10+645	C.T.H. "A"									2	180	R3-2, R6-2R	NO LEFT TURN SYMBOL, ONE WAY	
10+714	C.T.H. "A"									1	90	R5-1	DO NOT ENTER	
10+725	C.T.H. "A"									2	180	R3-2, R6-2R	NO LEFT TURN SYMBOL, ONE WAY	
10+760	C.T.H. "A"									1	90	R5-1	DO NOT ENTER	
10+767	C.T.H. "A"									2	180	R3-2, R6-2R	NO LEFT TURN SYMBOL, ONE WAY	
11+004	C.T.H. "A"									1	90	R5-1	DO NOT ENTER	
11+015	C.T.H. "A"									2	180	R3-2, R6-2R	NO LEFT TURN SYMBOL, ONE WAY	
11+477	C.T.H. "A"									1	90	R5-9	WRONG WAY	
11+552	C.T.H. "A"									1	90	R5-1	DO NOT ENTER	
11+560	C.T.H. "A"									1	138	R11-4	ROAD CLOSED TO THRU TRAFFIC	
11+563	C.T.H. "A"									2	180	R6-2L, R3-2	NO LEFT TURN SYMBOL, ONE WAY	
10+000-11+575	C.T.H. "A"	106	14,628										SPACING = 15 METERS	
SUBTOTALS			14,628	1,518	3036	1380	5,568							

MISCELLANEOUS QUANTITIES

HWY: C.T.H. "A"

COUNTY: WINNEBAGO

STATE PROJECT NO: 4994-00-78, 4994-00-82

SHEET NO: 31 M

GR7
 PLOT NAME: 4994-00-82
 DATE OF PLOT: 4/7/00
 PLOT NO:
 DESIGN FILE NO: 1, 2, 3, 99, 100
 ORIGINATOR: DJD
 PROJECT NO: 440278.00
 REVISION BY:
 DATE REVISION:
 PLOT NAME:
 SCALE:
 DATE: 7/1/99

SAWING EXISTING PAVEMENT

STATION	LOCATION	QUANTITY m
PROJ. 4994-00-82		
9+957	C.T.H. "Y"	7.2
10+035	C.T.H. "A"	7.2
13+580	C.T.H. "A"	7.2
TOTAL		21.6

PAVEMENT REMOVAL

STATION-STATION	LOCATION	QUANTITY m2
PROJ. 4994-00-82		
13+410-13+560	C.T.H. "A"	1,080

CRUSHED AGGREGATE BASE COURSE (150 mm)

STATION-STATION	LOCATION	CRUSHED AGGREGATE BASE COURSE	
		MAINLINE Mg	WATER KL
PROJ. 4994-00-82			
13+135-13+213	C.T.H. "A" WIDENING	80	4
13+213-13+300	C.T.H. "A" WIDENING	179	8
13+300-13+380	C.T.H. "A" WIDENING	536	23
13+380-13+500	C.T.H. "A" WIDENING	674	29
13+500-13+580	C.T.H. "A" WIDENING	181	8
13+460-13+580	C.T.H. "A" SHOULDERS	174	6
TOTALS		1,824	78

TOPSOIL, MULCHING, FERTILIZING, SEEDING, AND SODDING

STATION-STATION	LOCATION	TOPSOIL	MULCH	FERTILIZER	SEEDING
		m2	m2	TYPE "B" kg	NO 40 kg
13+410-13+580	C.T.H. "A"	1,900	1,900	67	19
9+957-9+962.5	C.T.H. "Y"	100	100	4	1
TOTALS		2,000	2,000	71	20

PRELIMINARY CONSTRUCTION STAKING

STATION	LOCATION	QUANTITY m
PROJ. 4994-00-82		
13+410-13+580	C.T.H. "A"	170.0
9+957-9+962.5	C.T.H. "Y"	5.5
TOTAL		175.5

CONSTRUCTION STAKING, SUBGRADE

STATION	LOCATION	QUANTITY m
PROJ. 4994-00-82		
13+410-13+580	C.T.H. "A"	170.0
9+957-9+962.5	C.T.H. "Y"	5.5
TOTAL		175.5

CONSTRUCTION STAKING, CONCRETE PAVEMENT

STATION	LOCATION	QUANTITY m
PROJ. 4994-00-82		
13+331-13+460	C.T.H. "A"	129

CONSTRUCTION STAKING, CONCRETE CURB AND GUTTER

STATION	LOCATION	QUANTITY m
PROJ. 4994-00-82		
13+410-13+460	C.T.H. "A"	50

SODDING

STATION	LOCATION	QUANTITY m2
PROJ. 4994-00-82		
13+460 RT.	C.T.H. "A"	15

CONCRETE PAVEMENT, 200 mm

STATION-STATION	LOCATION	QUANTITY m2
PROJ. 4994-00-82		
13+135-13+460	C.T.H. "A"	2,876
9+965-9+985	C.T.H. "Y"	388
TOTALS		3,264

CONCRETE CURB AND GUTTER, 450 mm TYPE 'A'

STATION-STATION	LOCATION	QUANTITY m
PROJ. 4994-00-82		
13+168-13+275	C.T.H. "A"	213.8
13+325-13+423	C.T.H. "A"	196.2
TOTAL		410.0

CONCRETE CURB AND GUTTER, 750 mm TYPE 'A'

STATION-STATION	LOCATION	QUANTITY m
PROJ. 4994-00-82		
13+331-13+460	C.T.H. "A"	258

CONCRETE CORRUGATED MEDIAN

STATION-STATION	LOCATION	QUANTITY m2
13+151-13+169	CDM A	30
13+422-13+443	CTA A	42

CULVERT PIPE, 450 MM

STATION-STATION	LOCATION	QUANTITY m	ENDWALLS EA	INLET ELEV.	DISCHARGE ELEV.
PROJ. 4994-00-82					
13+580	C.T.H. "A"	14	2	237.457	236.992

MISCELLANEOUS QUANTITIES

HWY: C.T.H. "A"

COUNTY: WINNEBAGO

STATE PROJECT NO: 4994-00-78, 4994-00-82

SHEET NO: 3.K



SIGNS, TYPE II, REFLECTIVE AND WOOD POSTS*

SIGN CODE	STATION	LOCATION	SIGN SIZE	SIGN	WOOD POST	SIGN MESSAGE
			mm	m2	EACH	
R4-7	13+170 LT.	C.T.H. "A"	600x750	0.45	1	KEEP RIGHT SYMBOL
R4-7	13+273 LT.	C.T.H. "A"	600x750	0.45	1	KEEP RIGHT SYMBOL
R4-7	13+326 LT.	C.T.H. "A"	600x750	0.45	1	KEEP RIGHT SYMBOL
R4-7	13+421 LT.	C.T.H. "A"	600x750	0.45	1	KEEP RIGHT SYMBOL

*FOR INFORMATION ONLY, COUNTY WILL INSTALL

ASPHALTIC CONCRETE PAVEMENT, TYPE "MV",
ASPHALTIC MATERIAL FOR PLANT MIXES, AND TACK COAT

STATION-STATION	LOCATION	ASPHALTIC CONCRETE PAVEMENT	ASPHALTIC MATERIAL FOR PLANT MIXES	ASPHALTIC MATERIAL FOR TACK COAT
		TYPE "MV" Mq	5.6% Mq	L
PROJ. 4994-00-82				
13+169-13+274	C.T.H. "A" ISLAND	19	1	18
13+326-13+422	C.T.H. "A" ISLAND	31	2	30
13+460-13+580	C.T.H. "A"	192	11	148
9+957-9+965	C.T.H. "Y"	16	1	20
10+010-10+035	C.T.H. "Y"	48	3	62
TOTALS		306	18	278

EROSION CONTROL

STATION-STATION	LOCATION	EROSION MAT, CLASS I TYPE "A"	
		DELIVERED m2	INSTALLED m2
13+460 - 13+540	C.T.H. "A"	192	192

PULL BOXES, 600 mm X 900 mm

STATION	LOCATION	QUANTITY EA
PROJ. 4994-00-82		
13+273	C.T.H. "A"	1
13+327	C.T.H. "A"	1
		2

NON-METALLIC CONDUIT, SCHEDULE 40, 75 mm

STATION	LOCATION	QUANTITY m
PROJ. 4994-00-82		
9+975	ACROSS C.T.H. "Y"	27
13+273	ACROSS C.T.H. "A"	23
13+328	ACROSS C.T.H. "A"	26
TOTAL		76

PAVEMENT MARKING, PAINT

STATION-STATION	LOCATION	100 mm SOLID YELLOW CENTERLINE	100 mm SOLID WHITE EDGELINE	100 mm DASHED WHITE LANE LINE	450 mm SOLID WHITE STOPLINE	200 mm SOLID WHITE CHANNELIZING	ARROW, TYPE 2 WHITE	WORDS WHITE
		m	m	m	m	m	EA	EA
PROJ. 4994-00-82								
13+135-13+214	C.T.H. "A"	158	158	40				
13+214-13+274	C.T.H. "A"	120	120	30				
13+274-13+285	C.T.H. "A"		11	3		60	2	2
13+318-13+326	C.T.H. "A"		8	2		8	1	
13+326-13+356	C.T.H. "A"	60	60	16		60	1	2
13+356-13+378	C.T.H. "A"	44	44	12		22	1	1
13+378-13+460	C.T.H. "A"	164	164	42				
13+460-13+580	C.T.H. "A"	240	240					
9+957-10+035	C.T.H. "Y"	76		6	24			
TOTALS		862	805	151	24	150	5	5

INCREMENTAL CUMULATIVE
END AREA CUT FILL FACTORS CUT FILL VOLUMES CUT FILL MASS CUT FILL HAUL
(m2) (m2) (m3) (m3) (m3)

STATION	END AREA CUT (m2)	END AREA FILL (m2)	FACTORS CUT (m3)	FACTORS FILL (m3)	VOLUMES CUT (m3)	VOLUMES FILL (m3)	MASS HAUL
PROJECT 4994-00-82							
13+140	9.1	0.1	1.0	1.3	182	2	180
13+160	11.2	0.0	1.0	1.3	204	1	383
13+180	11.8	0.0	1.0	1.3	230	0	613
13+200	12.0	0.0	1.0	1.3	237	0	850
13+220	11.8	0.0	1.0	1.3	238	0	1,088
13+240	11.9	0.0	1.0	1.3	237	0	1,325
13+260	11.8	0.0	1.0	1.3	238	0	1,563
13+280	13.4	0.0	1.0	1.3	253	0	1,816
13+300	19.9	0.0	1.0	1.3	333	0	2,149
13+320	14.3	0.2	1.0	1.3	342	2	2,489
13+340	16.1	0.1	1.0	1.3	304	4	2,789
13+360	18.5	0.2	1.0	1.3	346	3	3,132
13+380	18.6	0.2	1.0	1.3	371	3	3,500
13+400	17.7	0.2	1.0	1.3	363	3	3,860
13+420	17.6	0.2	1.0	1.3	353	3	4,210
13+440	17.9	0.1	1.0	1.3	355	2	4,563
13+460	17.3	0.0	1.0	1.3	352	1	4,914
13+480	24.2	0.0	1.0	1.3	415	0	5,329
13+500	23.1	0.0	1.0	1.3	472	0	5,801
13+520	19.2	0.0	1.0	1.3	422	0	6,223
13+540	14.0	0.0	1.0	1.3	331	0	6,554
13+560	9.1	0.0	1.0	1.3	230	0	6,784
13+570	7.1	0.2	1.0	1.3	81	1	6,864
13+580	5.1	0.6	1.0	1.3	61	4	6,921
13+600	0.0	0.0	1.0	1.3	51	6	6,966
9+950	5.3	1.6	1.0	1.3	27	8	6,985
9+960	7.2	0.0	1.0	1.3	62	8	7,039
9+980	12.8	0.0	1.0	1.3	199	0	7,238
10+012	11.9	0.0	1.0	1.3	395	0	7,633
10+020	8.8	0.0	1.0	1.3	83	0	7,716
10+035	7.3	0.2	1.0	1.3	121	1	7,836


ORIGINATOR: D:\J... PROJECT NO. 440276.00 DATE: 7/1/99 FILE NAME: ... PLOT NAME: ... SCALE: ...
 DATE REVISION: ...
 LEVELS ON - 1, 2, 3, 61, 62.
 DESIGN FILE IS: I:\440276\dgn\misc.dgn

PEN TABLE = #plot121laser.dwg
 DATE OF PLOT = 08/25/98
 PLOT NA
 DESIGN FILE IS L:\440278\DCN\rwtitle.dgn

FILE NAME:
 SCALE:
 DATE:
 PLOT NAME:
 ORIGINATOR:
 PROJECT NO:

CONVENTIONAL SYMBOLS AND ABBREVIATIONS

- STATE LINE
- COUNTY LINE
- TOWNSHIP & RANGE LINES
- QUARTER LINE
- SIXTEENTH LINE
- SECTION LINE
- NEW REFERENCE LINE
- NEW R/W LINE
- EXISTING R/W LINE
- PROPERTY LINE
- CORPORATE LIMITS
- NO ACCESS (BY ACQUISITION)
- ACCESS (BY PREVIOUS ACQUISITION)
- NO ACCESS (BY STATUTORY AUTHORITY)
- LIMITED EASEMENT
- FENCE
- BEAM GUARD
- SECTION CORNER
- CULVERT (BOX, PIPE OR CATTLE)
- LOT & TIE
- SLOPE INTERCEPTS
- UNDERGROUND UTILITIES
- IRON PIN/PIPE
- POWER POLE NON COMP.
- TELEPHONE POLE NON COMP.
- TELEPHONE PEDESTAL NON COMP.
- POWER POLE COMP.
- TELEPHONE POLE COMP.
- TELEPHONE PEDESTAL COMP.
- MONUMENTED R/W POINT

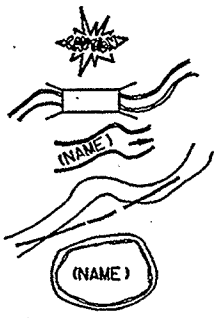


- A.P. ACCESS POINT
- AC. ACRES
- A.H. AHEAD
- ALUM. ALUMINUM
- ET.AL. AND OTHERS
- BK. BACK
- BIT. BITUMINOUS
- C.M. CABLE MARKER
- € CENTERLINE
- C.T.H. COUNTY TRUNK HIGHWAY
- C.S.M. CERTIFIED SURVEY MAP
- CONC. CONCRETE
- COR. CORNER
- CULV. CULVERT
- d/b/a DOING BUSINESS AS
- E ELECTRIC
- FDN. FOUNDATION
- G. GARAGE
- G.M. GAS MARKER
- G.P. GAS PUMPS
- H. HOUSE
- ha HECTARES
- I.P. IRON PIPE
- L.C. LAND CONTRACT
- LT. LEFT
- L LENGTH OF CURVE
- L.C. LONG CHORD

- L.C.B. LONG CHORD BEARING
- M.H. MANHOLE
- m METERS
- MON. MONUMENT
- O.L. OUTLOT
- P. PAGE
- P.K. PARKER-KALON
- P.L.E. PERMANENT LIMITED EASEMENT
- P.C. POINT OF CURVATURE
- P.I. POINT OF INTERSECTION
- P.T. POINT OF TANGENCY
- P.L. PROPERTY LINE
- R. RADIUS
- R.R. RAILROAD
- R REFERENCE LINE
- R.D.E. RESTRICTED DEVELOPMENT EASEMENT
- RT. RIGHT
- R/W RIGHT OF WAY
- SEC. SECTION
- S. SHED
- S.T.H. STATE TRUNK HIGHWAY
- STA. STATION
- T TANGENT LENGTH OF CURVE
- TAV. TAVERN
- T.L.E. TEMPORARY LIMITED EASEMENT
- X EAST COORDINATE (GRID)
- Y NORTH COORDINATE (GRID)


R/W PROJECT NUMBER 4994-00-00	SHEET NUMBER 4.1	TOTAL SHEETS 8
FEDERAL PROJECT NUMBER		
PLAT OF RIGHT OF WAY REQUIRED FOR C.T.H. "AA" - C.T.H. "Y"		
C.T.H. "A"	WINNEBAGO COUNTY	

BEGIN RELOCATION ORDER
 STA. 10+095.000
 X = 727 570 (± 30 m)
 Y = 229 355 (± 30 m)
 LOCATED 1480.767 m (4,858.15') SOUTH AND 395.841 m (1,298.69') EAST OF THE NORTH ONE-QUARTER CORNER OF SECTION 1, TOWNSHIP 18 NORTH, RANGE 16 EAST.

END RELOCATION ORDER
 STA. 13+400.000
 LOCATED 90.480 m (296.85') NORTH AND 206.348 m (676.99") EAST OF THE NORTHWEST CORNER OF SECTION 31, TOWNSHIP 19 NORTH, RANGE 17 EAST.

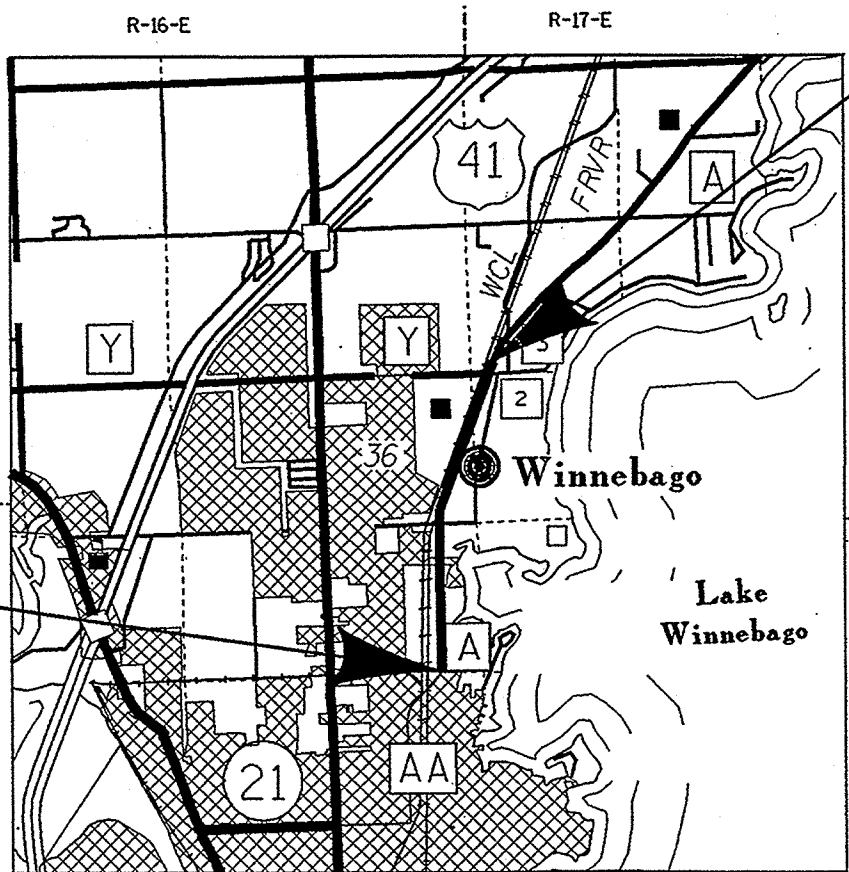

NOTES
 RIGHT OF WAY BOUNDARIES ARE DEFINED WITH COURSES OF THE PERIMETER OF THE HIGHWAY LANDS REFERENCED TO THE U.S. PUBLIC LAND SURVEY OR OTHER SURVEYS OF PUBLIC RECORD.

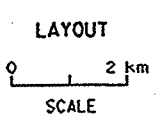

TOTAL NET LENGTH OF REFERENCE LINE = 3.305 km (2.054 Miles)

PREPARED BY
AVRES ASSOCIATES Engineers/Architects
 Scientists/Surveyors
 916 Willard Drive Suite 200
 Green Bay, Wisconsin 54304

JEFFREY KIP
 8-1878
 GREEN BAY
 WISCONSIN
 LAND SURVEYOR

DATE: AUG. 4, 1998

REVISION DATE

APPROVED FOR
 WINNEBAGO COUNTY
 AUG. 24, 1998
 DATE COUNTY HIGHWAY COMMISSIONER

SCHEDULE OF LANDS & INTERESTS REQUIRED

AREAS SHOWN IN THE TOTAL ACRES COLUMN MAY BE APPROXIMATE AND ARE DERIVED FROM TAX ROLLS OR OTHER AVAILABLE SOURCES AND MAY NOT INCLUDE LANDS OF THE OWNER WHICH ARE NOT CONTIGUOUS TO THE AREA TO BE ACQUIRED.

PARCEL NUMBER	SHEET NUMBER	OWNER	INTEREST REQUIRED	TOTAL AREA	R/W AREA REQUIRED			TOTAL AREA REMAINING	HIGHWAY EASEMENT AREA	T.L.E. AREA
					NEW	EXISTING	TOTAL			
1	4.3	CHARLES AND LORRAINE FERNAU	FEE & CONSTRUCTION PERMIT	144,311 SQ. m (1,553,350 S.F.)	67 SQ. m (721 S.F.)	----	67 SQ. m (721 S.F.)	144,244 SQ. m (1,552,629 S.F.)	----	----
2	4.3	JAMES M. NOFFKE	FEE & CONSTRUCTION PERMIT	161,874 SQ. m (1,742,400 S.F.)	140 SQ. m (1,507 S.F.)	----	140 SQ. m (1,507 S.F.)	161,734 SQ. m (1,740,893 S.F.)	----	----
3	4.3	MARY A. ARTS	FEE & CONSTRUCTION PERMIT	6,732 SQ. m (72,459 S.F.)	58 SQ. m (624 S.F.)	----	58 SQ. m (624 S.F.)	6,674 SQ. m (71,835 S.F.)	----	----
4	4.3	MILTON G. AND WENDY G. SCHAFFER	FEE	2,125 SQ. m (22,878 S.F.)	63 SQ. m (678 S.F.)	----	63 SQ. m (678 S.F.)	2,062 SQ. m (22,200 S.F.)	----	----
5	4.3	TIM W. WENZLAFF	FEE & CONSTRUCTION PERMIT	3,242 SQ. m (34,900 S.F.)	148 SQ. m (1,593 S.F.)	----	148 SQ. m (1,593 S.F.)	3,094 SQ. m (33,307 S.F.)	----	----
6	4.3,4.4	C.R. MEYER AND SONS CO.	CONSTRUCTION PERMIT	----	----	----	----	----	----	----
7	4.3,4.4	CITY OF OSHKOSH	CONSTRUCTION PERMIT	----	----	----	----	----	----	----
8	4.3,4.4	JANICE E. SCHIAVONE	FEE & CONSTRUCTION PERMIT	1,857 SQ. m (19,989 S.F.)	8 SQ. m (86 S.F.)	----	8 SQ. m (86 S.F.)	1,849 SQ. m (19,903 S.F.)	----	----
9	4.4	CARROLL BETTS	CONSTRUCTION PERMIT	----	----	----	----	----	----	----
10	4.4	RICHARD AND BARBARA SCHIM	CONSTRUCTION PERMIT	----	----	----	----	----	----	----
11	4.4	TODD AND BRENDA SEEFELD	CONSTRUCTION PERMIT	----	----	----	----	----	----	----
12	4.4	BRUCE AND VICKI HAGIE	CONSTRUCTION PERMIT	----	----	----	----	----	----	----
13	4.4	THOMAS A. COATES	FEE & CONSTRUCTION PERMIT	892 SQ. m (9,600 S.F.)	9 SQ. m (97 S.F.)	----	9 SQ. m (97 S.F.)	883 SQ. m (9,503 S.F.)	----	----
14	4.4	ELDON E. AND MARY E. LEE-VENDOR STEVEN LEE-PURCHASER	FEE & CONSTRUCTION PERMIT	1,632 SQ. m (17,570 S.F.)	14 SQ. m (151 S.F.)	----	14 SQ. m (151 S.F.)	1,618 SQ. m (17,419 S.F.)	----	----
15	4.4	JOHN N. TERRY	FEE & CONSTRUCTION PERMIT	2,453 SQ. m (26,400 S.F.)	16 SQ. m (172 S.F.)	----	16 SQ. m (172 S.F.)	2,437 SQ. m (26,228 S.F.)	----	----
16	4.4	RICHARD NONWEILER	CONSTRUCTION PERMIT	----	----	----	----	----	----	----
17	4.4	ASSOCIATES INVESTORS, A GENERAL PARTNERSHIP	CONSTRUCTION PERMIT	----	----	----	----	----	----	----
18	4.4	RICHARD AND PAT BRAASCH	CONSTRUCTION PERMIT	----	----	----	----	----	----	----
19	4.4	DONALD AND DELORES ROBINSON	CONSTRUCTION PERMIT	----	----	----	----	----	----	----
20	4.4	HAROLD AND PAMELA SALZER	CONSTRUCTION PERMIT	----	----	----	----	----	----	----
21	4.4	PINE INVESTMENTS	CONSTRUCTION PERMIT	----	----	----	----	----	----	----
22	4.4	MADDAM AERIALS CORPORATION	CONSTRUCTION PERMIT	----	----	----	----	----	----	----
23	4.4	RICHARD J. VANLANEN	CONSTRUCTION PERMIT	----	----	----	----	----	----	----
24	4.4	FREDERICK W. AND DEBRA A. LIGHTNER	CONSTRUCTION PERMIT	----	----	----	----	----	----	----
25	4.4	DIANE M. SWEET	CONSTRUCTION PERMIT	----	----	----	----	----	----	----
26	4.4,4.5	EDWARD AND CYNTHIA CLEMENTS	CONSTRUCTION PERMIT	----	----	----	----	----	----	----
27	4.4,4.5	KIP A. JACOBSON	CONSTRUCTION PERMIT	----	----	----	----	----	----	----
28	4.4,4.5	GORDON E. AND GERALDINE R. MILLER	CONSTRUCTION PERMIT	----	----	----	----	----	----	----
29	4.5	PAUL E. III AND KRISTIE L. REDEMANN	FEE AND T.L.E.	31,404 SQ. m (338,026 S.F.)	248 SQ. m (2,669 S.F.)	----	248 SQ. m (2,669 S.F.)	31,156 SQ. m (335,357 S.F.)	----	1,977 SQ. m (21,280 S.F.)
30	4.5	DONALD G. AND MARY E. DOBISH	FEE & CONSTRUCTION PERMIT	100,848 SQ. m (1,085,515 S.F.)	1119 SQ. m (12,045 S.F.)	----	1119 SQ. m (12,045 S.F.)	99,729 SQ. m (1,073,460 S.F.)	----	----
31	4.5	PAUL E. REDEMANN	FEE & CONSTRUCTION PERMIT	7,559 SQ. m (81,369 S.F.)	47 SQ. m (506 S.F.)	----	47 SQ. m (506 S.F.)	7,512 SQ. m (80,863 S.F.)	----	----
32	4.5	STATE OF WISCONSIN, DEPARTMENT OF SOCIAL SERVICES	HIGHWAY EASEMENT AND CONSTRUCTION PERMIT	----	----	----	----	----	49 SQ. m (527 S.F.)	----
33	4.5,4.6,4.7	FOX RIVER VALLEY RAILROAD CORPORATION	HIGHWAY EASEMENT AND CONSTRUCTION PERMIT	----	----	----	----	----	32 SQ. m (344 S.F.)	----
34	4.5,4.6,4.7	STATE OF WISCONSIN, STATE DEPARTMENT OF PUBLIC WELFARE	HIGHWAY EASEMENT AND CONSTRUCTION PERMIT	----	----	----	----	----	28 SQ. m (301 S.F.)	----
35	4.6	ASSOCIATED BANK NATIONAL ASSOCIATION	FEE & CONSTRUCTION PERMIT	2,153 SQ. m ± (23,175 S.F.)	59 SQ. m (635 S.F.)	----	59 SQ. m (635 S.F.)	2,094 SQ. m ± (22,540 S.F.)	----	----
36	4.6	ELMER TERHORST	CONSTRUCTION PERMIT	----	----	----	----	----	----	----
37	4.6	GERALD THORSON	CONSTRUCTION PERMIT	----	----	----	----	----	----	----
38	4.6	ELMER TERHORST	CONSTRUCTION PERMIT	----	----	----	----	----	----	----

REVISION DATE 09-09-1998	DATE 08-24-1998	HIGHWAY: C.T.H. "A"	FEDERAL PROJECT NO: 4994-00-00
		COUNTY: WINNEBAGO	STATE R/W PROJECT NO:
			SHEET NO: 42

PEN TABLE = #plot72\ciser\mv80pp.tbl
 DATE OF PLOT = 10/15/98
 PLOT NA
 DESIGN FILE IS #1-440278\DON\wrsched1.dgn
 FILE NAME:
 SCALE:
 DATE: 12/24/96
 PLOT NAME:
 ORIGINATOR: JPZ
 PROJECT NO: 44-0234
 LEVELS ON - 1,2,3,4,5,6,7,8,9,10,11,12,13,14,15,16,17,18,19,20,21,22,23,24,25,26,27,28,29,30,31,32,33,34,35,36,37,38,39,40,41,42,43,44,45,46,47,48,49,50,51,52,53,54,55,56,57,58,59,60,61,62

Job 4
 PEN TABLE = #plot72\ciser\mv80pp.tbl
 DATE OF PLOT = 10/15/98
 PLOT NA
 DESIGN FILE IS I:\440278\DNV\wsched2.dgn
 FILE NAME: 12/24/96
 SCALE:
 DATE: 12/24/96
 PLOT NAME:
 PROJECT NO: 44-0234
 LEVELS ON - 1,2,3,4,5,6,7,8,9,10,11,12,13,14,15,16,17,18,19,20,21,22,23,24,25,26,27,28,29,30,31,32,33,34,35,36,37,38,39,40,41,42,43,44,45,46,47,48,49,50,51,52,53,54,55,56,57,58,59,60,61,62.

SCHEDULE OF LANDS & INTERESTS REQUIRED

AREAS SHOWN IN THE TOTAL ACRES COLUMN MAY BE APPROXIMATE AND ARE DERIVED FROM TAX ROLLS OR OTHER AVAILABLE SOURCES AND MAY NOT INCLUDE LANDS OF THE OWNER WHICH ARE NOT CONTIGUOUS TO THE AREA TO BE ACQUIRED.

PARCEL NUMBER	SHEET NUMBER	OWNER	INTEREST REQUIRED	TOTAL AREA	R/W AREA REQUIRED			TOTAL AREA REMAINING	HIGHWAY EASEMENT AREA	T.L.E. AREA
					NEW	EXISTING	TOTAL			
39	4.6	NORTH SHORE MANOR APARTMENTS	CONSTRUCTION PERMIT	----	----	----	----	----	----	----
40	4.7	HERBERT SALZSIEDER	CONSTRUCTION PERMIT	----	----	----	----	----	----	----
41	4.7	MARK F. AND KRISTEN SALZSIEDER	CONSTRUCTION PERMIT	----	----	----	----	----	----	----
42	4.7	JAMES CLARK	CONSTRUCTION PERMIT	----	----	----	----	----	----	----
43	4.7	DAVID AND JENNICE BREARLEY	CONSTRUCTION PERMIT	----	----	----	----	----	----	----
44	4.7	SHARON G. BREARLEY	FEE & CONSTRUCTION PERMIT	2,711 SQ. m (29,185 S.F.)	14 SQ. m (151 S.F.)	----	14 SQ. m (151 S.F.)	2,697 SQ. m (29,134 S.F.)	----	----
45	4.7	LAKEVIEW LIMITED PARTNERSHIP	FEE & CONSTRUCTION PERMIT	944 SQ. m (10,162 S.F.)	5 SQ. m (54 S.F.)	----	5 SQ. m (54 S.F.)	939 SQ. m (10,108 S.F.)	----	----
46	4.3	CITY OF OSHKOSH	RELEASE	----	----	----	----	----	----	----
47	4.3,4.6,4.7	AMERITECH	RELEASE	----	----	----	----	----	----	----
48	4.5	WISCONSIN PUBLIC SERVICE CORPORATION	RELEASE	----	----	----	----	----	----	----
49	4.4	NEIL O. AND LORETTA ZIEBELL-VENDOR STEVEN E. LEE-PURCHASER	FEE & CONSTRUCTION PERMIT	1,784 SQ. m (19,200 S.F.)	12 SQ. m (129 S.F.)	----	12 SQ. m (129 S.F.)	1,772 SQ. m (19,071 S.F.)	----	----
50										


REVISION DATE 07-21-1998 09-09-1998 NC	DATE 08-24-1998	HIGHWAY: C.T.H. "A"	FEDERAL PROJECT NO: 4994-00-00	COUNTY: WINNEBAGO	STATE R/W PROJECT NO:	SHEET NO: 4.3	M
---	-----------------	---------------------	--------------------------------	-------------------	-----------------------	---------------	---

CITY

TOWN

LEGEND

T.I. (CONSTRUCTION PERMIT) REQ'D.

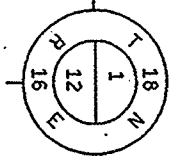

SW-SE
1-18-16

NW-SE
1-18-16

ORIGINATOR: LEVELS ON - 1, 2, 3, 62, 63

C.T.H. "AA"

ADVOCAP, INC. BUILDING

CHARLES AND LORRAINE FERNAU

STA. 10+464.880 C.T.H. "A"=
STA. 2+000.000 SHADOW LANE

C. R. MEYER AND SONS CO.

OF

EMRO MARKETING CO.

C.T.H. "A" BOWEN STREET

BEGIN RELOCATION ORDER
STA. 10+095.000

C.T.H. "A" R/W CONSTRUCTION

STANLEY KELLENBERGER

JAMES M. NOFFKE

EASEMENT
WISCONSIN PUBLIC SERVICE CORPORATION
VOL. 378 PAGE 71

MILTON G. AND WENDY G. SCHAFER

STA. 10+370.594 C.T.H. "A"=
STA. 1+000.000 MAC ARTHUR LANE

TIM W. WENZLAFF

SEWER EASEMENT
CITY OF OSHKOSH
DOCUMENT 982212
DOCUMENT 958378

OSHKOSH

OSHKOSH

OSHKOSH

SHADOW LANE CURVE DATA

P.I. = 2+022.479
 Δ = 27°25'28"
 T = 22.479 m (73.75')
 L = 44.786 m (146.93')
 E = 1.206 m (3.96')
 R = 208.923 m (685.44')
 P.C. = 2+000.000
 P.T. = 2+044.786
 L.C.B. = N59°55'08"E
 L.C. = 44.700 m (146.65')

REVISION DATE 09-09-1998	DATE 08-24-1998	SCALE, METERS 0 50 100	HWY: C.T.H. "A"	FEDERAL PROJECT NO:
GRID FACTOR			COUNTY: WINNEBAGO	STATE R/W PROJECT NO: 4994-00-00
FILE NAME:				SHEET NO: 4A M

TOWN

LEGEND

T.I. (CONSTRUCTION PERMIT) REQ'D.

CITY



NW-SE
1-18-16

SW-NE
1-18-16

NW-NE
1-18-16

OF

C. R. MEYER AND SONS CO.

6 STA. 10+727.432 C.T.H. "A"=
STA. 4+000.000 RIDGE LANE

STA. 10+644.131 C.T.H. "A"=
STA. 3+000.000 MILLER LANE

OSHKOSH

RICHARD NONWEILER
16

ASSOCIATED INVESTORS,
A GENERAL PARTNERSHIP
17

PINE INVESTMENTS
21

MADDAM AERIALS CORPORATION
22

DIANE M. SWEET
25

EDWARD AND CYNTHIA CLEMENTS
26

CLYDE W. SMITH

TOWN

STA. 11+021.054 C.T.H. "A"=
STA. 6+000.000 DRIFTWOOD LANE

CITY OF OSHKOSH 7

OF

10+800

11+000

11+200

BEARING, N00°13'57"E

STA. 10+777.542 C.T.H. "A"=
STA. 5+000.000 KEENVILLE AVENUE

RICHARD AND PAT BRAASCH
18

ASSESSOR'S PLAT NO. 1
TOWN OF OSHKOSH

SE-NE
1-18-16

OSHKOSH

OF

FREDERICK W. AND DEBRA A. LIGHTNER
24

KIP A. JACOBSON
27

GORDON E. AND GERALDINE R. MILLER
28

RICHARD J. VANLANEN
23

OSHKOSH

NE-NE
1-18-16

ORIGINATOR: LEVELS ON - 1, 2, 3, 62, 63

REVISION DATE
09-09-1998

DATE
08-24-1998

SCALE, METERS
0 50 100

HWY: C.T.H. "A"
COUNTY: WINNEBAGO

FEDERAL PROJECT NO:
STATE R/W PROJECT NO: 4994-00-00

SHEET NO: 4.5 M

14 ELDON E. AND MARY E. LEE-VENDOR
STEVEN E. LEE-PURCHASER
49 NEIL O. AND LORETTA E. ZIEBELL-VENDOR
STEVEN E. LEE-PURCHASER


BAY VIEW PARK SUBDIVISION

CITY


NE-SE
1-18-16

OF

OSHKOSH

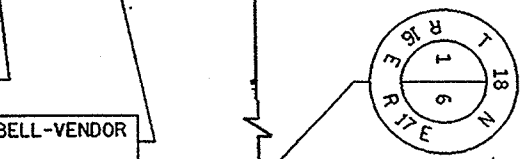

ORIGINATOR: LEVELS ON - 1, 2, 3, 62, 63
 FILE NAME:

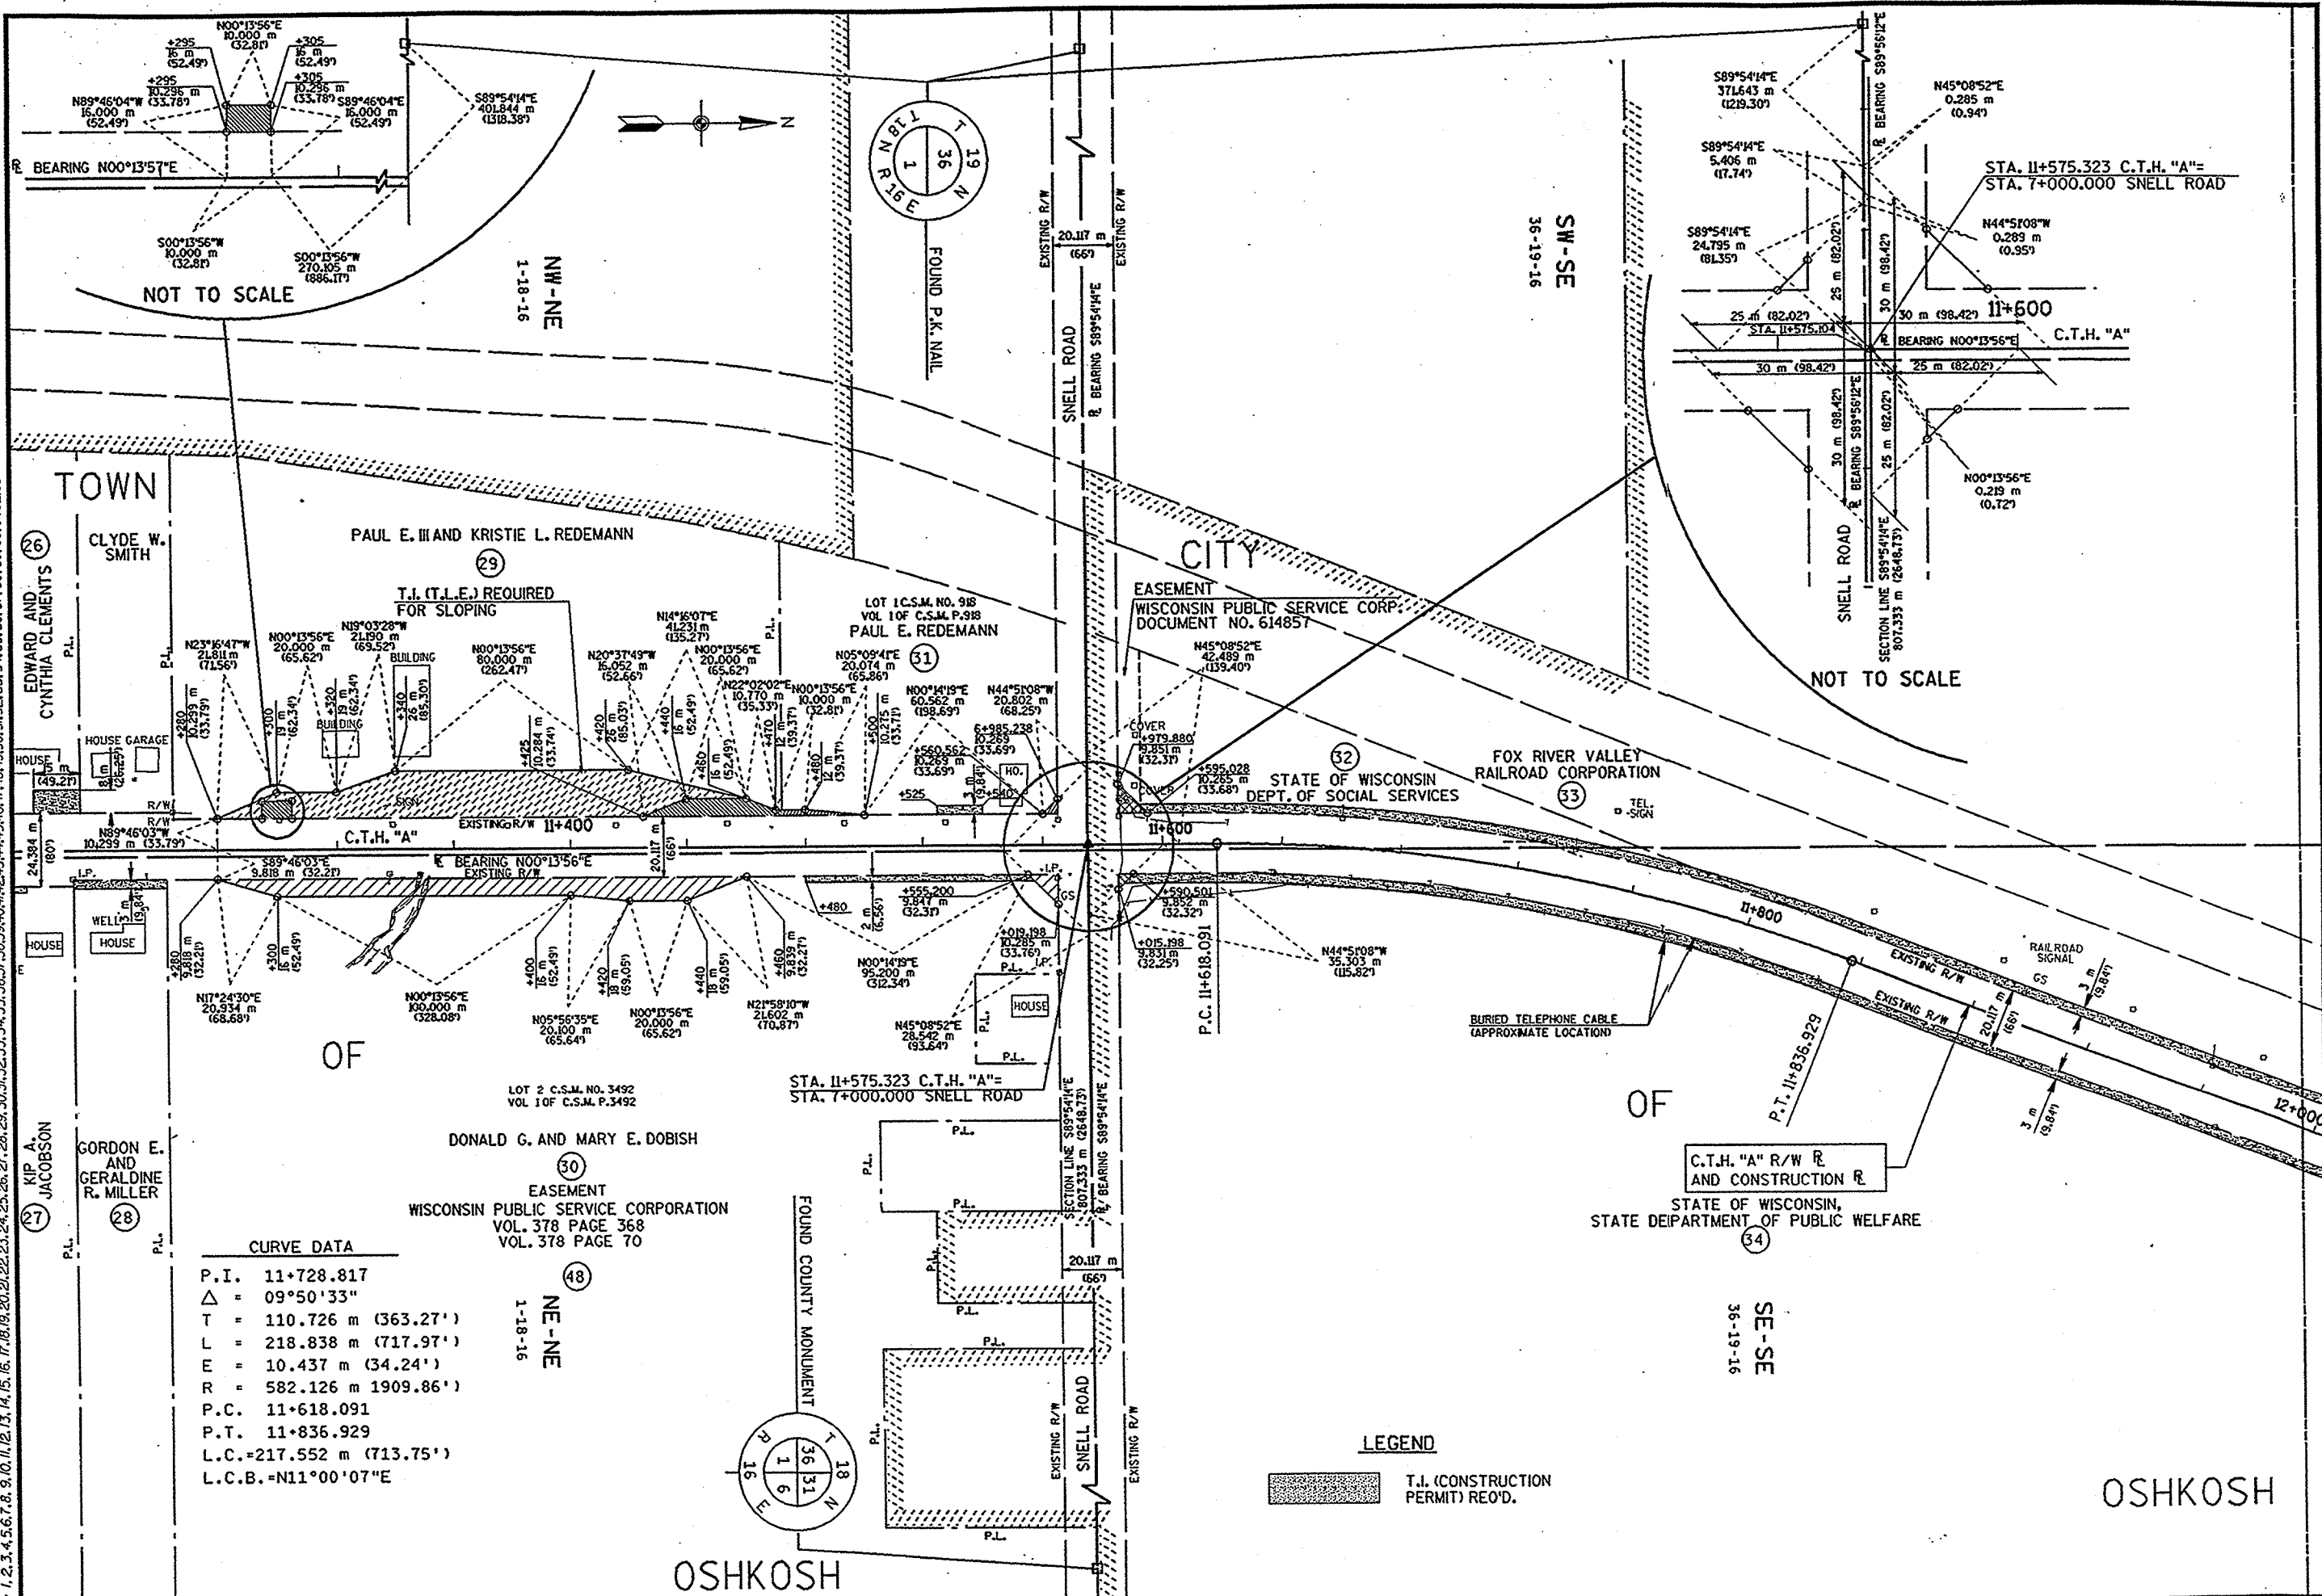

CURVE DATA


P.I.	11+728.817
Δ	= 09°50'33"
T	= 110.726 m (363.27')
L	= 218.838 m (717.97')
E	= 10.437 m (34.24')
R	= 582.126 m 1909.86')
P.C.	11+618.091
P.T.	11+836.929
L.C.	= 217.552 m (713.75')
L.C.B.	= N11°00'07"E

LEGEND

T.I. (CONSTRUCTION PERMIT) REQ'D.

REVISION DATE 09-09-1998	DATE 08-24-1998	SCALE, METERS 0 50 100	HWY: C.T.H. "A" COUNTY: WINNEBAGO	FEDERAL PROJECT NO: STATE R/W PROJECT NO: 4994-00-00	SHEET NO: 4.6 M
-----------------------------	--------------------	---------------------------	--------------------------------------	---	-----------------

ORIGINAL: LEVELS ON - 1, 2, 3, 62, 63

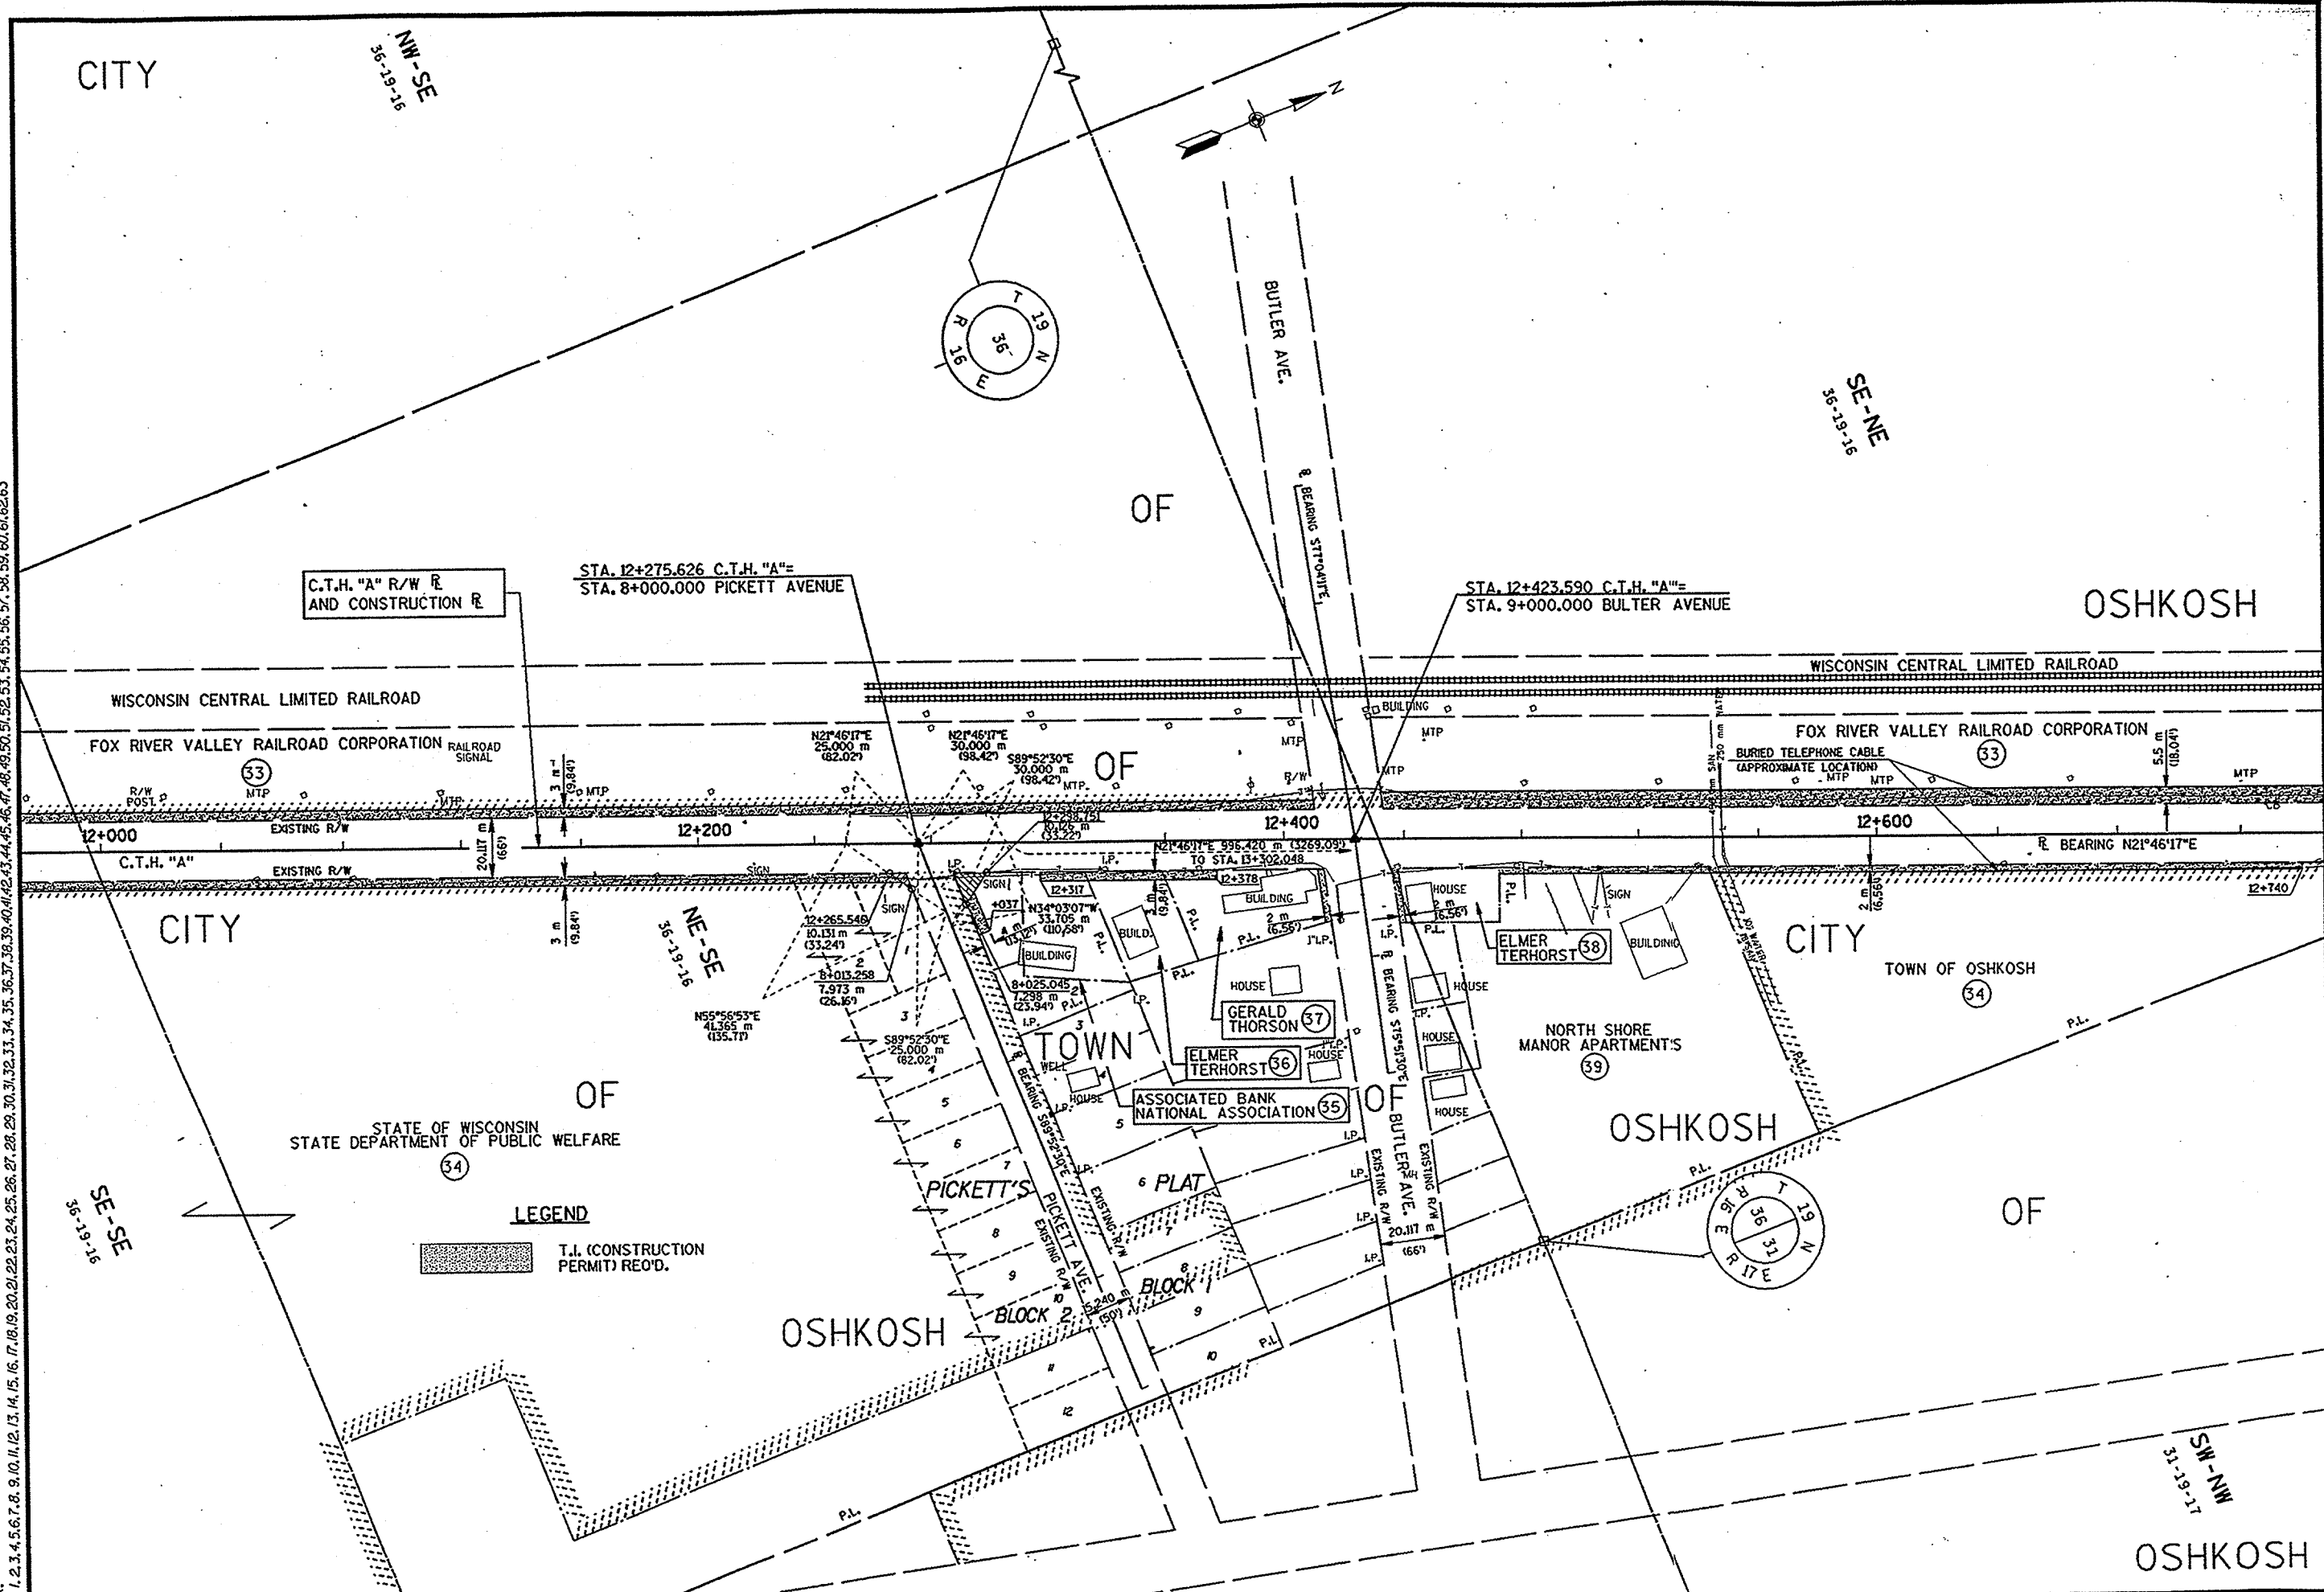


LEGEND
 T.I. (CONSTRUCTION PERMIT) RECD.

REVISION DATE 09-09-1998	DATE 08-24-1998	SCALE, METERS 0 50 100	HWY: C.T.H. "A" COUNTY: WINNEBAGO	FEDERAL PROJECT NO: STATE R/W PROJECT NO: 4994-00-00	SHEET NO: 4.7	M
-----------------------------	--------------------	---------------------------	--------------------------------------	---	---------------	---

FILE NAME:

WISDOT: MSHT 72

ORIGINATOR: LEVELS ON - 1, 2, 3, 62, 63

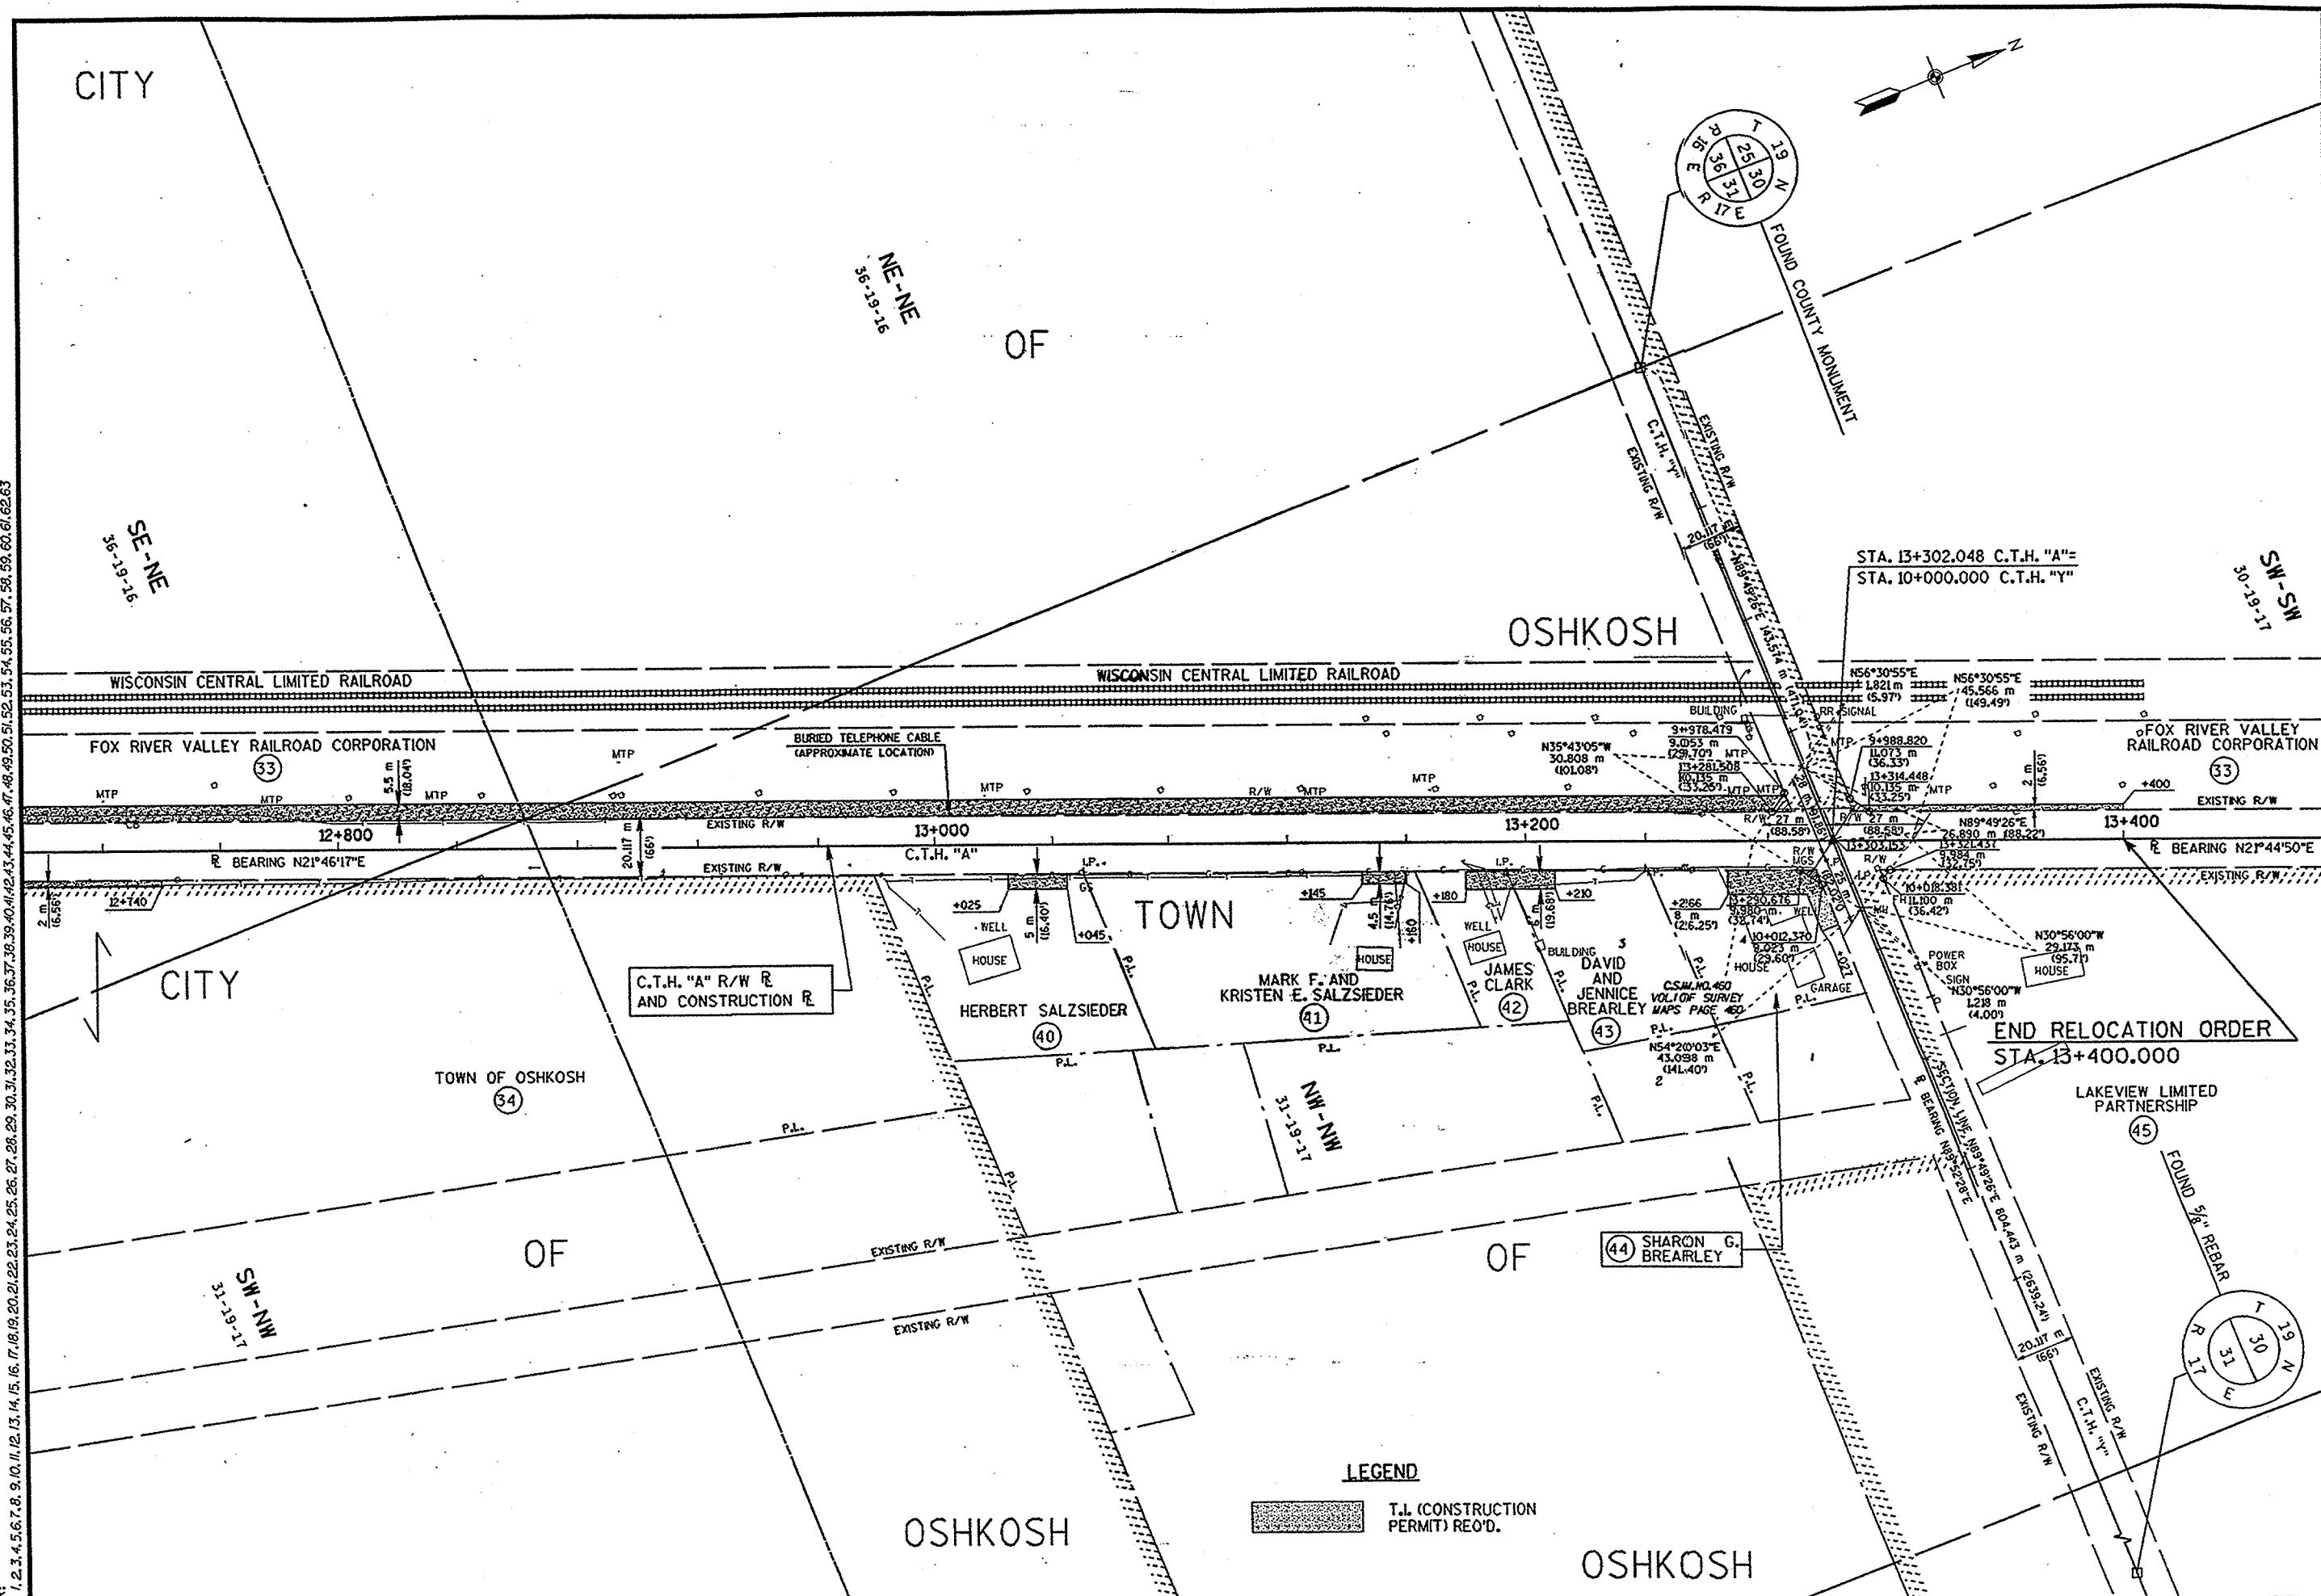

REVISION DATE 09-09-1998	DATE 08-24-1998	SCALE, METERS 0 50 100	HWY: C.T.H. "A"	FEDERAL PROJECT NO:	
GRID FACTOR			COUNTY: WINNEBAGO	STATE R/W PROJECT NO: 4994-00-00	SHEET NO: 4.8 M


FILE NAME:

WI6DOT: MSR: 75

CB 2
 PEN TABLE = sploct72:ioser-inv80pp.tbl
 DATE OF PLOT = 11/25/98
 PLOT NA
 DESIGN FILE IS I:\440278\dgn\ppl.dgn

59.60.61.62
 50.51.52.53.54.55.56.57.
 44.45.46.47.48.


ORIGINATOR: JPZ
 PROJECT NO: 44-0278
 DATE: 02/25/98
 FILE NAME: PPI.PRF
 SCALE:
 PLOT NAME: PPI.PREF

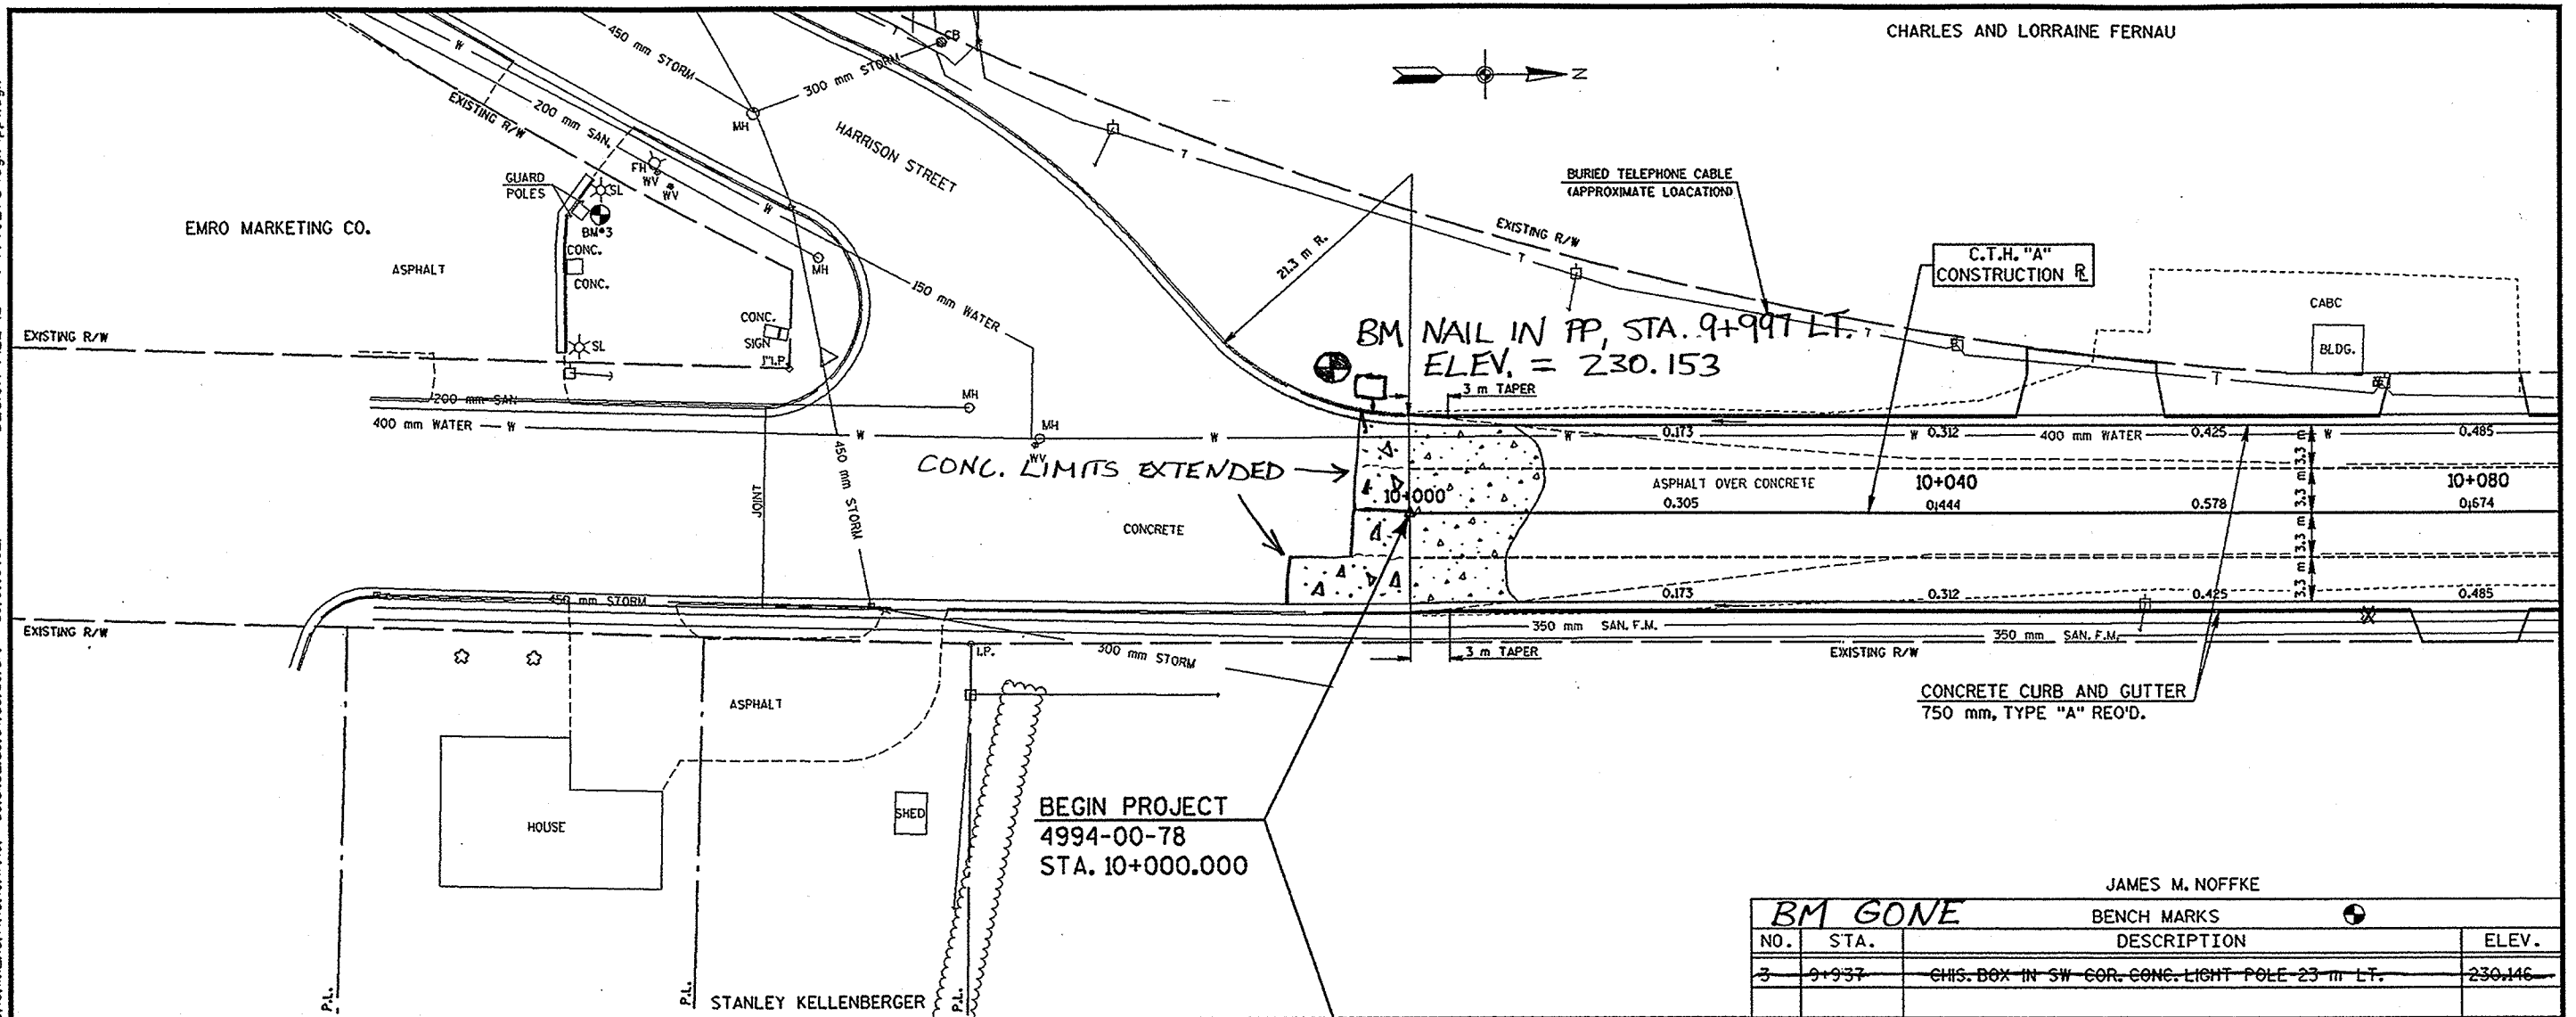

BEGIN PROJECT
 4994-00-78
 STA. 10+000.000


JAMES M. NOFFKE

BM GONE			
NO.	STA.	DESCRIPTION	ELEV.
3	9+937	CHS. BOX IN SW COR. CONC. LIGHT POLE 23 m LT.	230.146

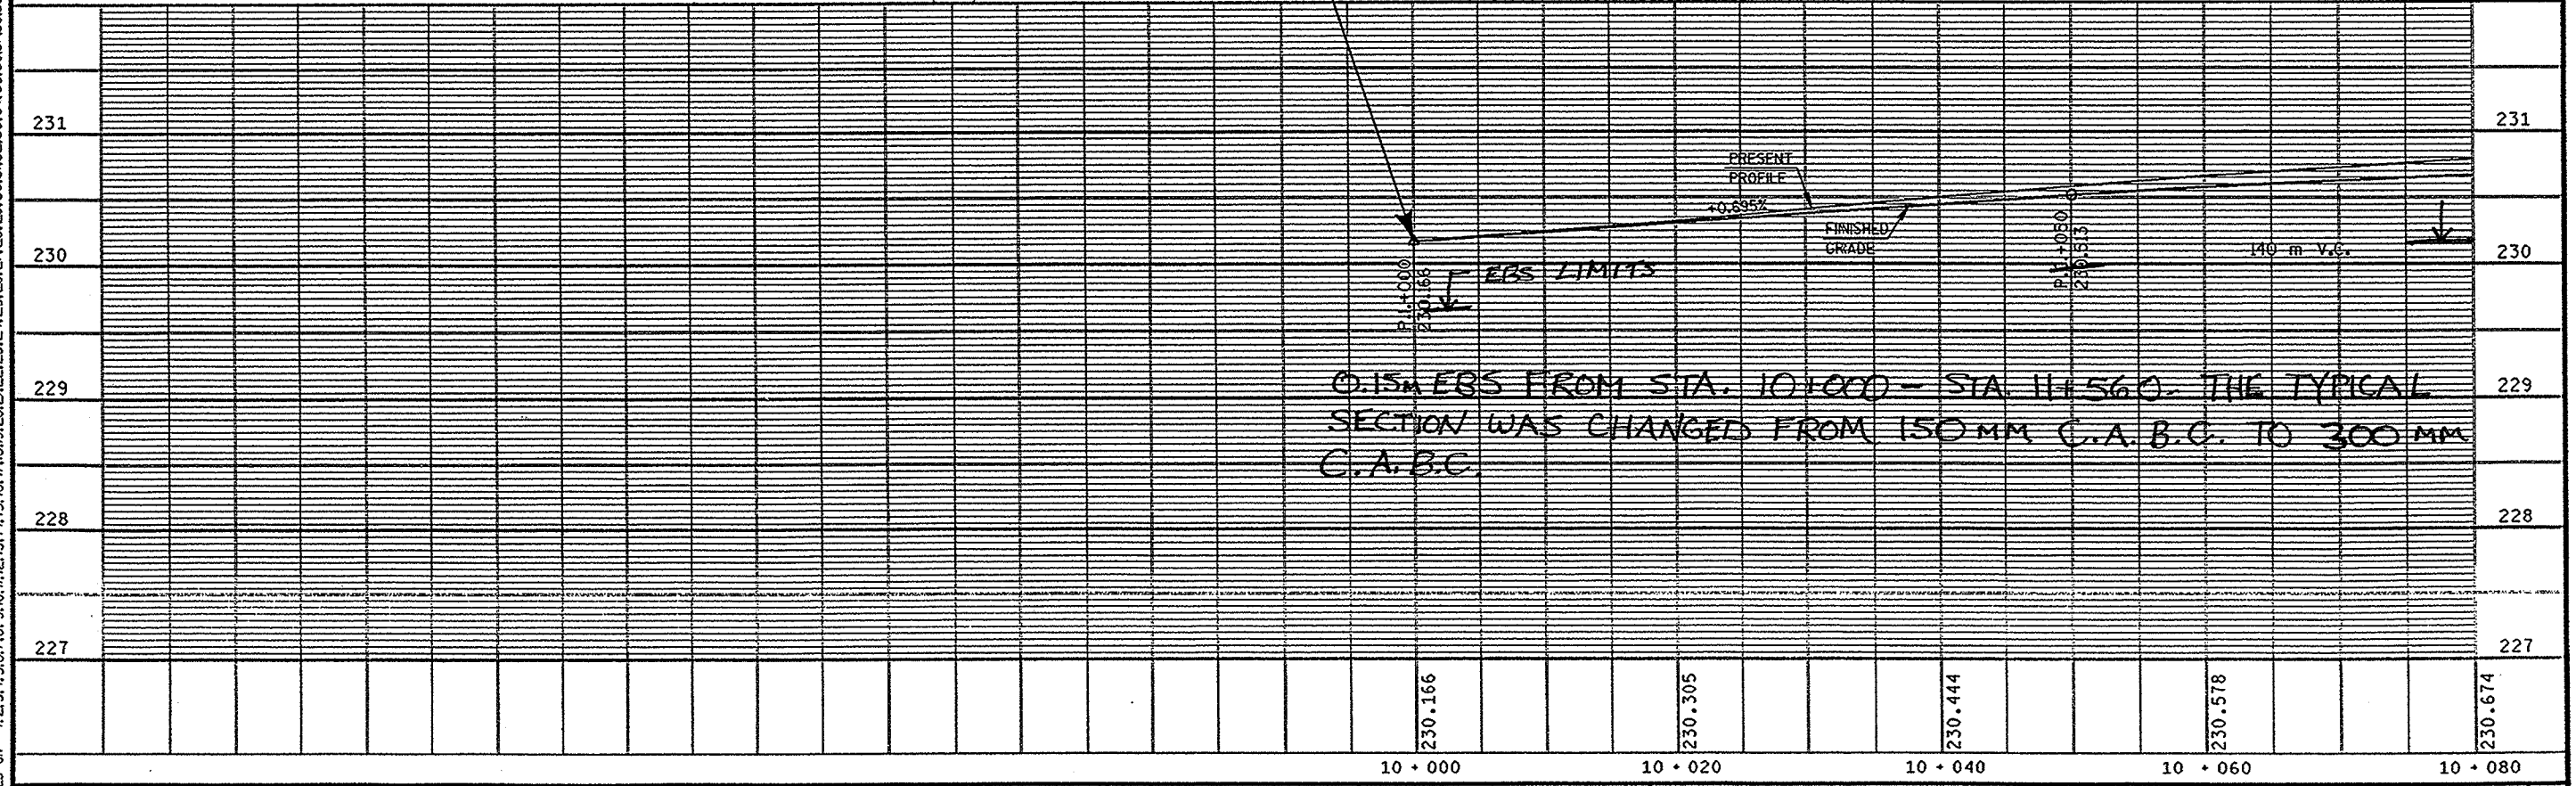


CB 2
 PEN TABLE = #plot72+laser+mv80pp.tbl
 DATE OF PLOT = 11/25/98
 PLOT NA
 DESIGN FILE IS I:\440278\dgn\pp2.dgn
 FILE NAME:
 SCALE:
 DATE: 2/25/98
 PLOT NAME:
 ORIGINATOR: JPZ
 PROJECT NO: 44-0278
 LEVELS ON = 1, 2, 3, 48, 50, 51, 52, 53, 54, 55, 56, 57, 58, 59, 60, 61, 62.

CHARLES AND LORRAINE FERNAU

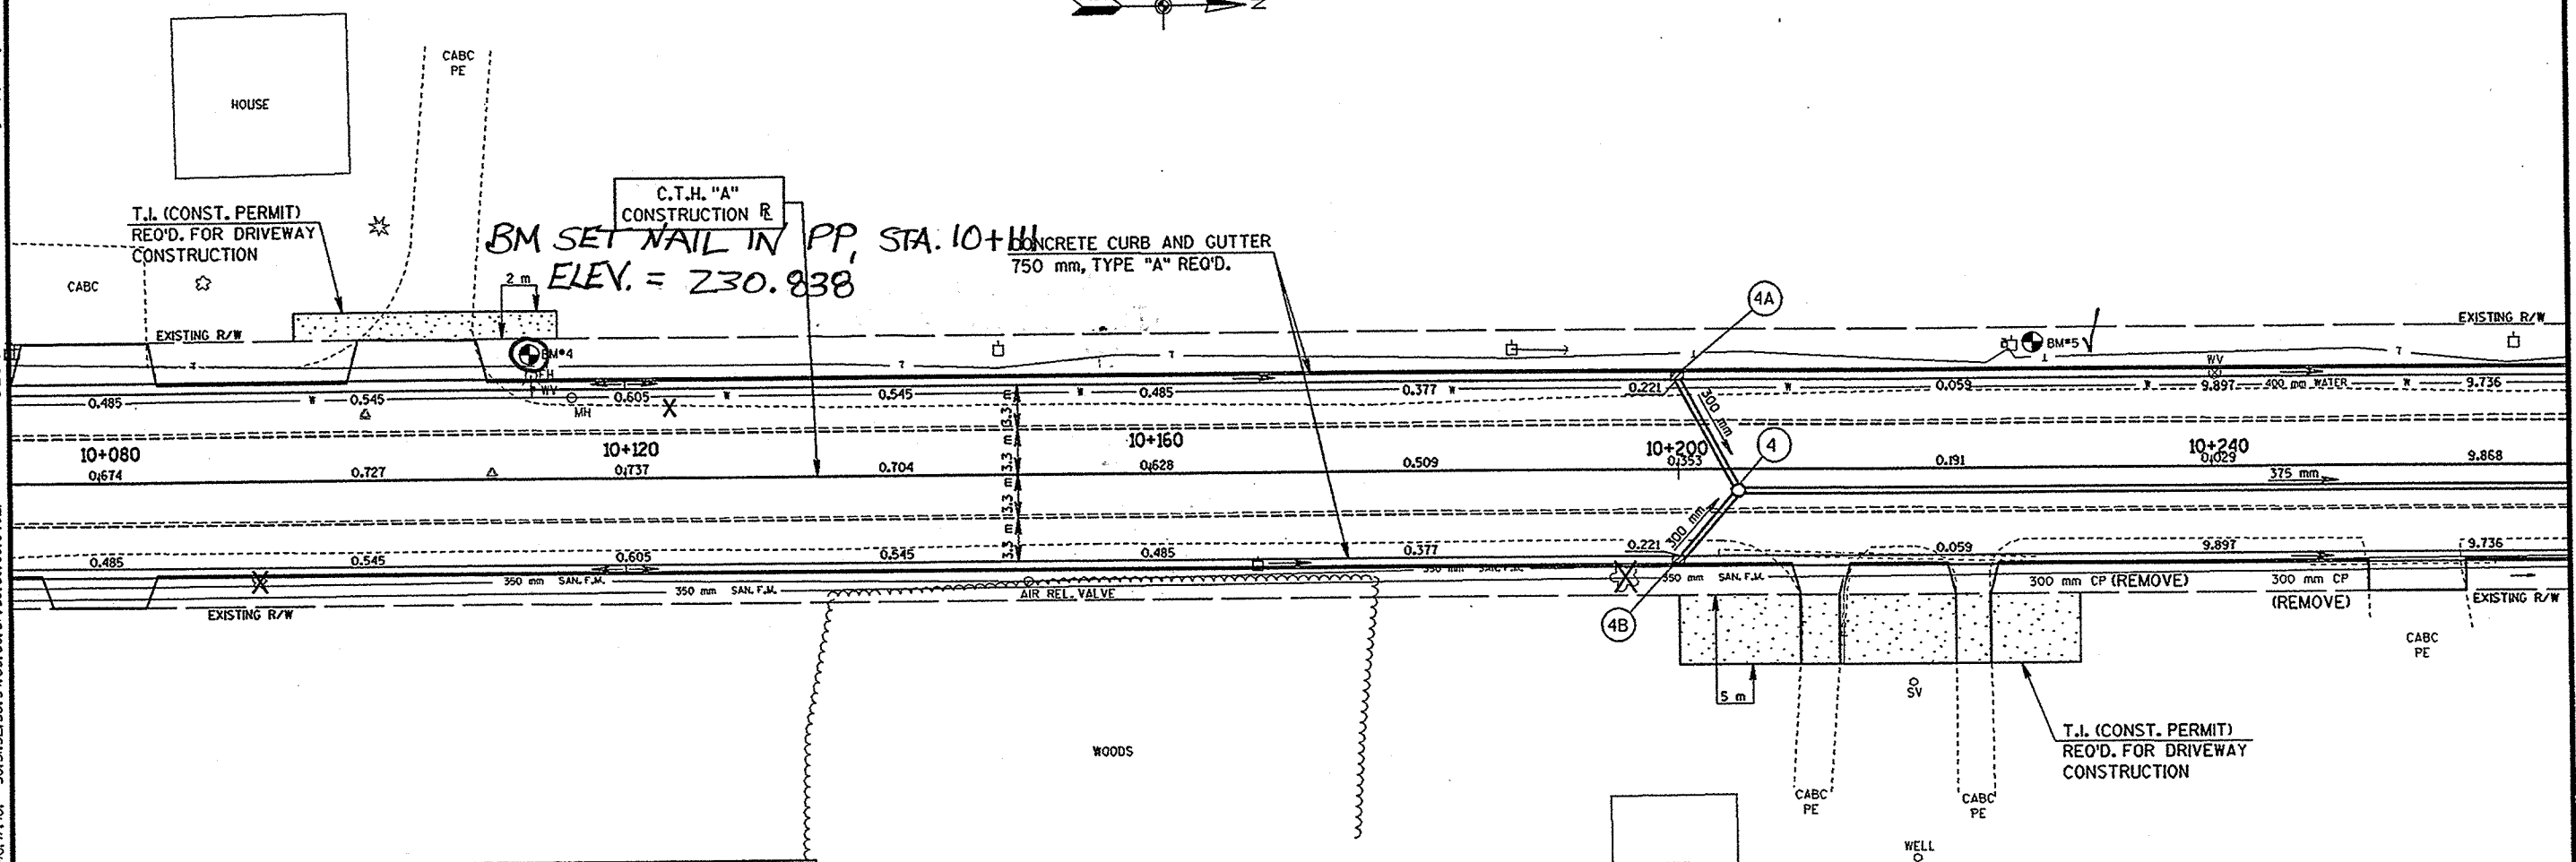

BENCH MARKS			
NO.	STA.	DESCRIPTION	ELEV.
4	10+113	SET 150 mm NAIL IN PP#50-DD-64-9 m LT.	230.893
5	10+225	SET 150 mm NAIL IN PP#50-CC-64 9 m LT.	229.931

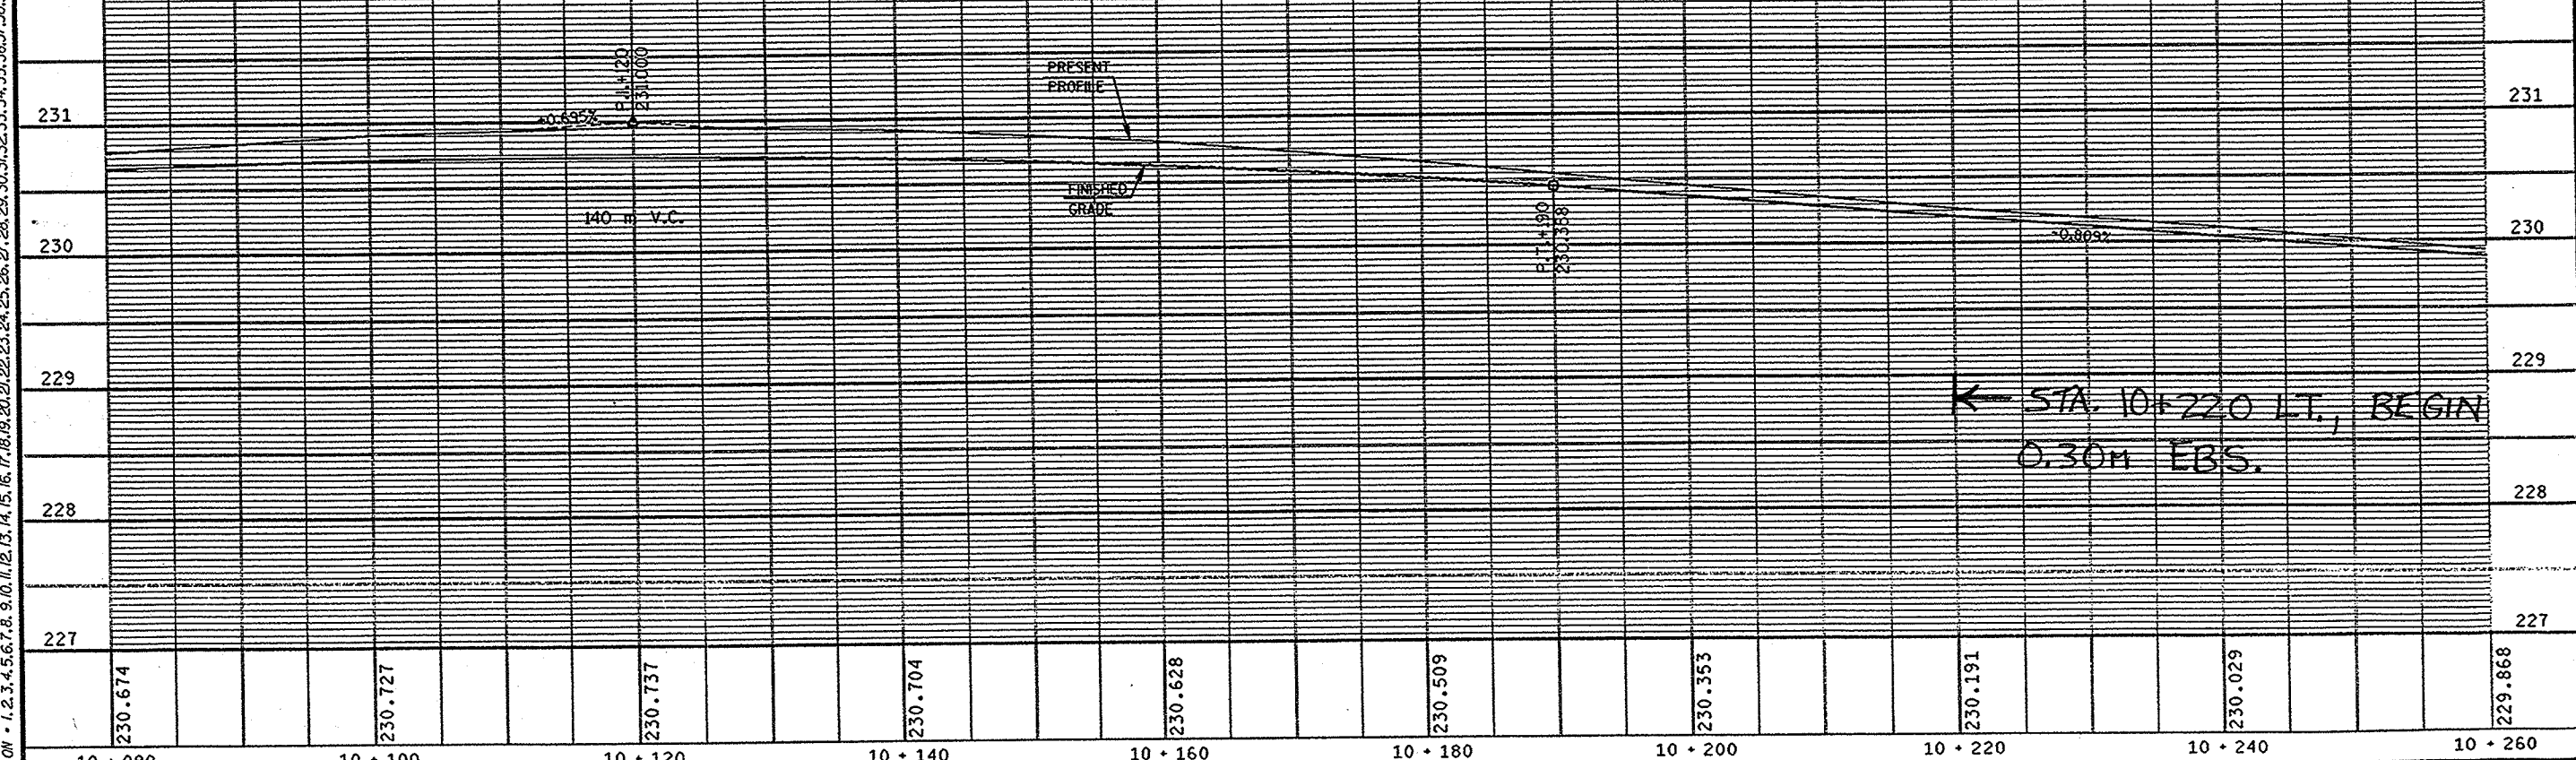

CHARLES AND LORRAINE FERNAU

MARY ARTS

REVISED SHEET

REVISED 4/7/00

HOUSE T.I. (CONST. PERMIT) REQ'D. FOR DRIVEWAY CONSTRUCTION

SAW CUT REQ'D. FULL DEPTH

NOTE: E.O.P. GRADES REVISED DUE TO DRAINAGE PROBLEMS AND ABRUPT CROSS-SLOPE CHANGES AT INTERSECTIONS. SEE ATTACHED SHEETS SHOWING PLAN GRADE PROBLEMS.

STA. 10+370.594 C.T.H. "A" = STA. 1+000.000 MAC ARTHUR LANE

ASPH. SLOPE PAVING ADDED. BOTH SIDES OF ROADWAY FROM TOP OF CURB TO HEADWALL.

CONCRETE CURB AND GUTTER 750 mm TYPE "A" REQ'D.

CONC. PAV'T LIMITS ENDED ON SIDEROADS AT CURB FLANGE EXTENDED.

BM NAIL IN FP SE COR. 'A' AND MacArthur. ELEV. = 229.055

MILTON SCHAFER


TIM WENZLAFF

600 mm RCP STORM SEWER FROM ENDWALL (5) TO MH (6) WAS BACKFILLED WITH CLAY IN AN ATTEMPT TO PREVENT CHANNEL FLOW FROM FOLLOWING STORM TRENCH.


NORMAL LAKE WATER ELEV. = 227.998 NAVIGATION SEASON.

STA. 10+405 RT. STA. 10+600 RT. 0.30M EBS

FILE NAME: DATE: PLOT NAME: SCALE: PROJECT NO: ORIGINATOR: DJD

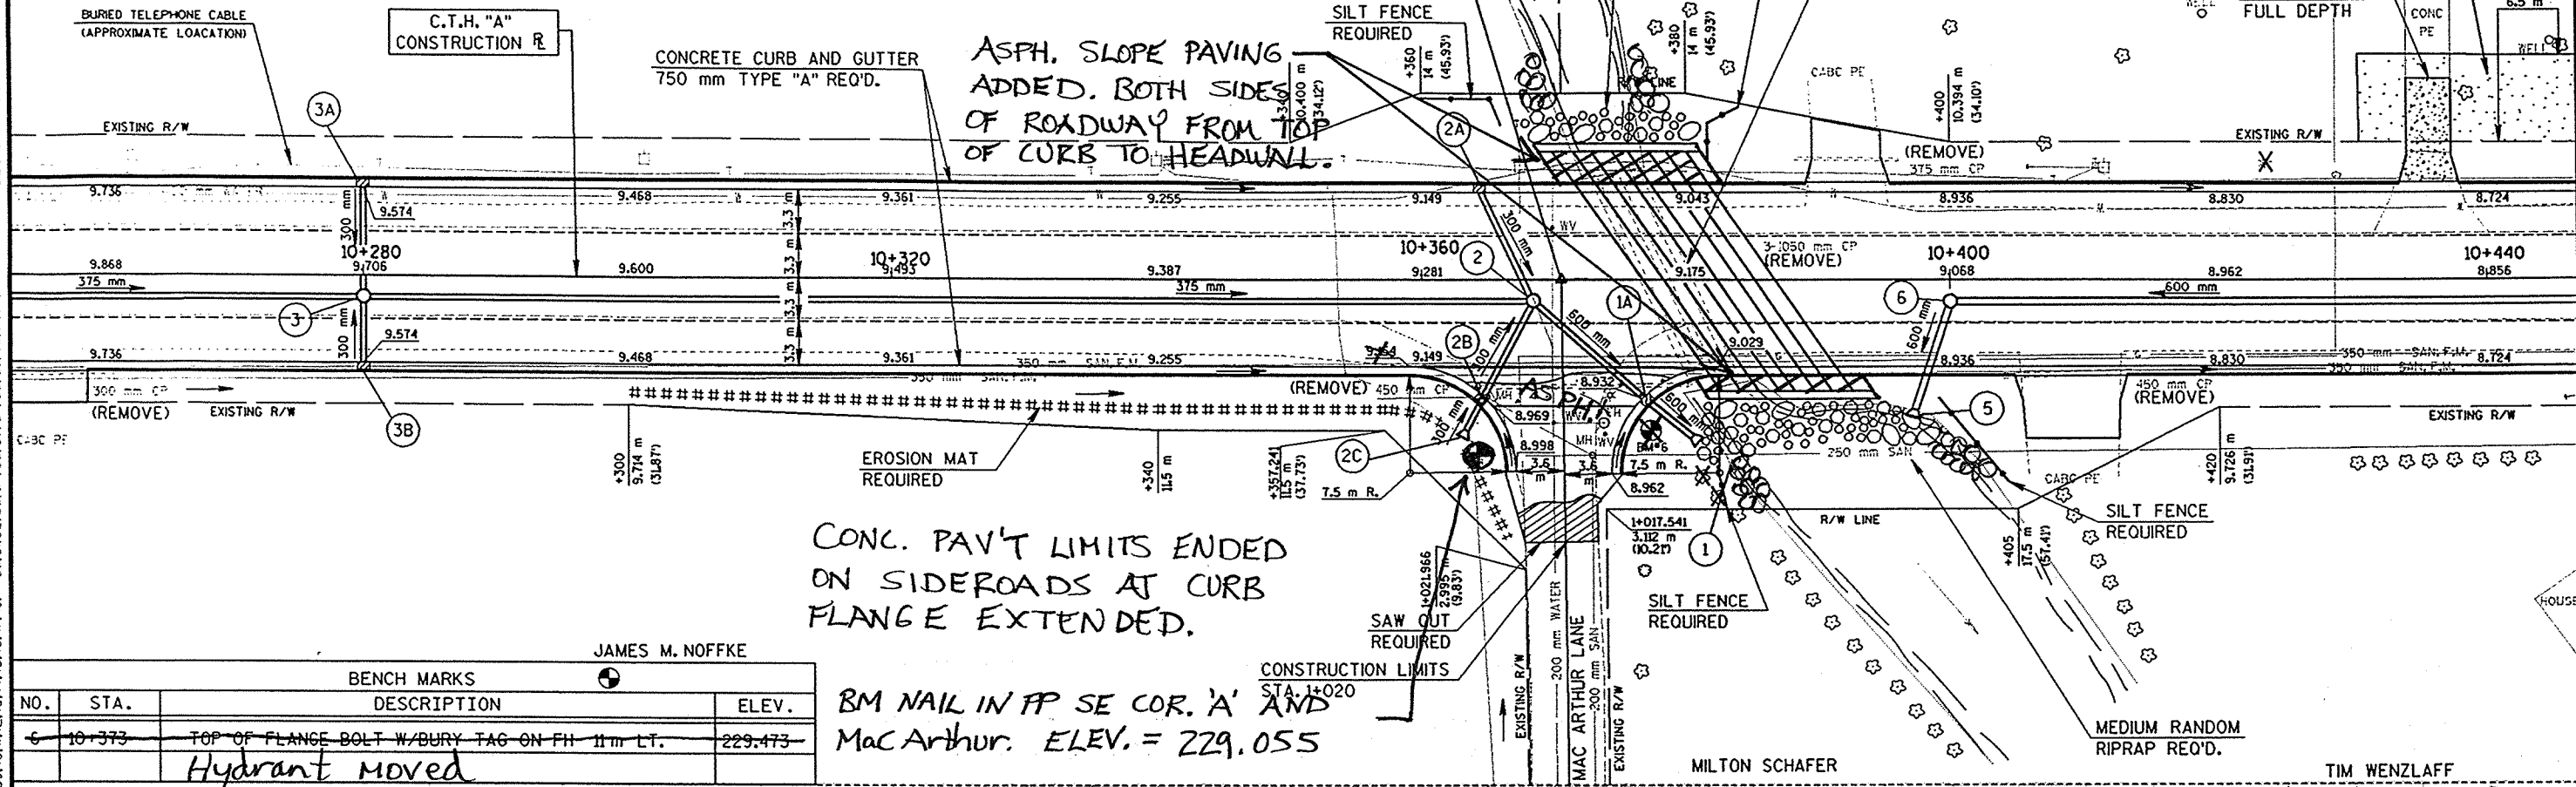



BENCH MARKS			
NO.	STA.	DESCRIPTION	ELEV.
6	10+373	TOP OF FLANGE BOLT W/BURY TAG ON FH 11m LT.	229.473
Hydrant moved			

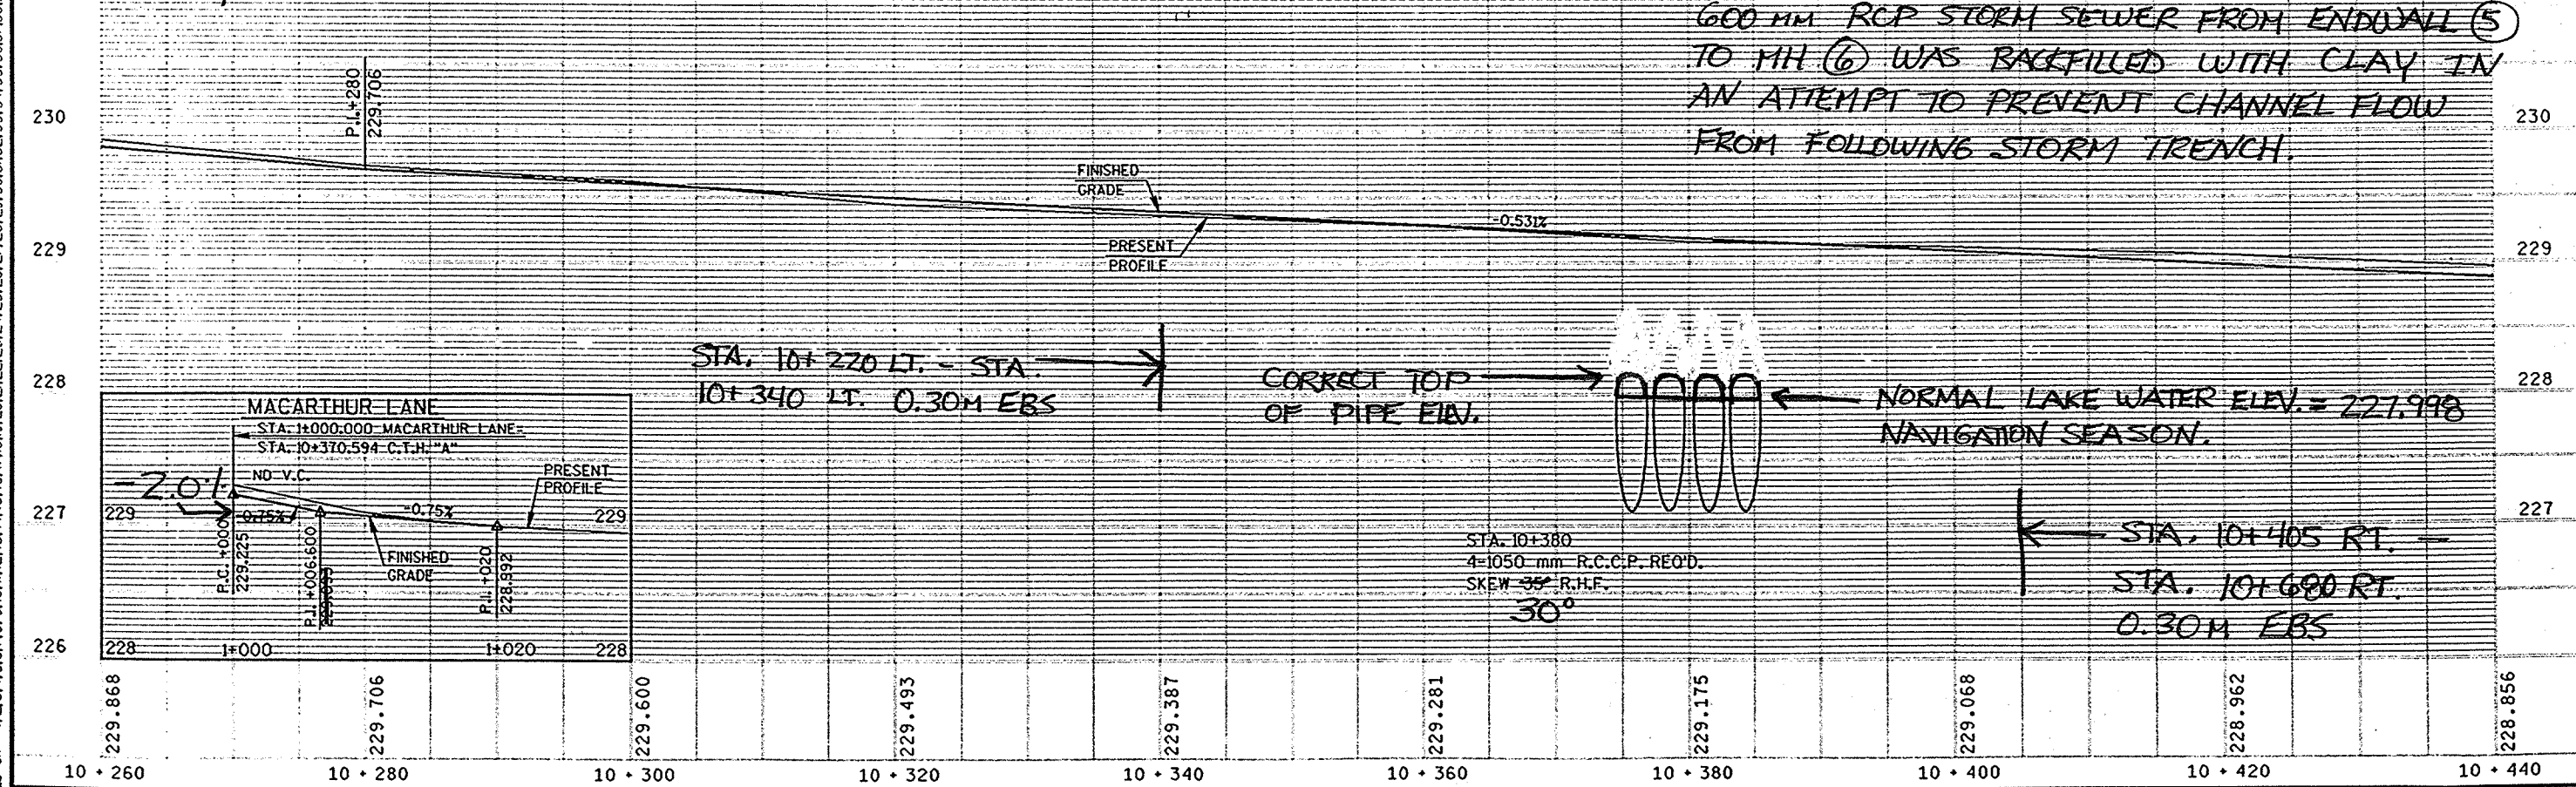


CB 2
 PEN TABLE = #plot72\cuser\m\80pp.tbl
 DATE OF PLOT = 04/15/99
 PLOT NO
 DESIGN FILE IS I:\440278\4gn\pp3.dgn

FILE NAME:
 SCALE:
 DATE:
 PLOT NAME:


ORIGINATOR: DJD
 PROJECT NO:
 LEVELS ON = 1, 2, 3, 48, 50, 51, 52, 53, 54, 55, 56, 57, 58, 59, 60, 61, 62

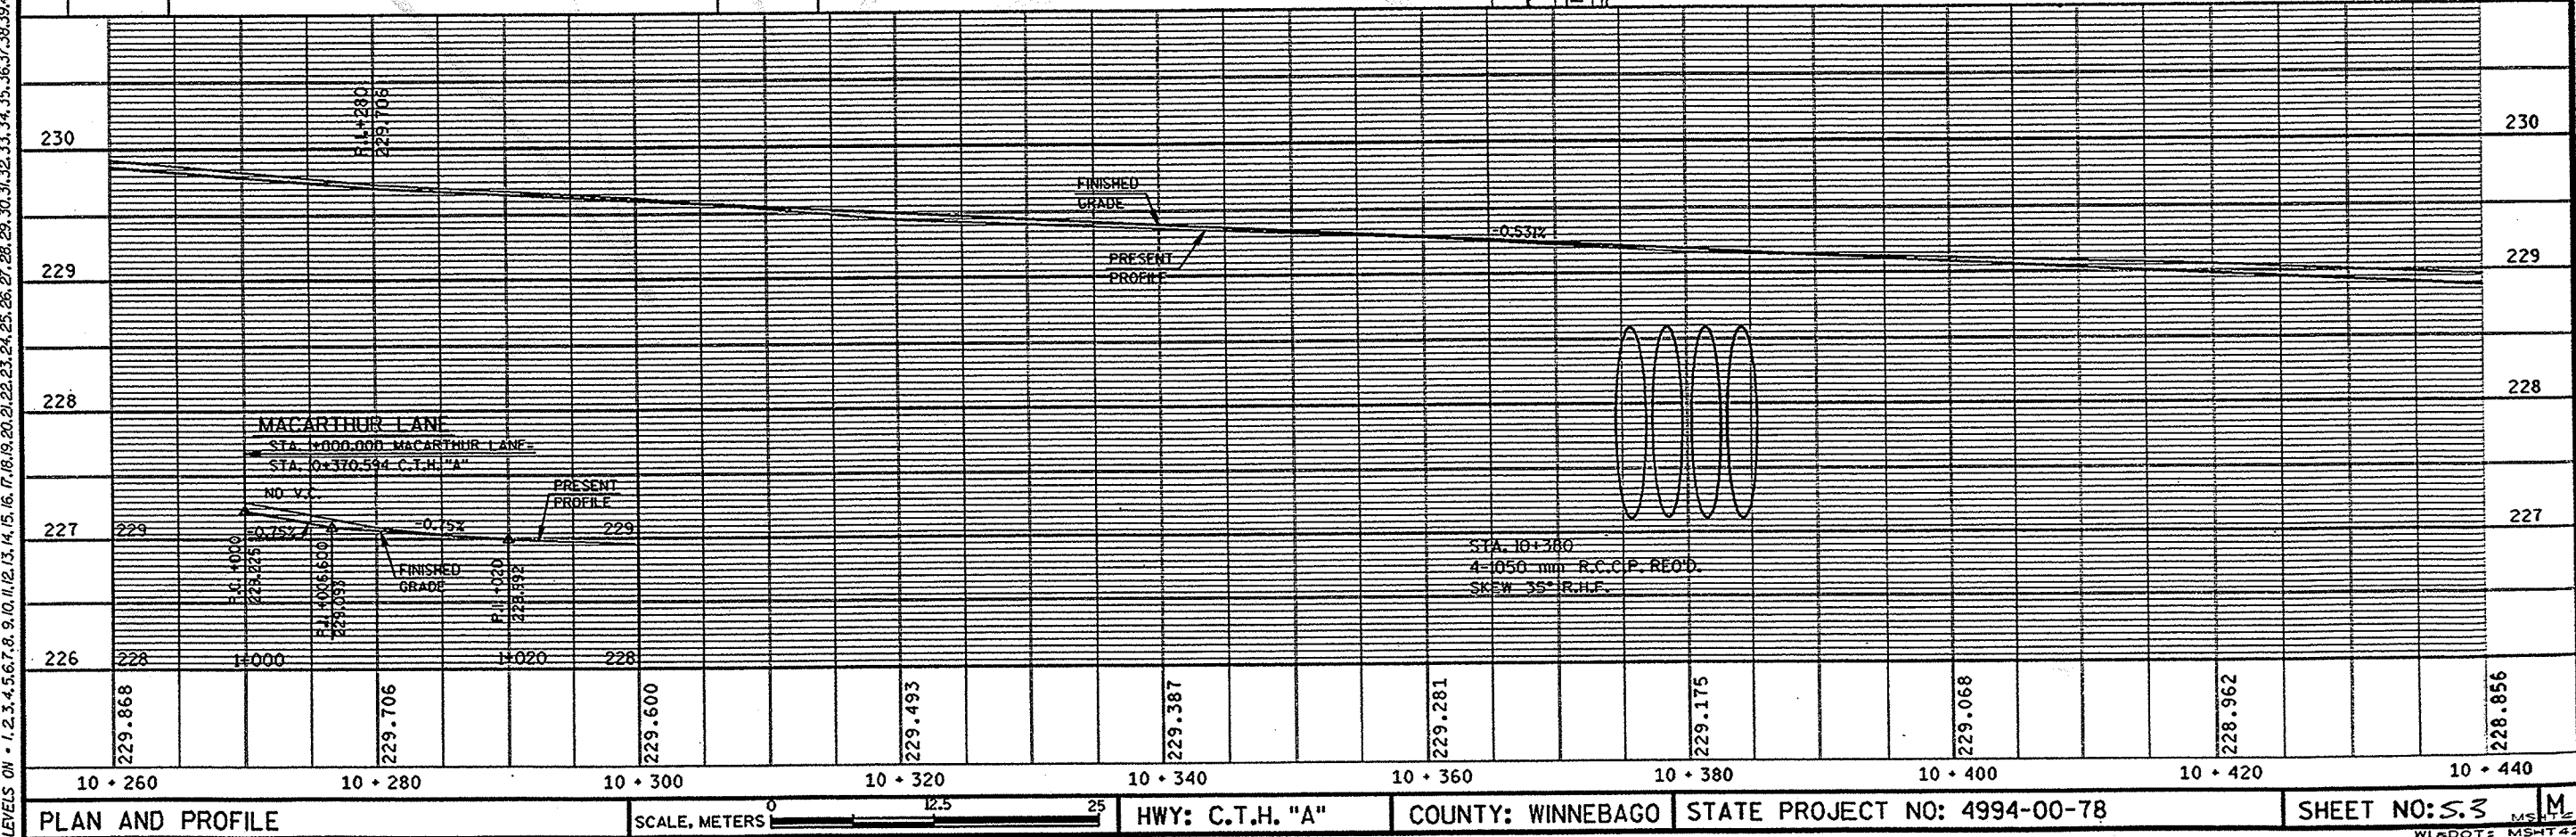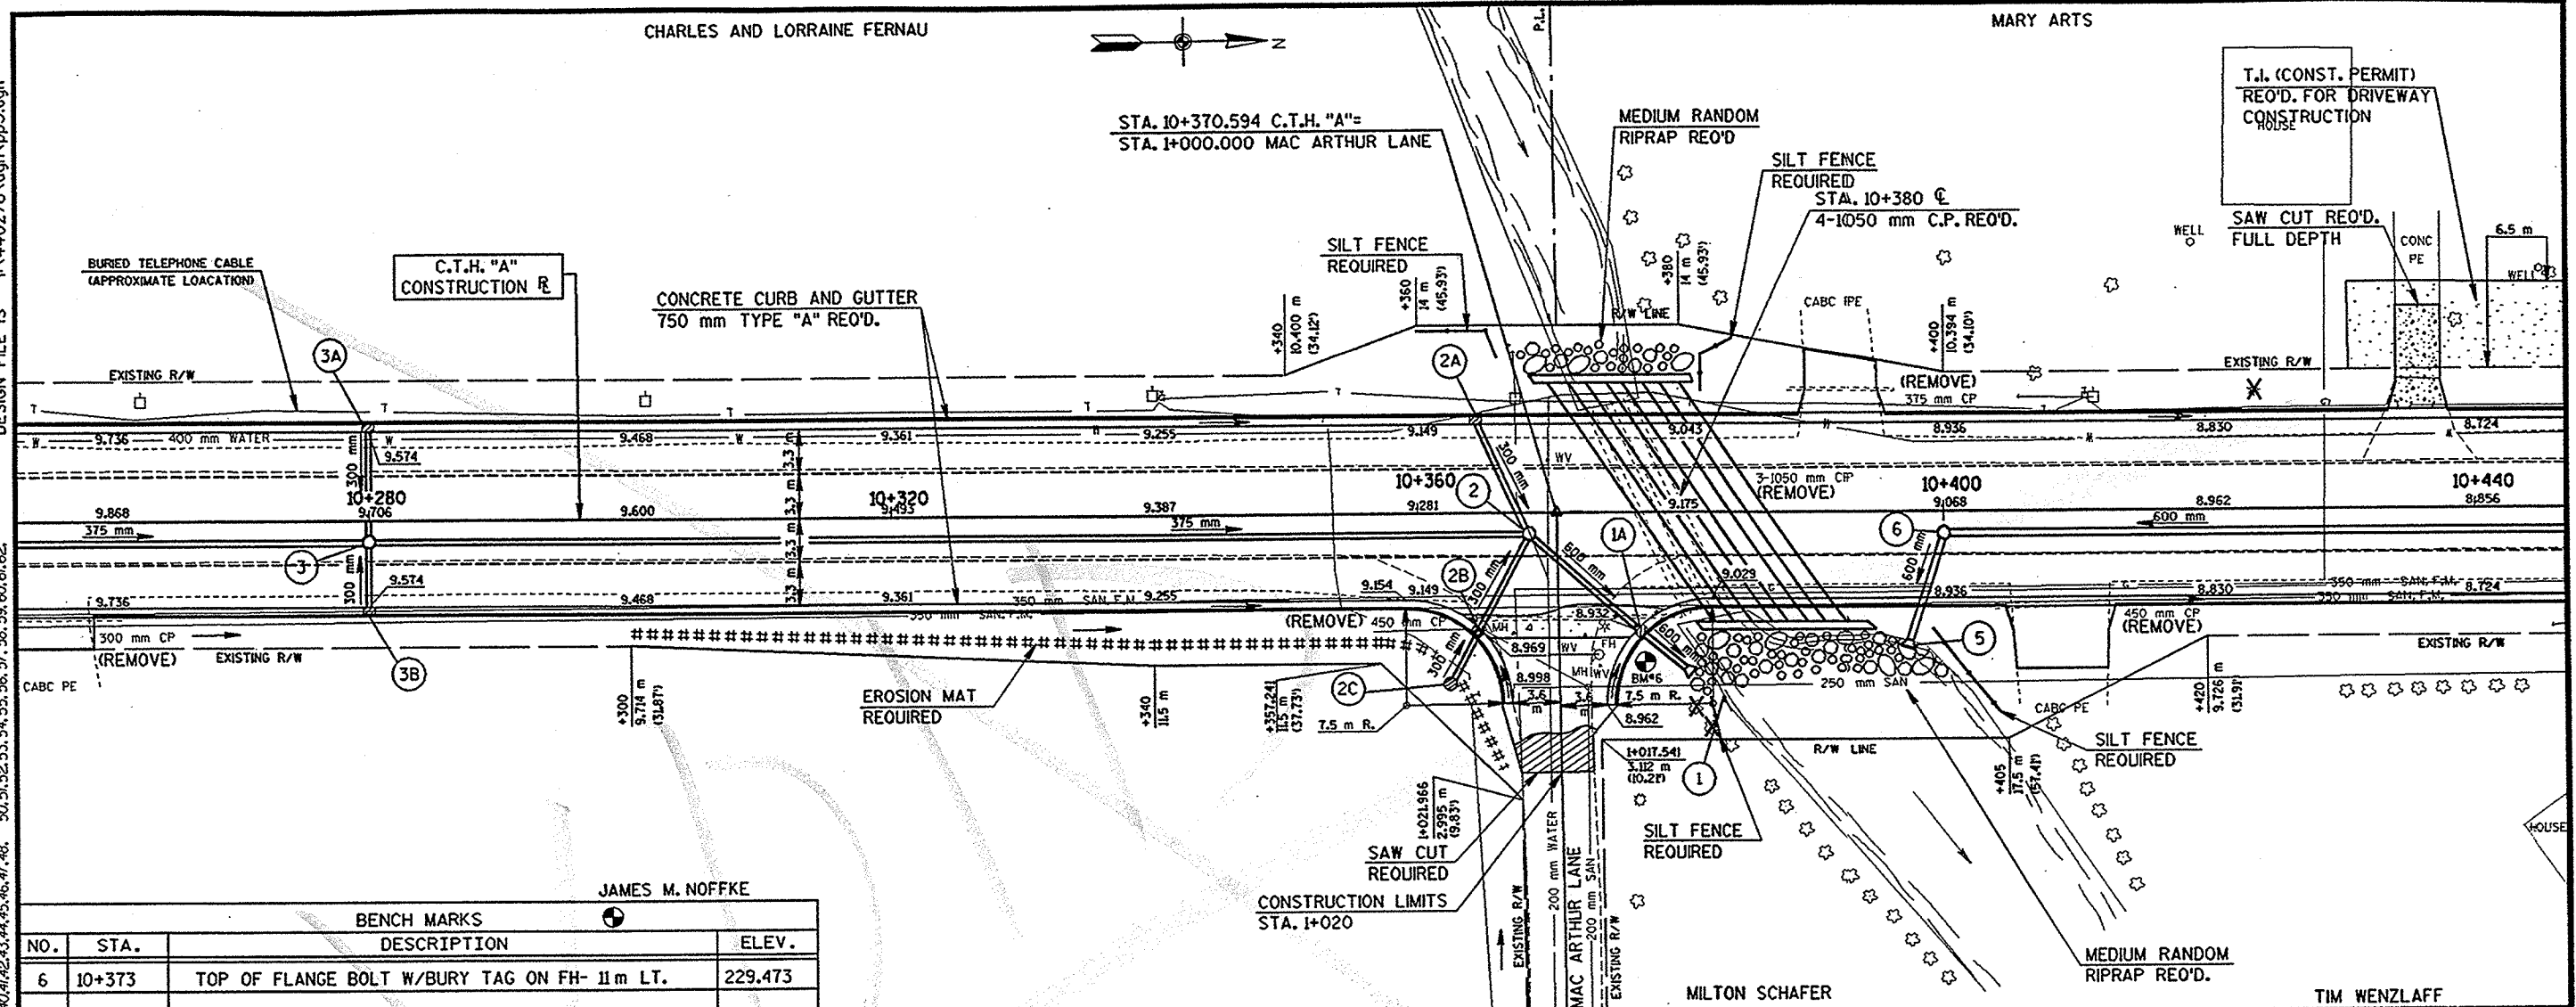


GP 2
 PEN TABLE = #DIOT72Hoser#m80pp.tbl
 DATE OF PLOT = 11/25/98
 PLOT NAME =
 DESIGN FILE IS I:\440278.dgn\pp4.dgn
 FILE NAME =
 SCALE =
 DATE: 02/25/98
 PLOT NAME =
 ORIGINATOR: JPZ
 PROJECT NO: 440278
 LEVELS ON = 1, 2, 3, 48, 50, 51, 52, 53, 54, 55, 56, 57, 58, 59, 60, 61, 62

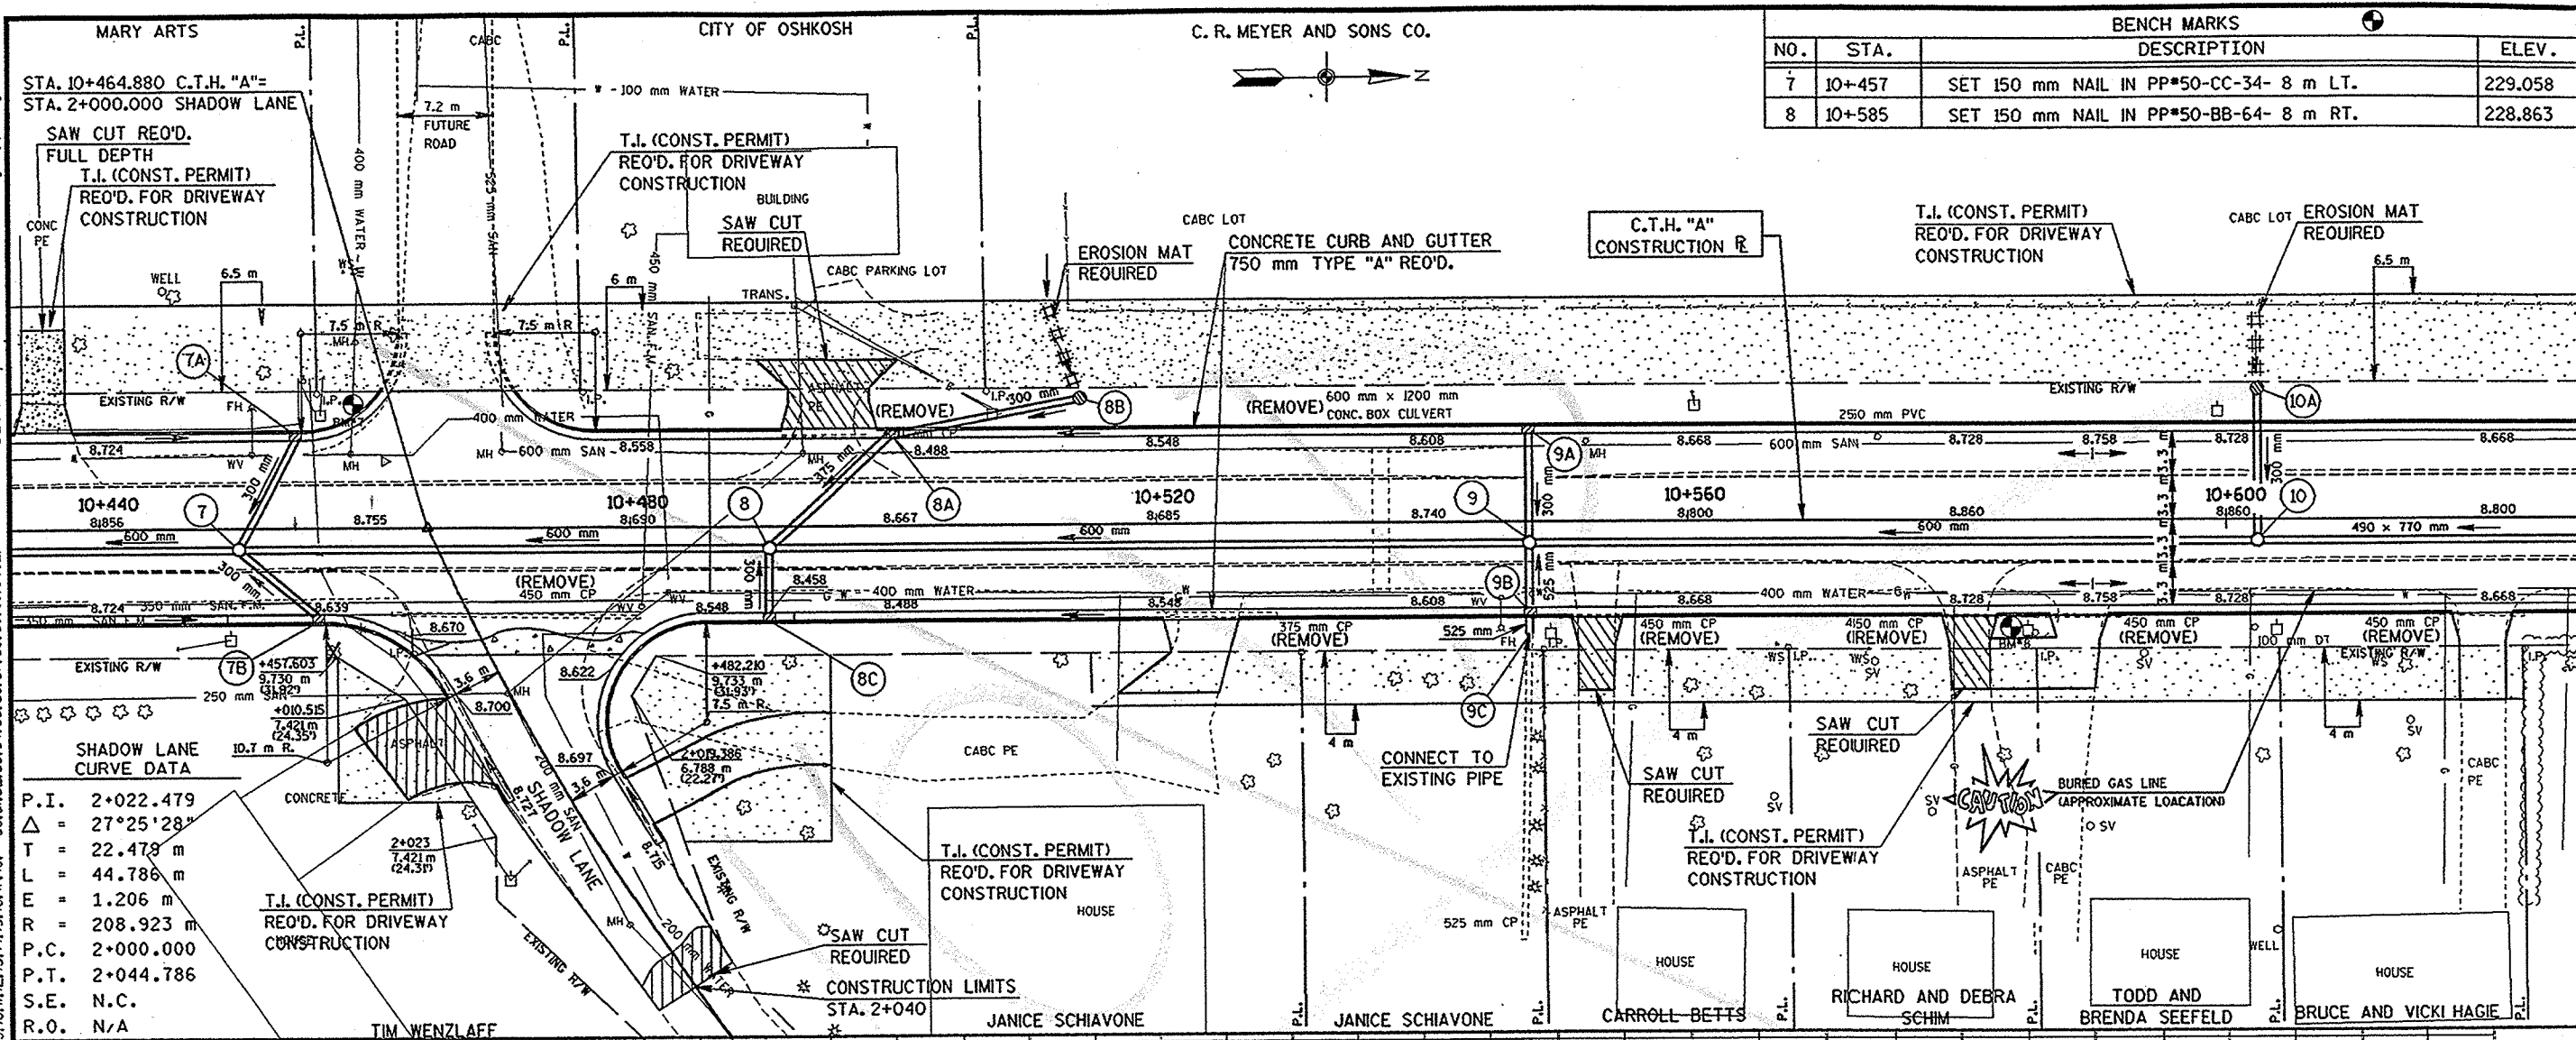

BENCH MARKS			
NO.	STA.	DESCRIPTION	ELEV.
7	10+457	SET 150 mm NAIL IN PP*50-CC-34- 8 m LT.	229.058
8	10+585	SET 150 mm NAIL IN PP*50-BB-64- 8 m RT.	228.863

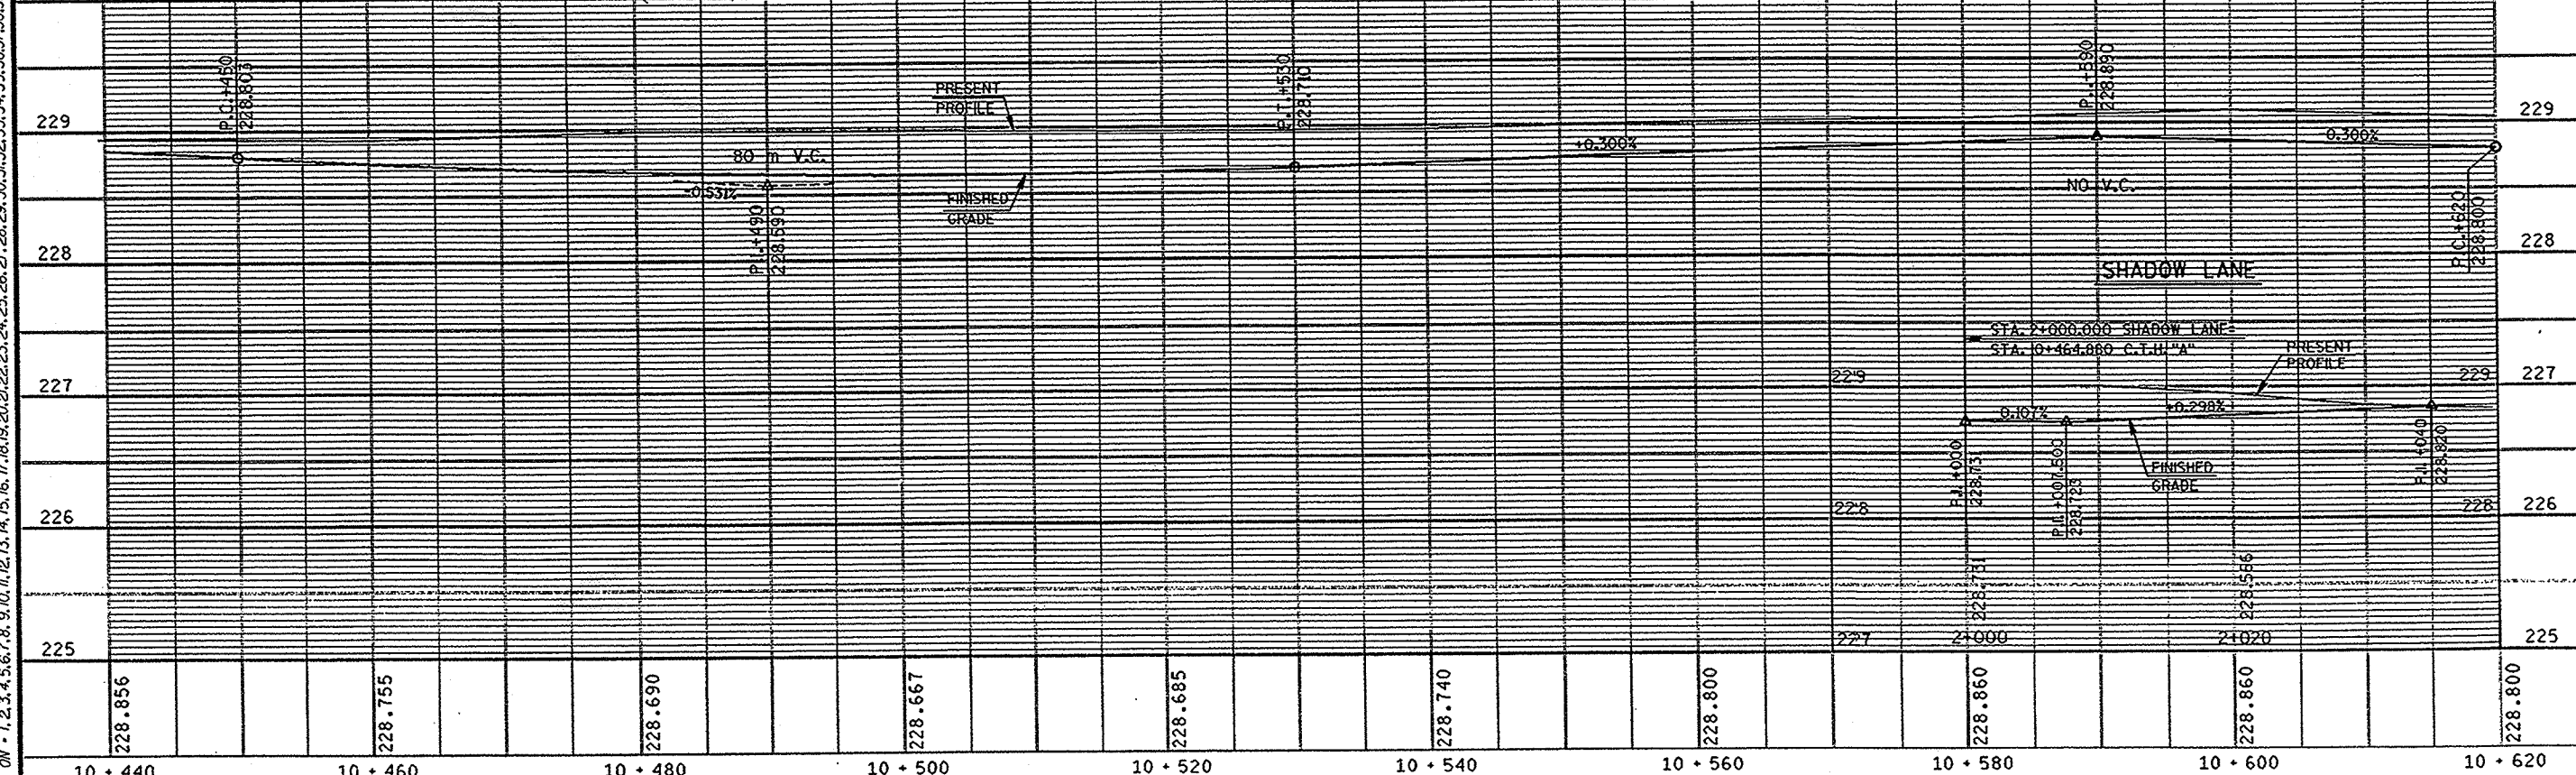

WISDOT: MSHT42

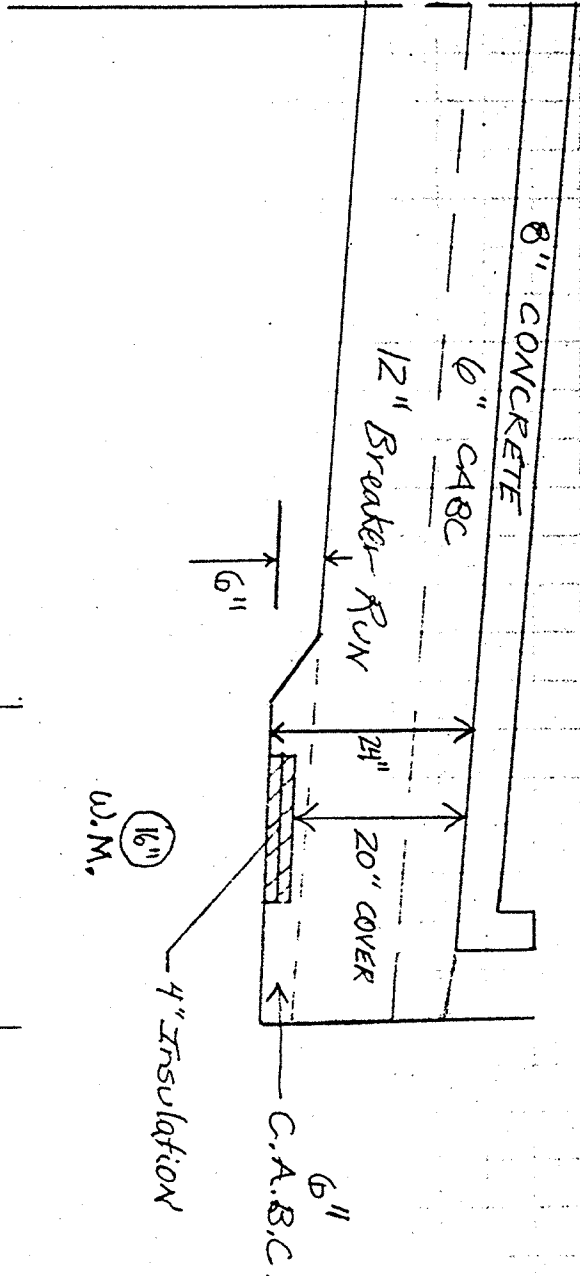

SHADOW LANE - MILLER LANE
STA. 10+500 - STA. 10+640

WATERMAIN INSULATION DETAIL


8/24/00

McMAHON ASSOCIATES, INC.

ENGINEERS ■ ARCHITECTS
 PROJ. MGRS. ■ SURVEYORS


1445 McMAHON DRIVE, P.O. BOX 1025
 NEENAH, WI 54956/57-1025
 TEL: 920-751-4200 FAX: 920-751-4284
 952 SOUTH STATE ROAD 2
 VALPARAISO, IN 46383
 TEL: 219-462-7743 FAX: 219-464-8248
 6813 NORTH SECOND STREET
 MACHESNEY PARK, IL 61115
 TEL: 815-636-9590 FAX: 815-636-9591

DATE _____
 CLIENT _____
 PROJECT _____
 PROJECT No. _____
 BY _____ PAGE _____ OF _____

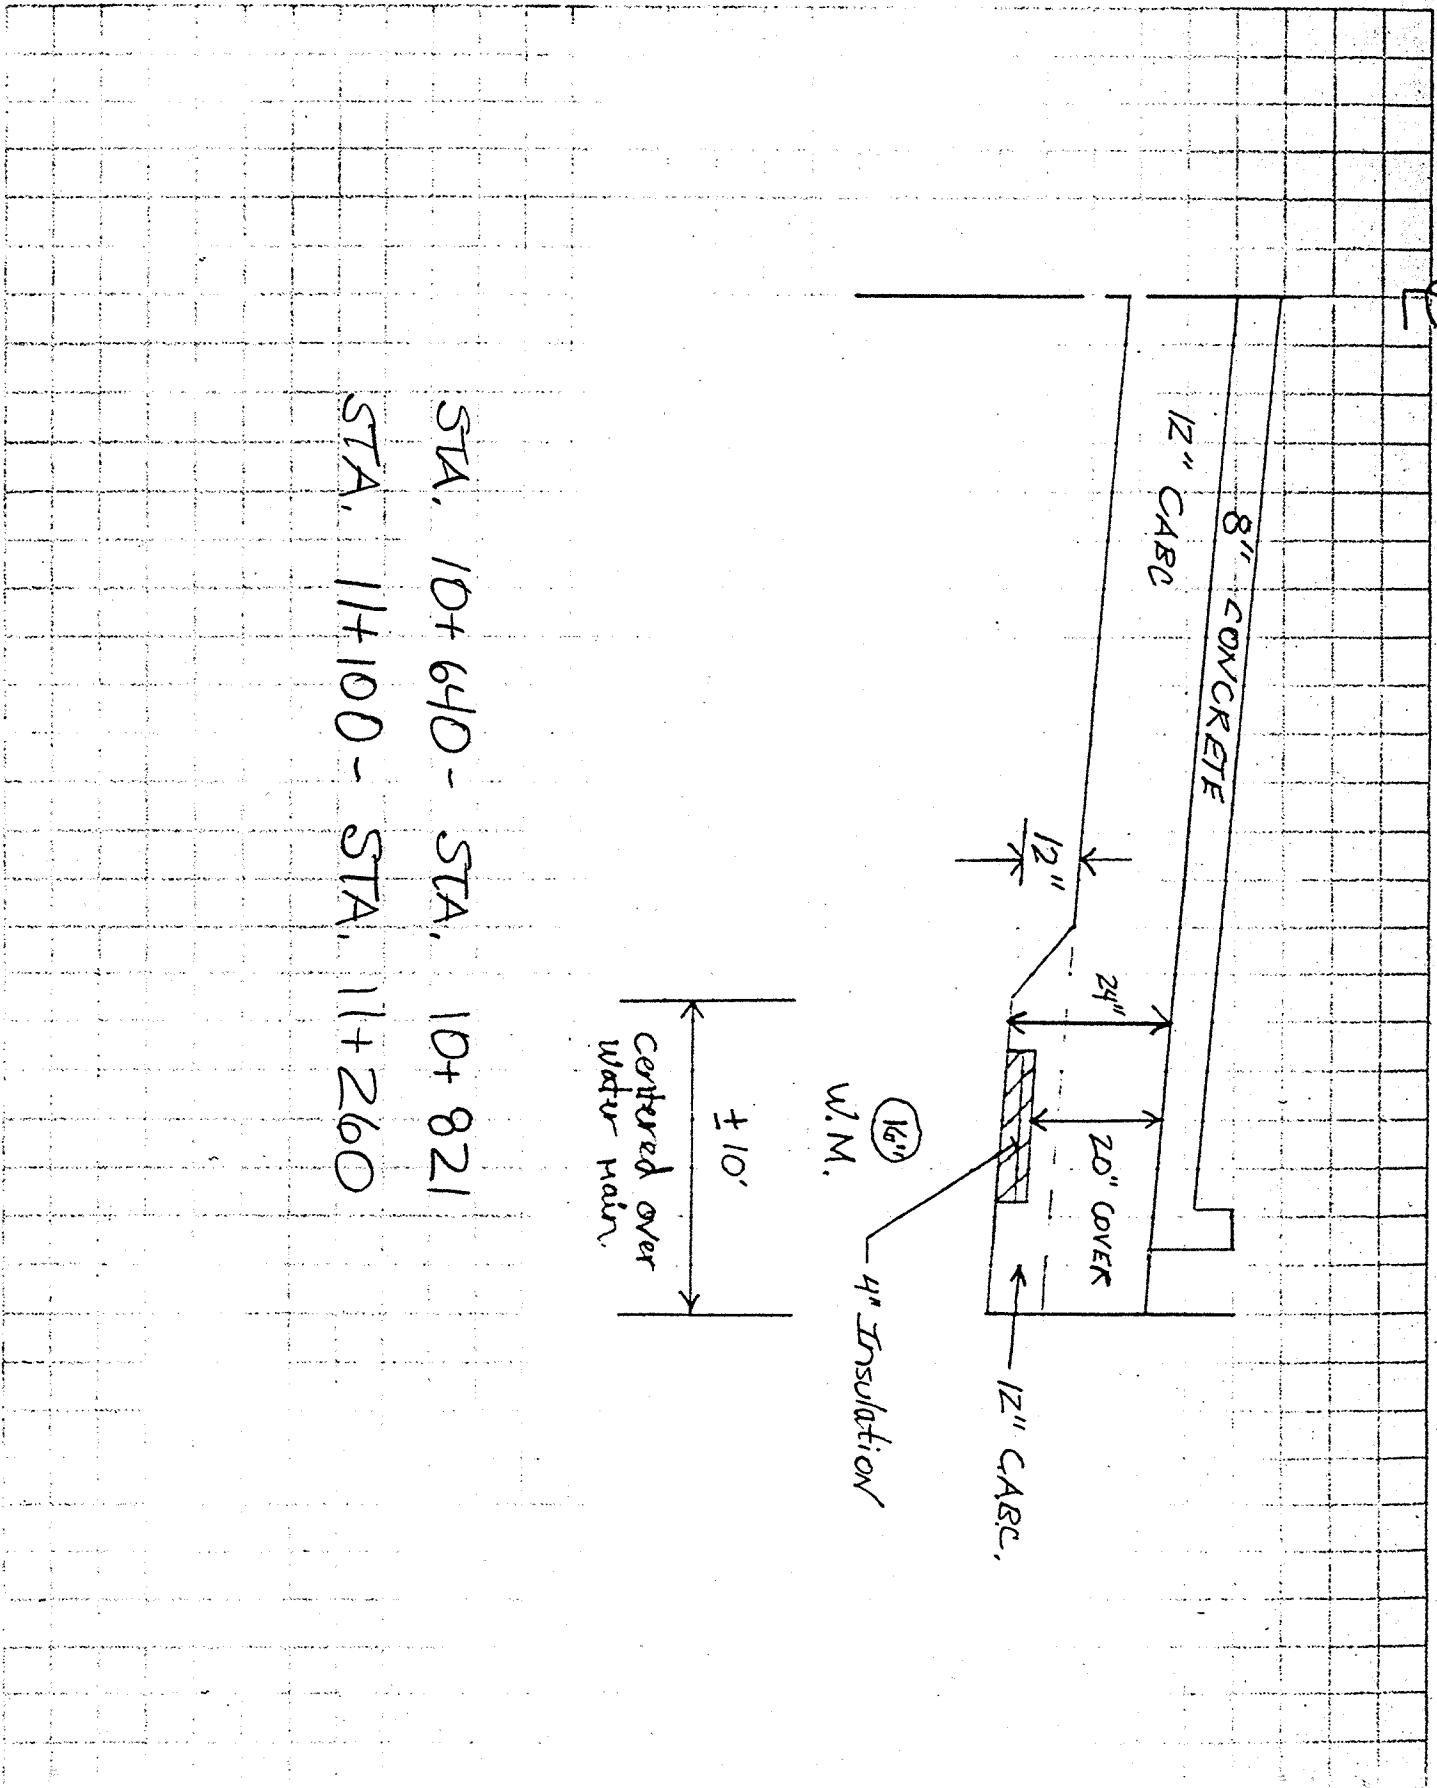


STA. 10+640 - STA. 10+821
 STA. 11+100 - STA. 11+260

FILE NAME: DATE: 02/25/98 PLOT NAME: SCALE: ORIGINATOR: JPZ PROJECT NO: 440278 LEVELS ON: 1, 2, 3, 99, 100


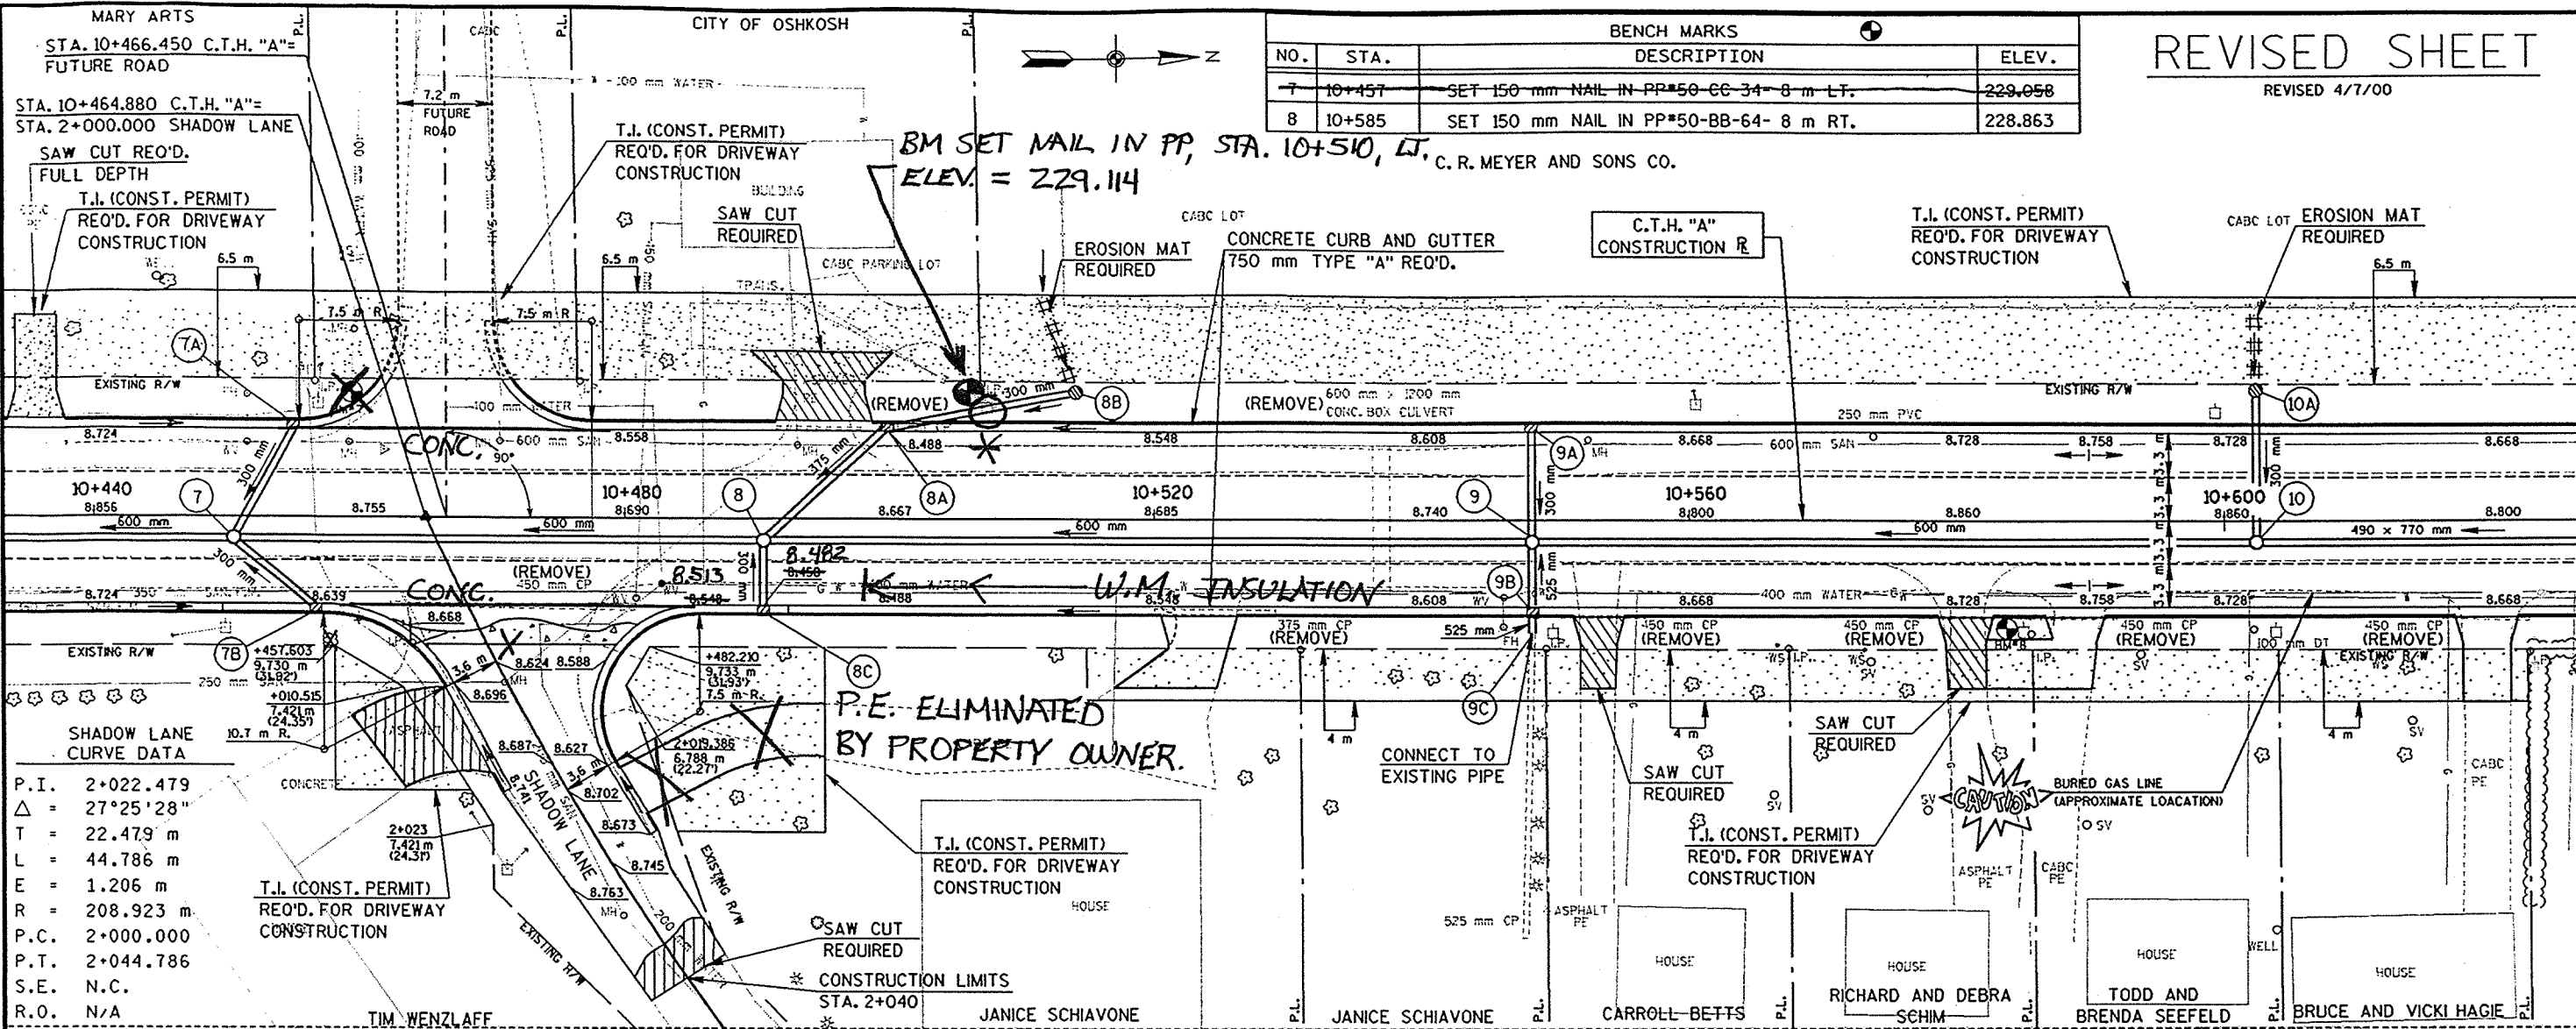


BENCH MARKS			
NO.	STA.	DESCRIPTION	ELEV.
7	10+457	SET 150 mm NAIL IN PP#50-CC-34-8 m LT.	229.058
8	10+585	SET 150 mm NAIL IN PP#50-BB-64-8 m RT.	228.863


REVISED SHEET
REVISED 4/7/00

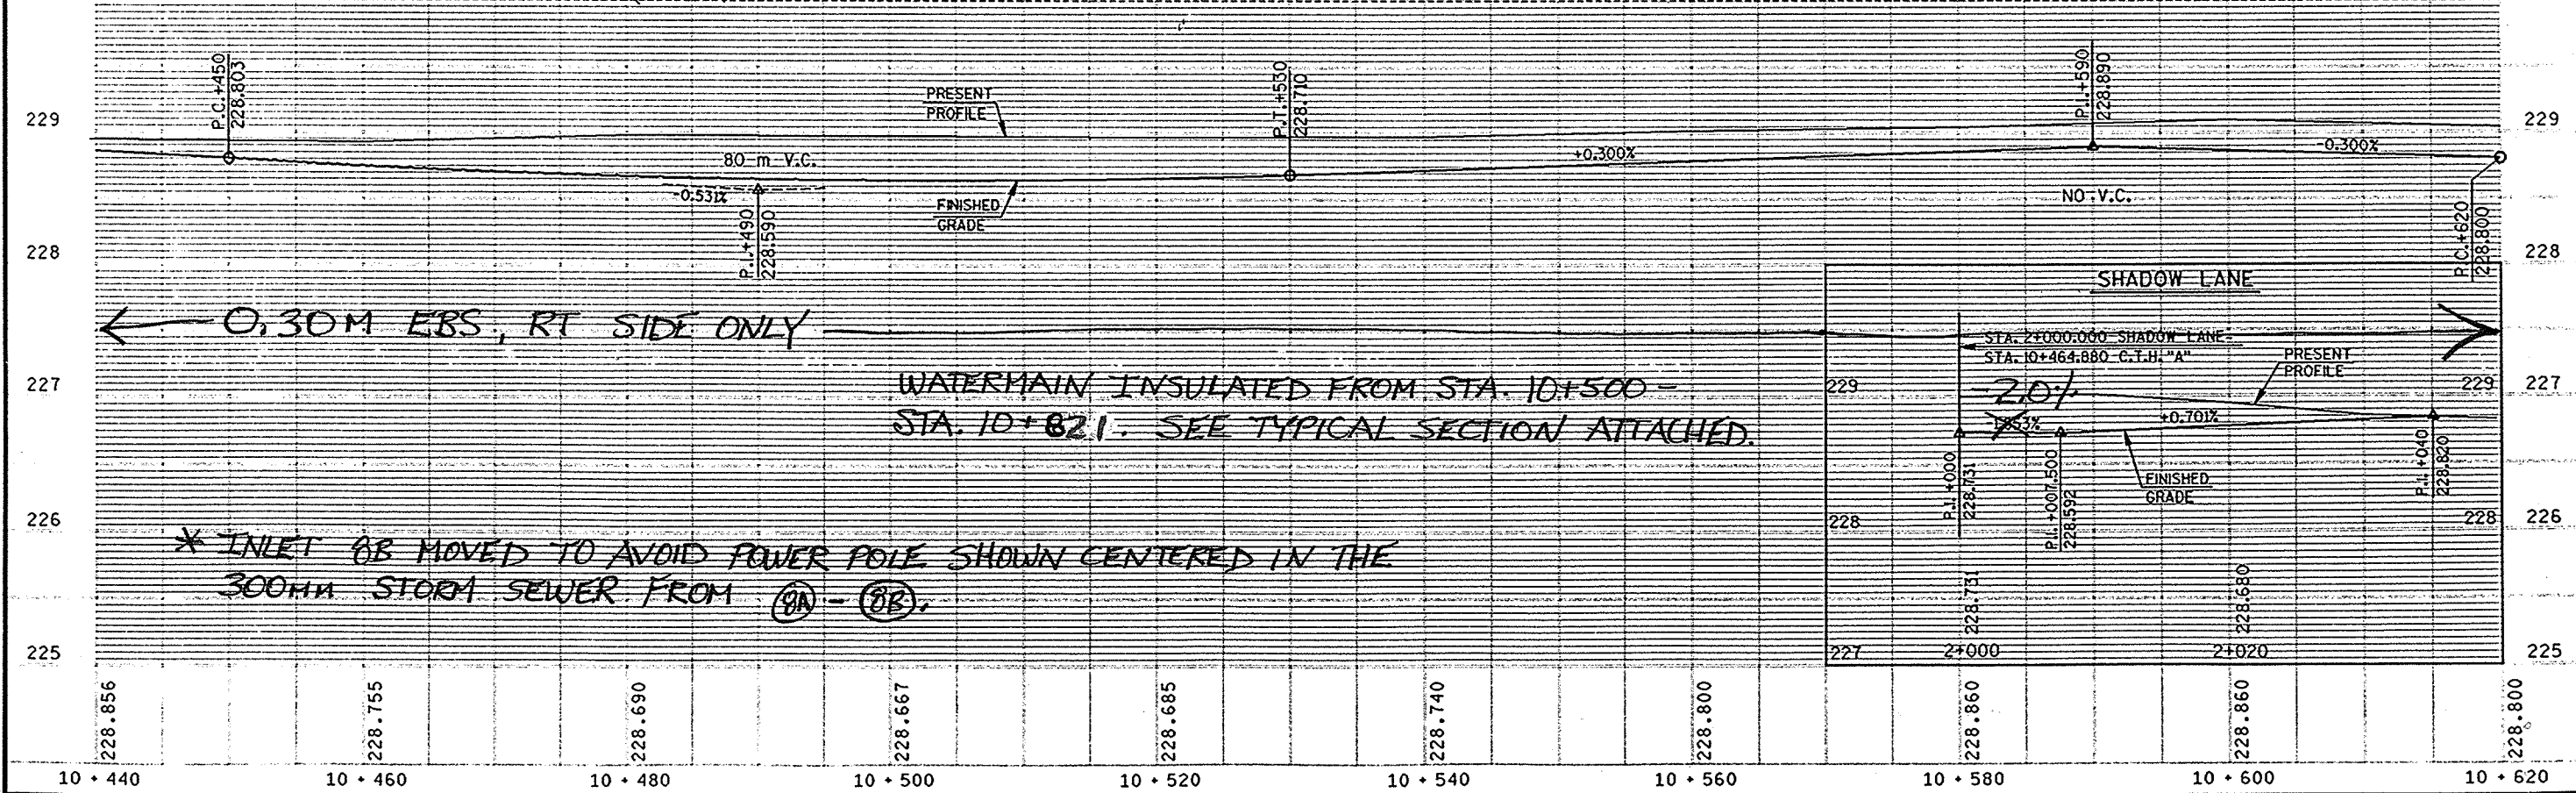


ORIGINATOR: JPZ
 PROJECT NO: 440278
 LEVELS ON - 1, 2, 3, 48, 50, 51, 52, 53, 54, 55, 56, 57, 58, 59, 60, 61, 62
 DATE: 02/25/98
 FILE NAME: PPS,PRF
 SCALE:
 PLOT NAME: PPS,PRF
 CB 2
 PEN TABLE = #plot7210ser+inv80pp.tbl
 DATE OF PLOT = 11/25/98
 PLOT NA
 DESIGN FILE IS I:\440278.dgn\pp5.dgn

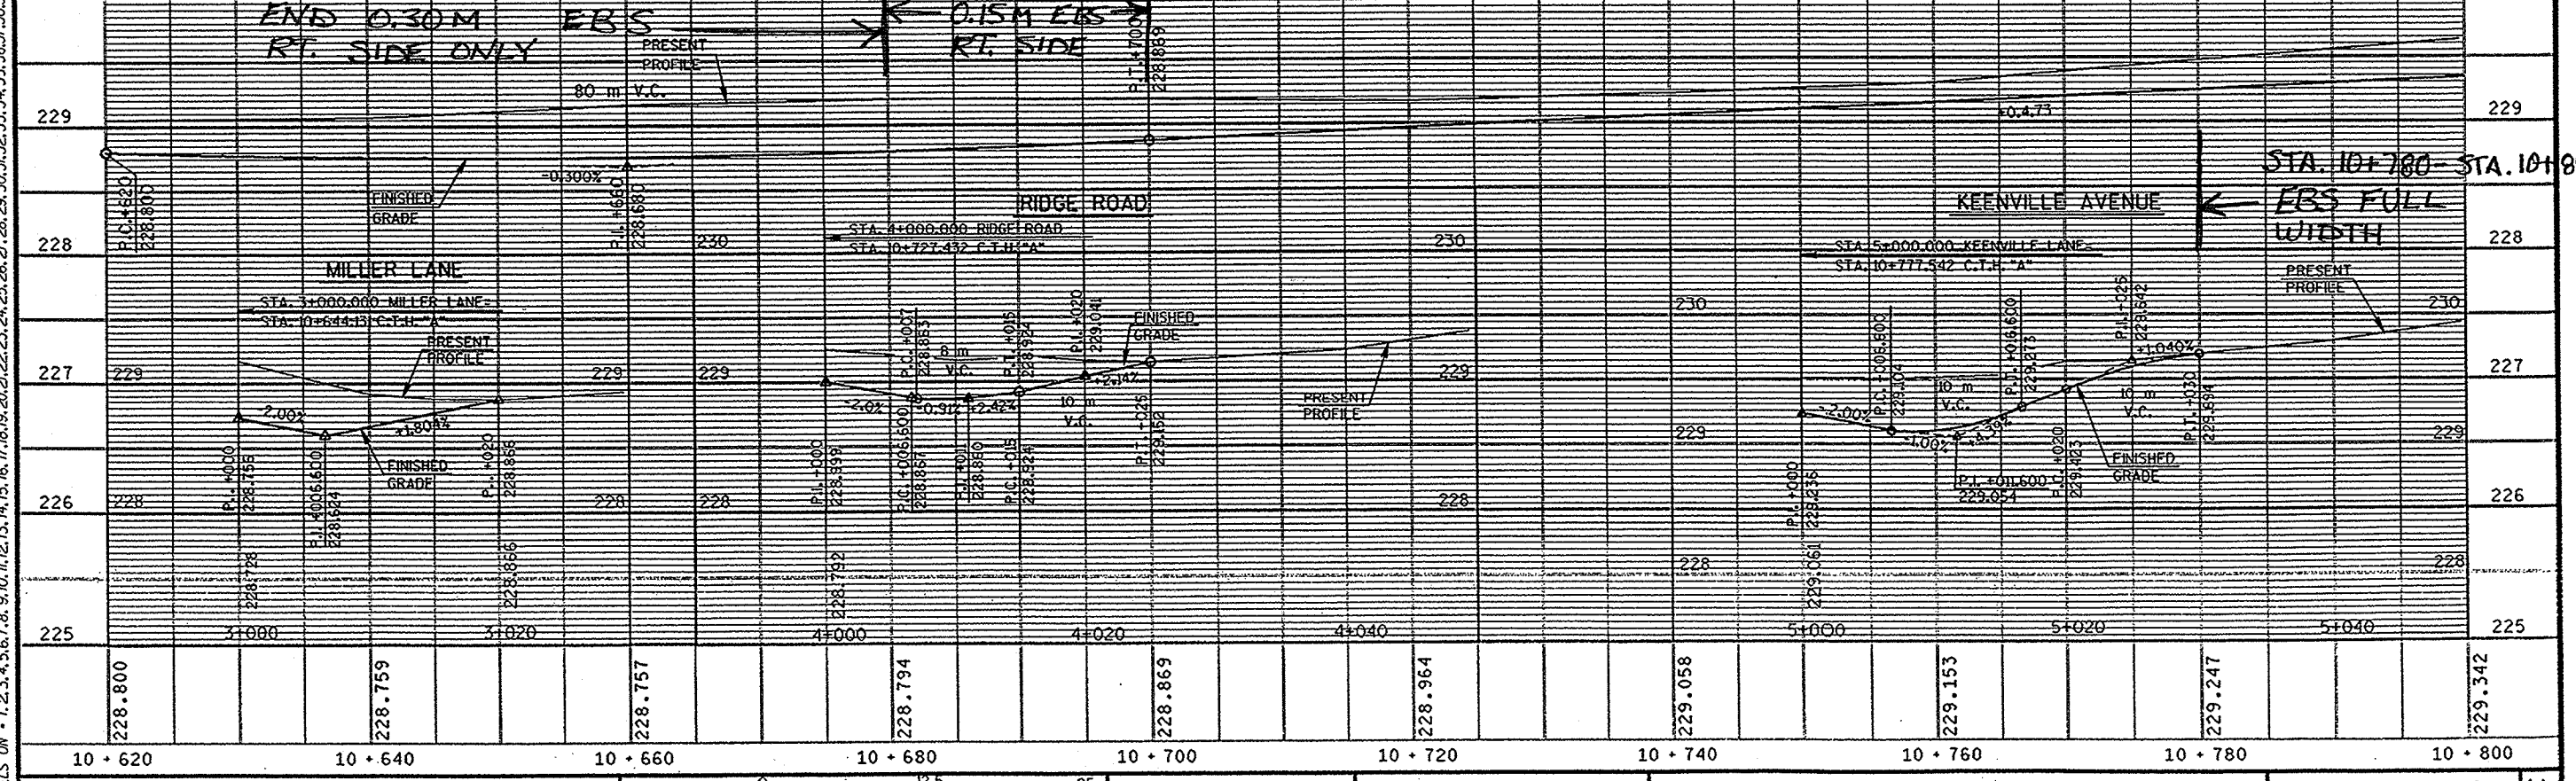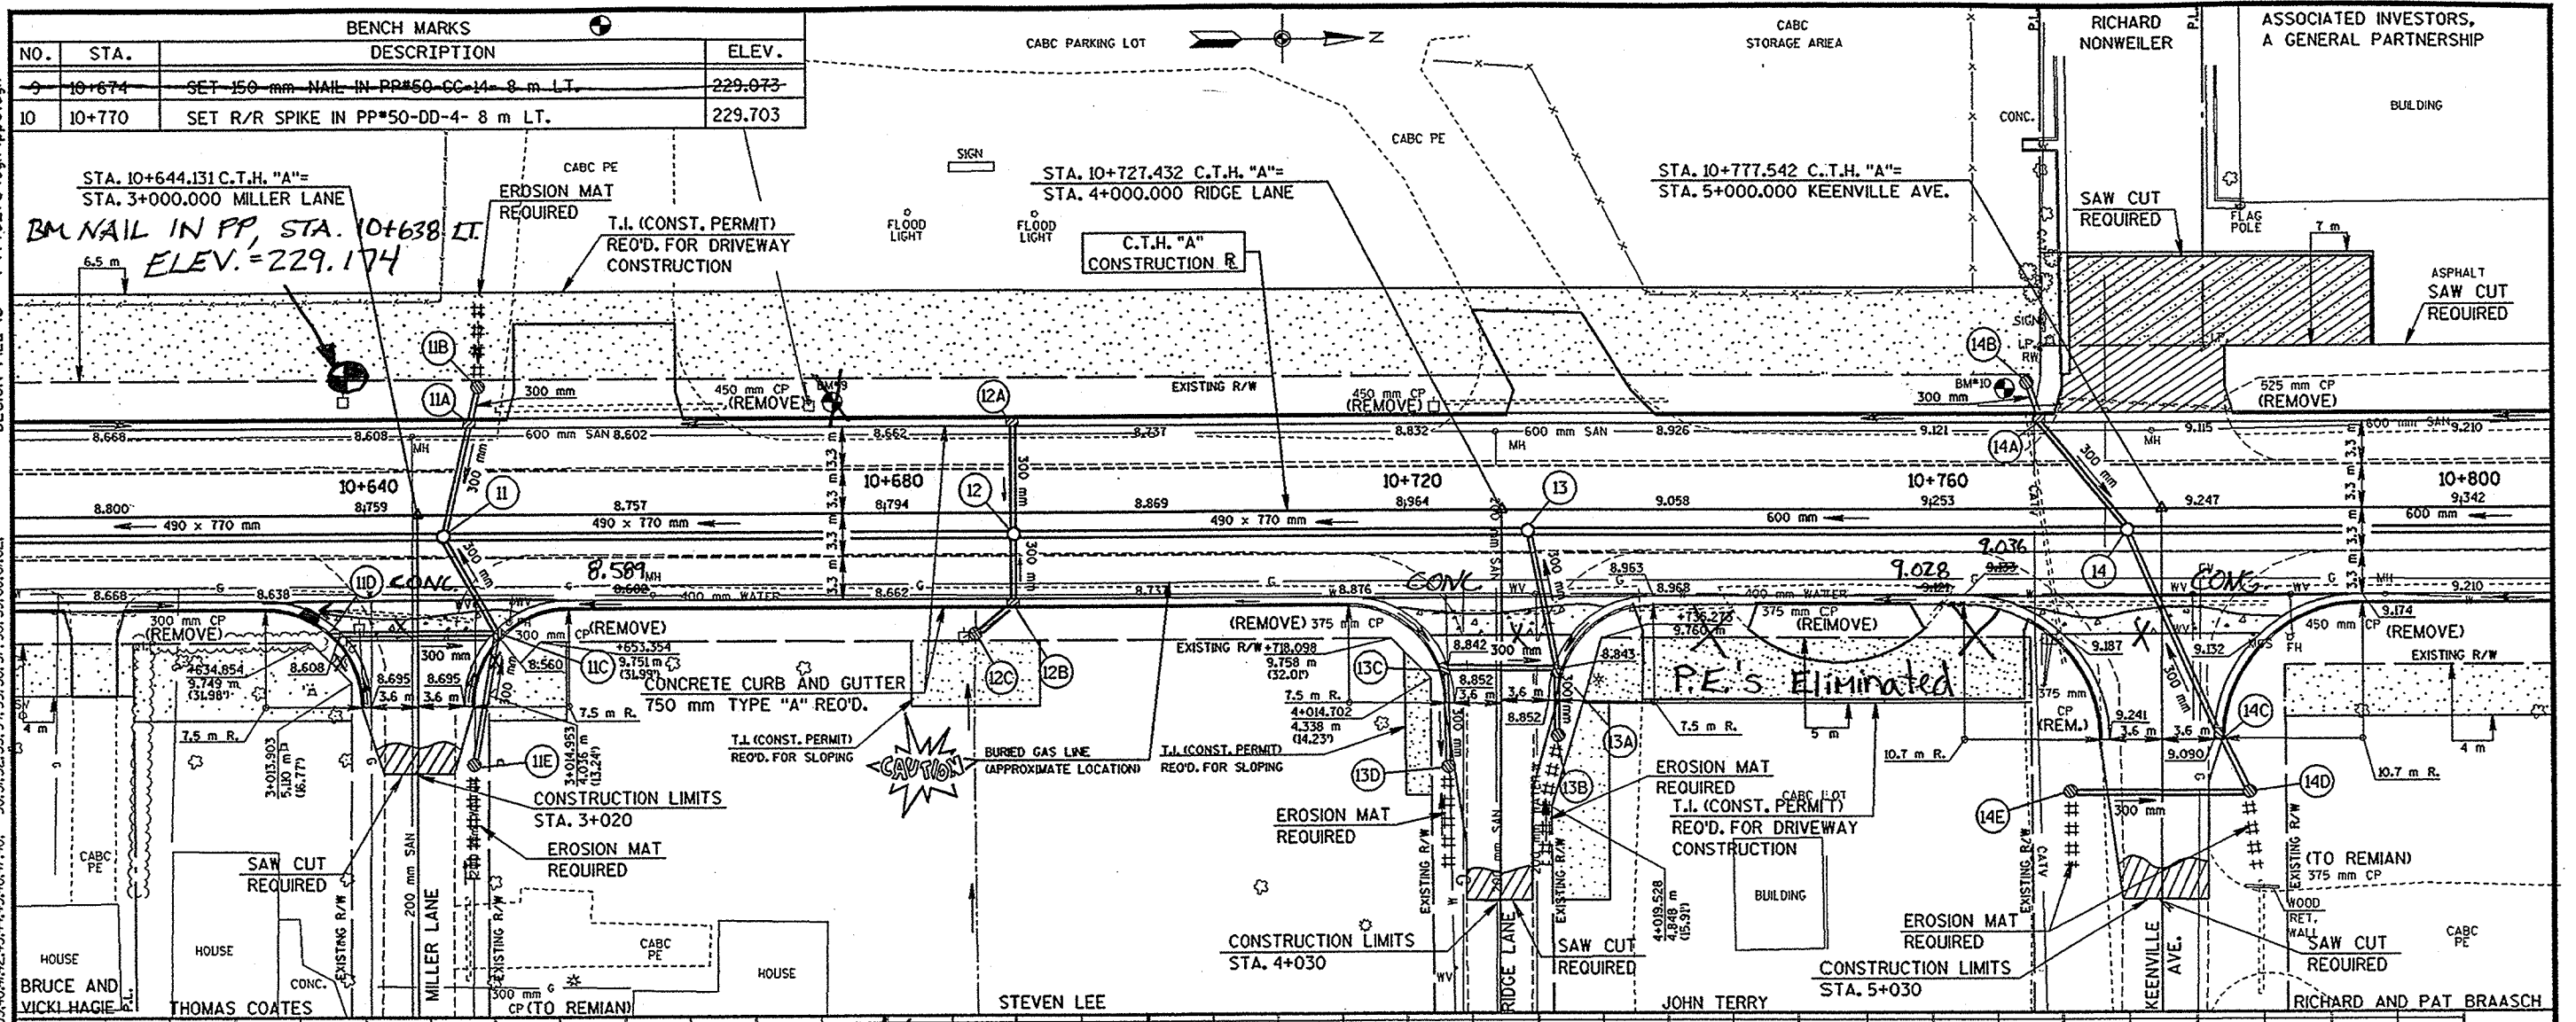


ORIGINATOR: JPZ
 PROJECT NO: 440278
 LEVELS ON: 1, 2, 3, 48, 50, 51, 52, 53, 54, 55, 56, 57, 59, 60, 61, 62
 FILE NAME: DATE: 02/25/98
 PLOT NAME: PP6.PRF
 SCALE: 1:25
 PEN TABLE = #plot72+user+mv80pp.tbl
 DATE OF PLOT = 11/25/98
 PLOT NA
 DESIGN FILE IS I:\440278\dgn\pp6.dgn

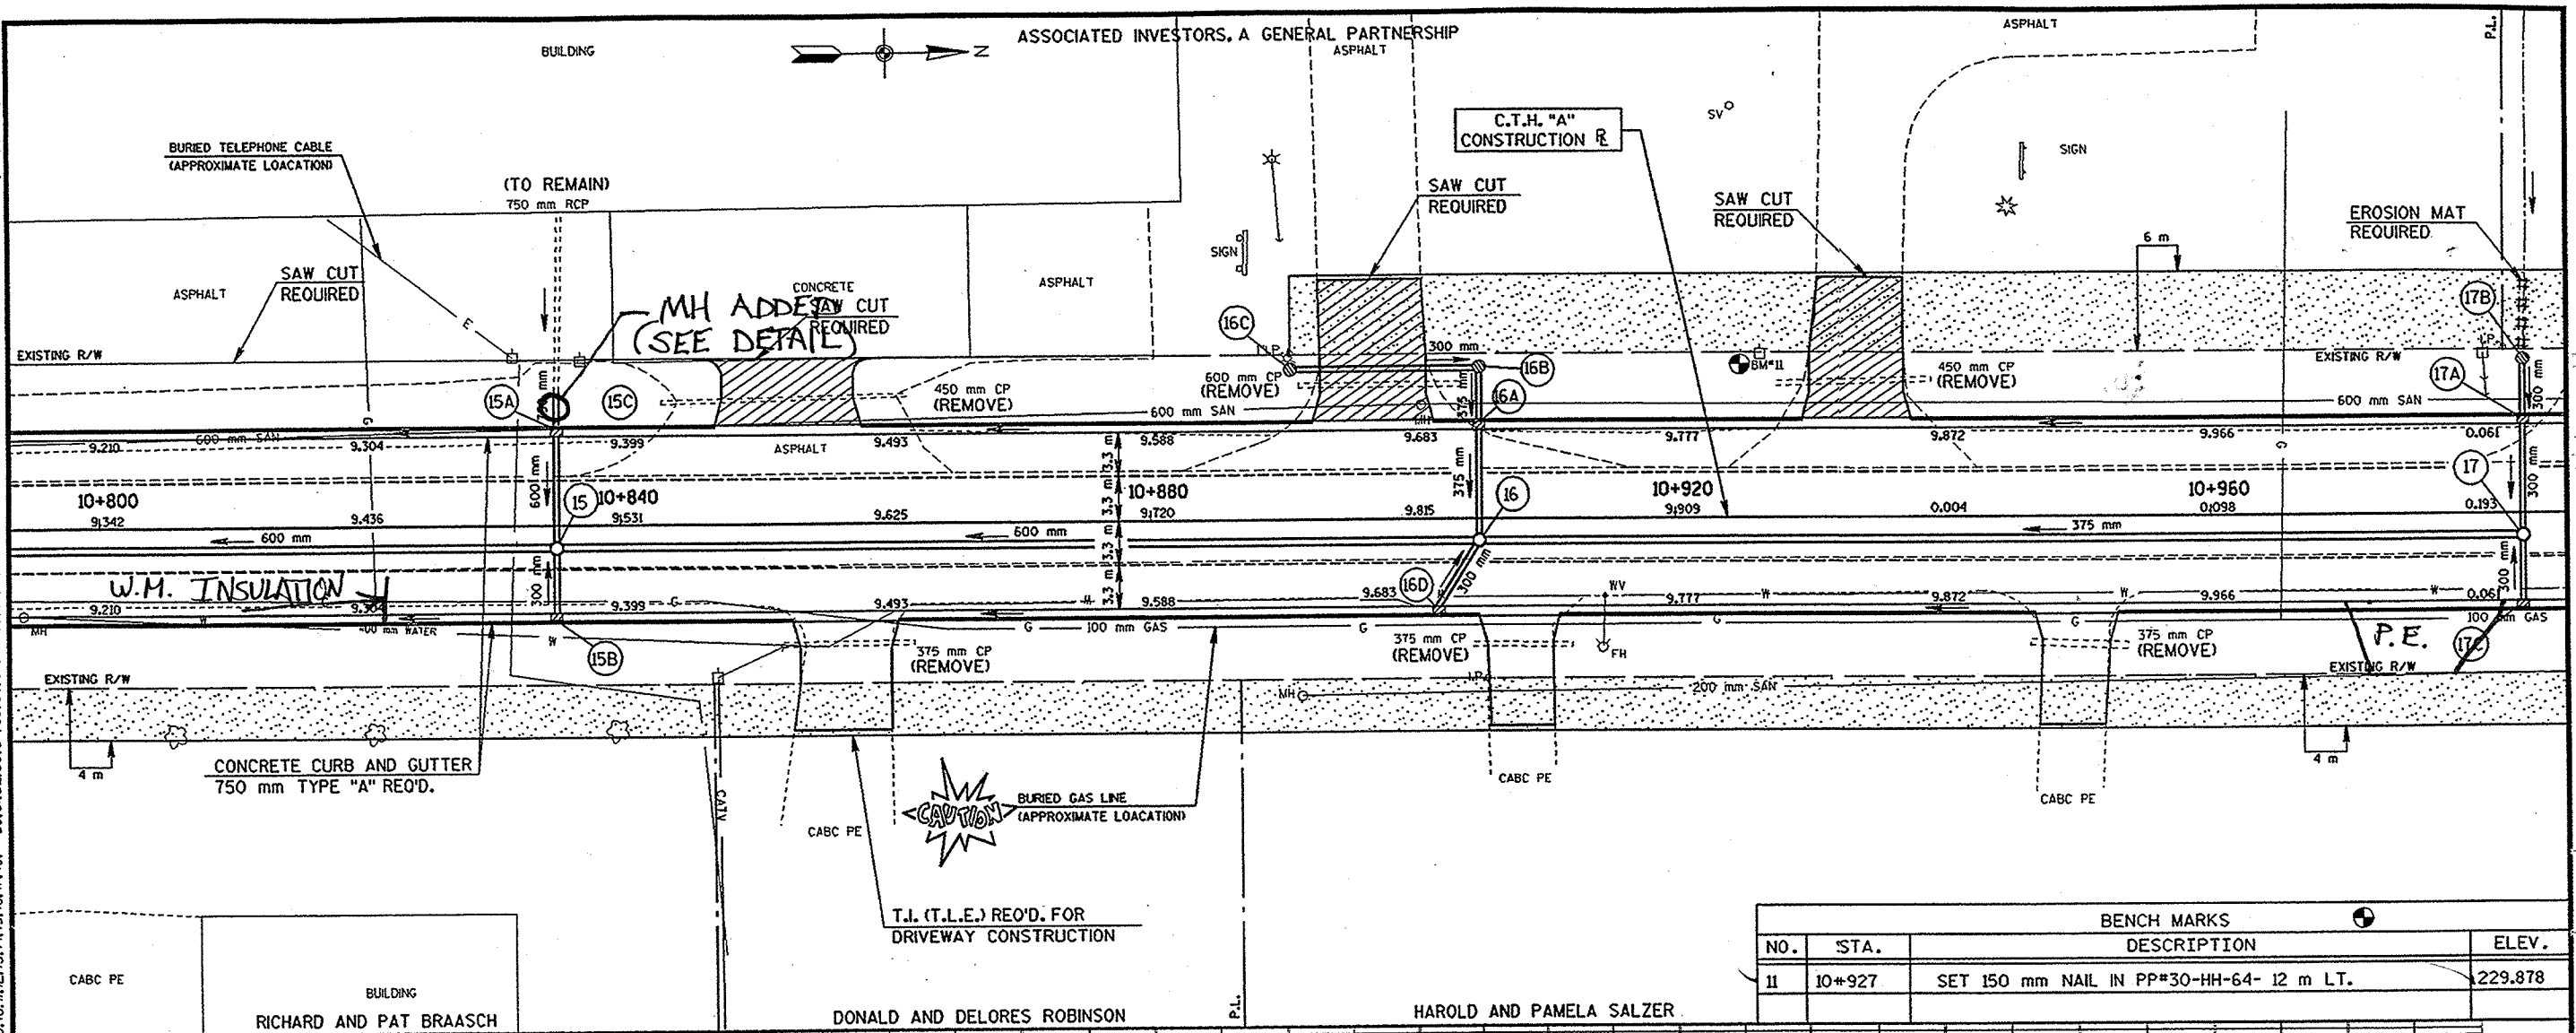


BENCH MARKS			
NO.	STA.	DESCRIPTION	ELEV.
11	10+927	SET 150 mm NAIL IN PP#30-HH-64- 12 m LT.	229.878

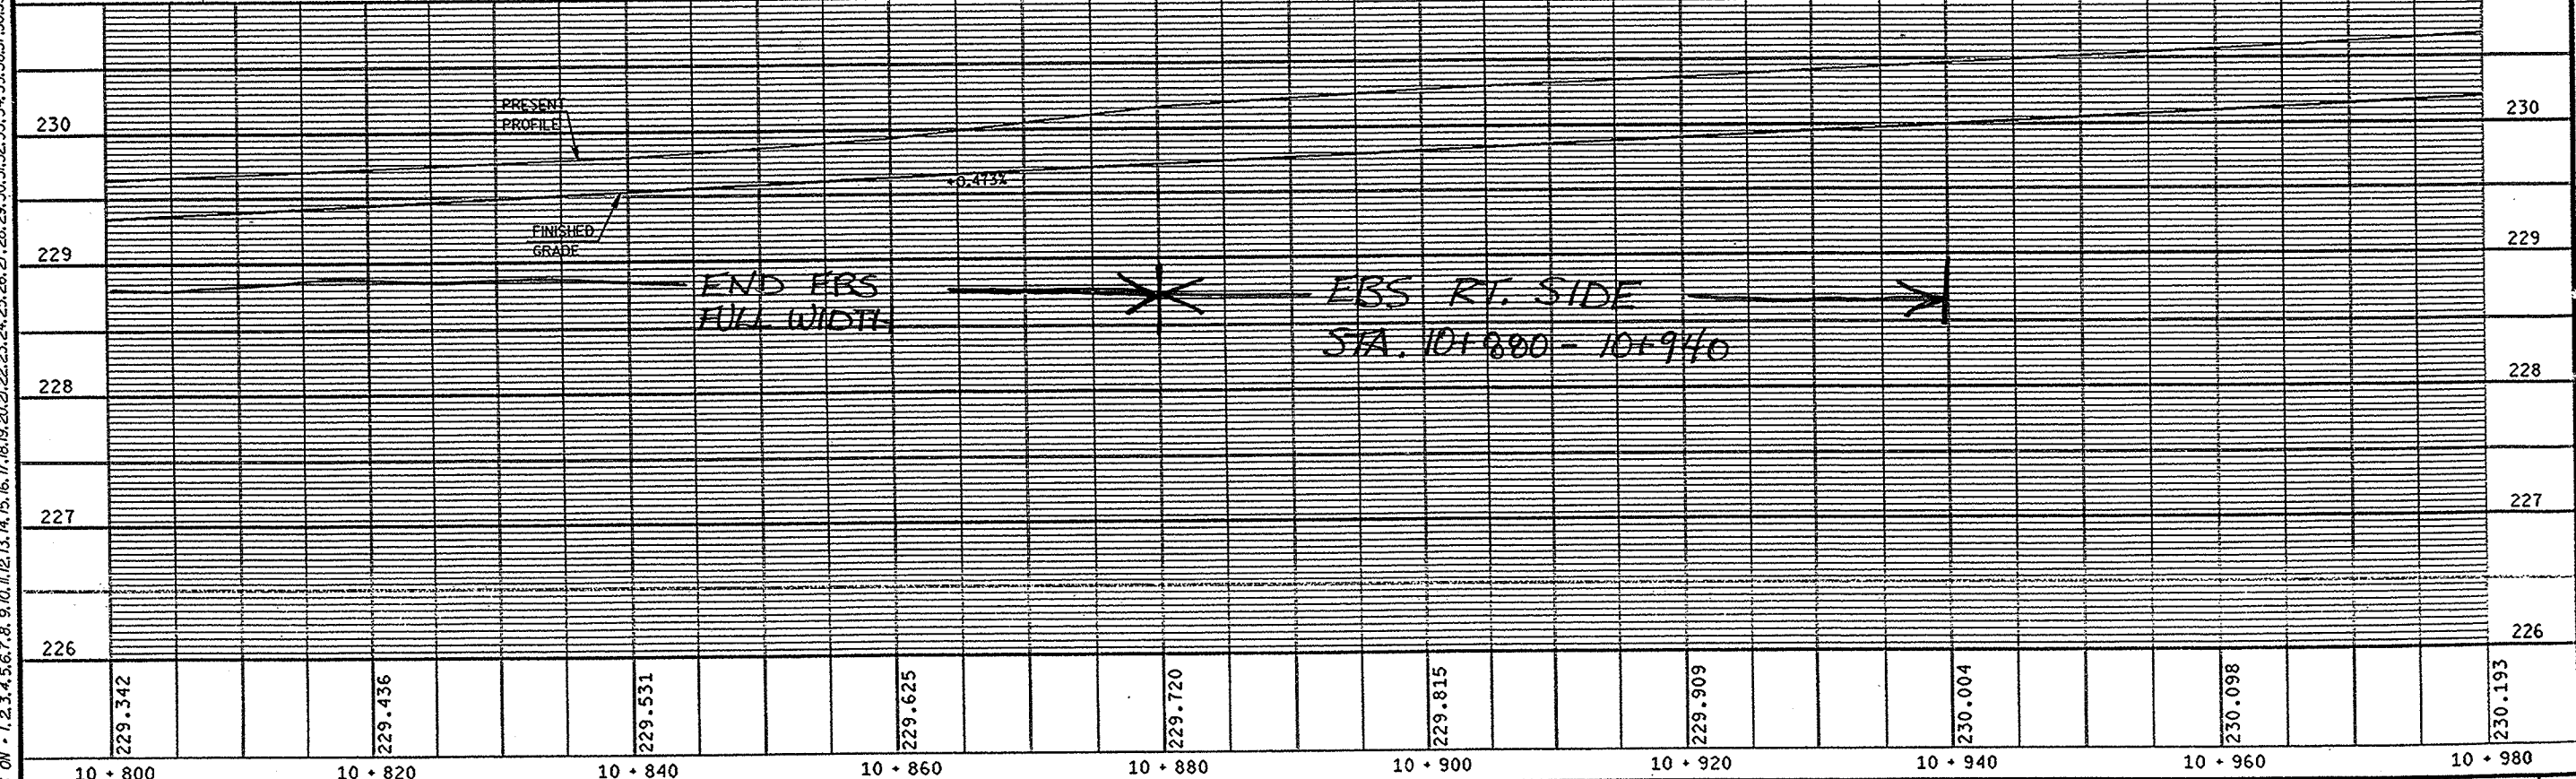

ORIGINATOR: JPZ
 PROJECT NO: 440278
 DATE: 02/25/98
 FILE NAME: PP6.REF
 PLOT NAME: PP6.REF
 SCALE: 1:12.5
 LEVELS ON: 1, 2, 3, 48, 50, 51, 52, 53, 54, 55, 56, 57, 58, 59, 60, 61, 62
 PEN TABLE = #plot72#user#mv80pp.tbl
 DATE OF PLOT = 11/25/98
 PLOT NA
 DESIGN FILE IS I:\440278.dgn\pp7.dgn

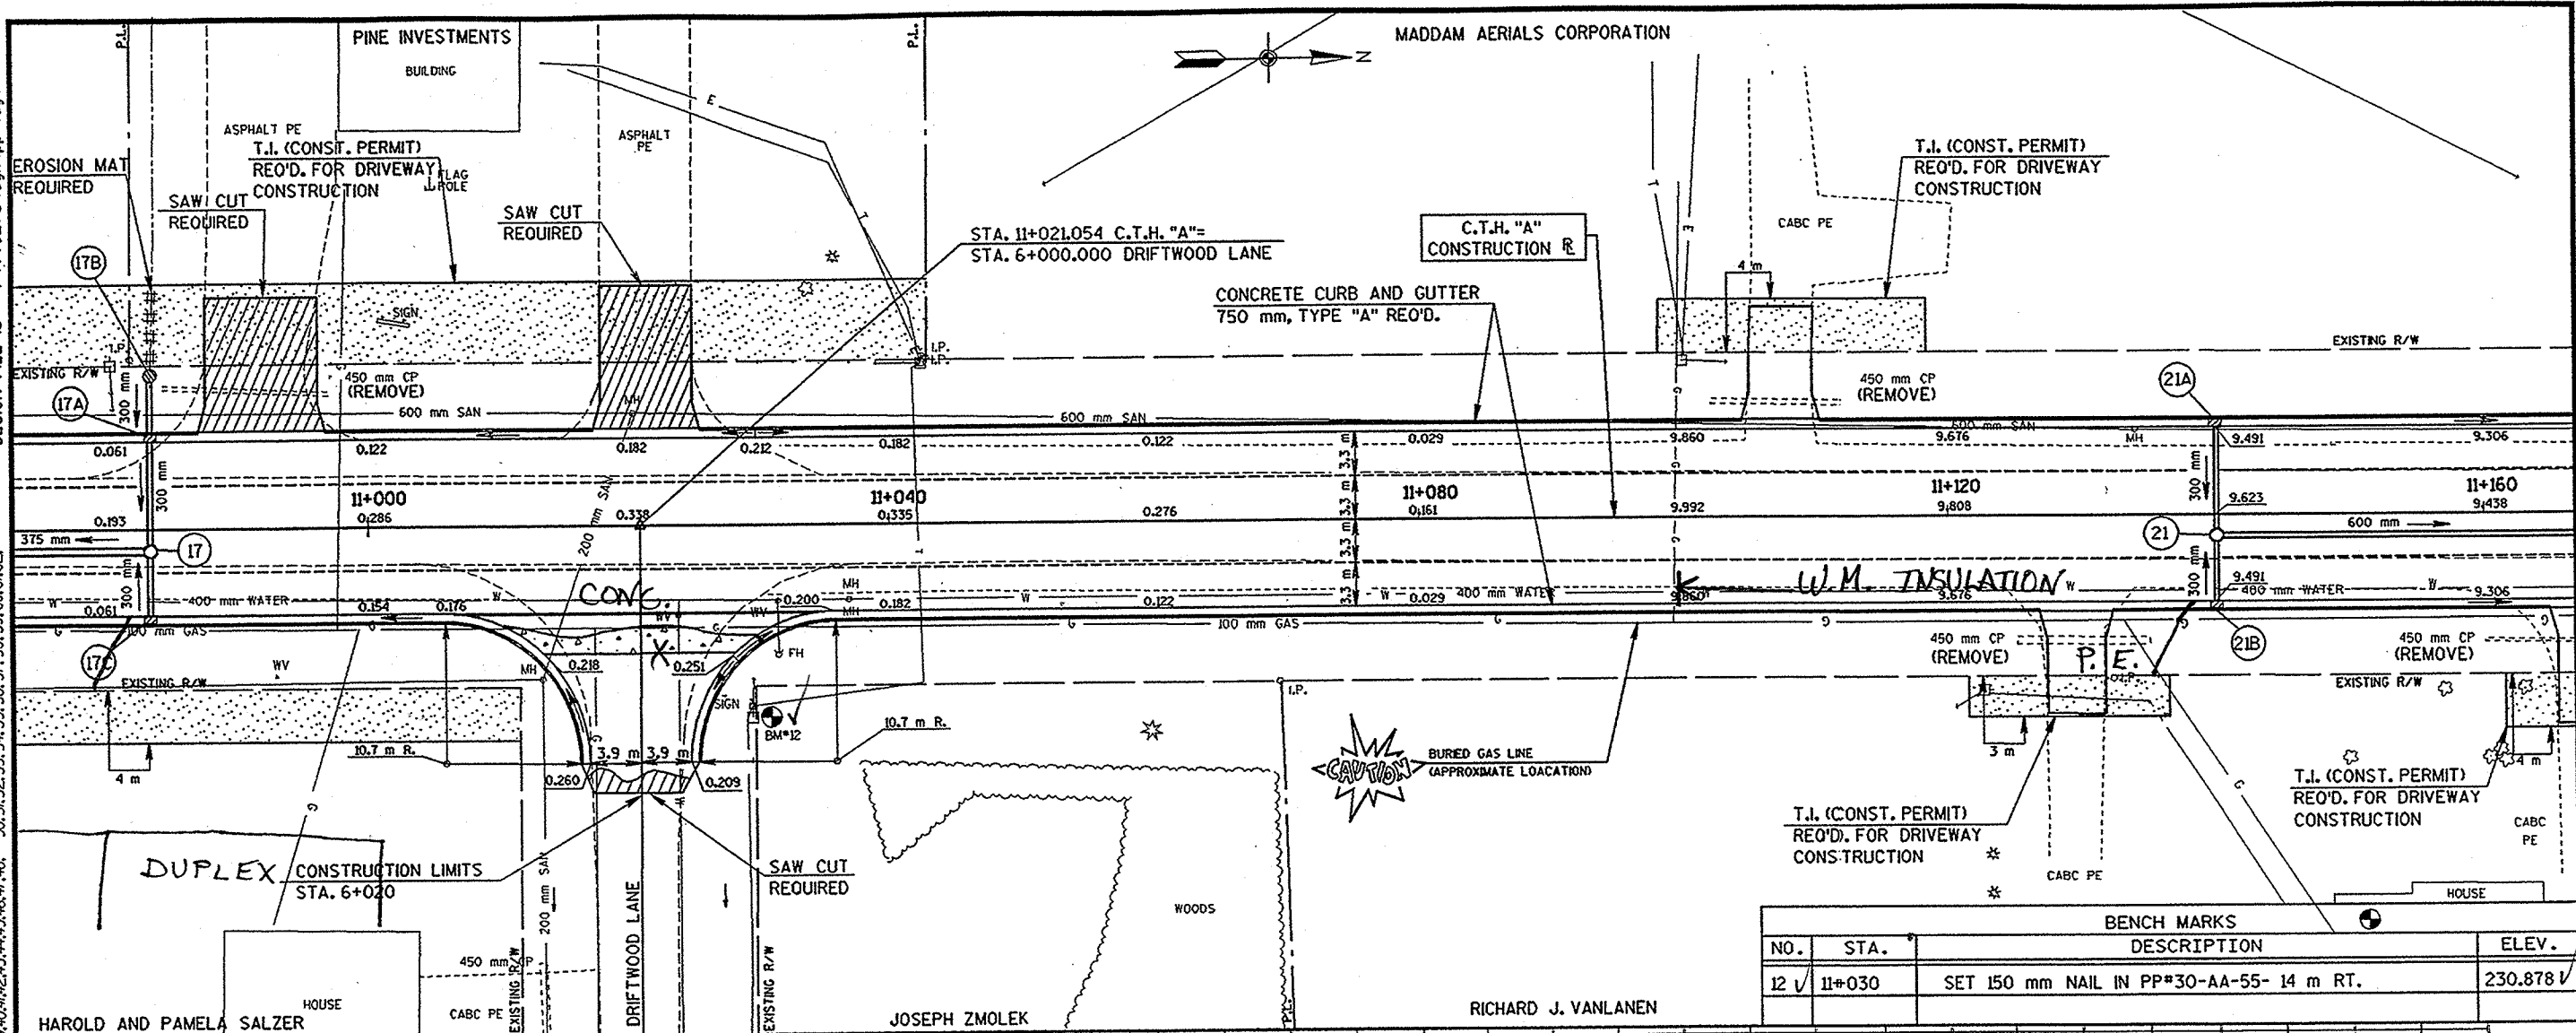


BENCH MARKS			
NO.	STA.	DESCRIPTION	ELEV.
12	11+030	SET 150 mm NAIL IN PP#30-AA-55- 14 m RT.	230.878

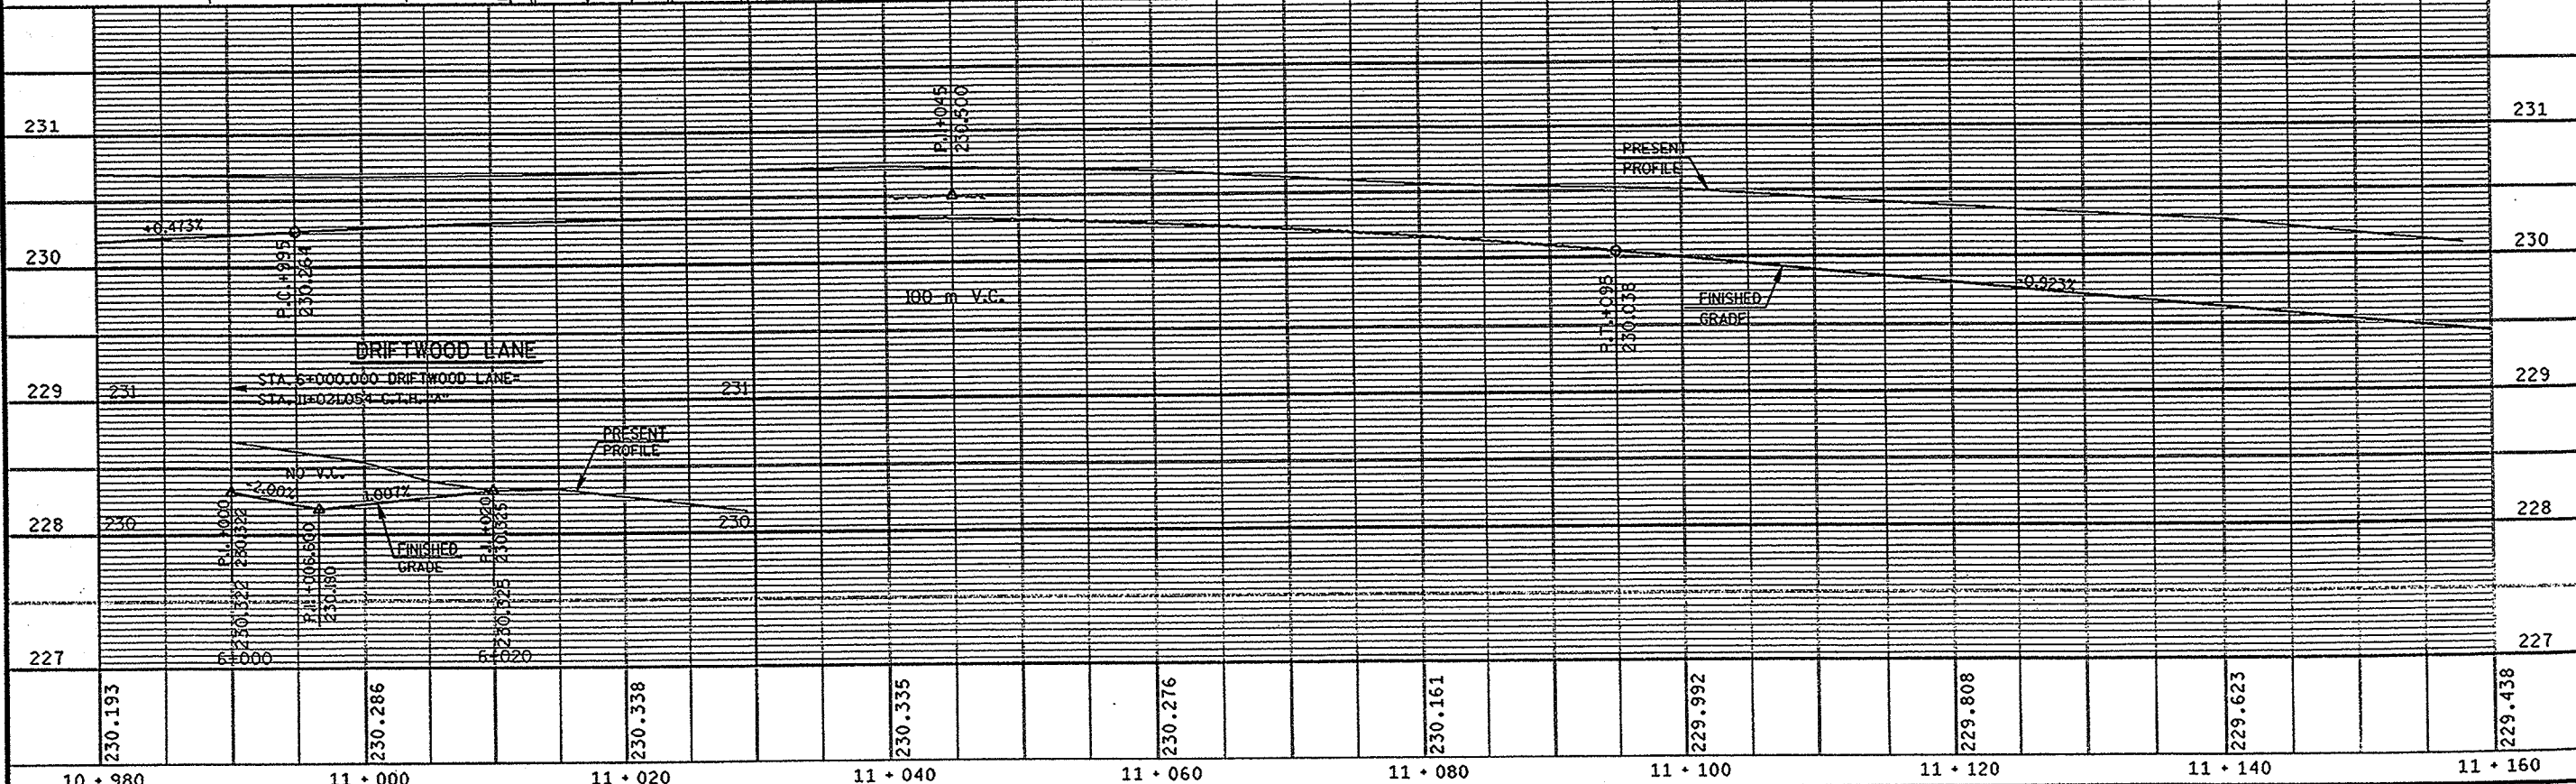

CB 2
 PEN TABLE = #plot72#loser#mv80dp.tbl
 DATE OF PLOT = 04/15/99
 PLOT NO
 DESIGN FILE IS I:\440278\dgn\pp8.dgn


FILE NAME:
 SCALE:
 DATE: 02/25/98
 PLOT NAME:
 PROJECT NO: 440278
 LEVELS ON = 1, 2, 3, 48, 50, 51, 52, 53, 54, 55, 56, 57, 58, 59, 60, 61, 62

ORIGINATOR: JPZ
 PROJECT NO: 440278
 LEVELS ON = 1, 2, 3, 48, 50, 51, 52, 53, 54, 55, 56, 57, 58, 59, 60, 61, 62

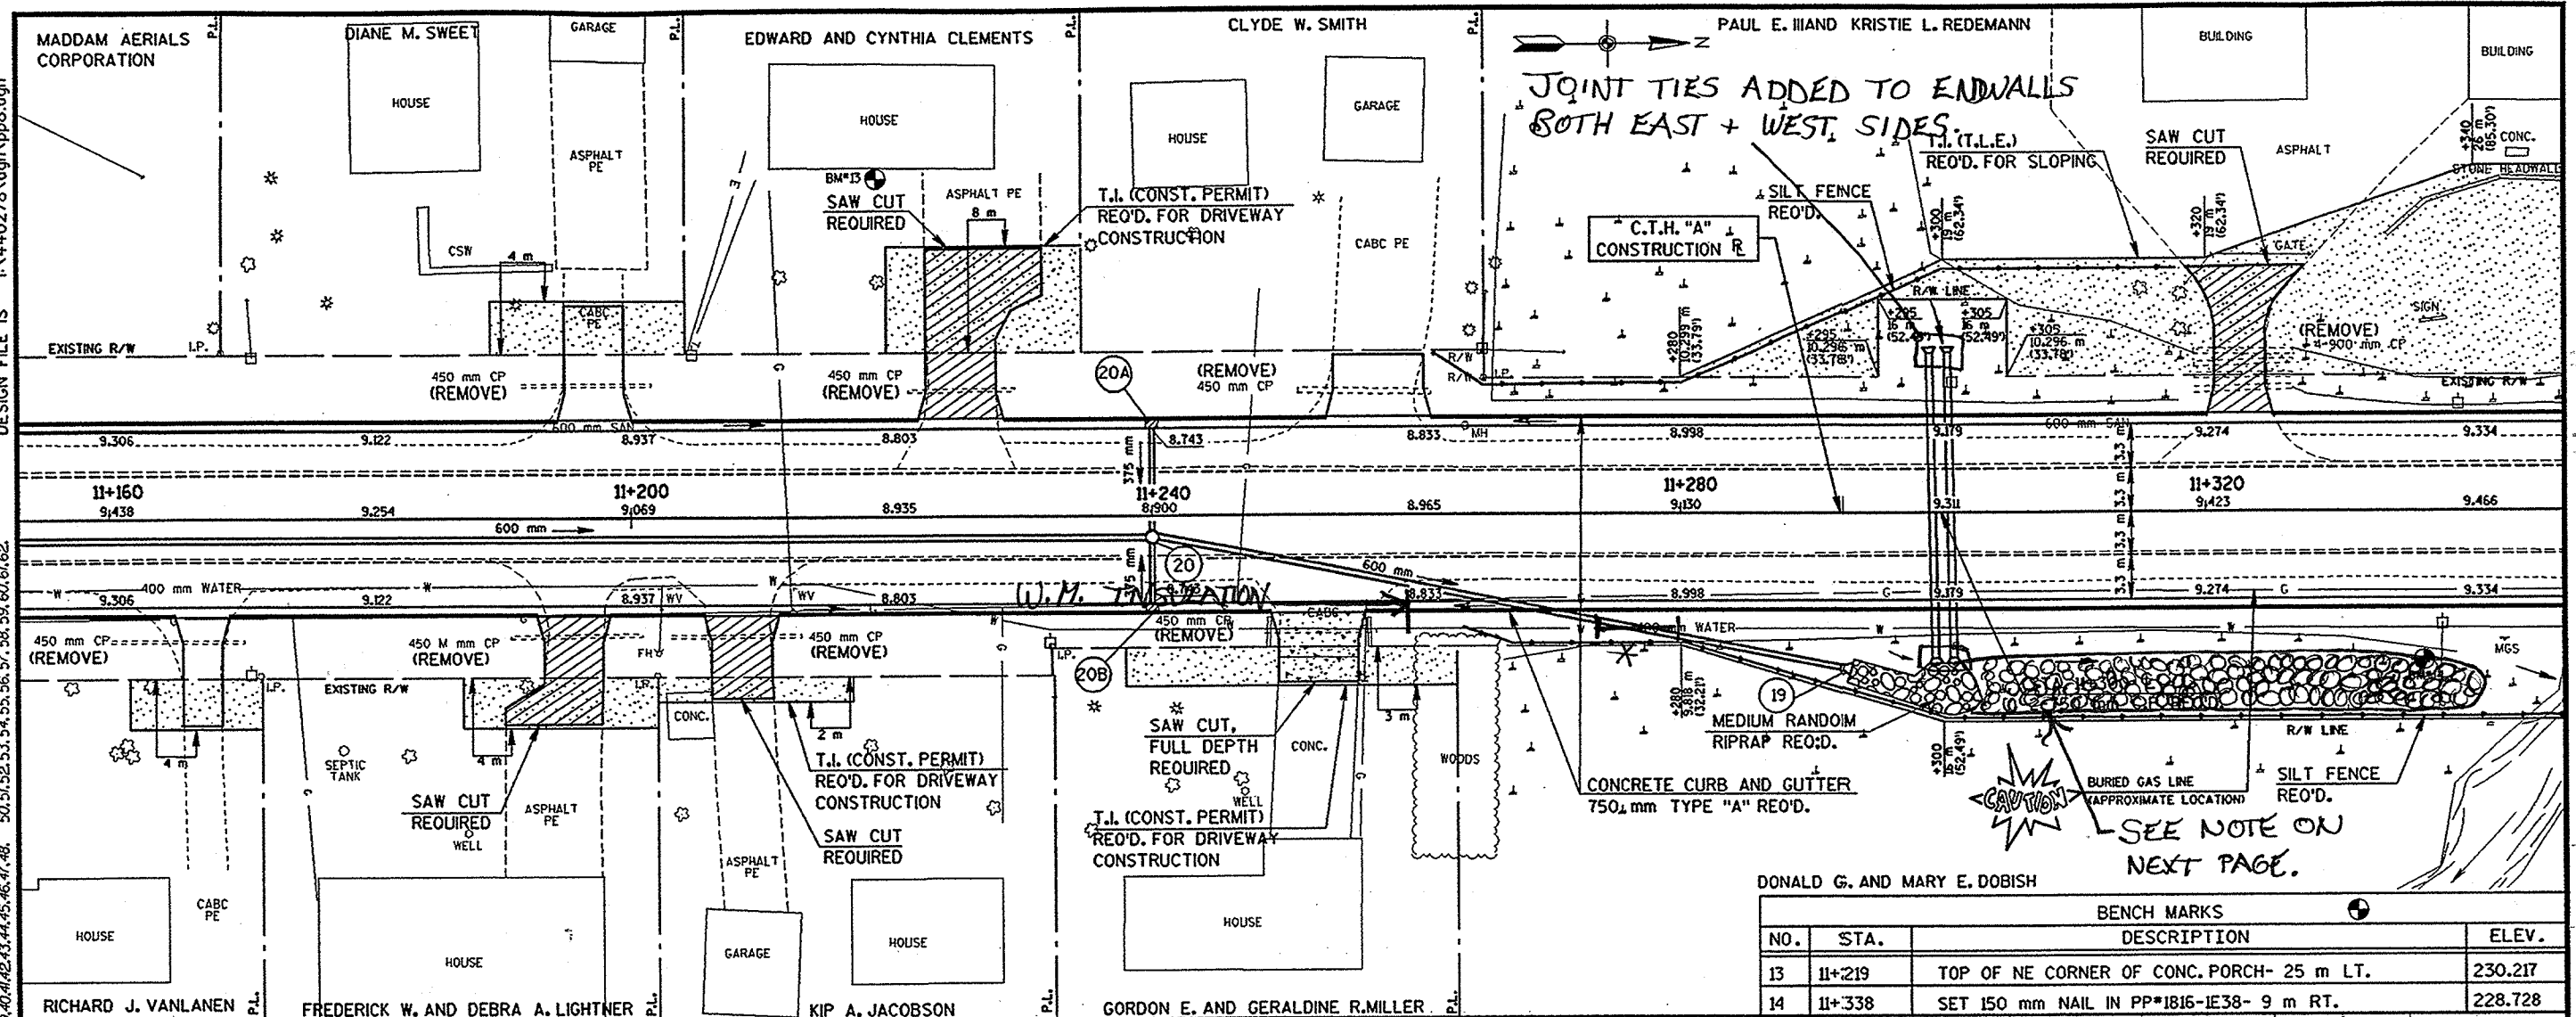


DONALD G. AND MARY E. DOBISH

BENCH MARKS			
NO.	STA.	DESCRIPTION	ELEV.
13	11+219	TOP OF NE CORNER OF CONC. PORCH- 25 m LT.	230.217
14	11+338	SET 150 mm NAIL IN PP#1816-1E38- 9 m RT.	228.728

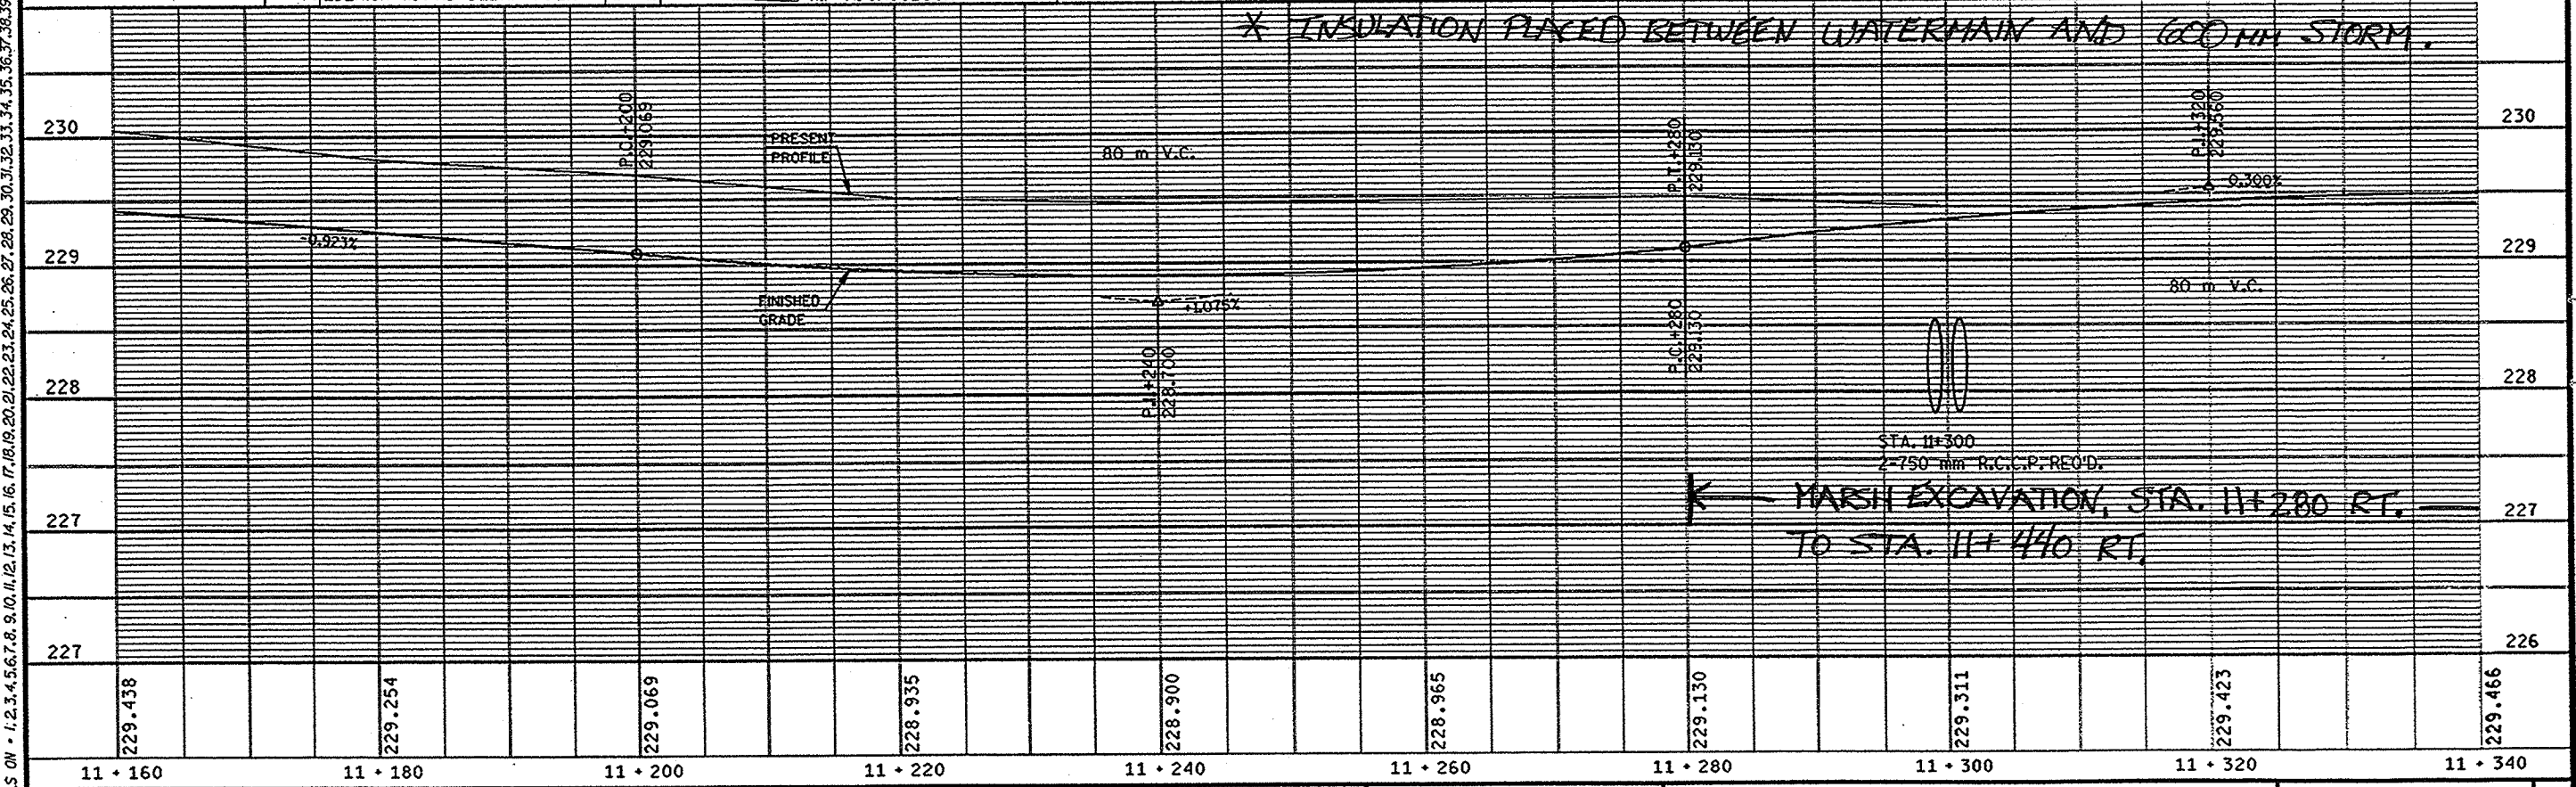


STA. 11+300
 2-750 mm R.C.P. REQ'D.
 ← MARSH EXCAVATION, STA. 11+280 RT. TO STA. 11+440 RT.

ORIGINATOR: JPZ
 PROJECT NO: 440278
 LEVELS ON - 1, 2, 3, 48, 50, 51, 52, 53, 54, 55, 56, 57, 58, 59, 60, 61, 62
 DATE: 02/25/98
 FILE NAME: PPS.PRF
 SCALE:
 PLOT NAME: PPS.PRF
 CB 2
 PLOT NO: 440278
 DESIGN FILE IS: I:\440278\440278.dgn\pp9.dgn
 PLOT NAME: PPS.PRF
 DATE OF PLOT: 04/15/99
 FILE NAME: PPS.PRF

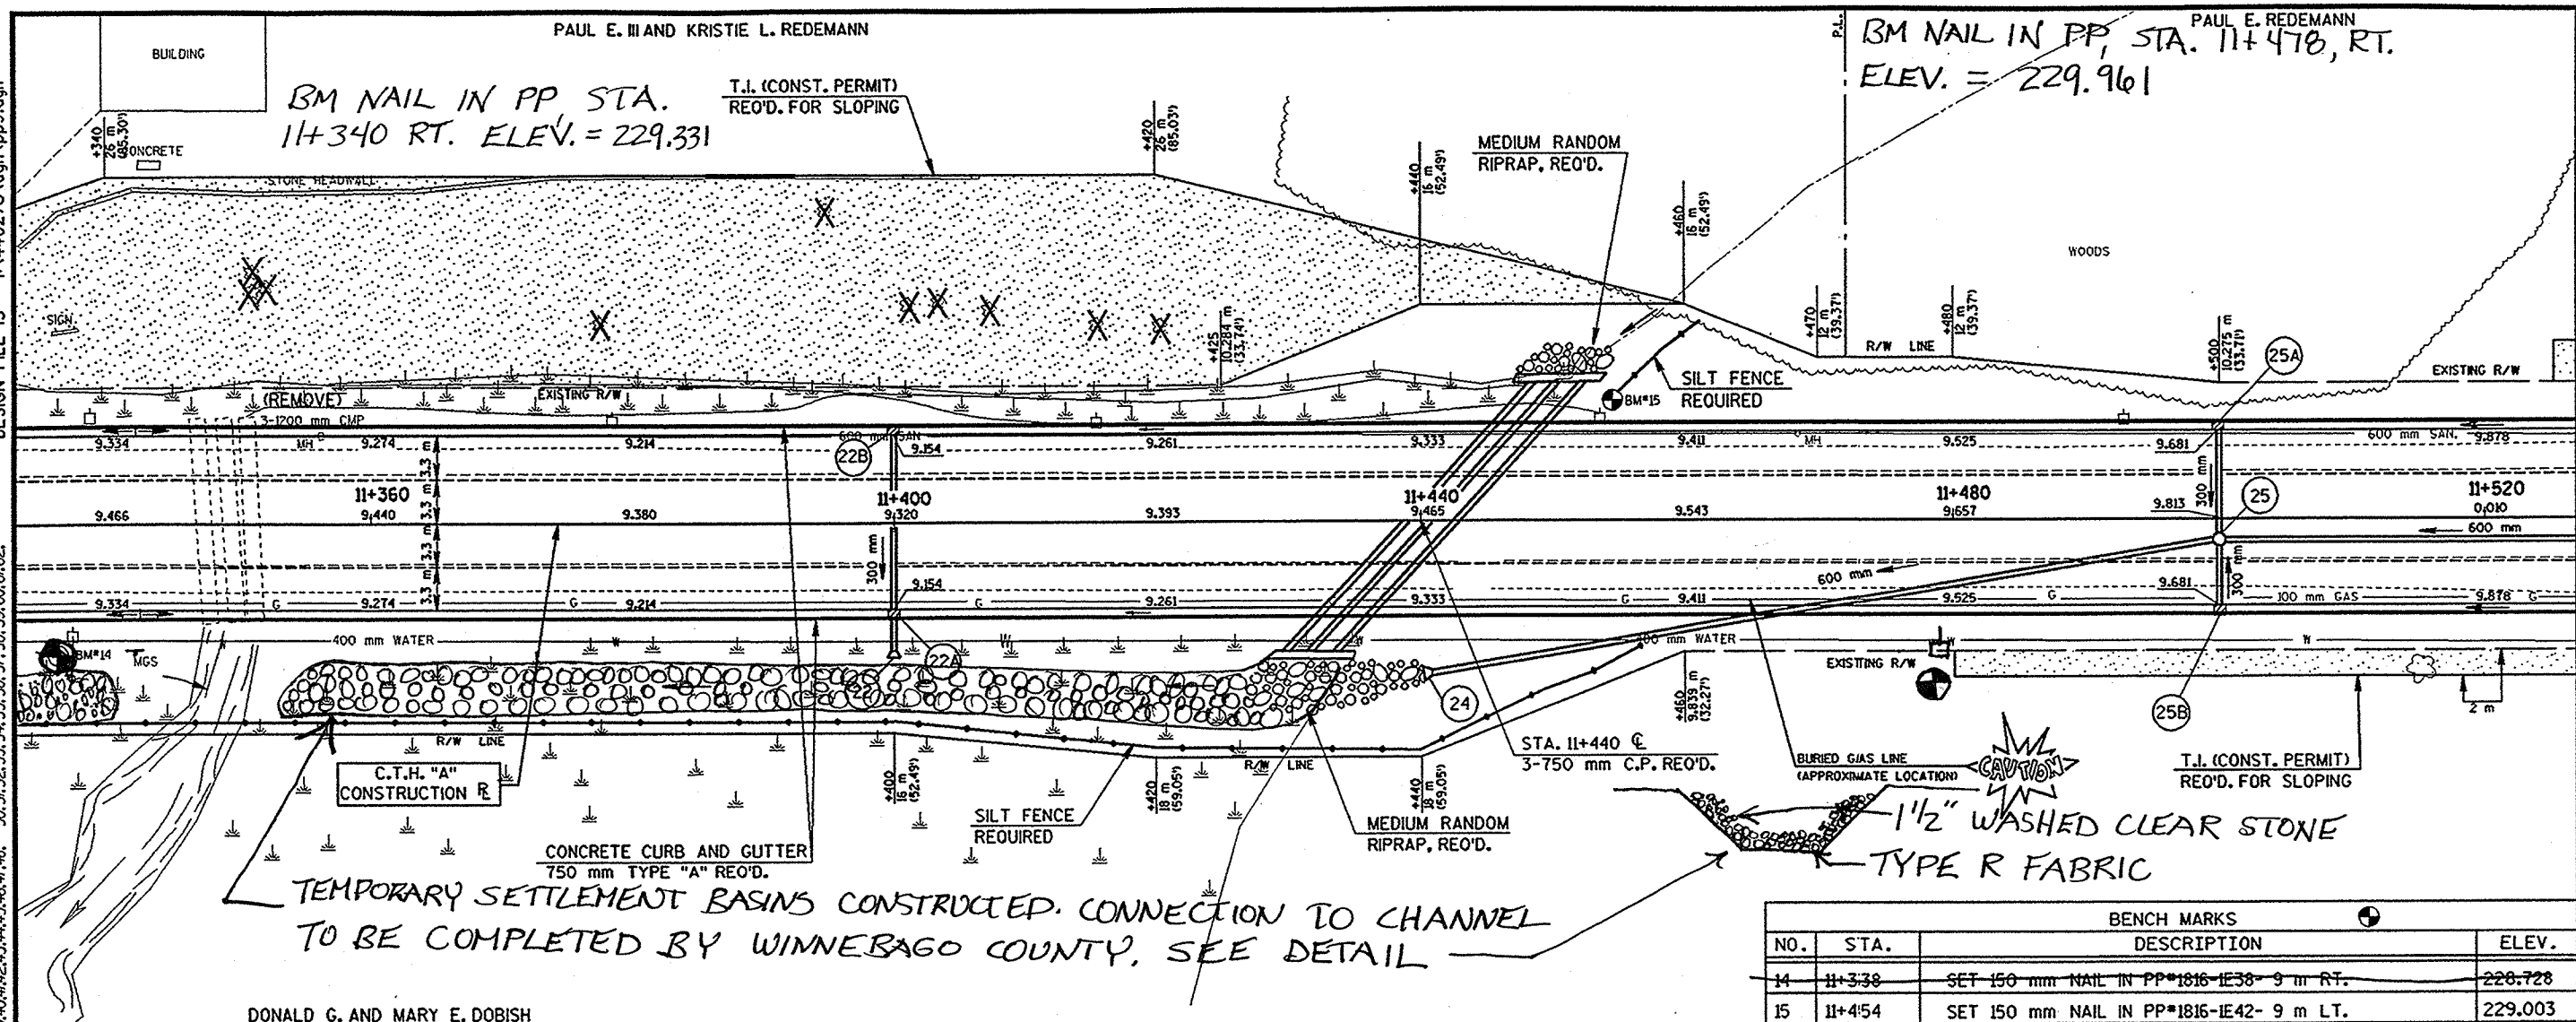


BENCH MARKS			
NO.	STA.	DESCRIPTION	ELEV.
14	11+338	SET 150 mm NAIL IN PP#1816-1E38- 9 m RT.	228.728
15	11+454	SET 150 mm NAIL IN PP#1816-1E42- 9 m LT.	229.003

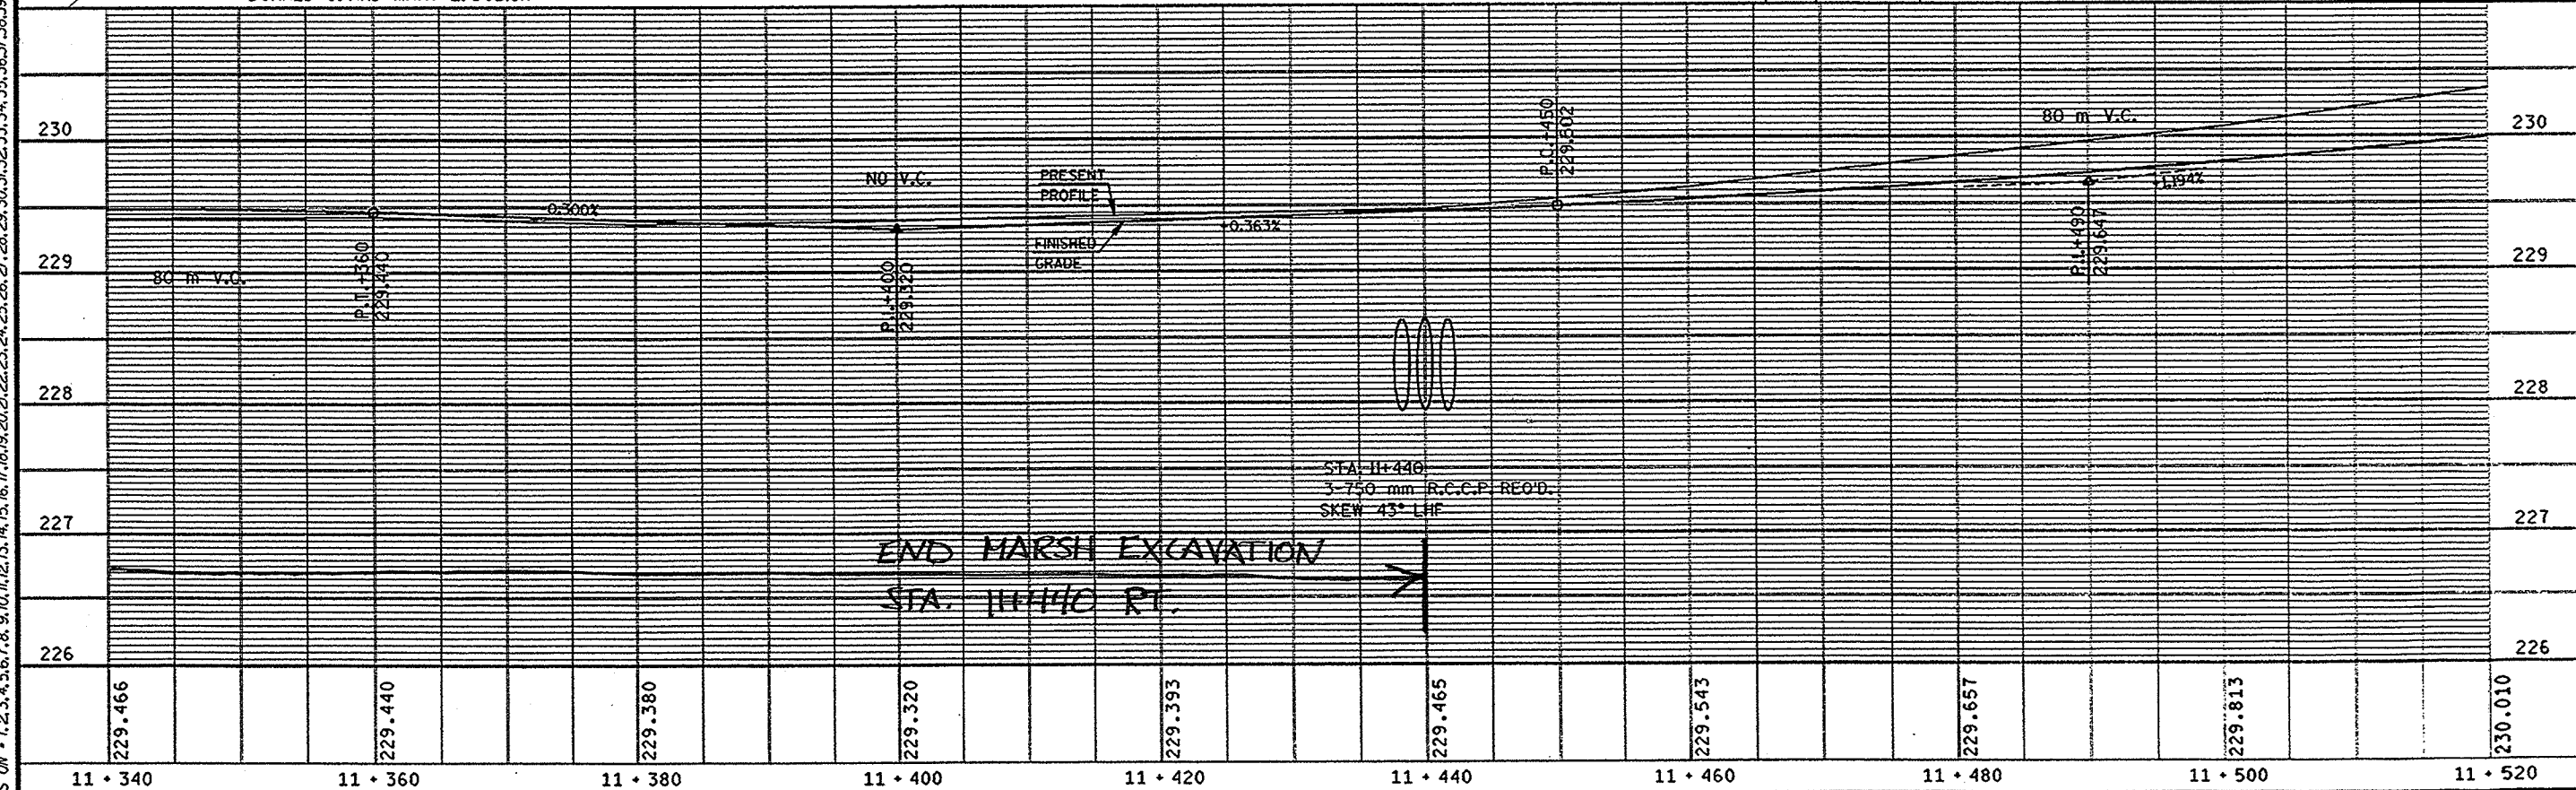

GB 2
 PEN TABLE = #plot72:igser:mv80pp.tbl
 DATE OF PLOT = 12/02/98
 PLOT NA
 DESIGN FILE IS I:\440278\dgn\pp10.dgn

ORIGINATOR: JPZ
 PROJECT NO: 440278
 FILE NAME: P:\P10.PRF
 DATE: 02/25/98
 SCALE:
 LEVELS ON = 1, 2, 3, 48, 50, 51, 52, 53, 54, 55, 56, 57, 58, 59, 60, 61, 62.

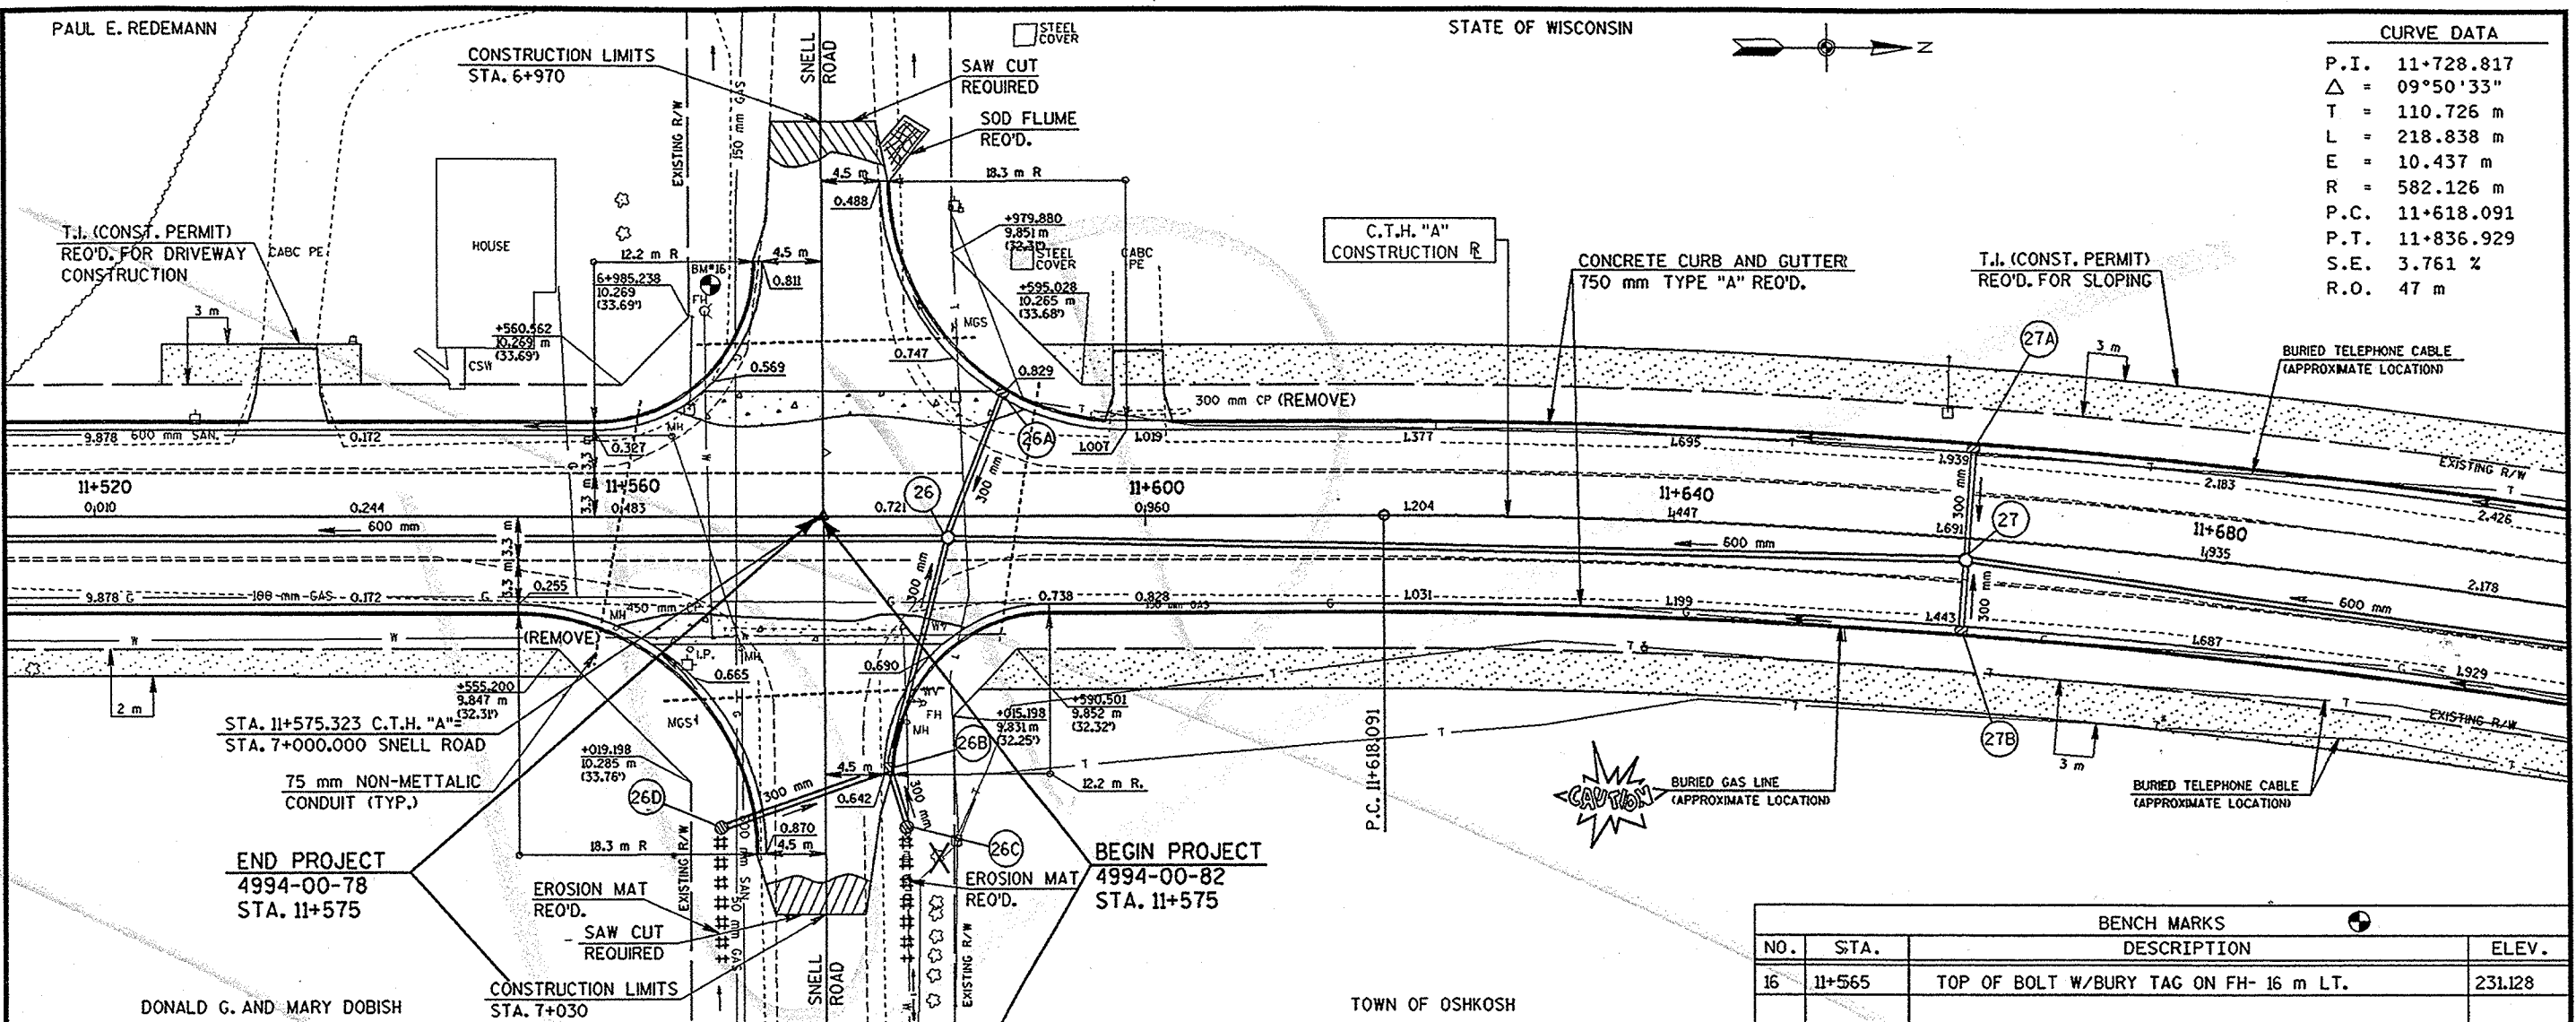


CURVE DATA

P.I.	11+728.817
Δ	09°50'33"
T	110.726 m
L	218.838 m
E	10.437 m
R	582.126 m
P.C.	11+618.091
P.T.	11+836.929
S.E.	3.761 %
R.O.	47 m


BENCH MARKS

NO.	STA.	DESCRIPTION	ELEV.
16	11+565	TOP OF BOLT W/BURY TAG ON FH- 16 m LT.	231.128

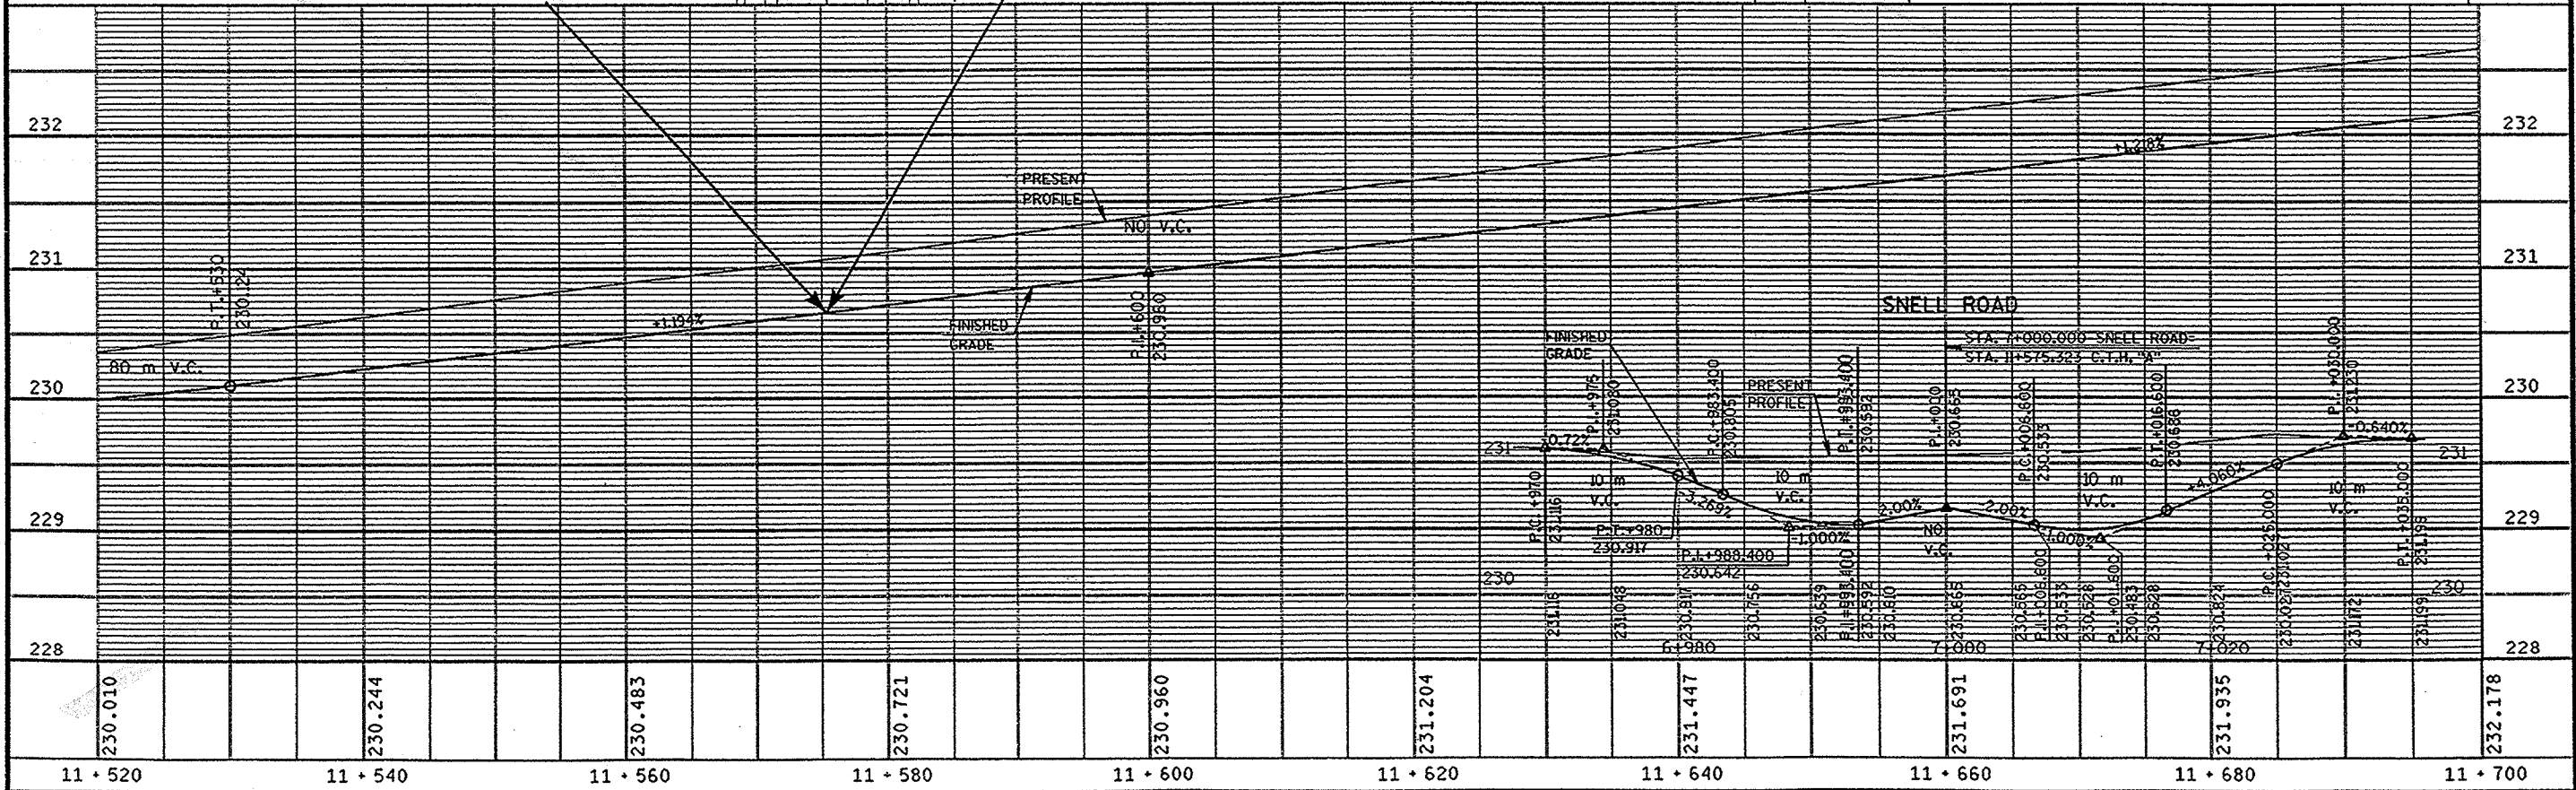

WISDOT: MSHT42

ORIGINATOR: JPZ
 PROJECT NO: 490278
 LEVELS ON: 1, 2, 3, 48, 50, 51, 52, 53, 54, 55, 56, 57, 58, 59, 60, 61, 62.
 FILE NAME: P:\440278\p10.dgn
 DATE: 02/25/98
 PLOT NAME: P10.PRF
 SCALE: 1:1000
 DESIGN FILE IS: P:\440278\p10.dgn

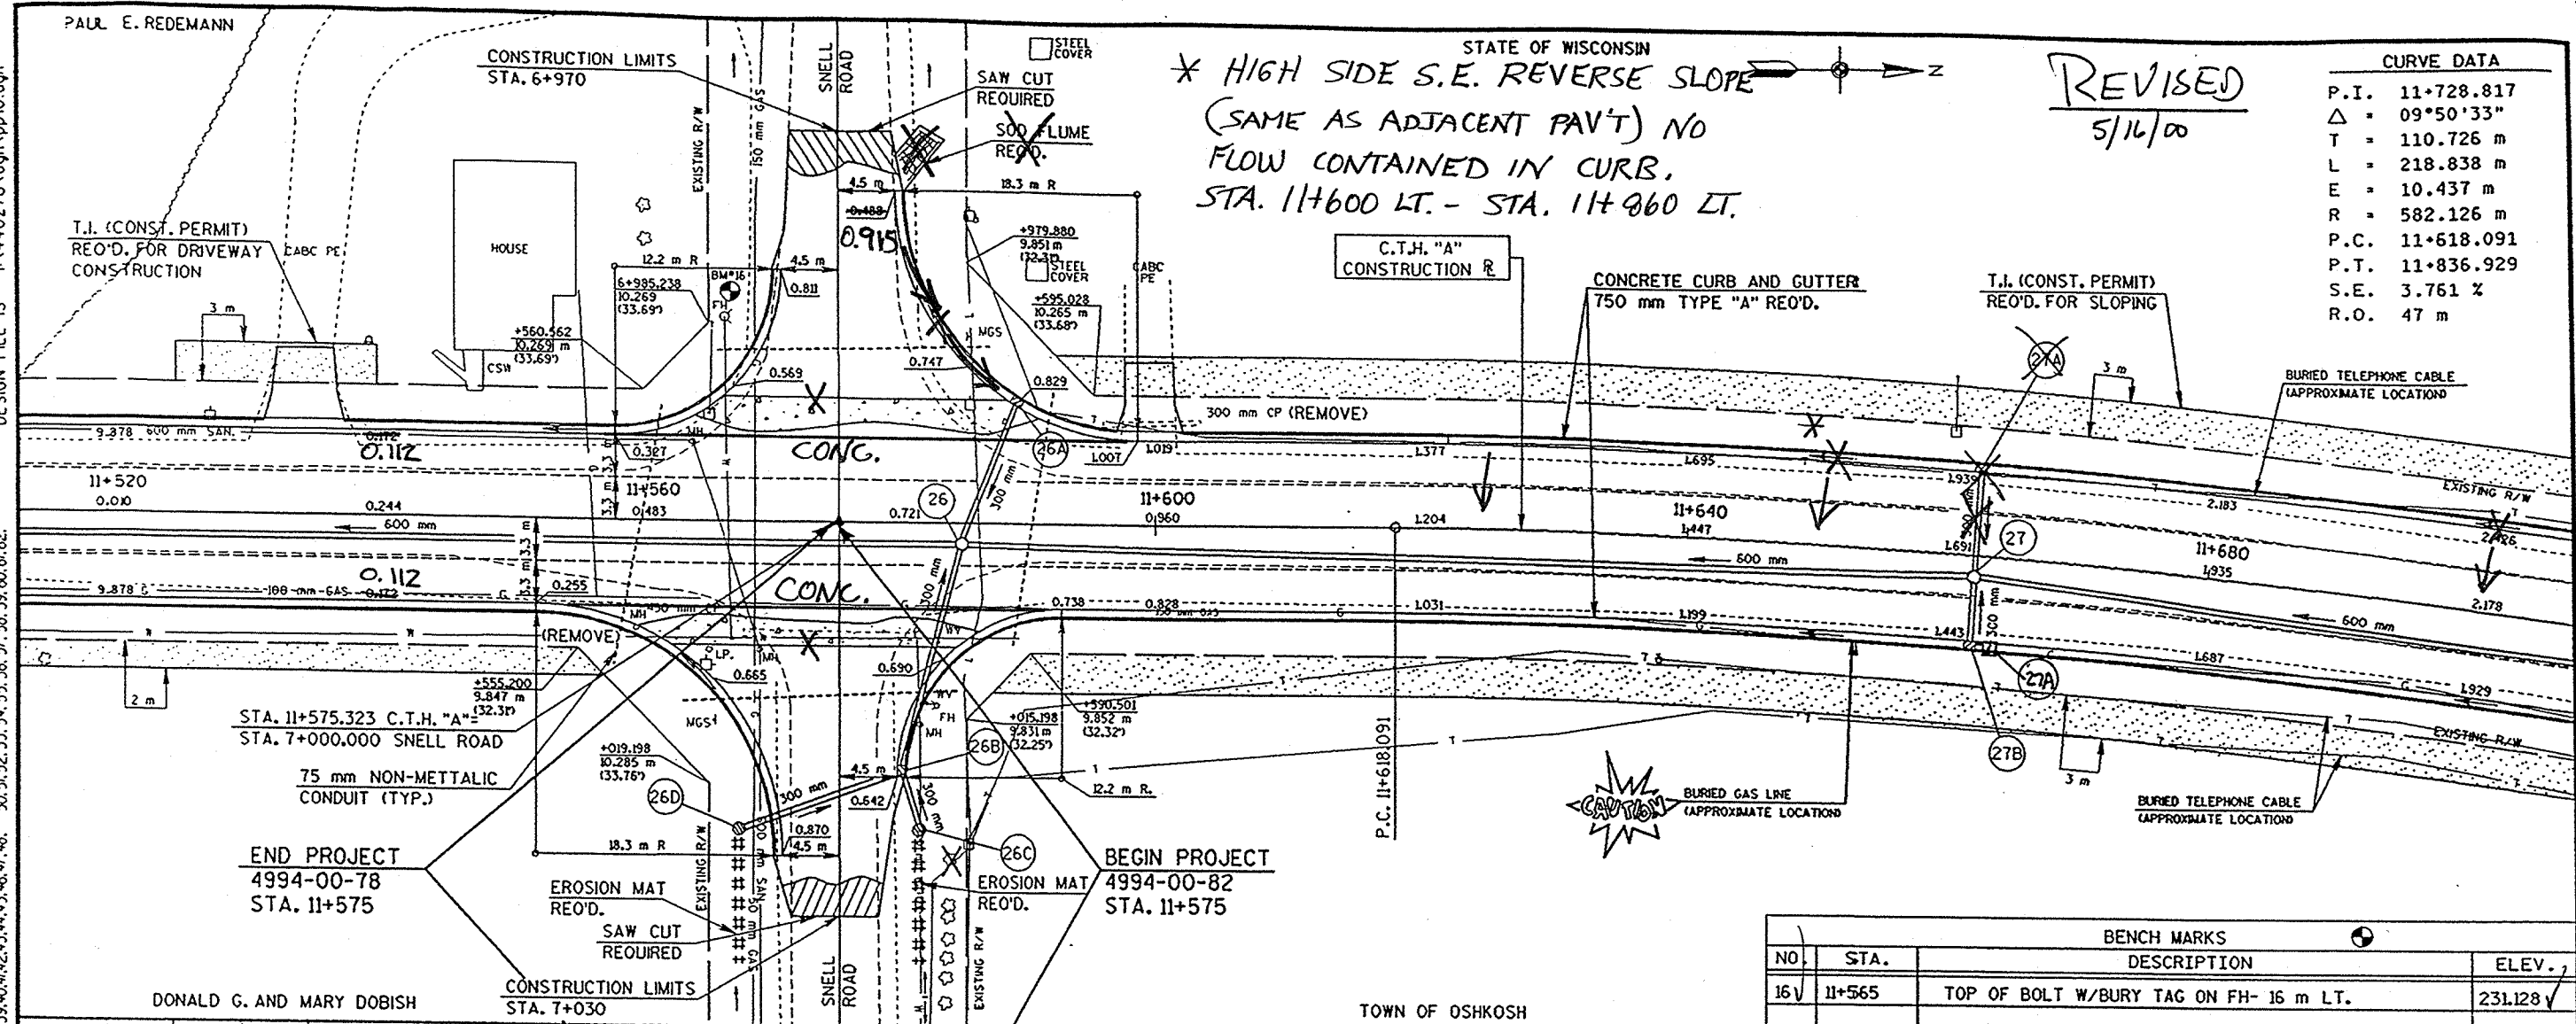


STATE OF WISCONSIN
 * HIGH SIDE S.E. REVERSE SLOPE (SAME AS ADJACENT PAV'T) NO FLOW CONTAINED IN CURB.
 STA. 11+600 LT. - STA. 11+860 LT.

REVISED
 5/16/00


CURVE DATA	
P.I.	11+728.817
Δ	09°50'33"
T	110.726 m
L	218.838 m
E	10.437 m
R	582.126 m
P.C.	11+618.091
P.T.	11+836.929
S.E.	3.761 %
R.O.	47 m

BENCH MARKS			
NO.	STA.	DESCRIPTION	ELEV.
16V	11+565	TOP OF BOLT W/BURY TAG ON FH- 16 m LT.	231.128 ✓

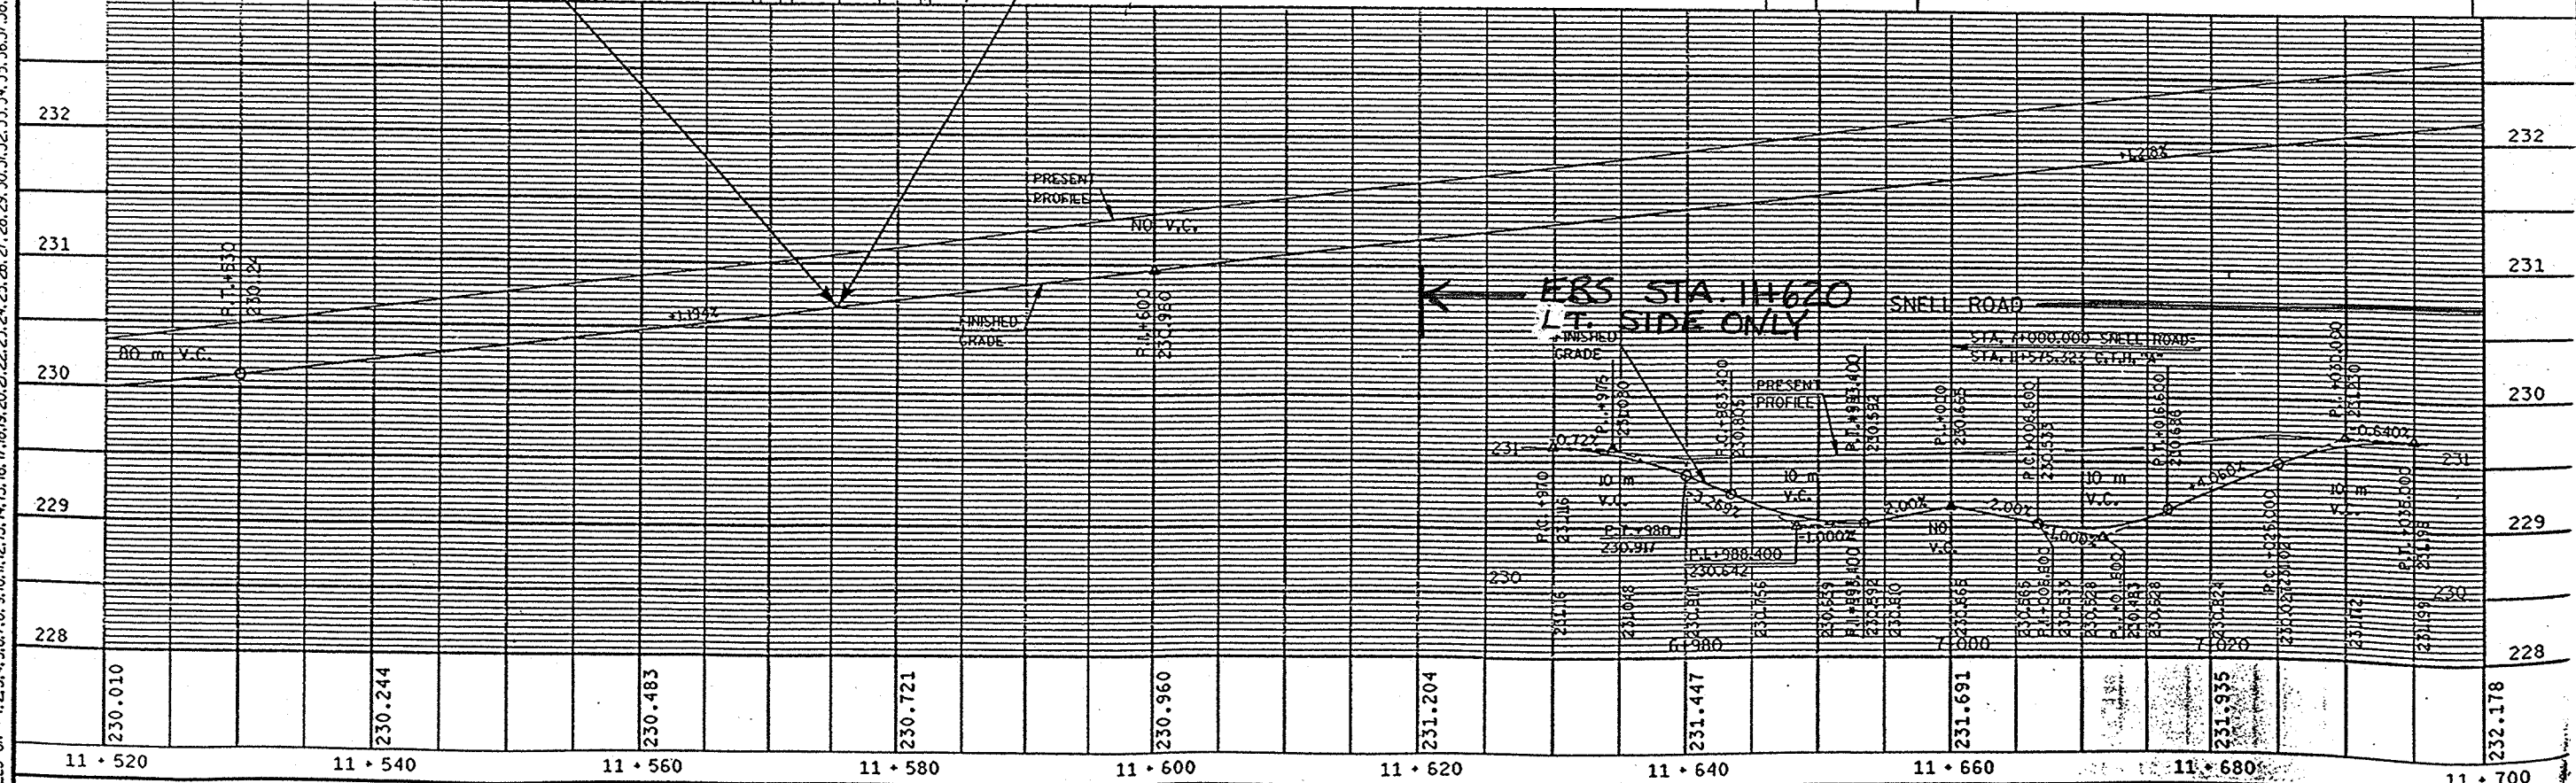

← REVERSE STA. 11+620 LT. SIDE ONLY


GB 2
 PEN TABLE = #plot724user=my80pp.tbl
 DATE OF PLOT = 11/23/98
 PLOT NA
 DESIGN FILE IS I:\440278\dgn\pp11.dgn
 FILE NAME:
 SCALE:
 DATE:
 PLOT NAME:
 ORIGINATOR: JPZ
 PROJECT NO: 440278
 LEVELS ON: 1, 2, 3, 48, 50, 51, 52, 53, 54, 55, 56, 57, 58, 59, 60, 61, 62.

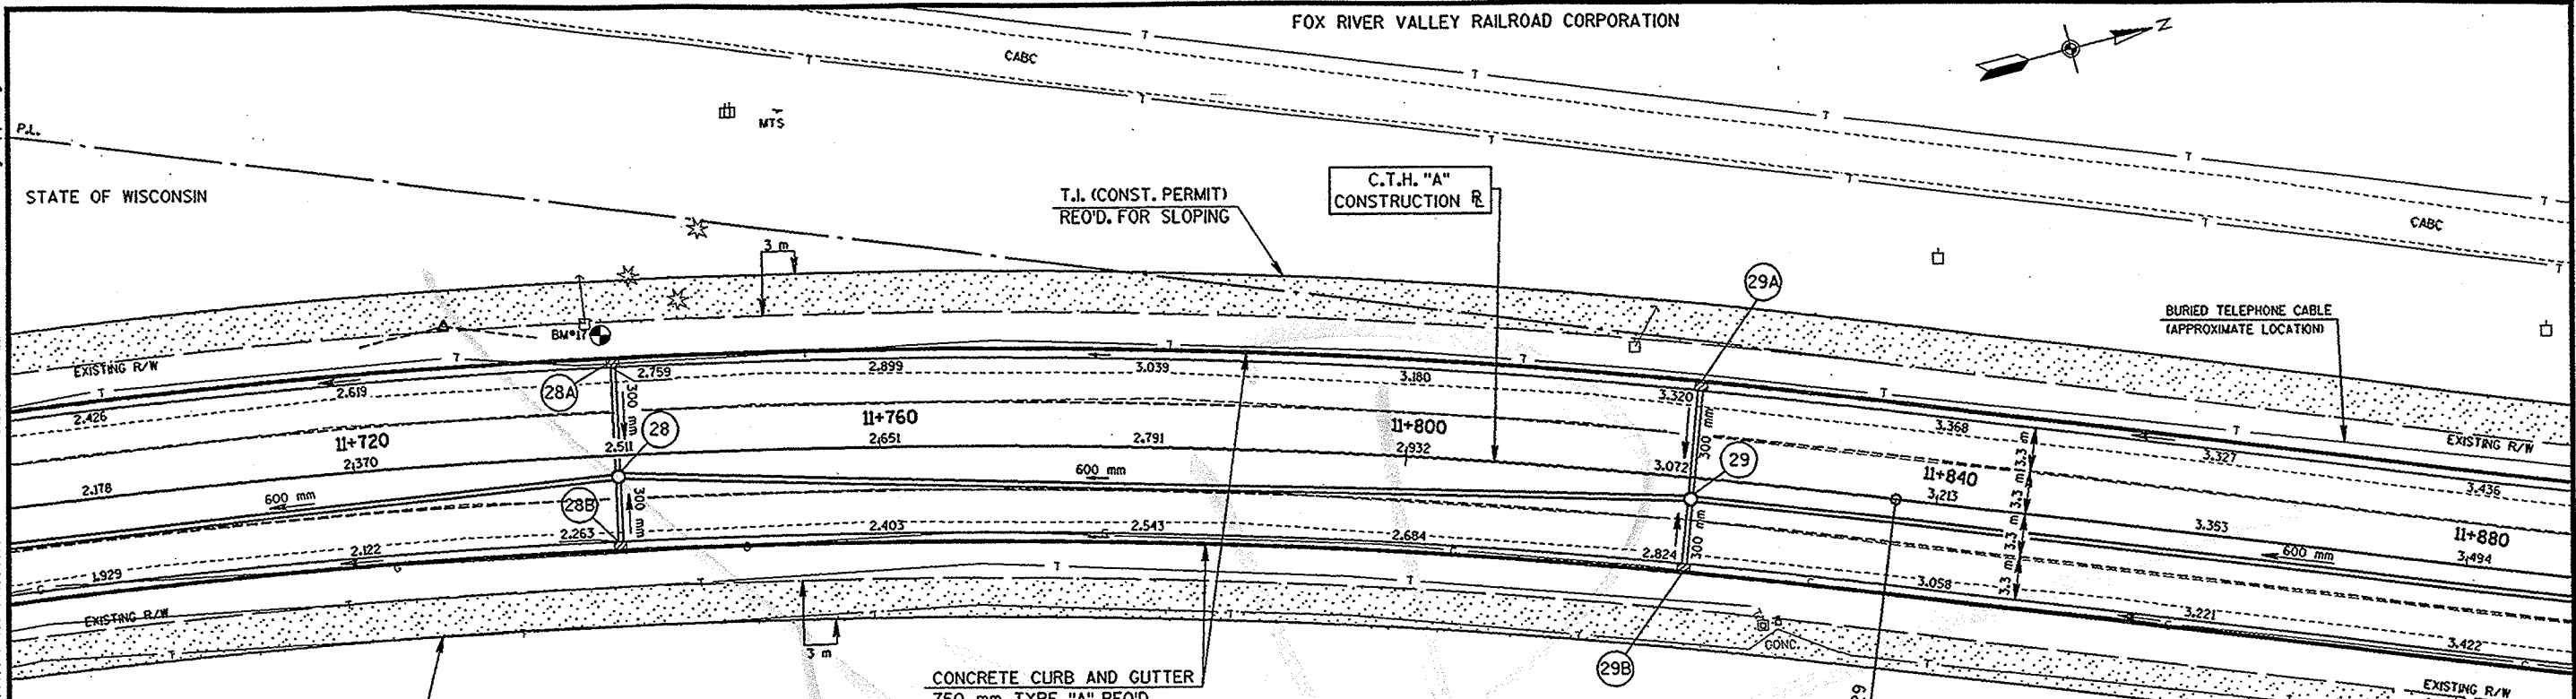


CURVE DATA

P.I. 11+728.817
 $\Delta = 09^{\circ}50'33''$
 T = 110.726 m
 L = 218.838 m
 E = 10.437 m
 R = 582.126 m
 P.C. 11+618.091
 P.T. 11+836.929
 S.E. 3.761%
 R.O. 47 m


BENCH MARKS			
NO.	STA.	DESCRIPTION	ELEV.
17	11+738	SET 150 mm NAIL IN PP#36- R53-9 m LT.	233.128

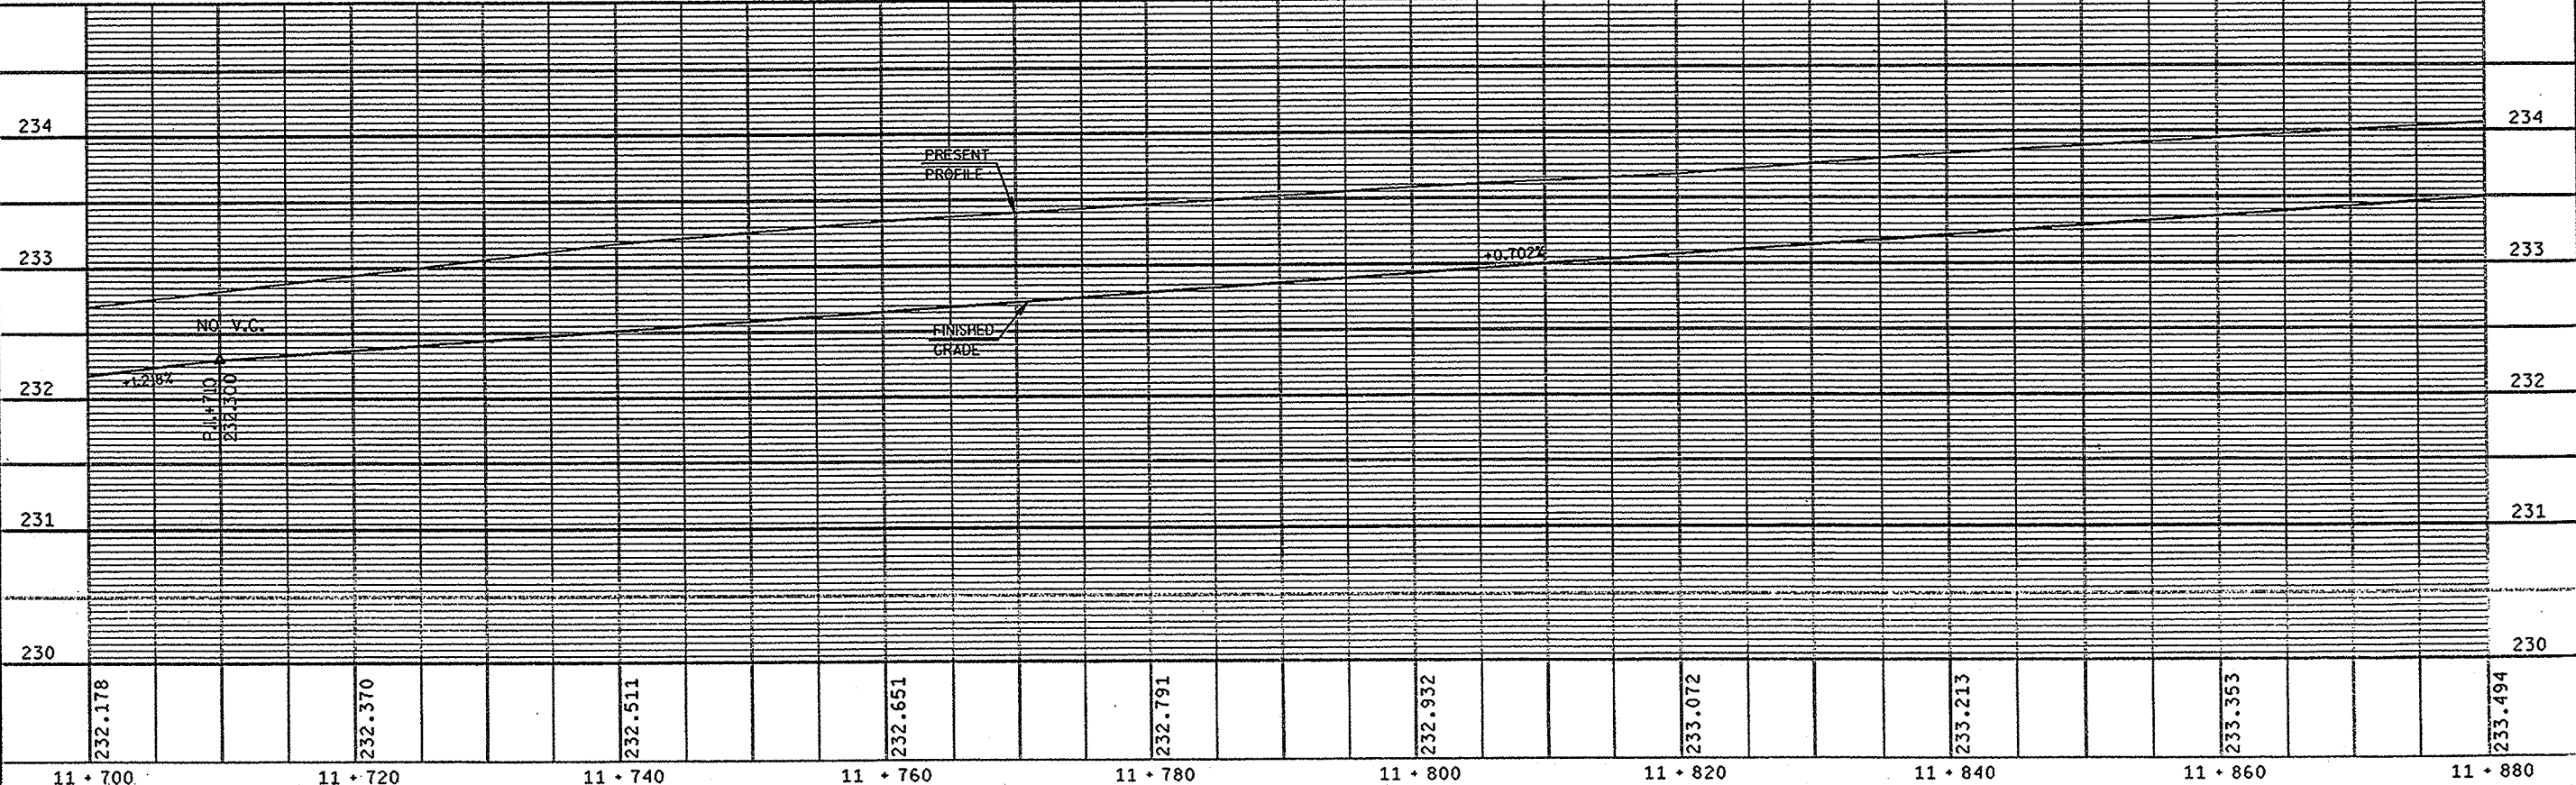


FOX RIVER VALLEY RAILROAD CORPORATION

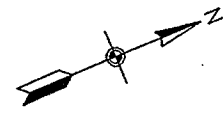

GB 2
 PEN TABLE = #plot724\user\mv80pp.tbl
 DATE OF PLOT = 11/25/98
 PLOT NAME
 DESIGN FILE IS I:\440278\dgn\pp12.dgn
 FILE NAME:
 SCALE:
 DATE: 02/25/98
 PLOT NAME:
 ORIGINATOR: JPZ
 PROJECT NO: 440278
 LEVELS ON = 1, 2, 3, 48, 50, 51, 52, 53, 54, 55, 56, 57, 58, 59, 60, 61, 62

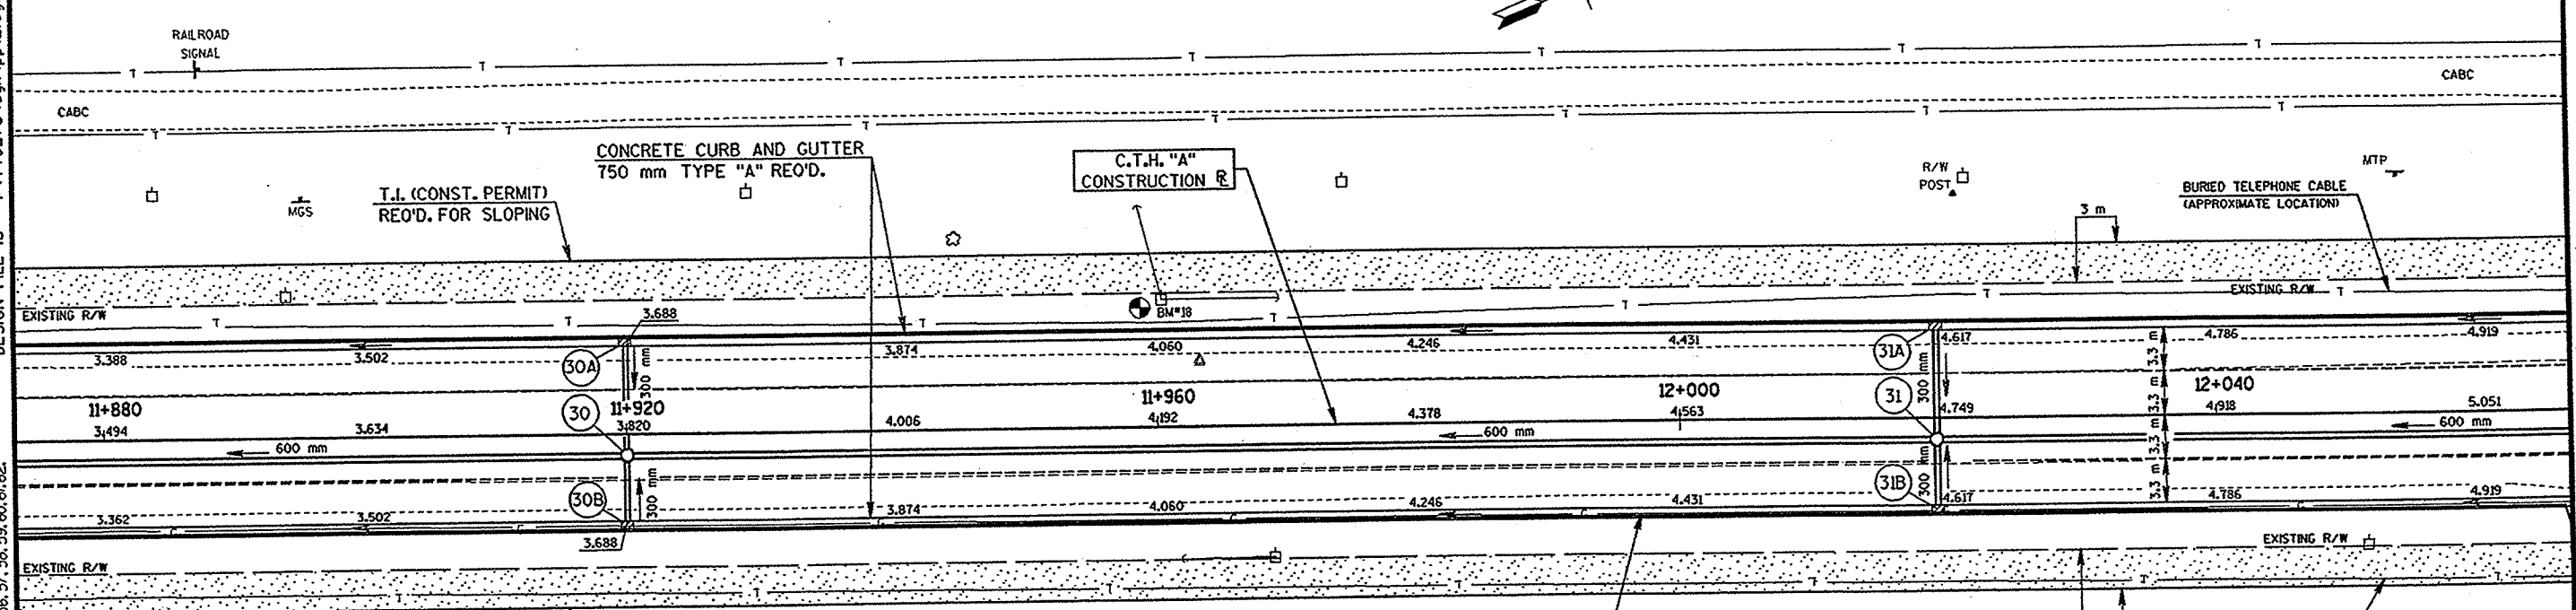


T.I. (CONST. PERMIT)
REQ'D. FOR SLOPING

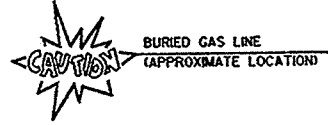


BENCH MARKS			
NO.	STA.	DESCRIPTION	ELEV.
18	11+961	SET 150 mm NAIL IN PP#36-R57- 9 m LT.	234.638

TOWN OF OSHKOSH

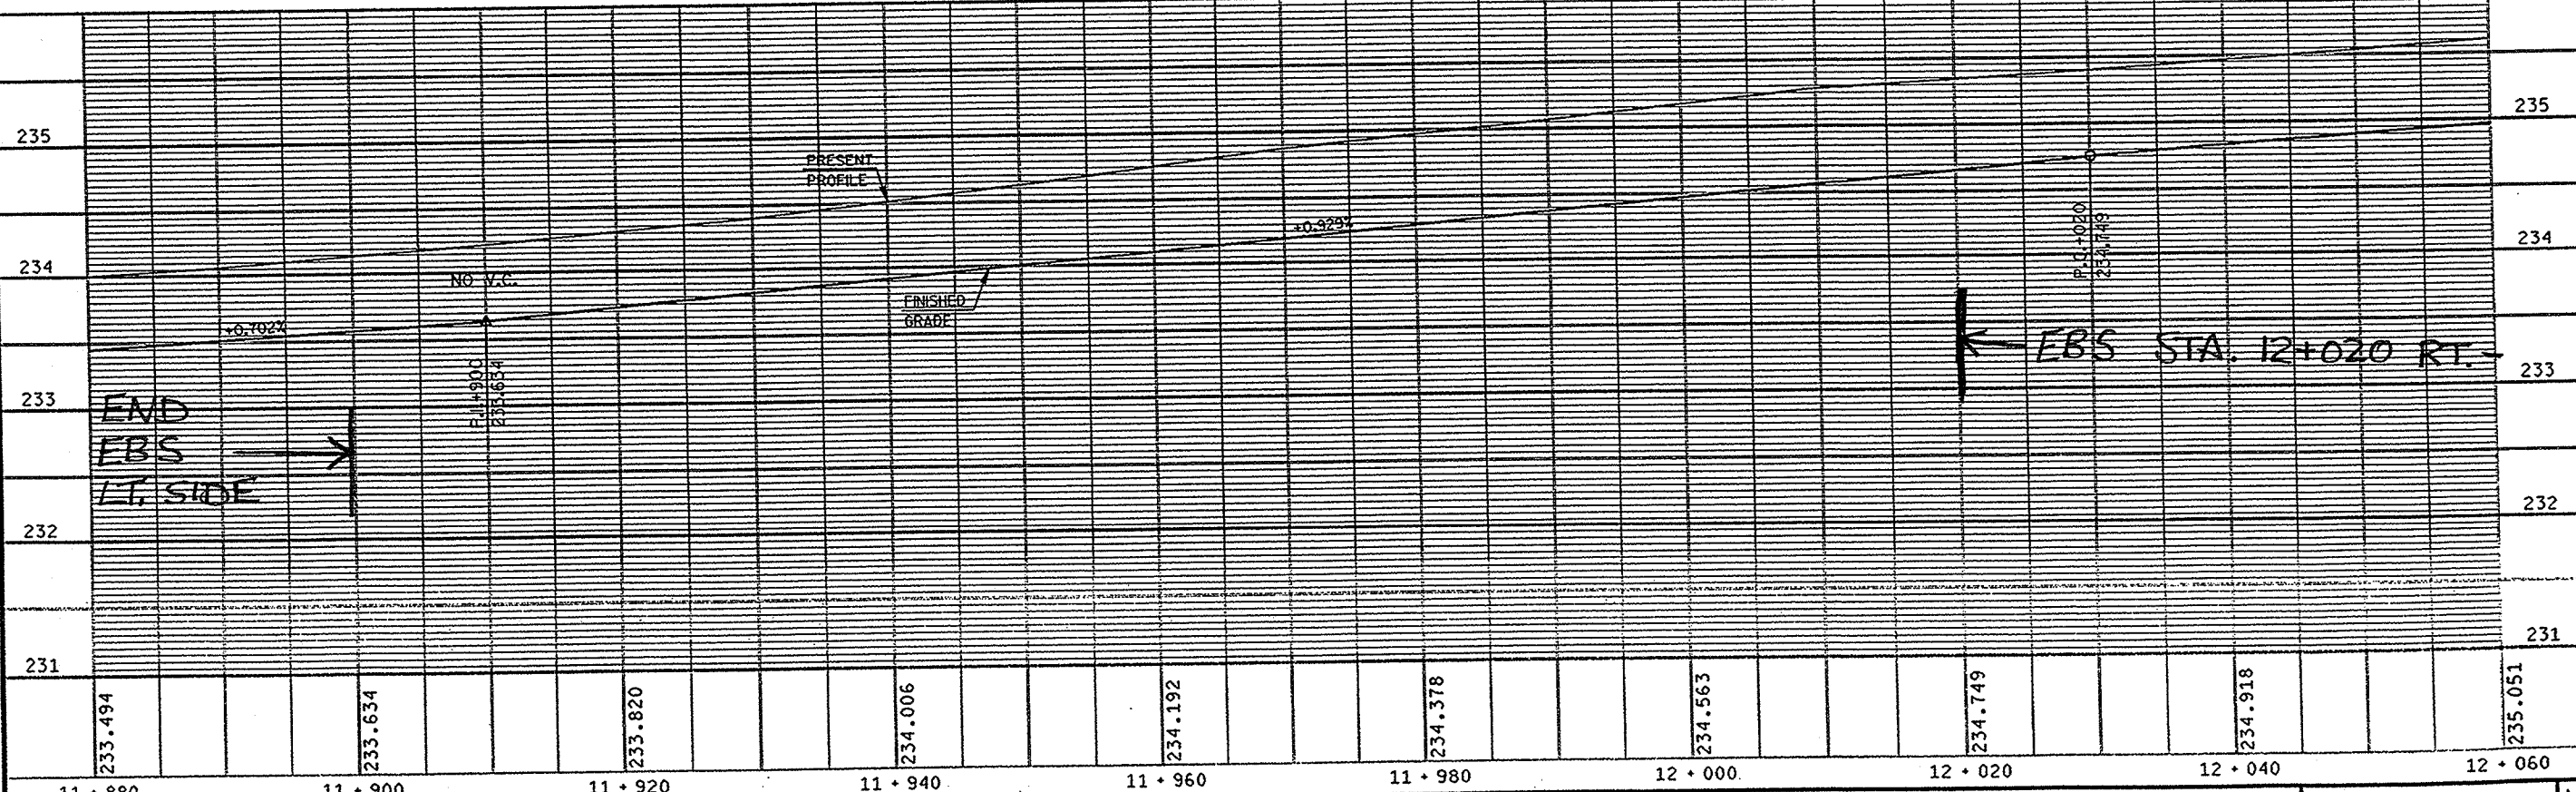


FOX RIVER VALLEY RAILROAD CORPORATION

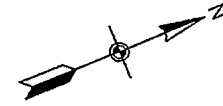


RAILROAD SIGNAL



GB 2
 PEN TABLE = #plot724user+inv80pp.tbl
 DATE OF PLOT = 11/25/98
 PLOT NA
 DESIGN FILE IS I:\440278\dgn\pp13.dgn
 FILE NAME: I:\440278\dgn\pp13.dgn
 DATE: 02/25/98
 PLOT NAME:
 ORIGINATOR: JPZ
 PROJECT NO: 440278
 LEVELS ON = 1, 2, 3, 48, 50, 51, 52, 53, 54, 55, 56, 57, 58, 59, 60, 61, 62
 SCALE:

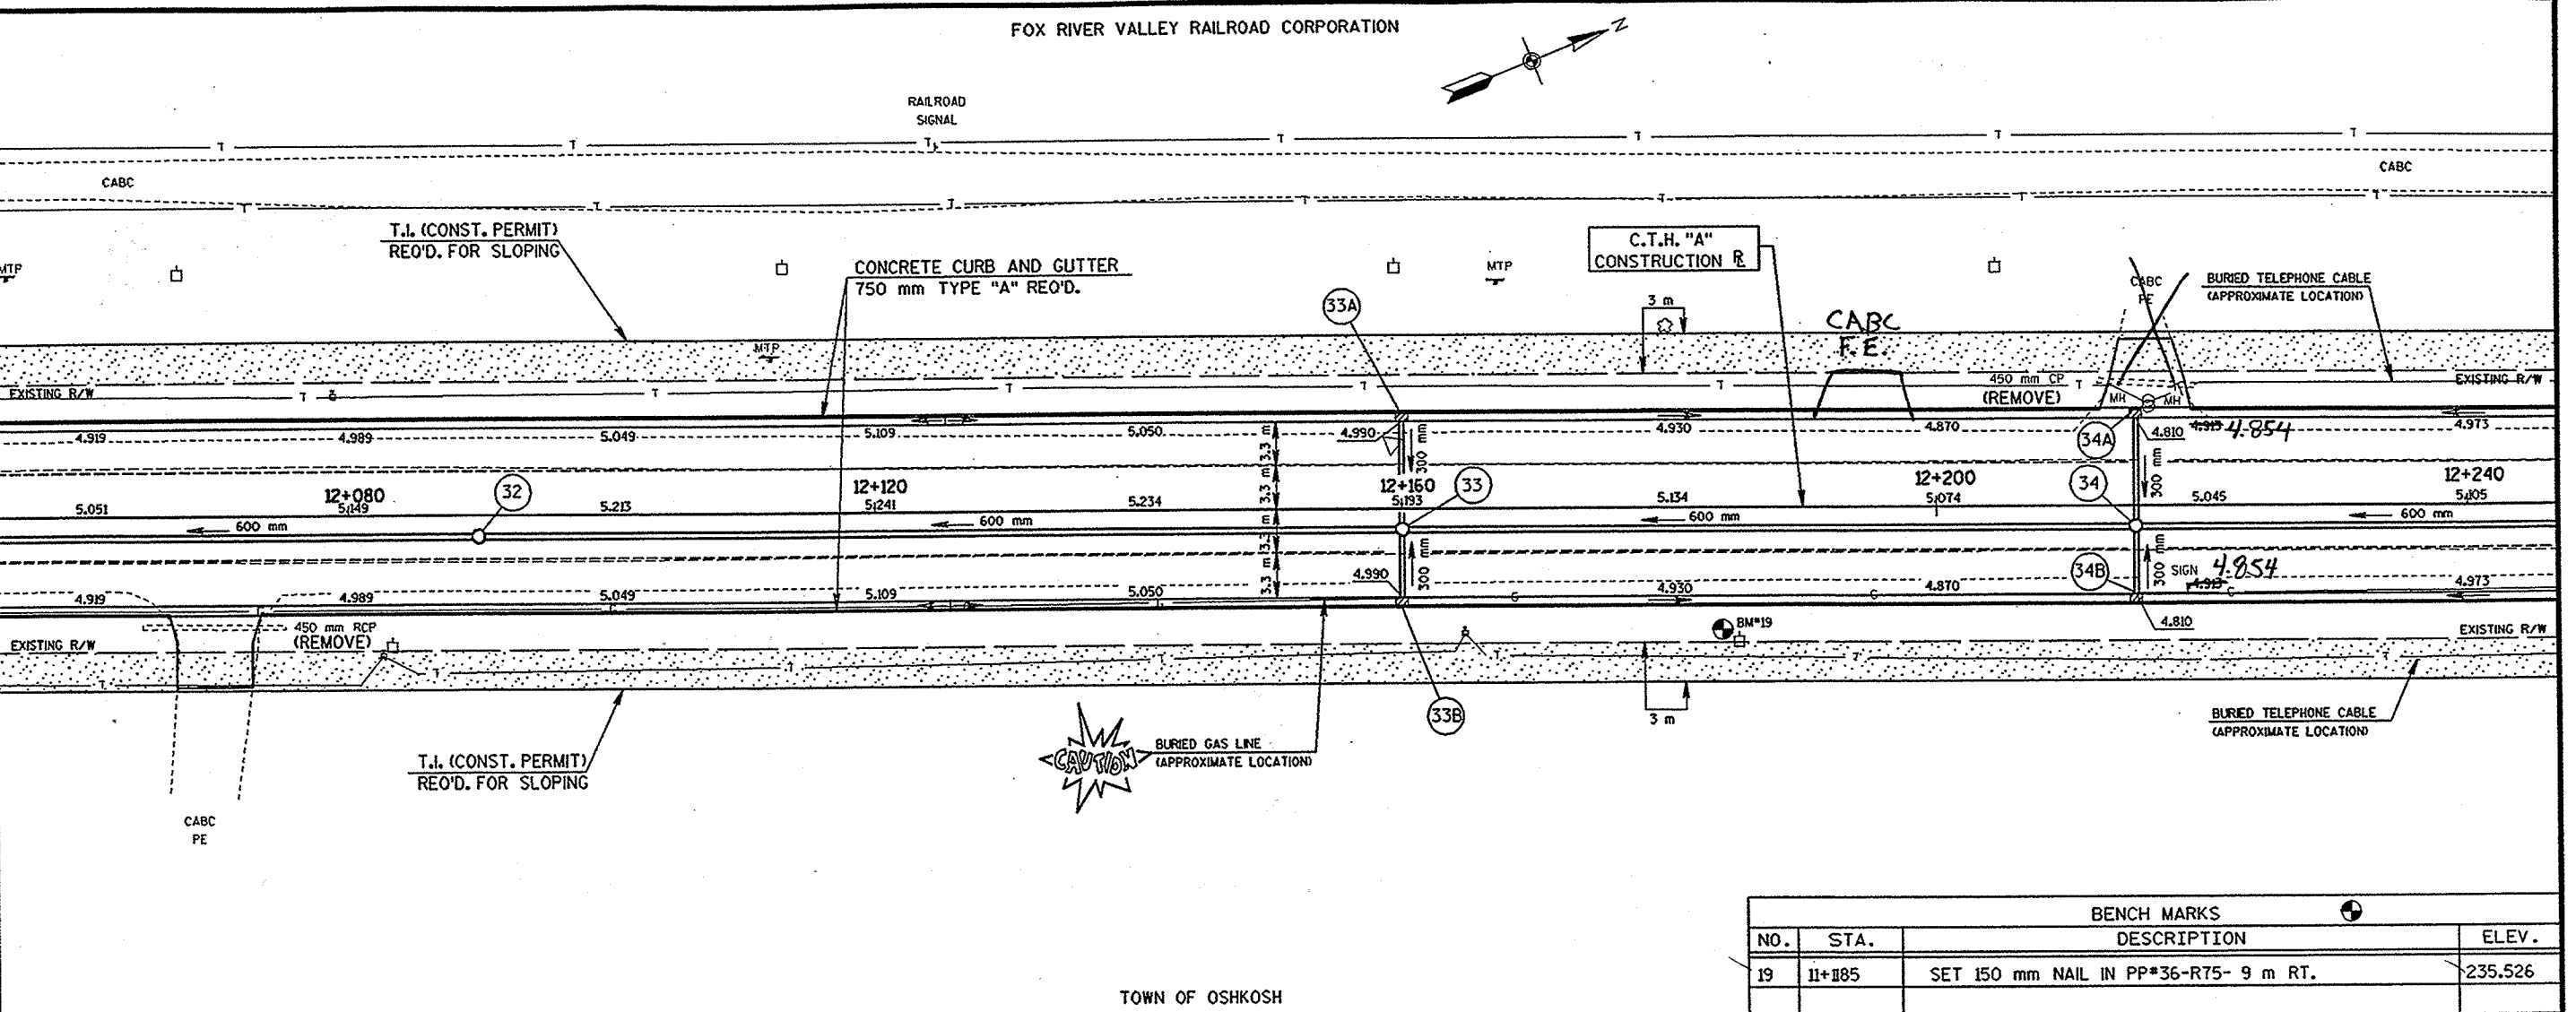


BENCH MARKS			
NO.	STA.	DESCRIPTION	ELEV.
19	11+185	SET 150 mm NAIL IN PP#36-R75- 9 m RT.	235.526

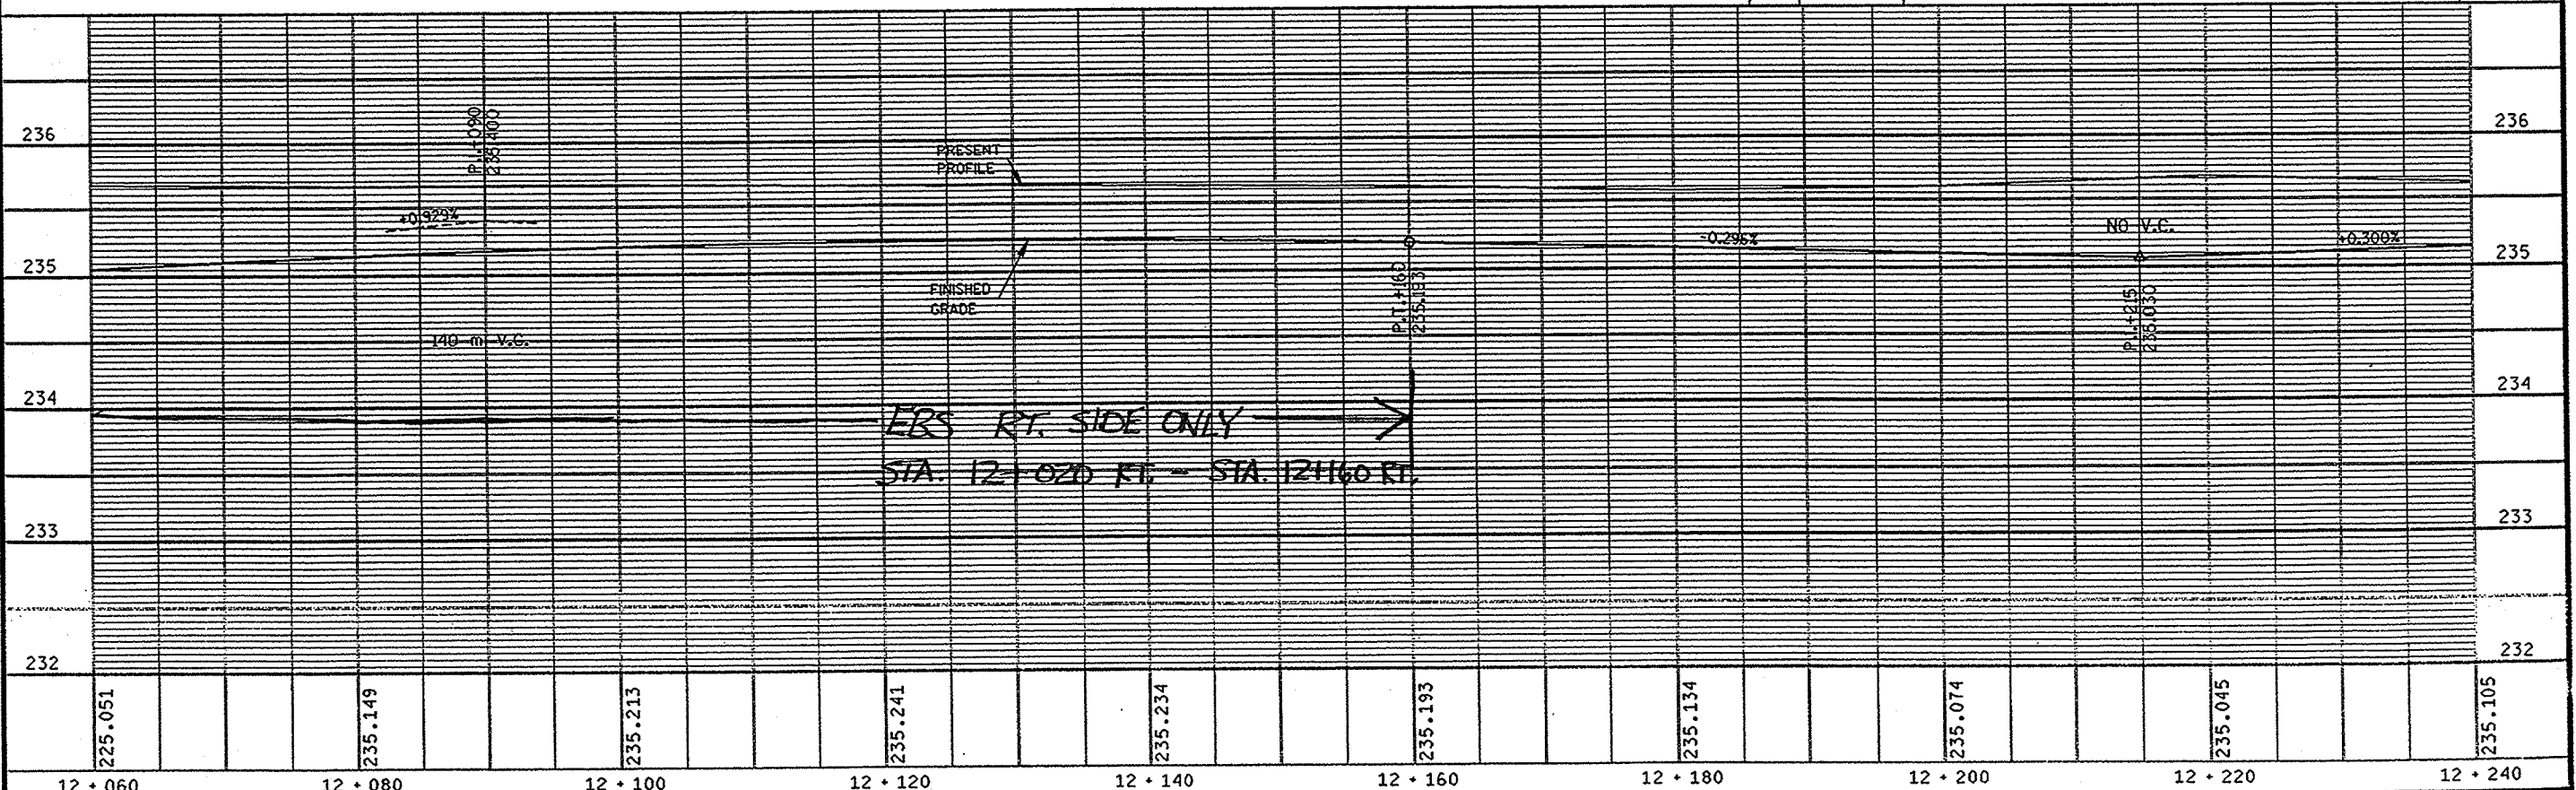


ORIGINATOR: JPZ
 PROJECT NO: 440278
 LEVELS ON: 1, 2, 3, 48, 50, 51, 52, 53, 54, 55, 56, 57, 58, 59, 60, 61, 62
 DATE: 11/25/98
 PLOT NAME: I:\440278\ dgn\pp14.dgn
 FILE NAME: #plot72#loser#mv80pp.tbl
 SCALE: 1:250
 PLOT NA: I:\440278\ dgn\pp14.dgn
 DESIGN FILE IS: I:\440278\ dgn\pp14.dgn

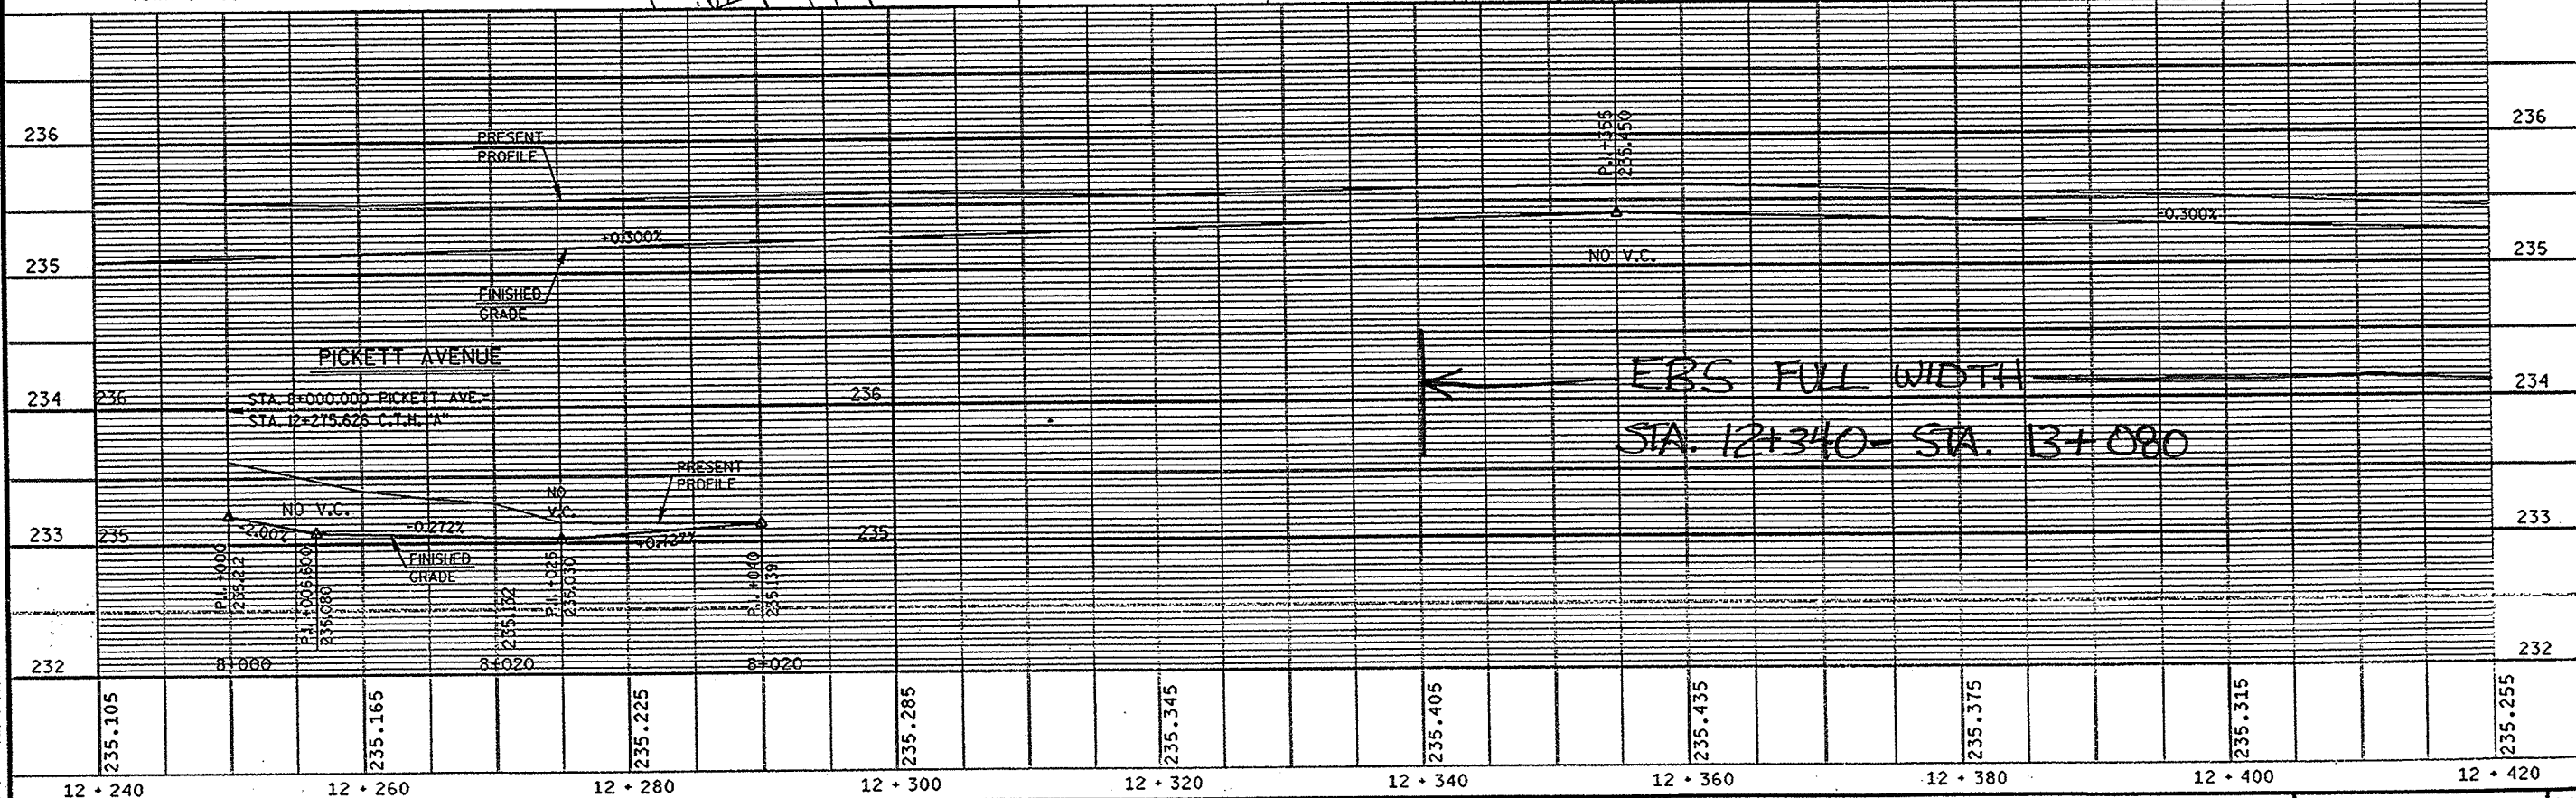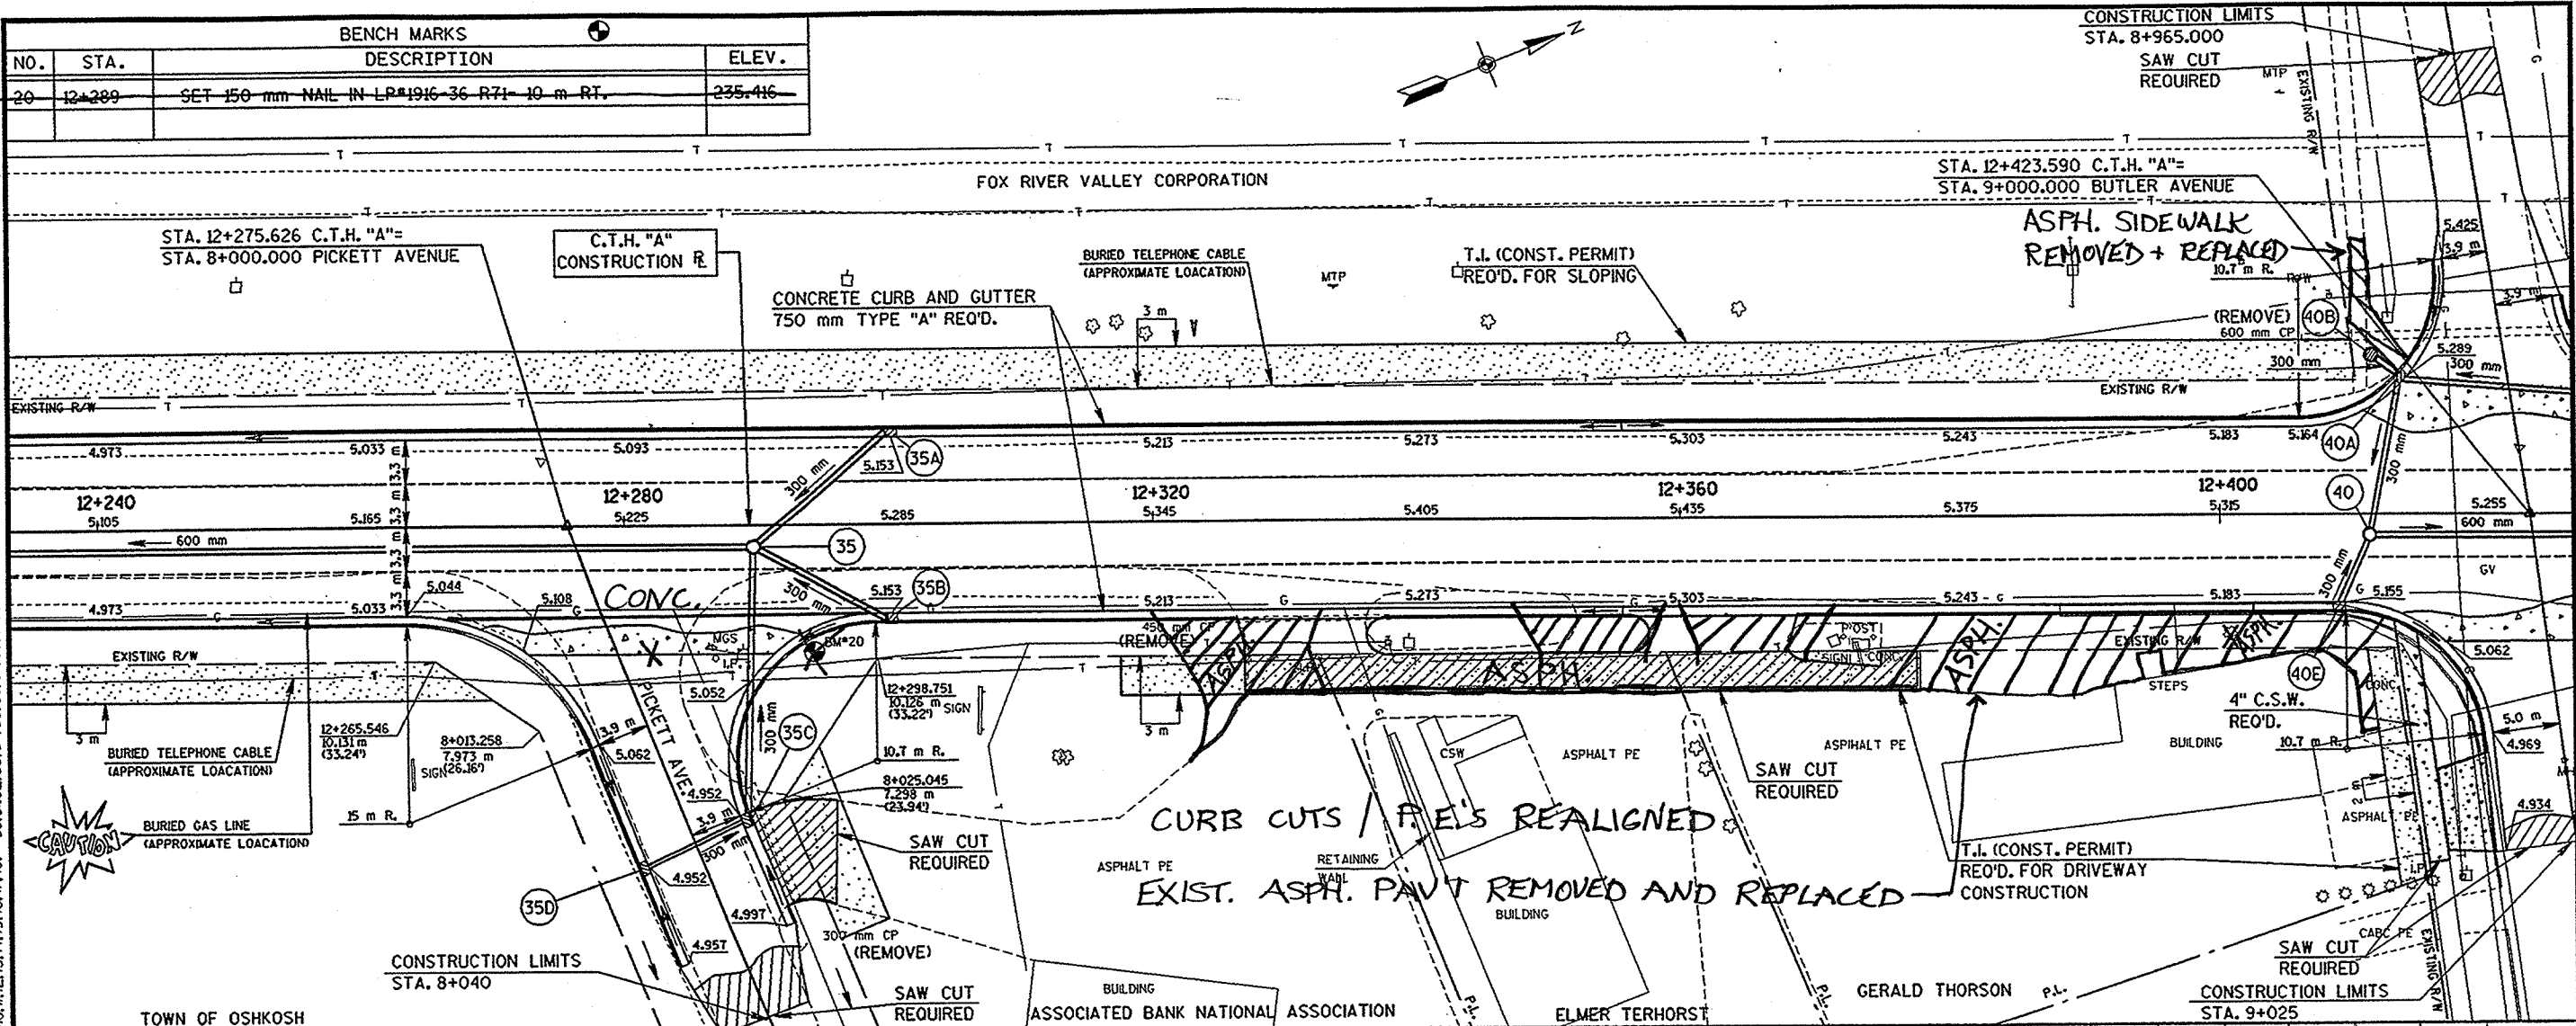


* ENDWALL (40D) ELIMINATED, 300 MM ROT STORM SEWER FROM (40C) TO (40D) ELIMINATED, CROSS SECTIONS FOR BUTLER AVE. WERE NOT CORRECT. A DITCH WAS NOT NECESSARY.

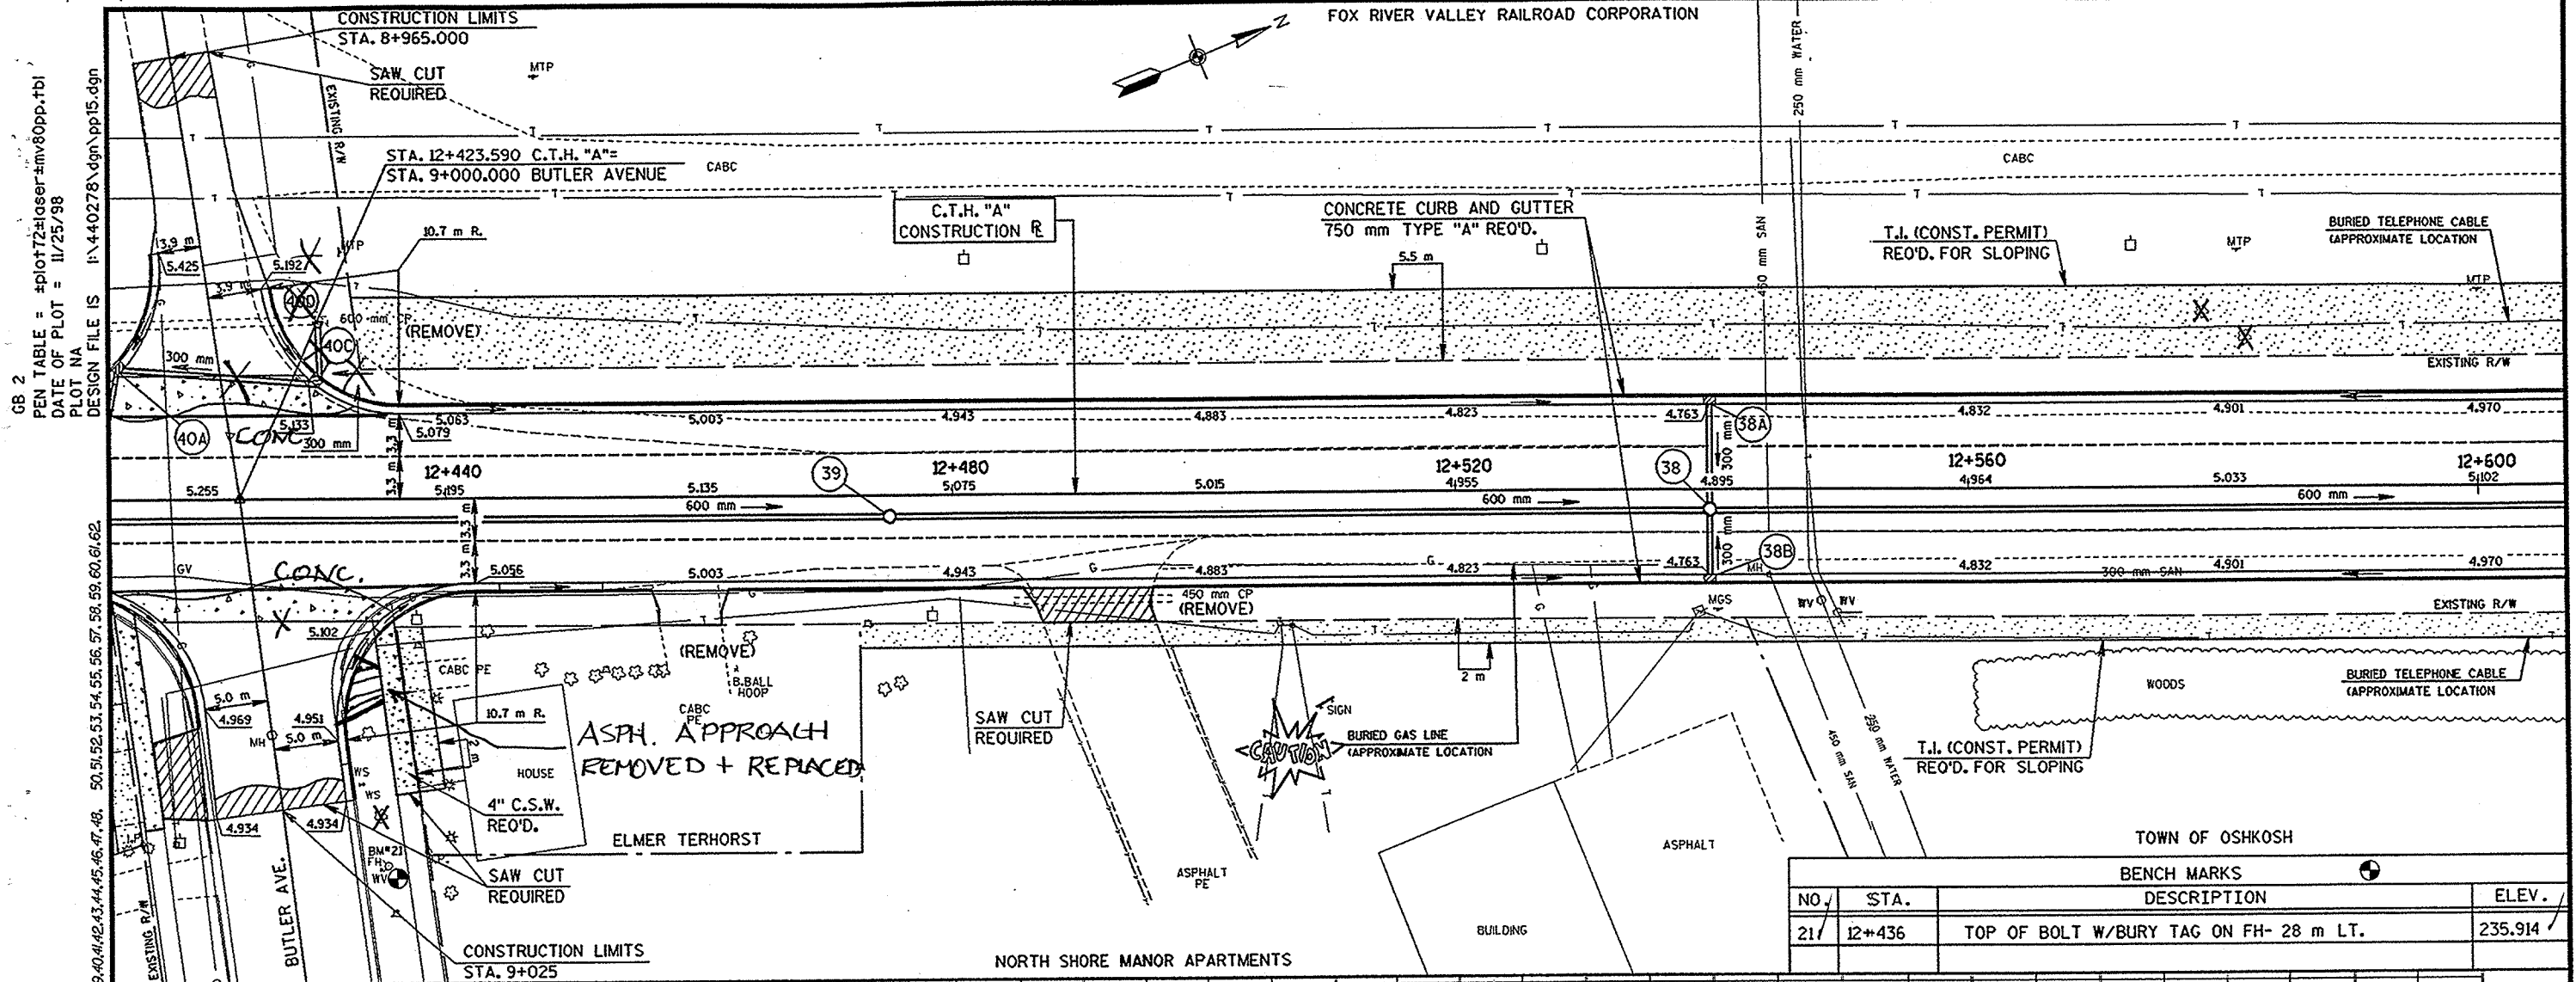

BENCH MARKS			
NO.	STA.	DESCRIPTION	ELEV.
21	12+436	TOP OF BOLT W/BURY TAG ON FH- 28 m LT.	235.914

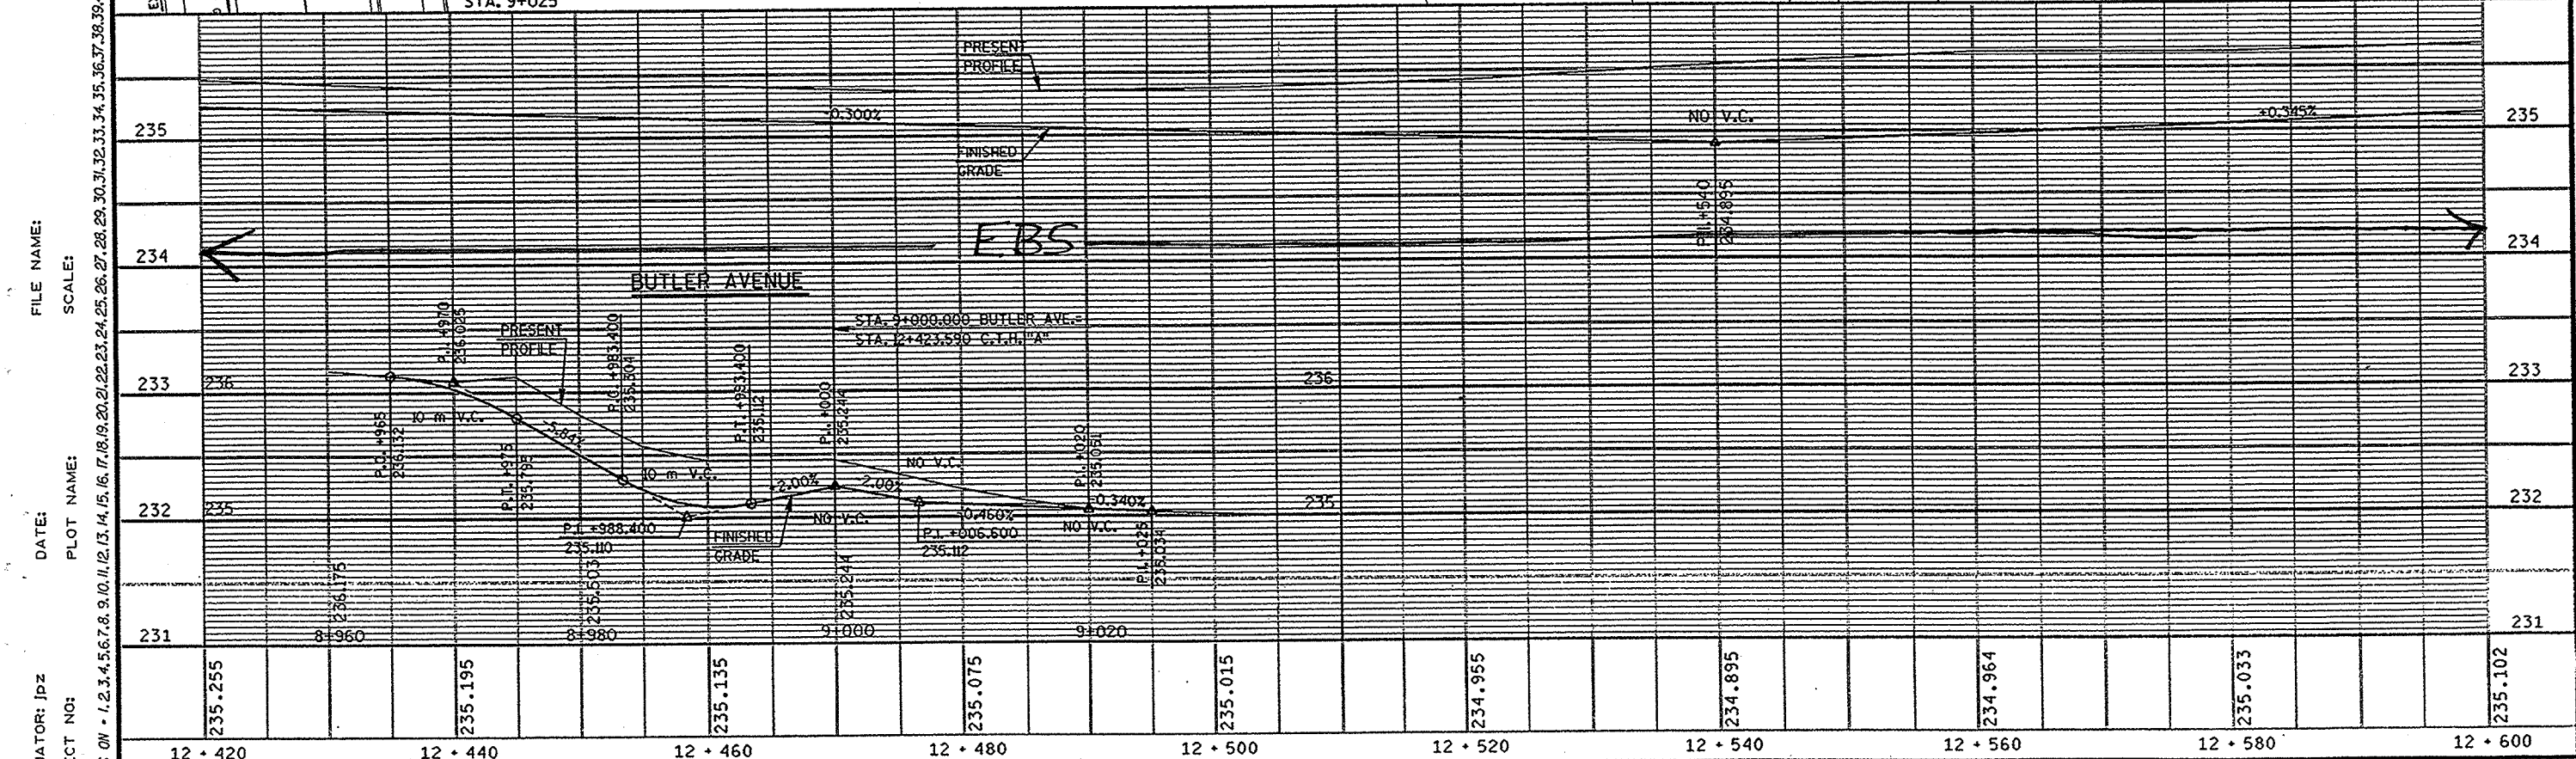


ORIGINATOR: jdz
 PROJECT NO: 4994-00-82
 LEVELS ON: 1, 2, 3, 48, 50, 51, 52, 53, 54, 55, 56, 57, 58, 59, 60, 61, 62
 FILE NAME: I:\440278\dgn\pp15.dgn
 PLOT NAME: 11/25/98
 DATE: 11/25/98
 PEN TABLE: #plot72\user\mv80pp.tbl
 GB 2

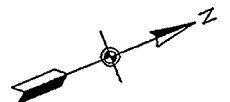


AN EXISTING STORM PIPE WAS FOUND THAT TIED INTO THE EXISTING INLET AT (36B) LOCATION. THE PIPE WAS TIED INTO (36B) USING PVC FITTINGS.


GB 2
 FILE NAME: #plot72+igser=mv80pp.tbl
 DATE OF PLOT = 11/25/98
 PLOT NO.
 DESIGN FILE IS I:\440278\dgn\pp16.dgn

ORIGINATOR: jpz
 PROJECT NO:
 LEVELS ON = 1, 2, 3, 48, 50, 51, 52, 53, 54, 55, 56, 57, 58, 59, 60, 61, 62.
 DATE:
 PLOT NAME:
 SCALE:

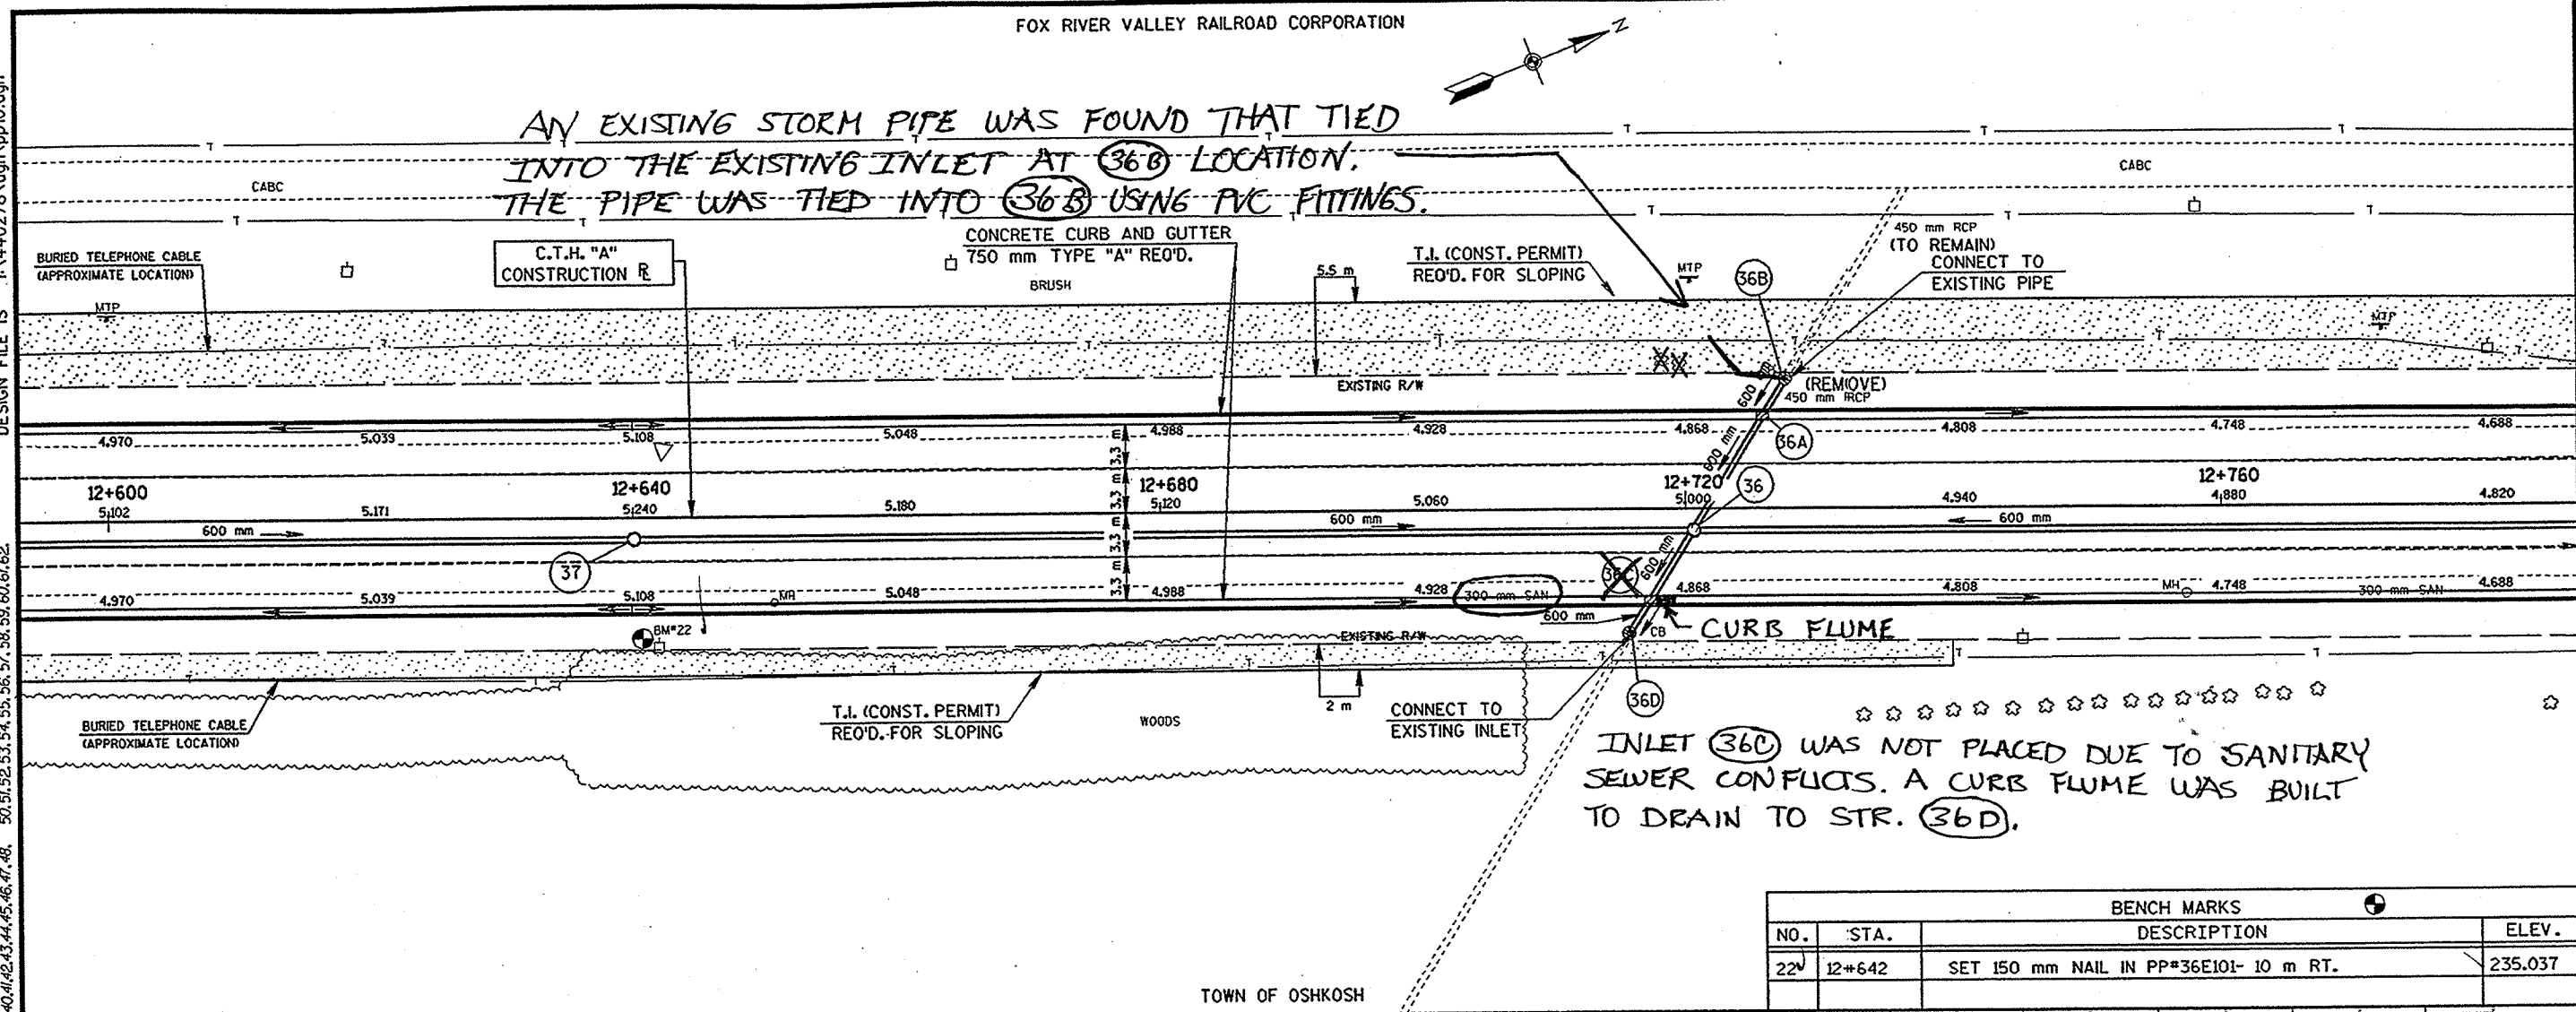


BENCH MARKS			
NO.	STA.	DESCRIPTION	ELEV.
22	12+642	SET 150 mm NAIL IN PP#36E101- 10 m RT.	235.037

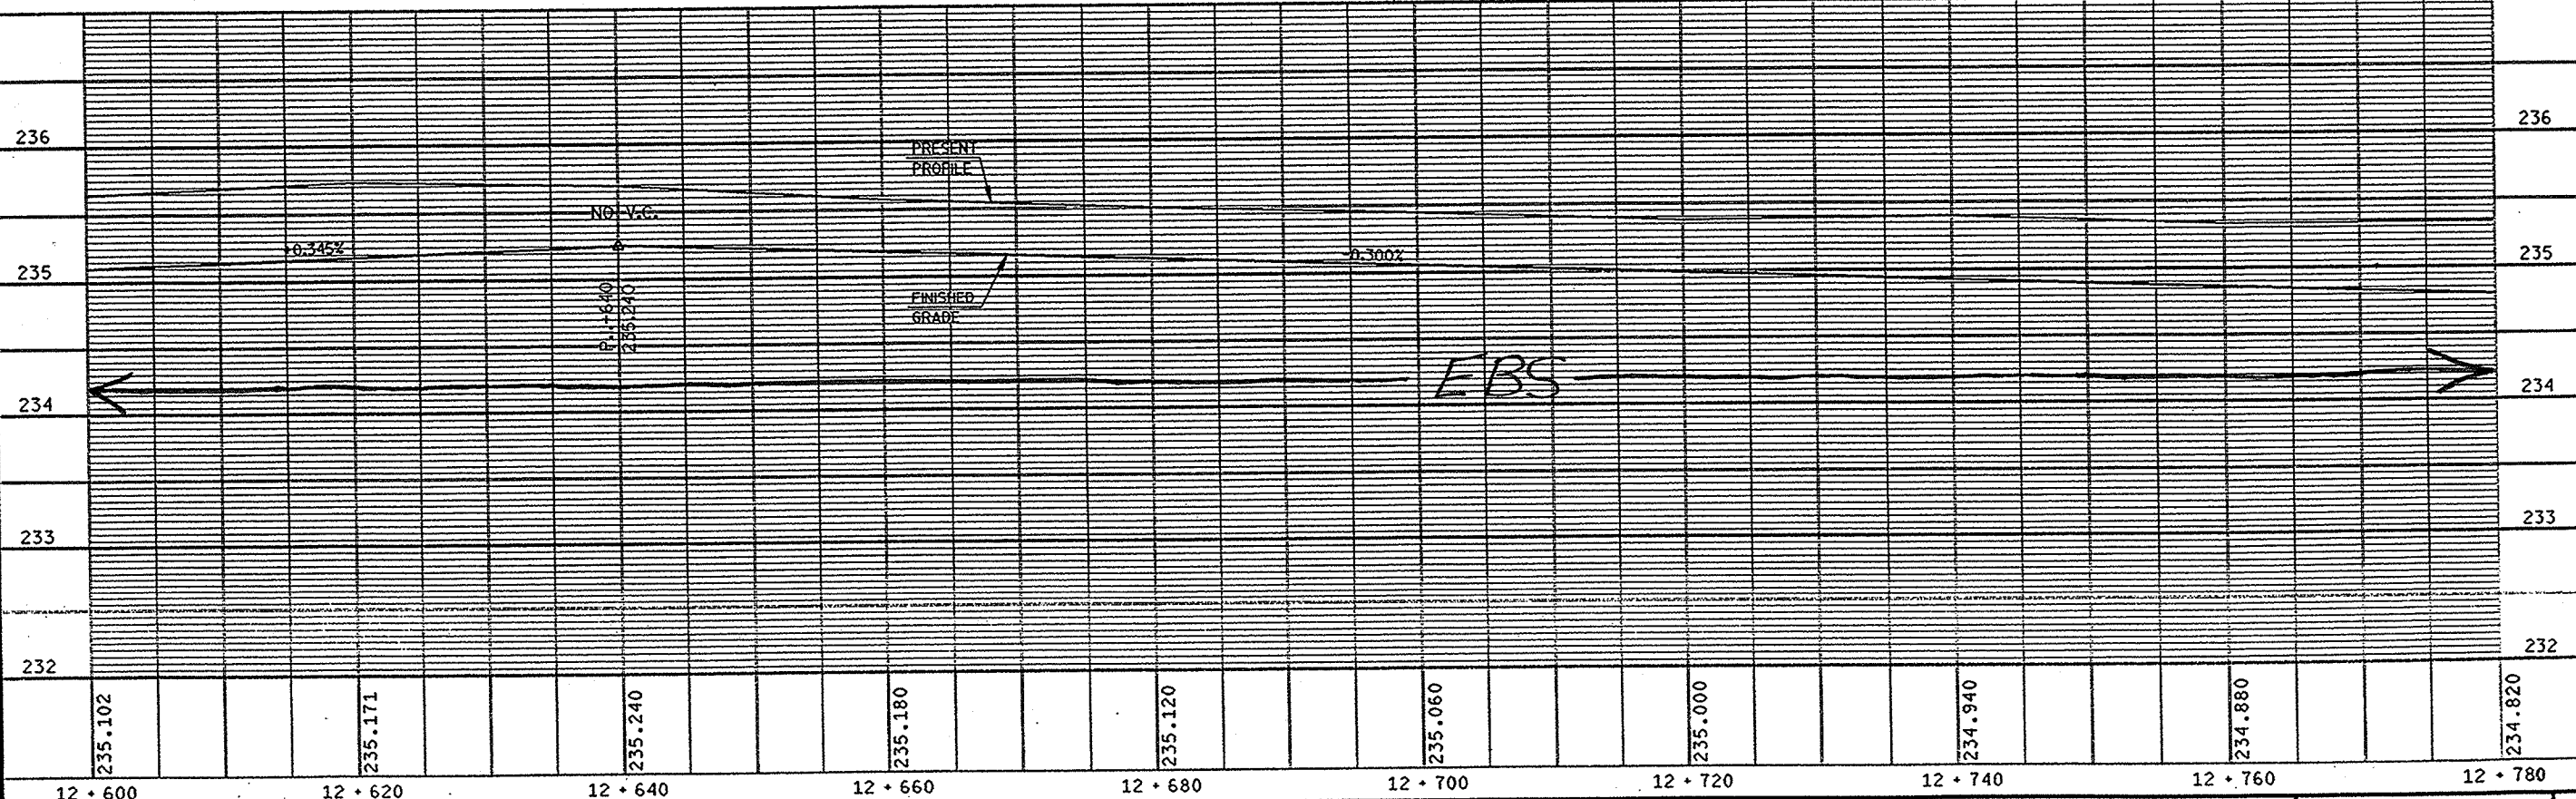

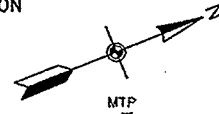


GB 2
 PEN TABLE = #plot12\user\mv80dp.tbl
 DATE OF PLOT = 11/25/98
 PLOT NA
 DESIGN FILE IS I:\440278\dgn\pp17.dgn

ORIGINATOR: JPZ
 PROJECT NO: 440278
 LEVELS ON = 1, 2, 3, 48, 50, 51, 52, 53, 54, 55, 56, 57, 58, 59, 60, 61, 62
 FILE NAME:
 SCALE:
 DATE: 02/25/98
 PLOT NAME:

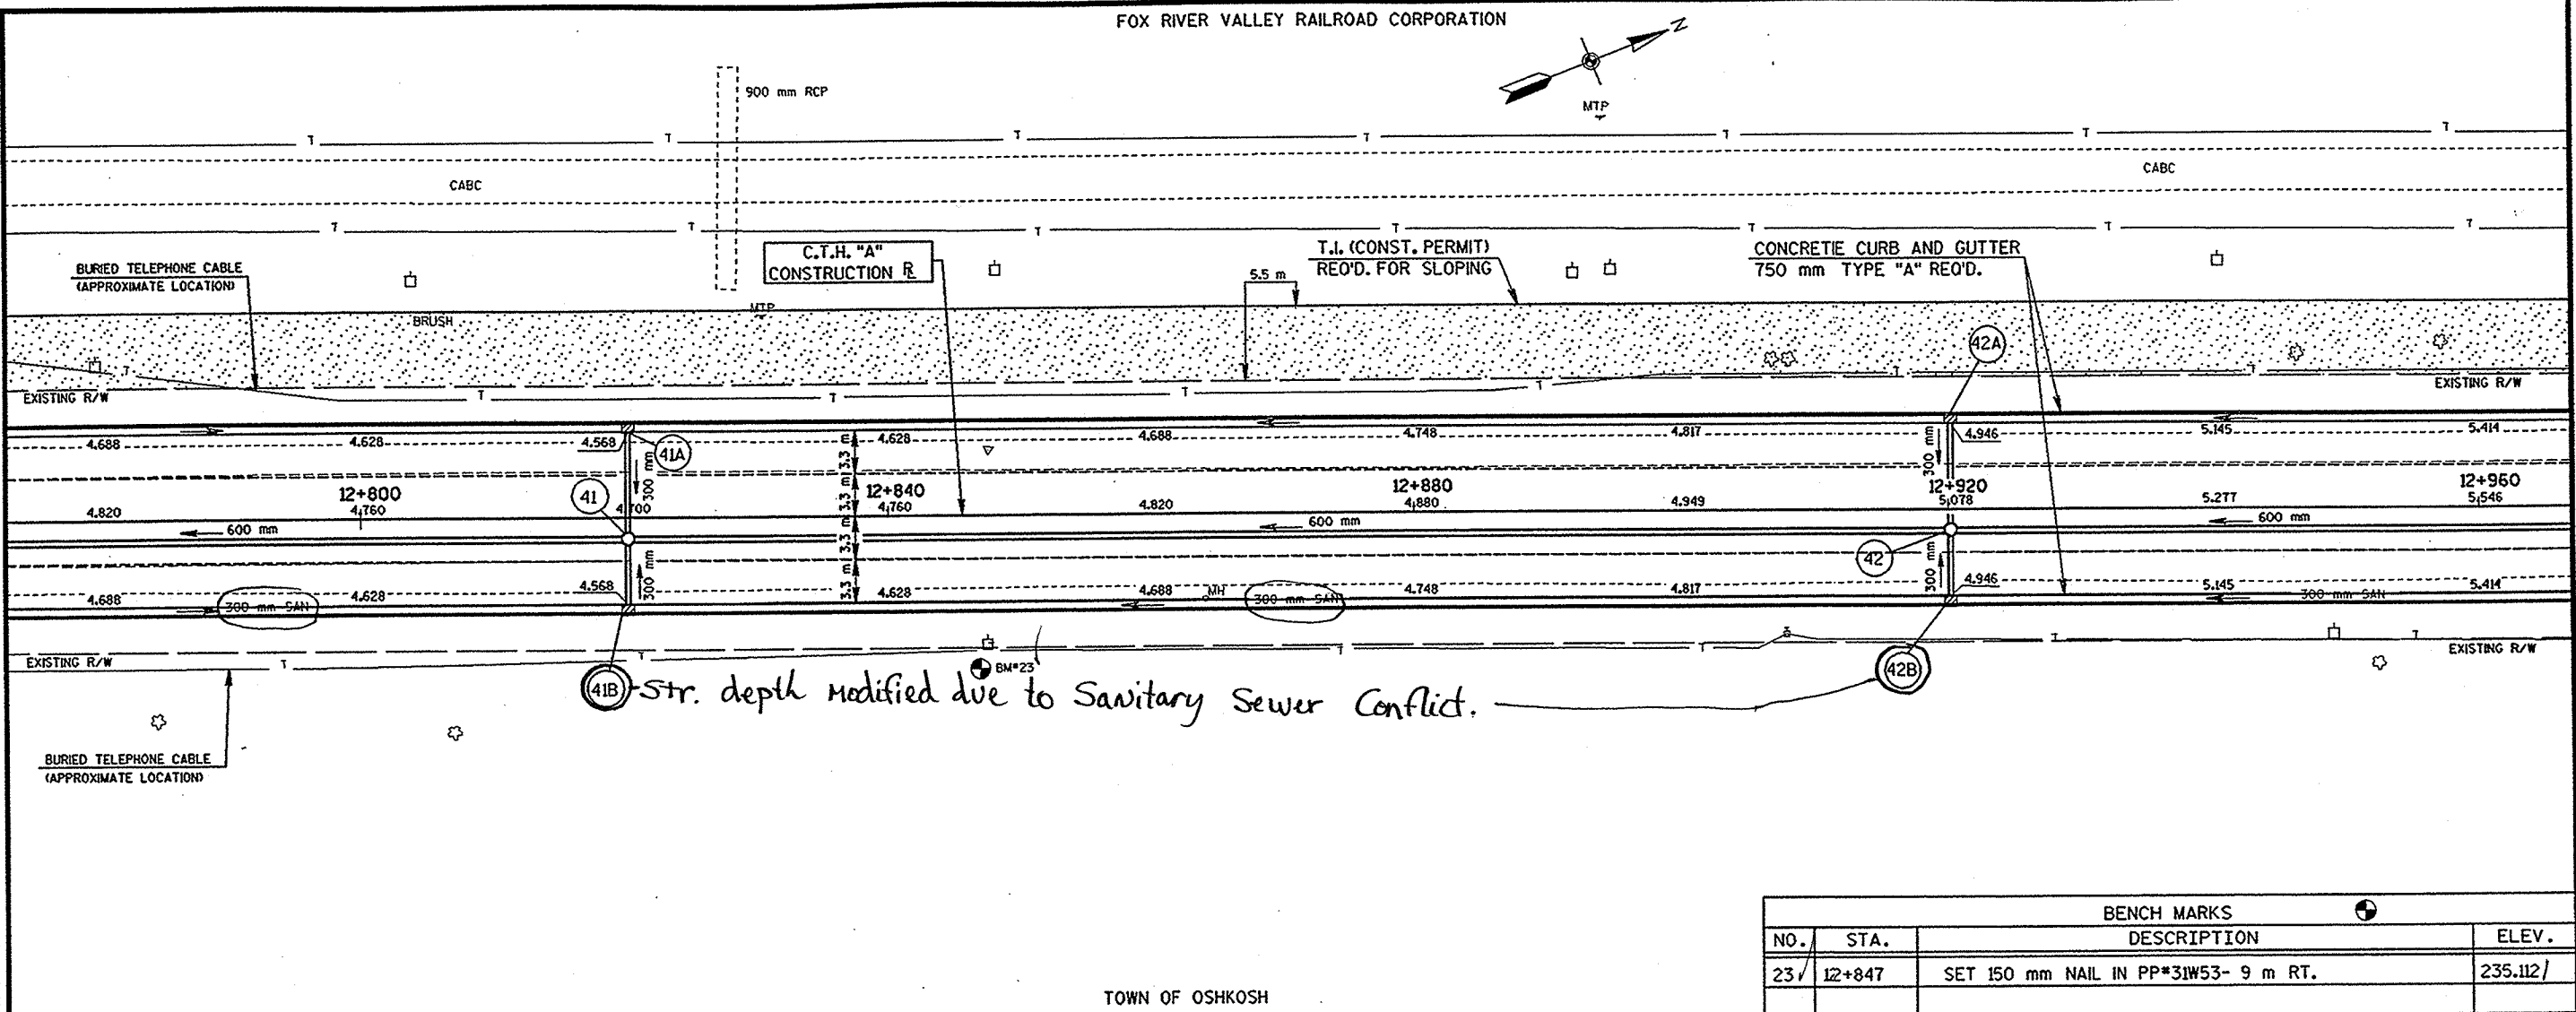


BENCH MARKS			
NO.	STA.	DESCRIPTION	ELEV.
237	12+847	SET 150 mm NAIL IN PP*31W53- 9 m RT.	235.112

TOWN OF OSHKOSH

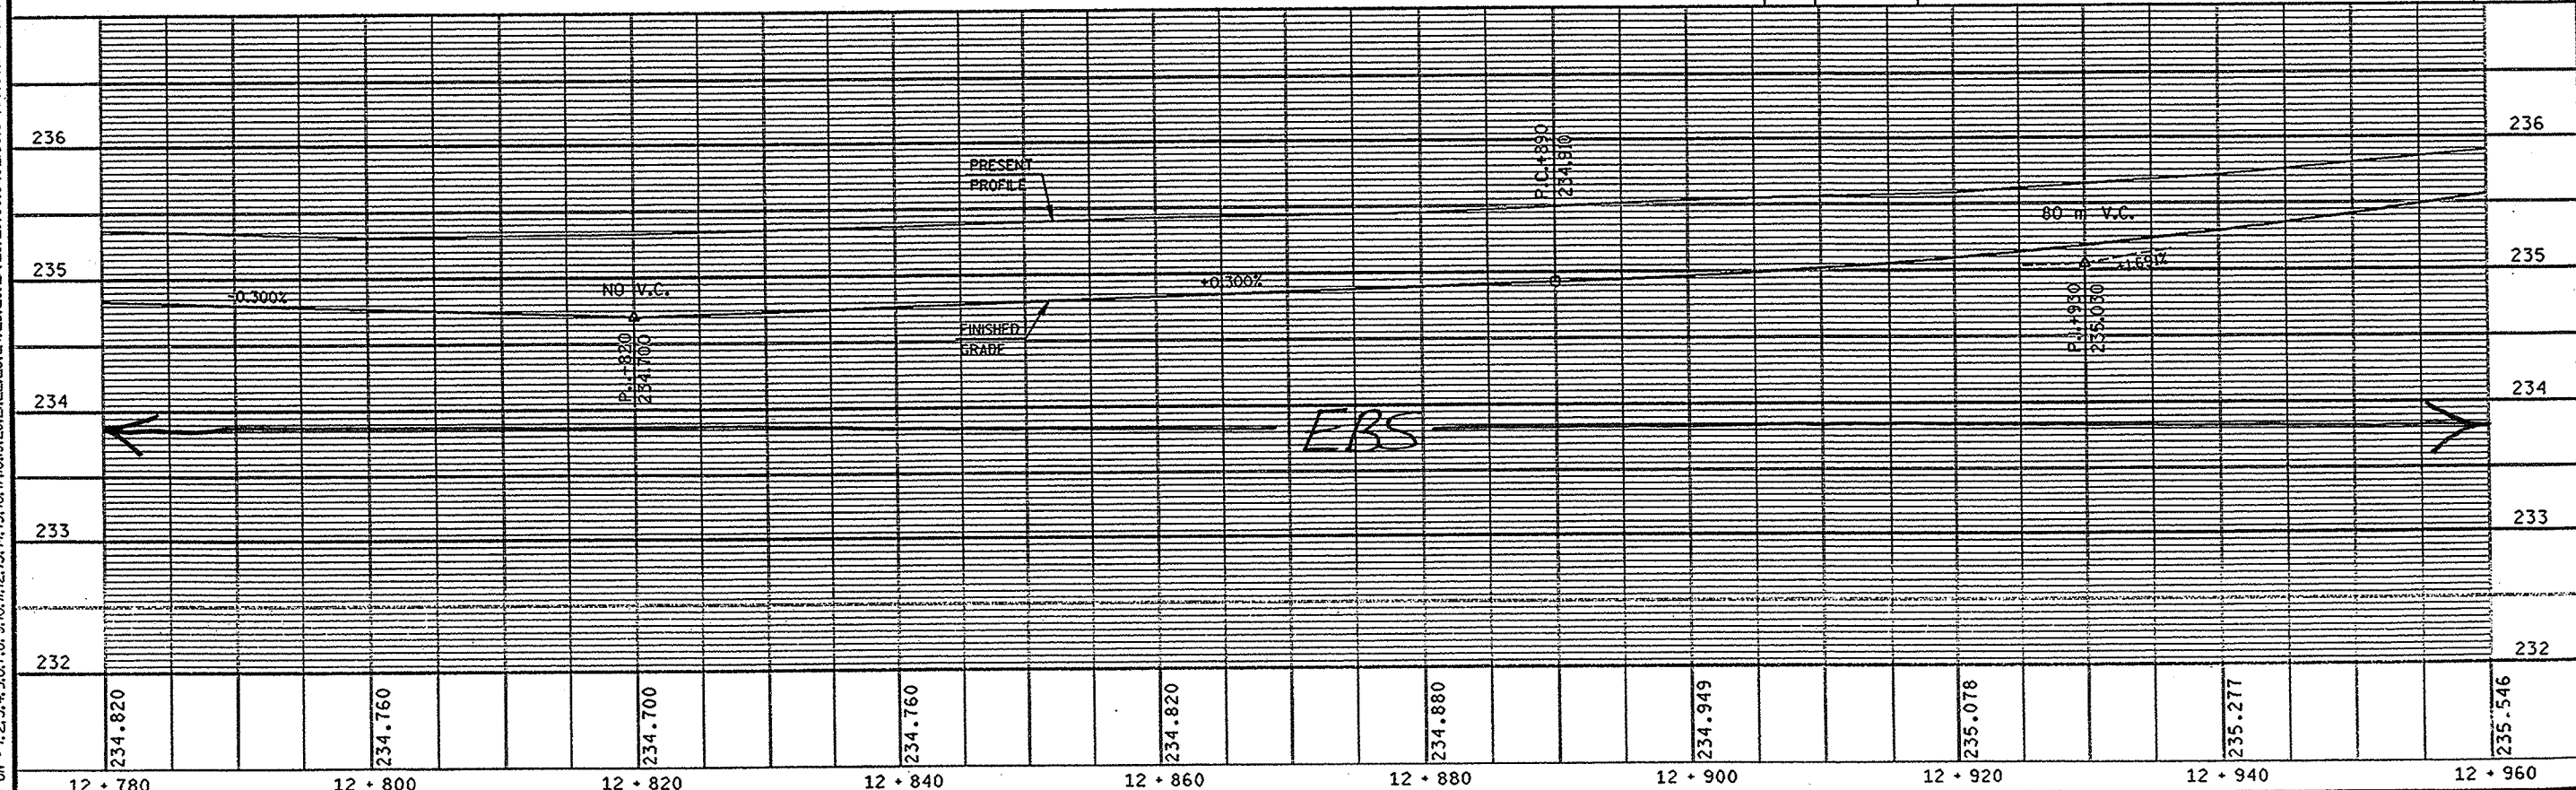


FOX RIVER VALLEY RAILROAD CORPORATION

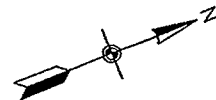


GB 2
 PEN TABLE = #plot724loser+mv80pp.tbl
 DATE OF PLOT = 11/25/98
 PLOT NA
 DESIGN FILE IS I:\440278\dgn\pp18.dgn

FILE NAME: SCALE: DATE: PLOT NAME: ORIGINATOR: DJD PROJECT NO: LEVELS ON = 1, 2, 3, 48, 50, 51, 52, 53, 54, 55, 56, 57, 58, 59, 60, 61, 62

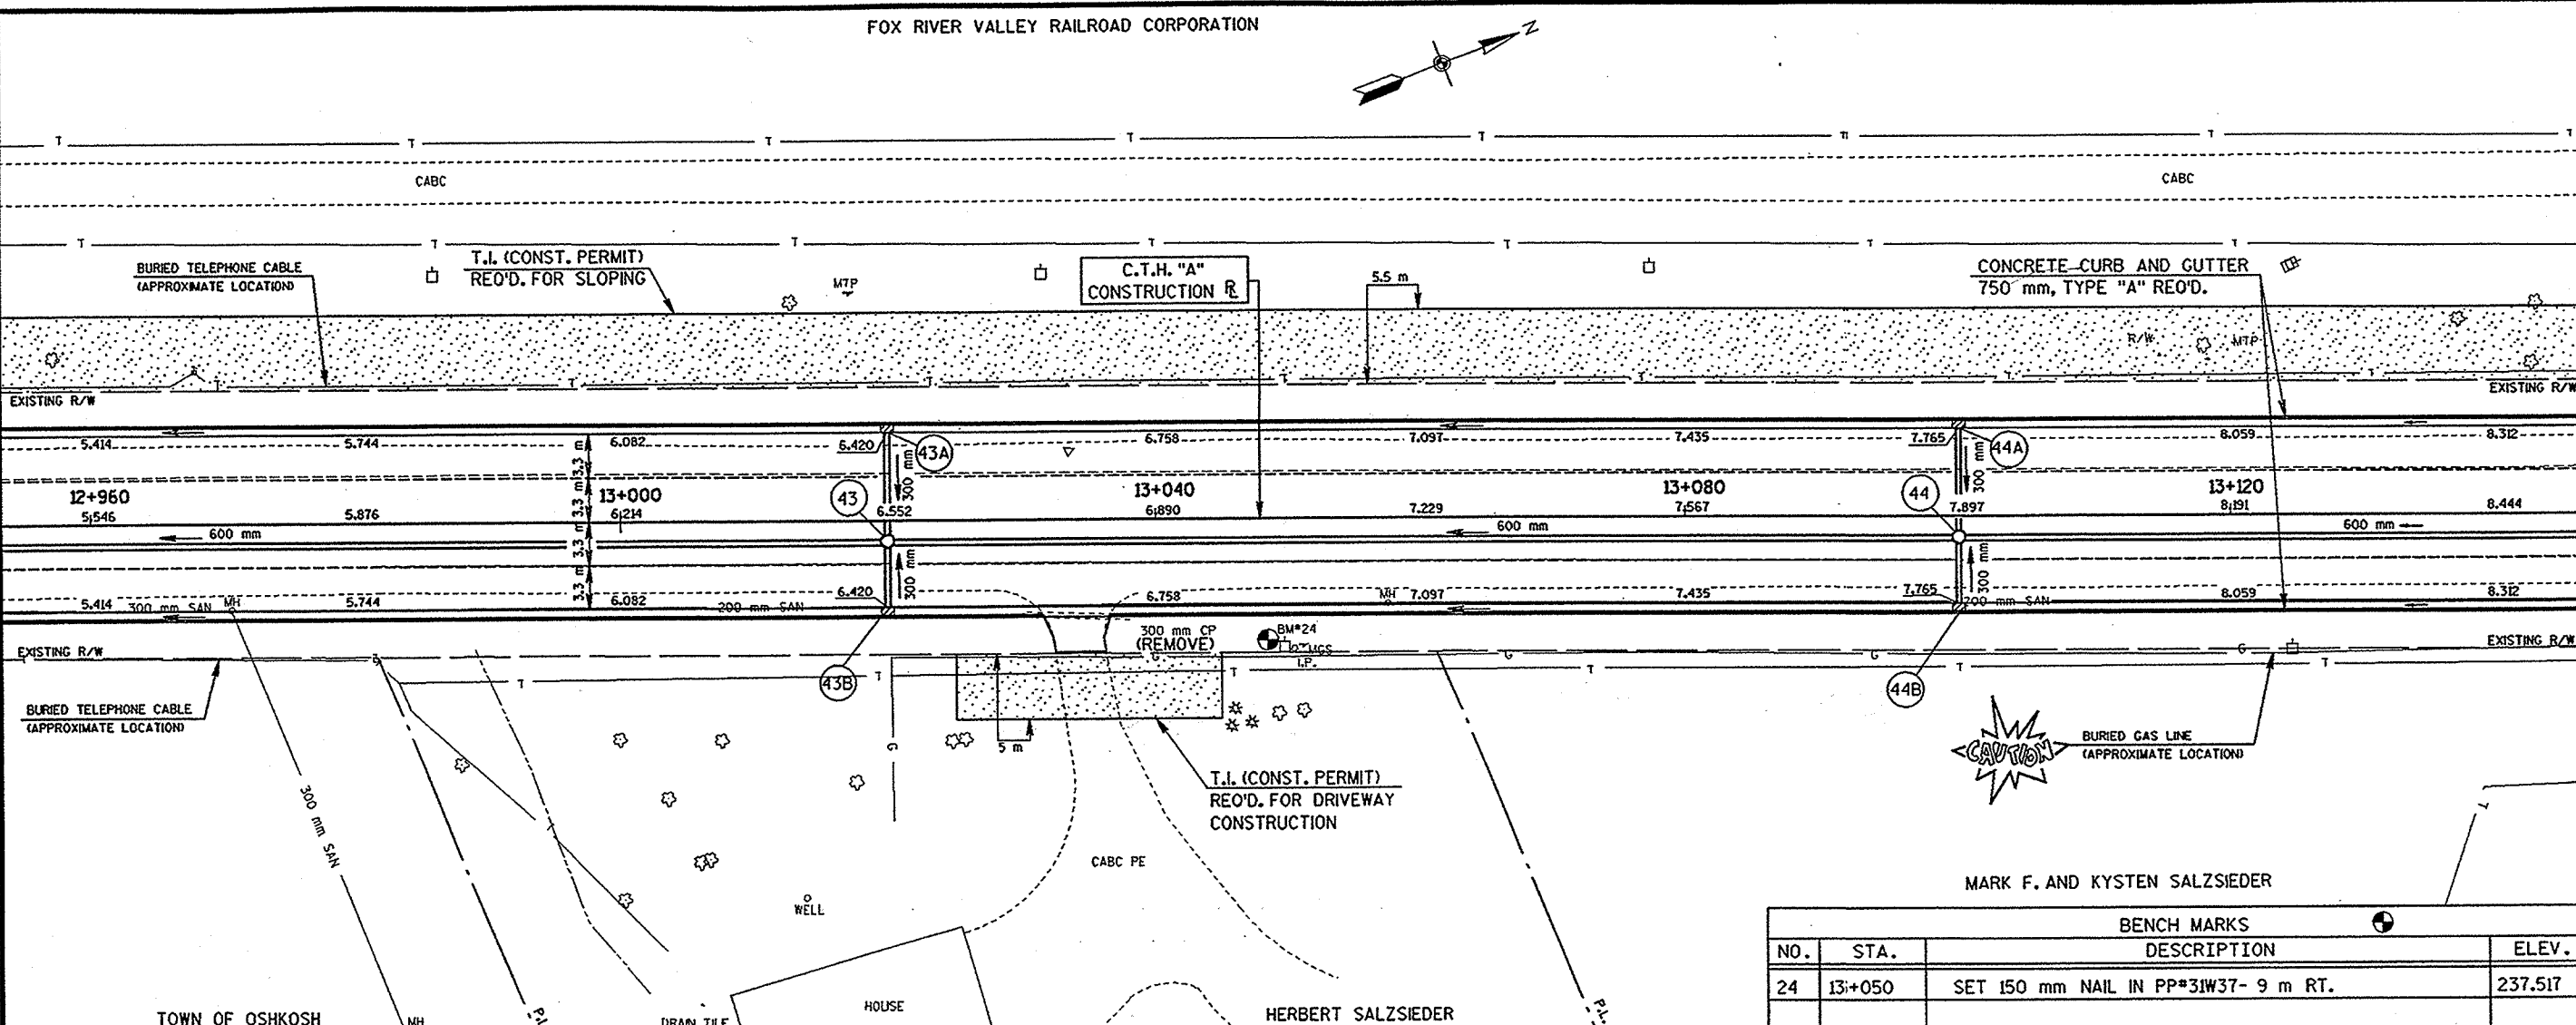

BENCH MARKS			
NO.	STA.	DESCRIPTION	ELEV.
24	13+050	SET 150 mm NAIL IN PP#31W37- 9 m RT.	237.517

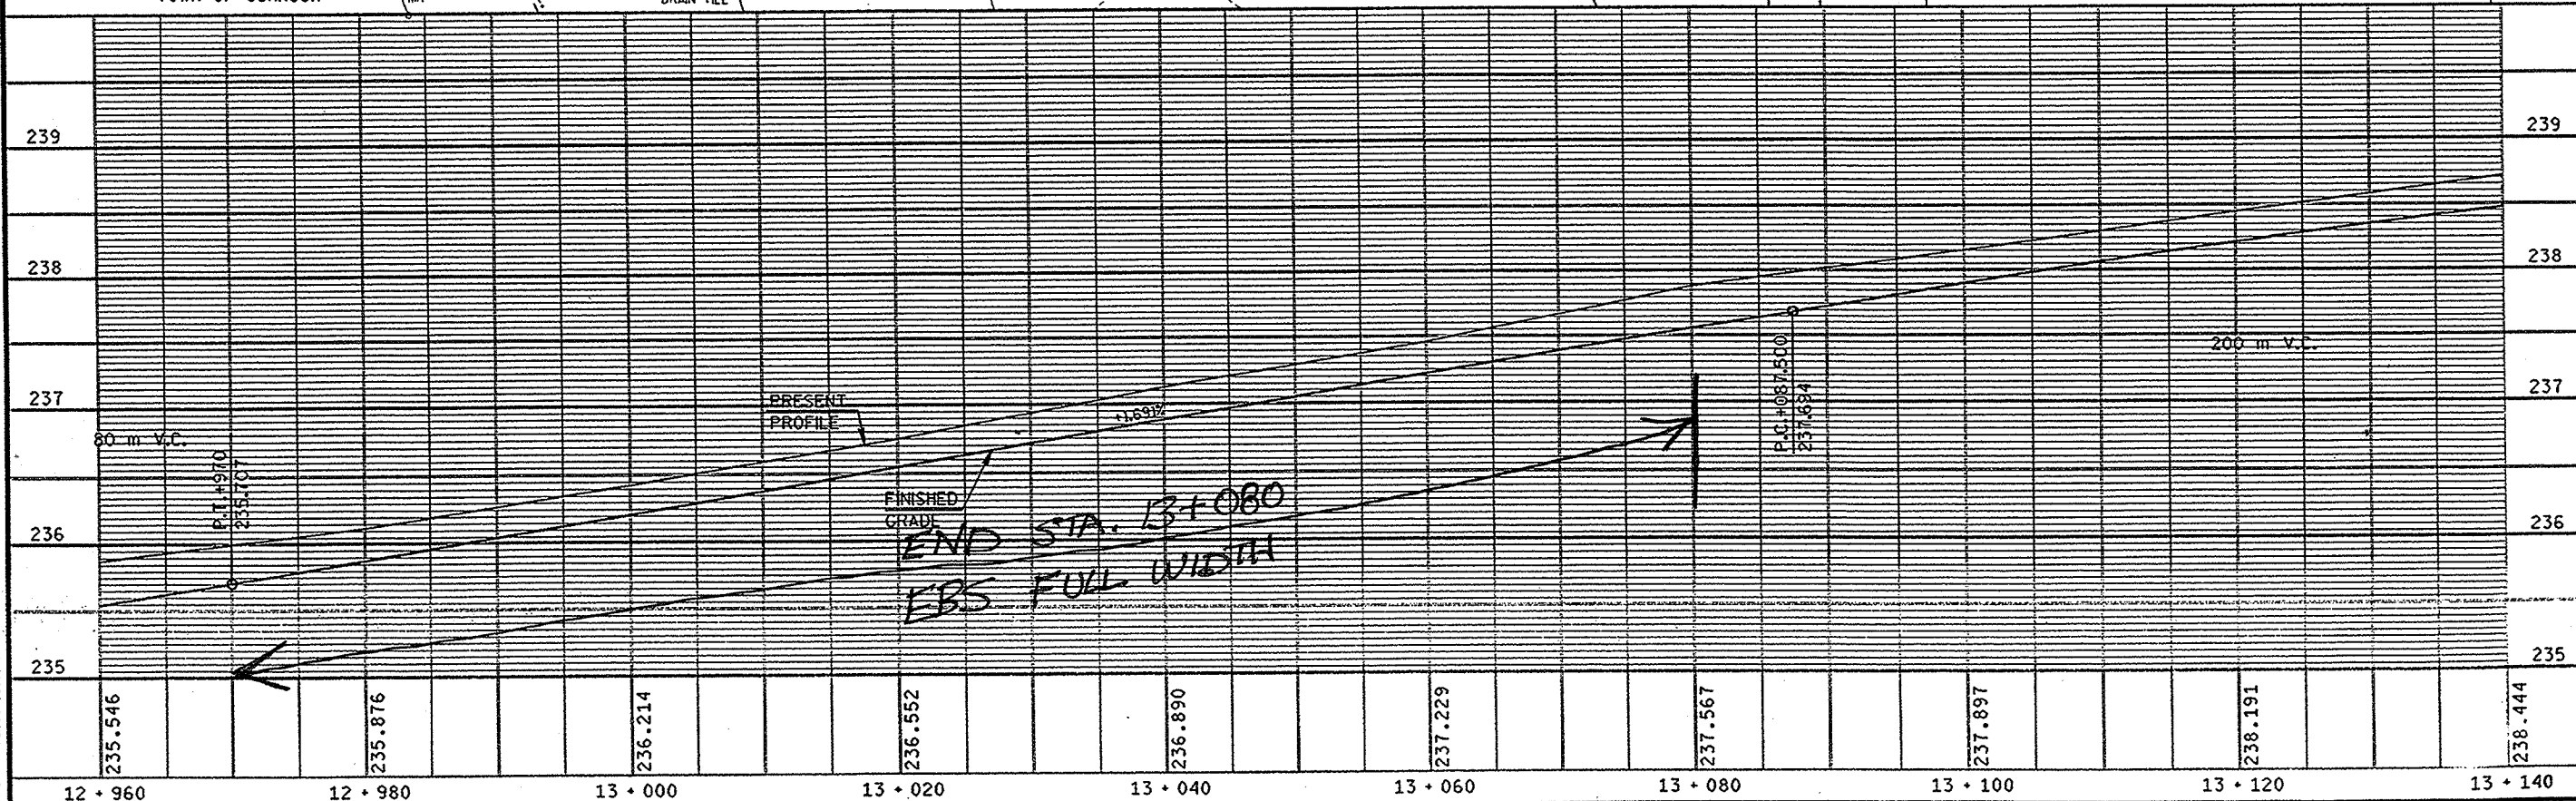



ORIGINATOR: DJD
 PROJECT NO: 4994-00-82
 DATE: 5/1/00
 FILE NAME: #plot#laser#mv80pp.tbl
 PLOT NAME: 5/1/00
 SCALE: 1:100
 LEVELS ON: 1, 2, 3, 61, 62

BENCH MARKS			
NO.	STA.	DESCRIPTION	ELEV.
25	13+193	SET 150 mm NAIL IN PP*31W31- 10 m LT.	239.492
26	13+319	TOP OF BOLT W/BURY TAG ON FH- 18 m LT.	239.488



FOX VALLEY RAILROAD CORPORATION

CONSTRUCTION LIMITS
 STA. 9+957.00,
 SAW CUT REQ'D.


REVISED SHEET
 REVISED 5/1/00
 FOX VALLEY
 RAILROAD CORP.

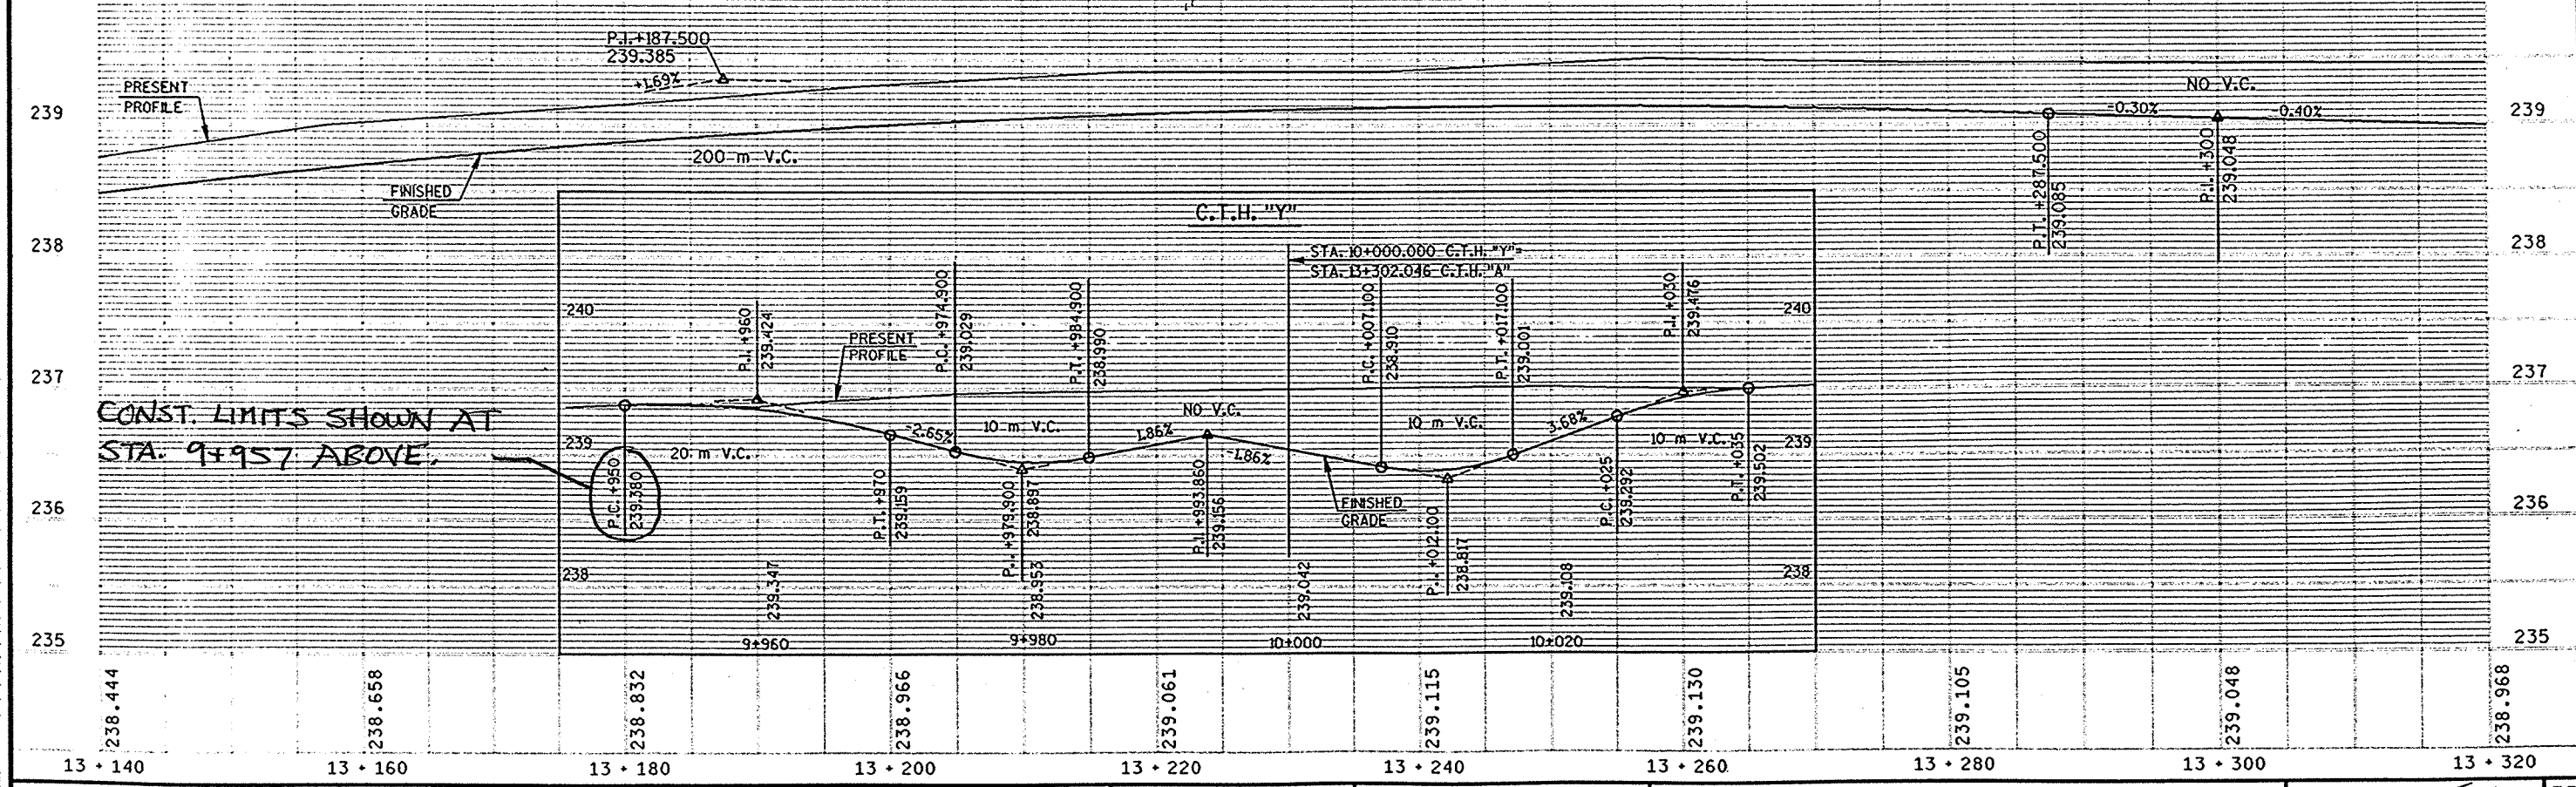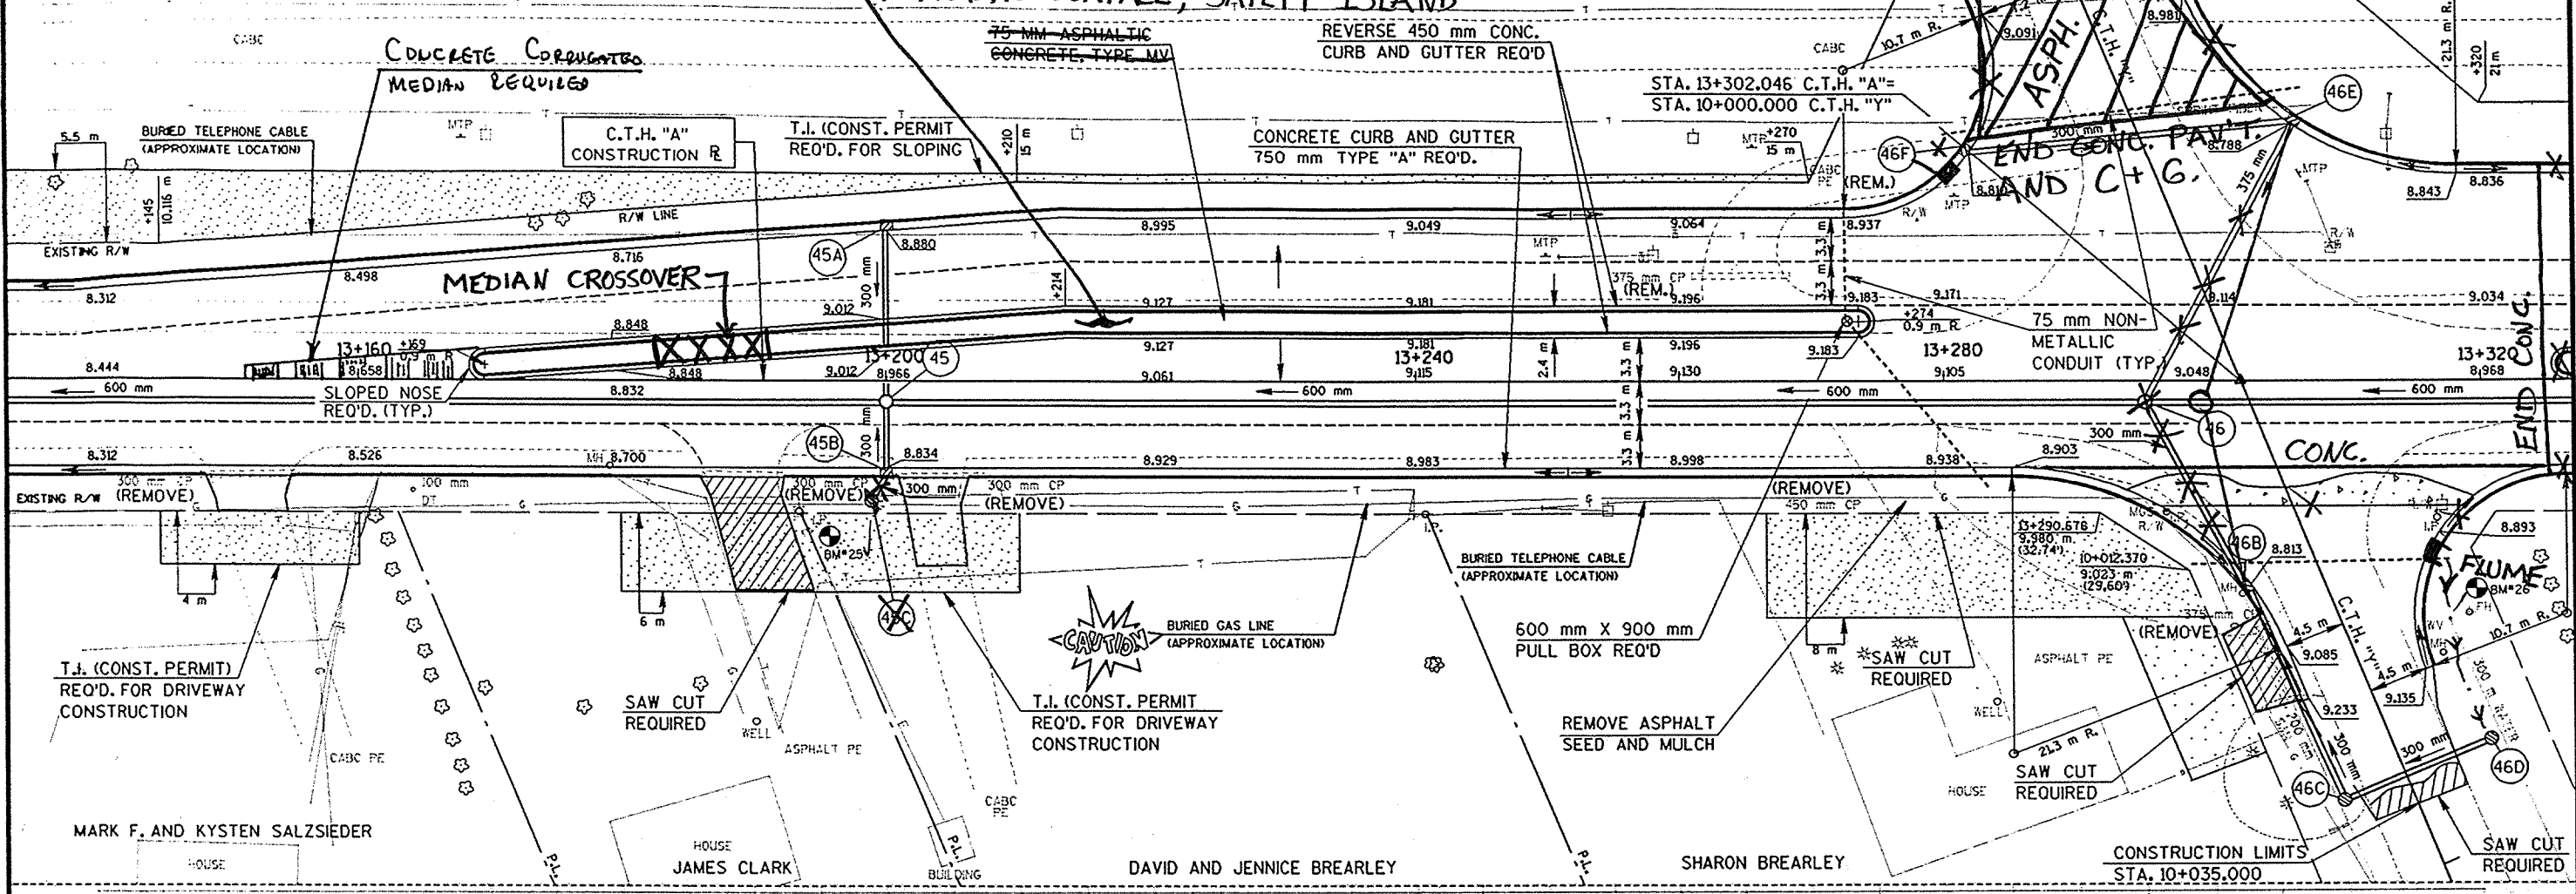

ORIGINATOR: DJD
 PROJECT NO: 4994-00-82
 LEVELS ON: 1, 2, 3, 48, 50, 51, 52, 53, 54, 55, 56, 57, 58, 59, 60, 61, 62
 FILE NAME: #plot7240ser+mv80pp.tbl
 DATE OF PLOT = 11/25/98
 PLOT NA: 4994-00-82
 DESIGN FILE IS: I:\440278\dgn\pp19.dgn

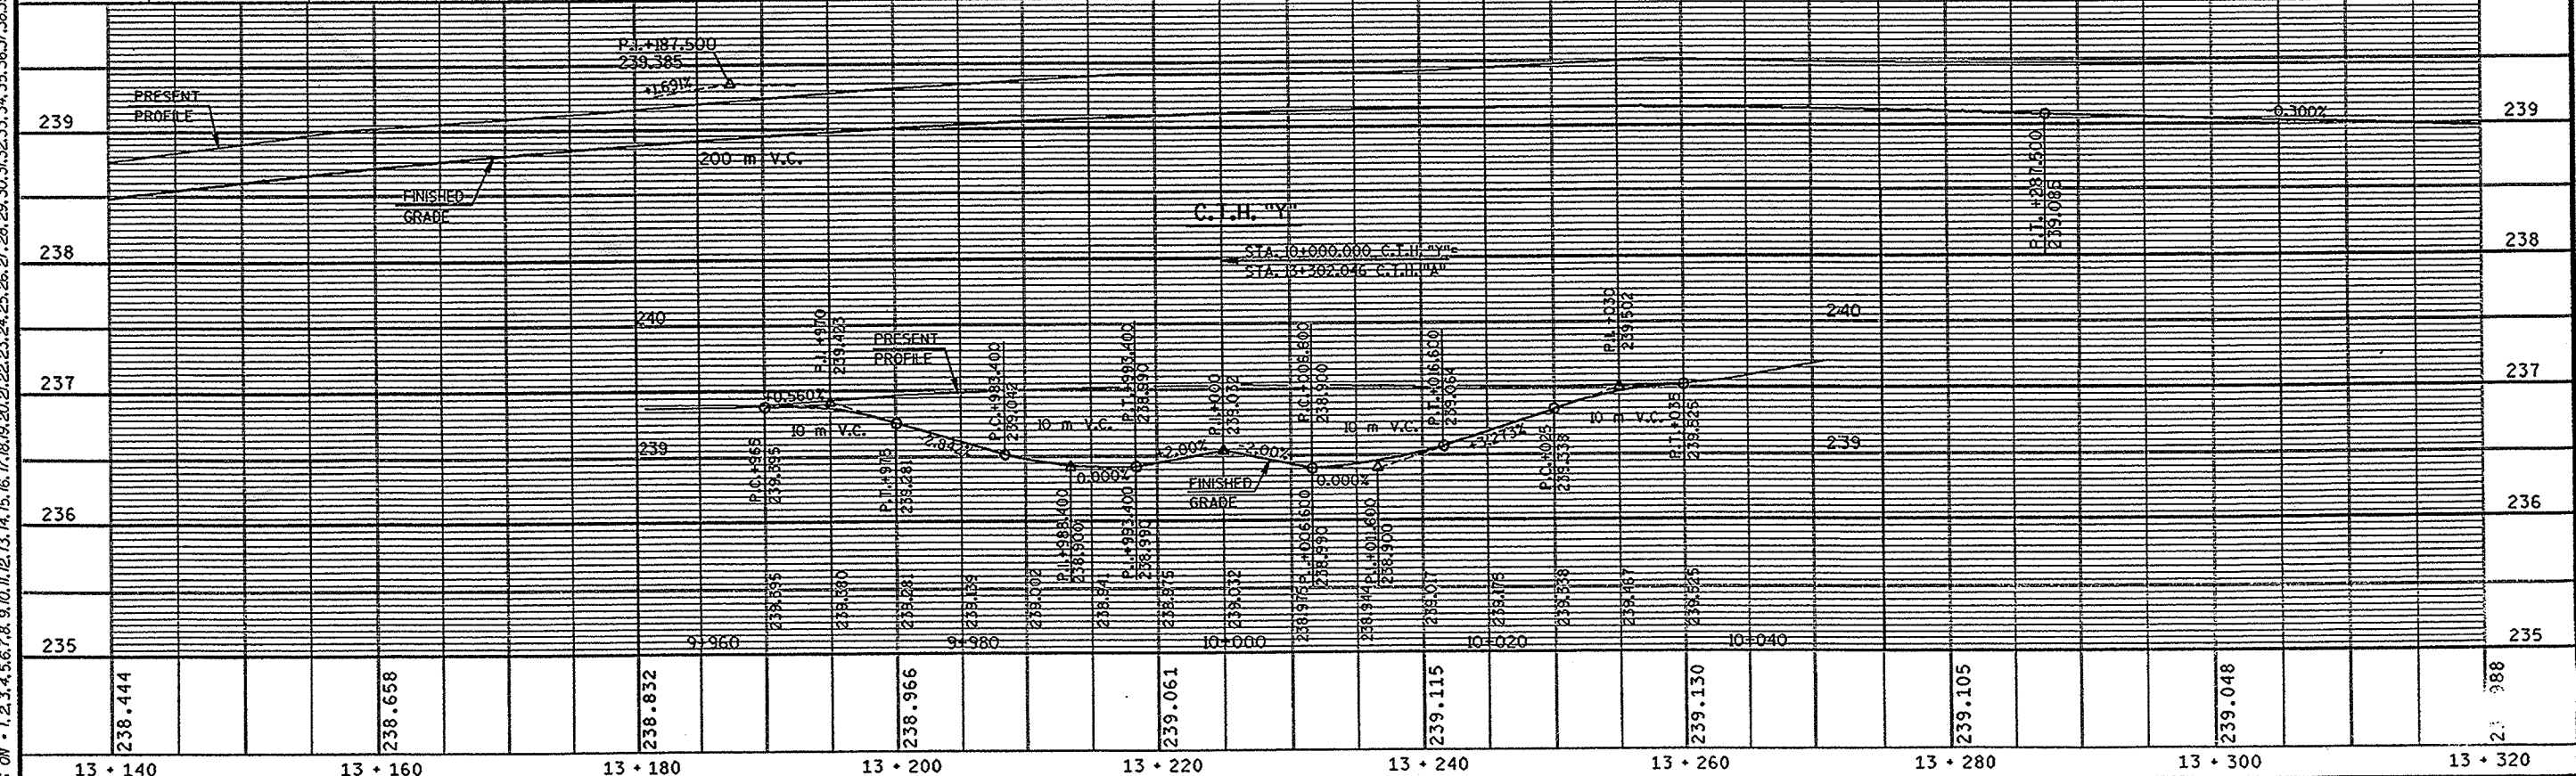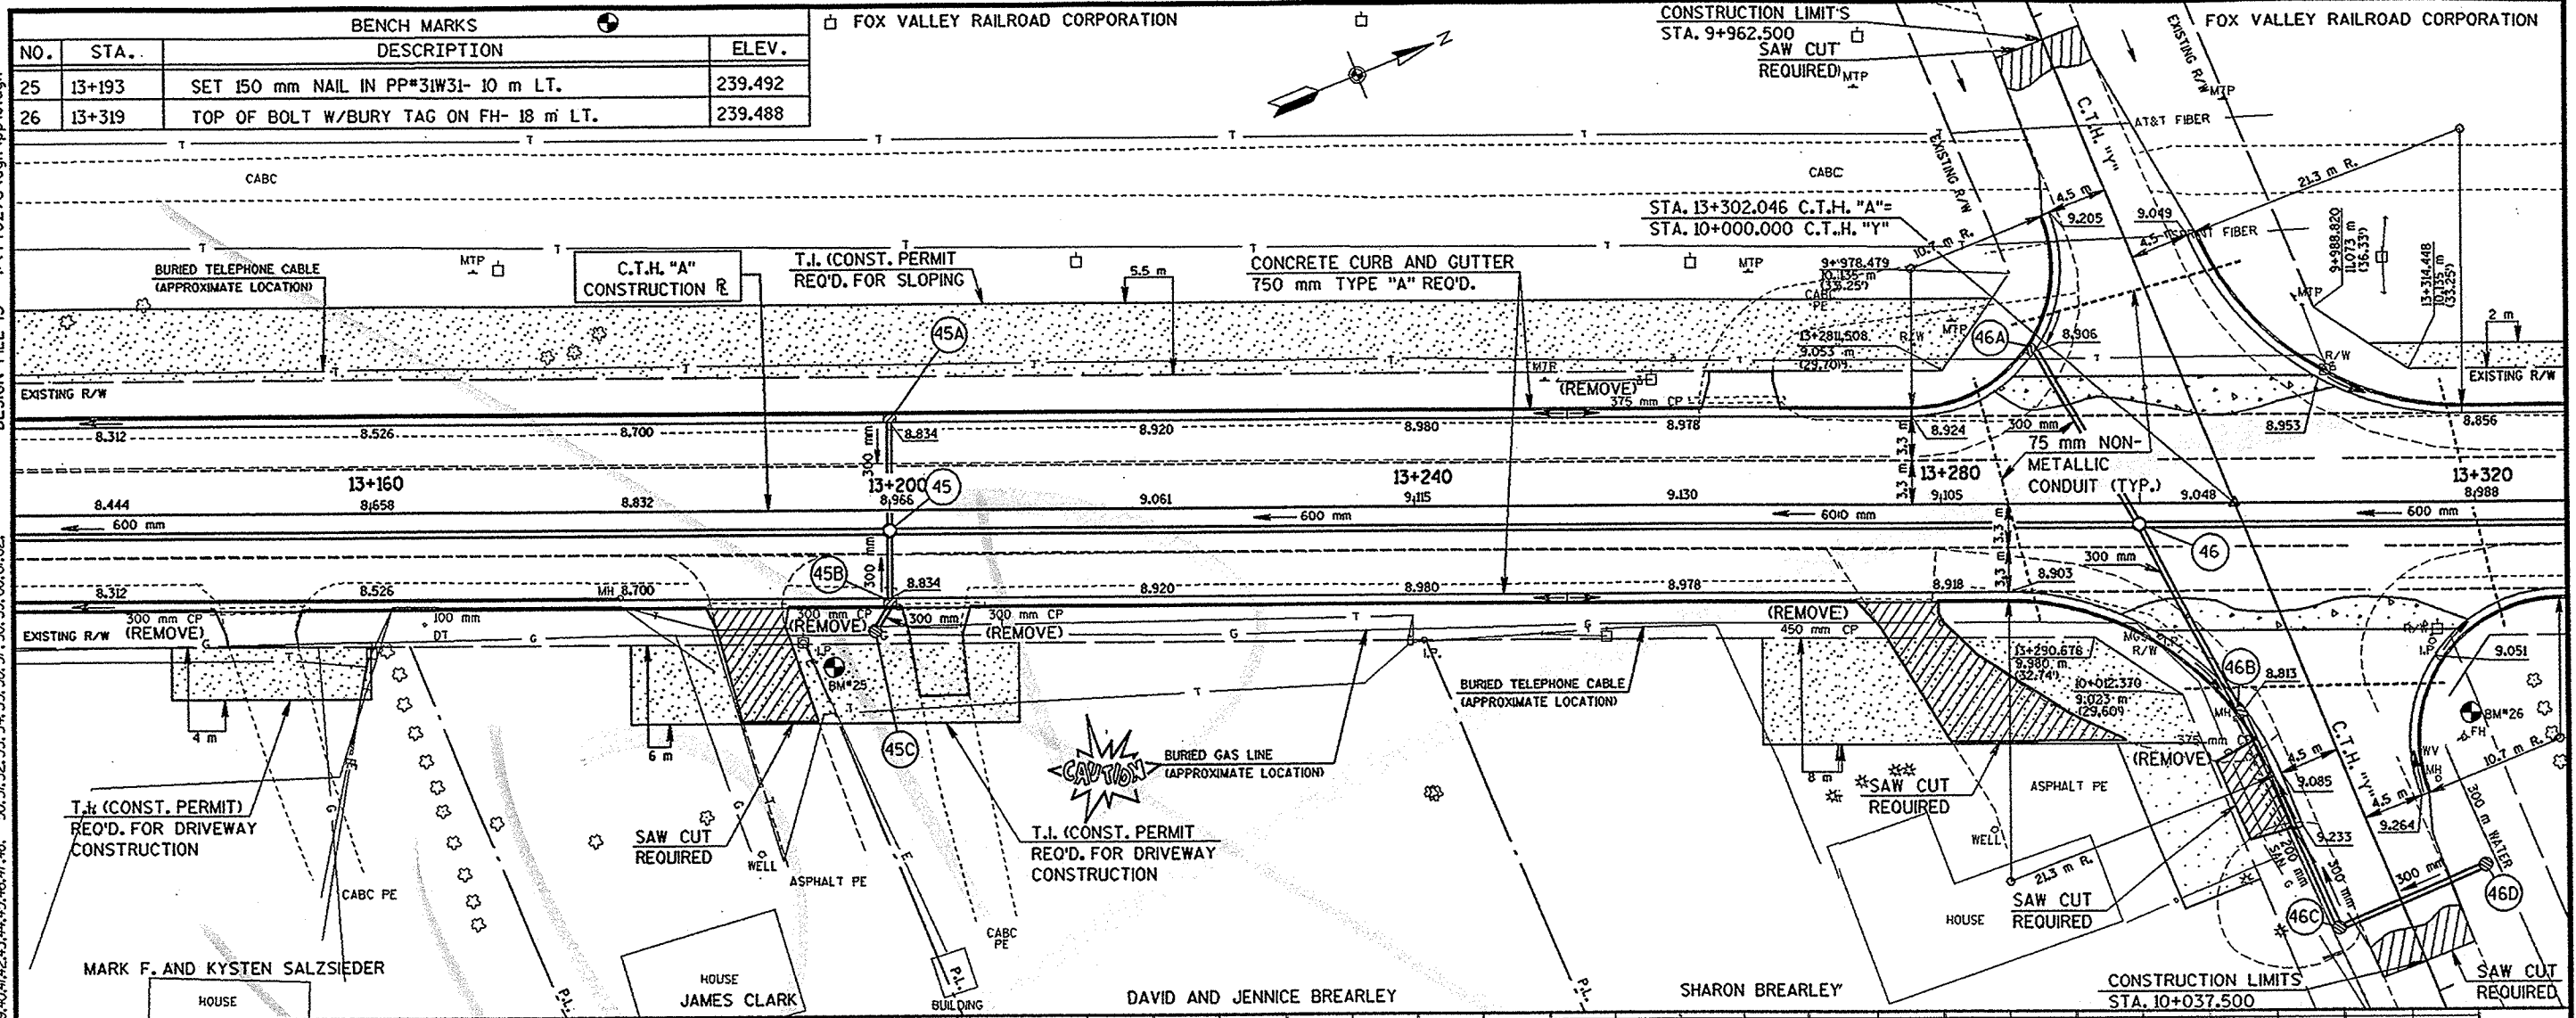


ORIGINATOR: JPZ
 PROJECT NO: 440278
 LEVELS ON: 1, 2, 3, 48, 50, 51, 52, 53, 54, 55, 56, 57, 58, 59, 60, 61, 62
 DATE: 03/02/98
 FILE NAME: #plot72hoser#mv80pp.tbl
 PLOT NAME: 11/25/98
 SCALE: 1:1
 DESIGN FILE IS: I:\440278\dgn\pp20.dgn

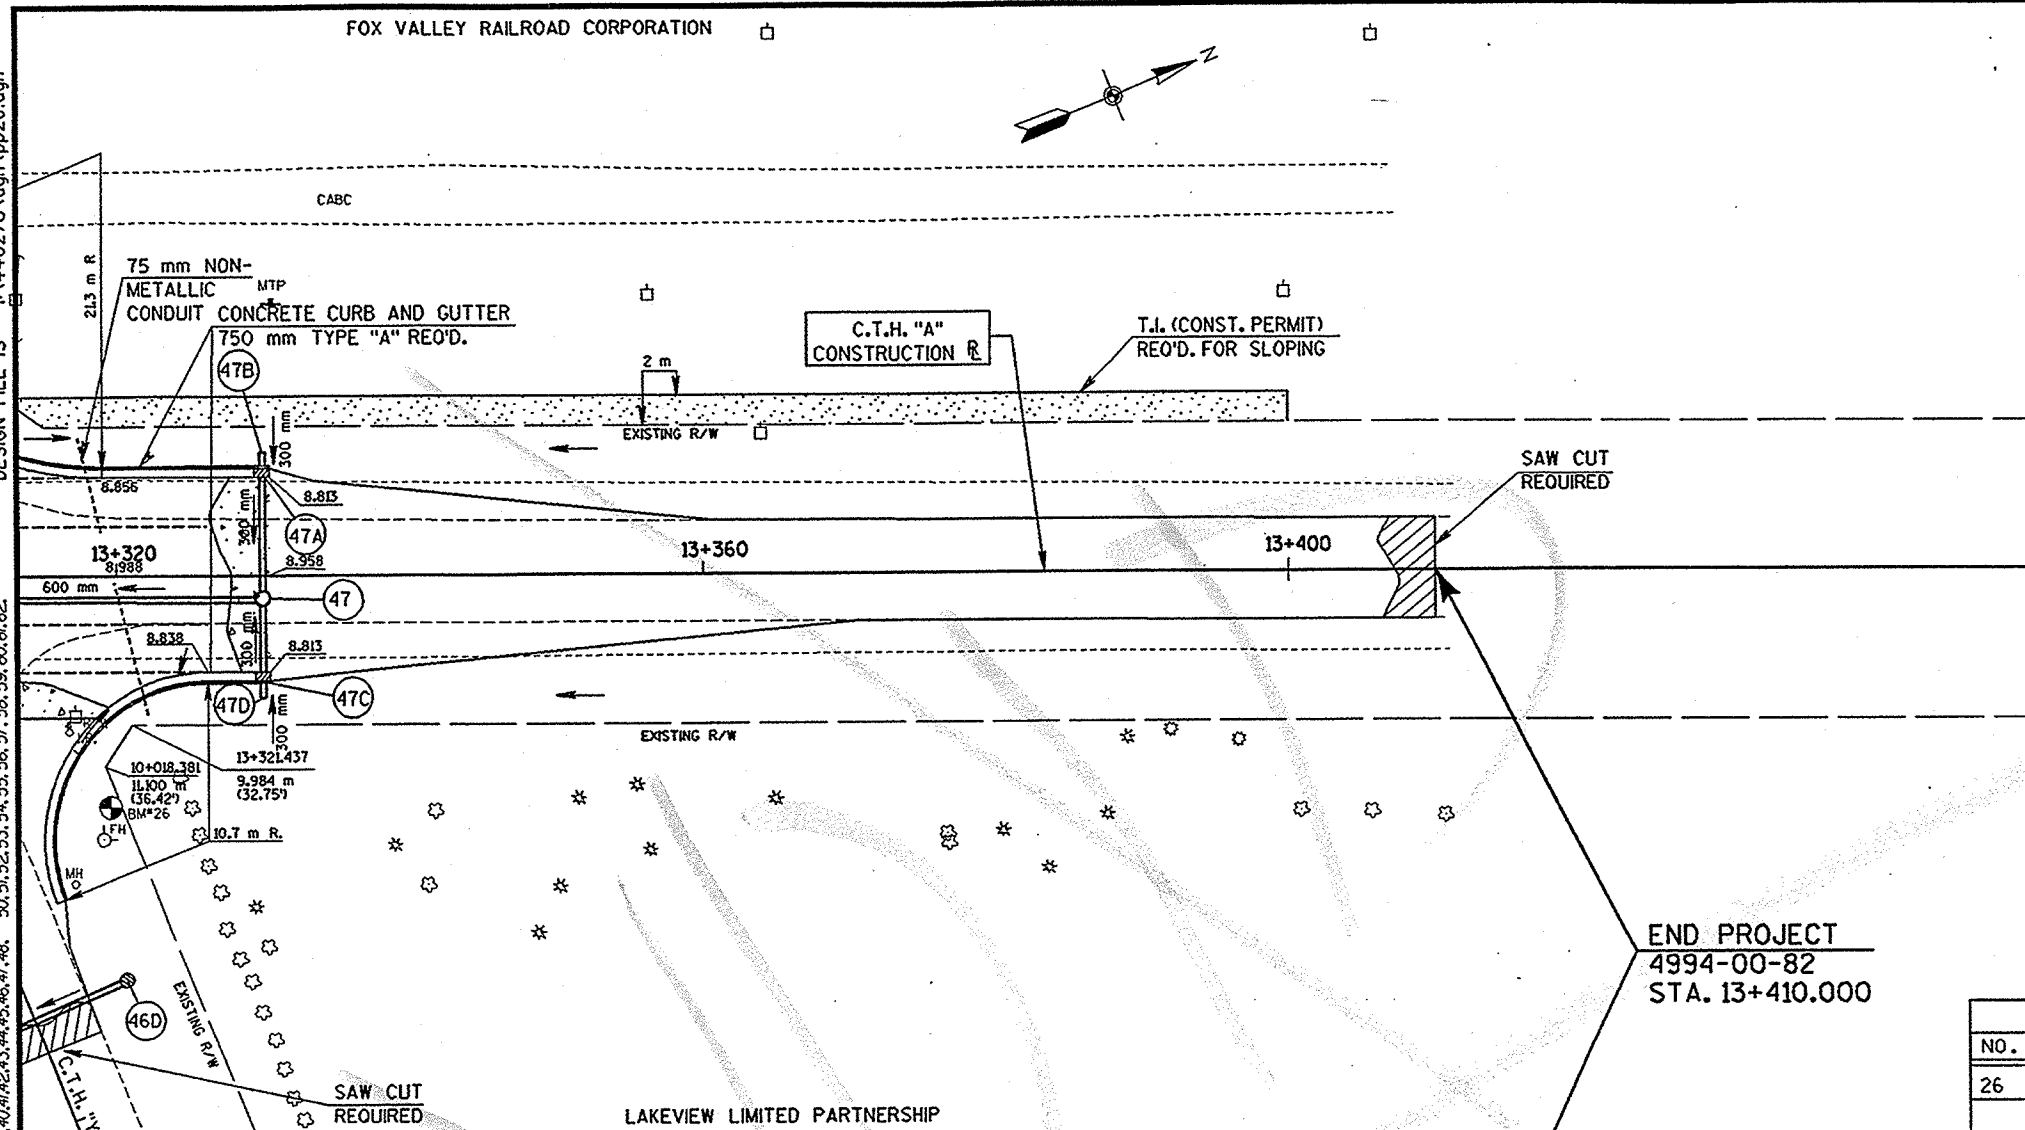

END PROJECT
 4994-00-82
 STA. 13+410.000


BENCH MARKS			
NO.	STA.	DESCRIPTION	ELEV.
26	13+319	TOP OF BOLT W/BURY TAG ON FH- 18 m LT.	239.488

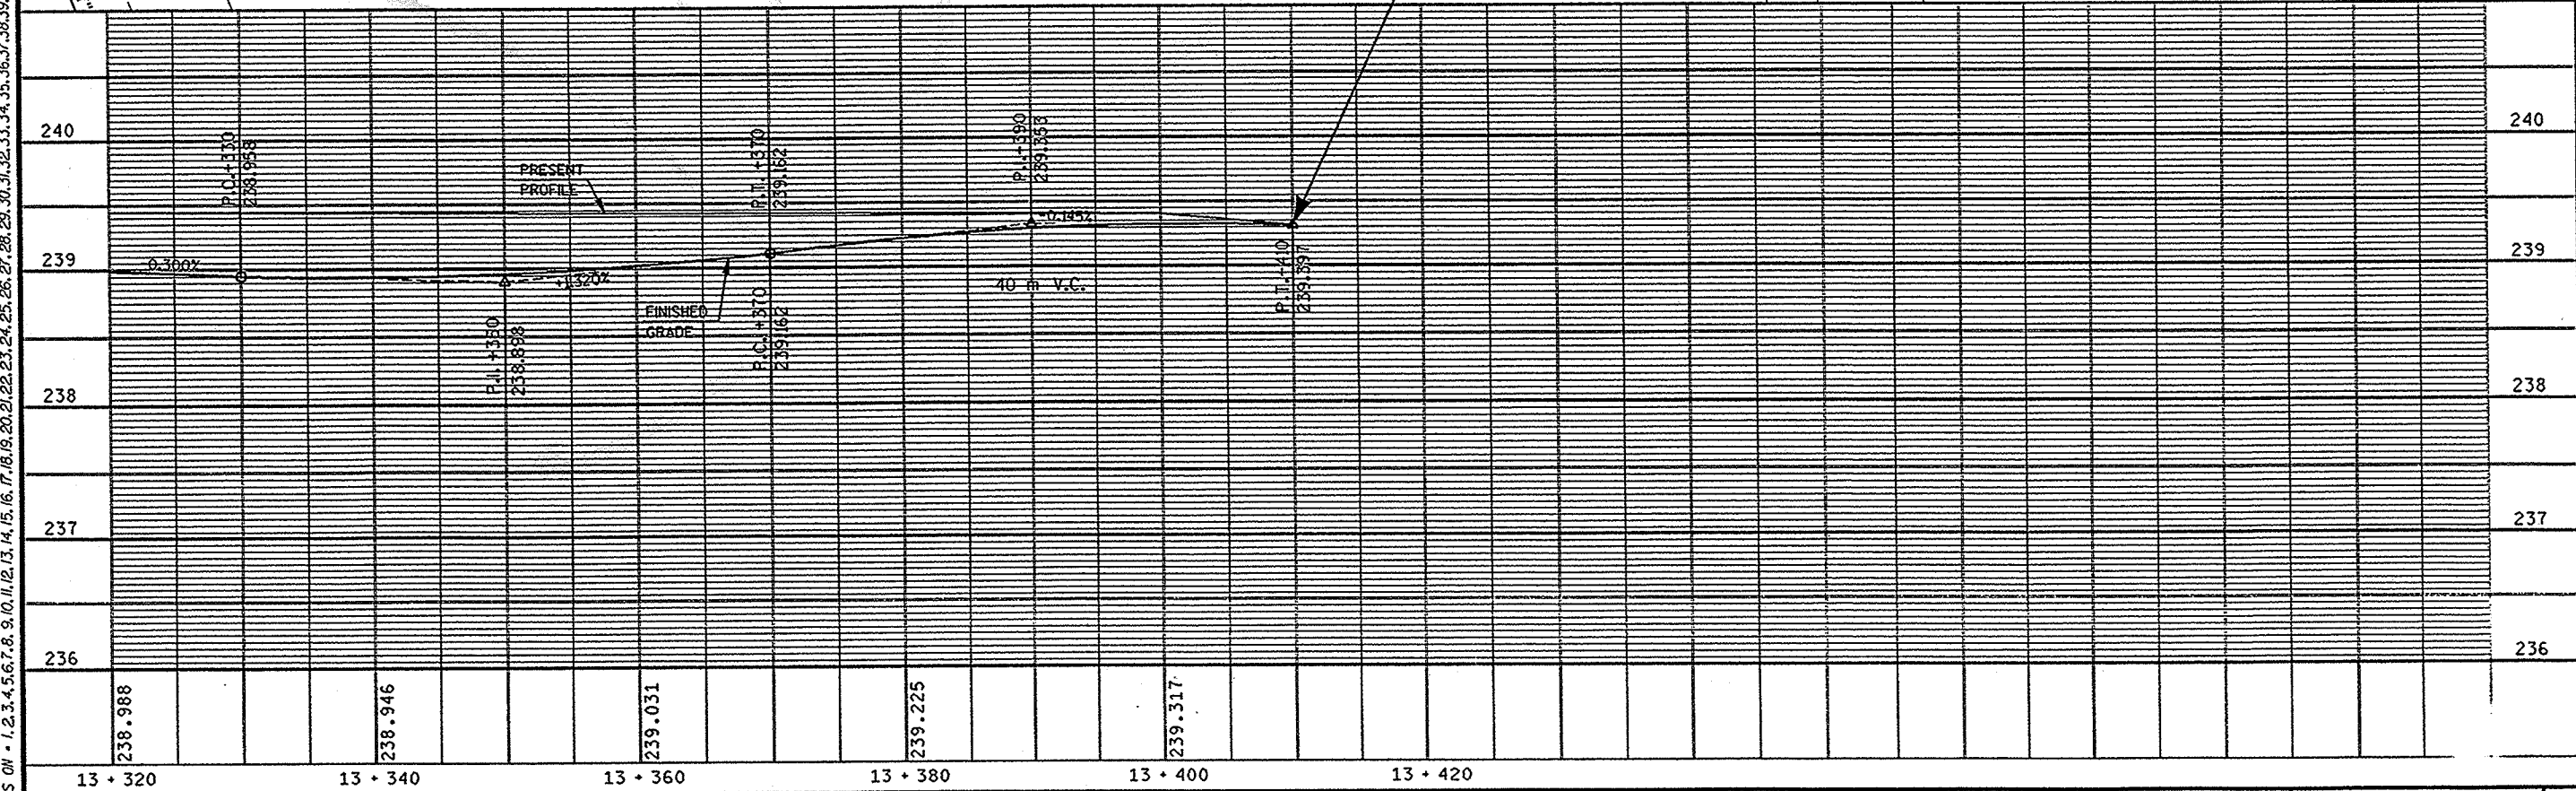

F.O. CONFLICTS AND R/W AQUISITION PREVENTED CONSTRUCTION PER PLAN.

TEMP. ASPH. PAV'T PLACED FROM END OF CONC. PAV'T AND CURB AND GUTTER AT STA. 13+326 TO STA. 13+580, STA. 13+326 - STA. 13+460 WAS GRADED TO THE ULTIMATE PROFILE PER ORIGINAL PLAN. THE PLAN SUBGRADE WAS CONSTRUCTED.

CU 2
 PFN TARI F - plot+plaser+mv+RORr.f.tn
 DAIL OF PLOI - 5/1/00
 PLOT NA
 DLSIGN FILL IS I:\440278\Jgn\1120.dgn
 FILE NAME:
 SCALE:
 DATE: 03/02/98
 PLOT NAME:
 ORIGINATOR: JPZ
 PROJECT NO: 440278
 LEVELS ON: 1, 2, 3, 48, 50, 51, 52, 53, 54, 55, 56, 57, 58, 59, 60, 61, 62

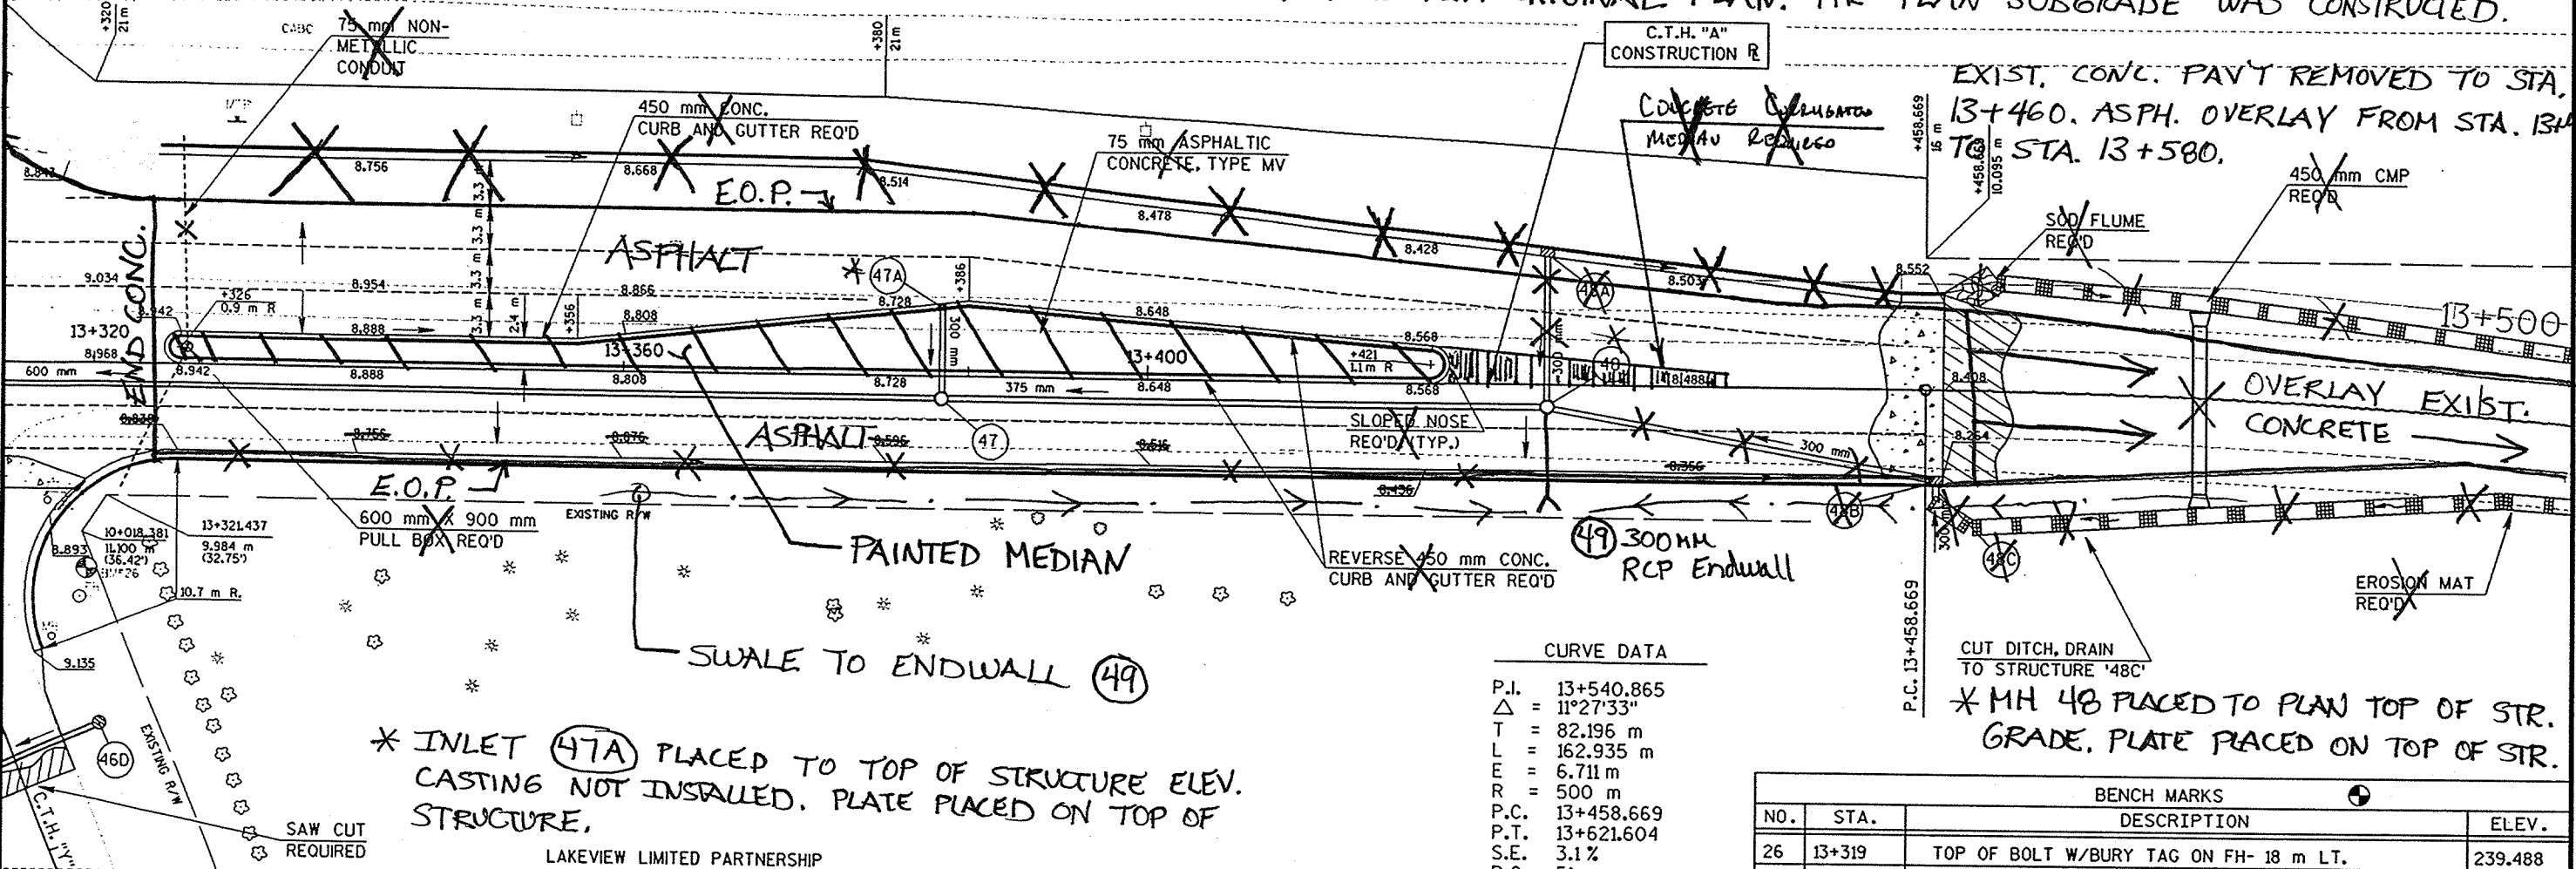

* INLET (47A) PLACED TO TOP OF STRUCTURE ELEV. CASTING NOT INSTALLED. PLATE PLACED ON TOP OF STRUCTURE.


CURVE DATA

P.I.	13+540.865
Δ	11°27'33"
T	82.196 m
L	162.935 m
E	6.711 m
R	500 m
P.C.	13+458.669
P.T.	13+621.604
S.E.	3.1%
R.O.	51 m


BENCH MARKS

NO.	STA.	DESCRIPTION	ELEV.
26	13+319	TOP OF BOLT W/BURY TAG ON FH- 18 m LT.	239.488

STORM SEWER FROM MH (48) TO INLET (48B) NOT PLACED. INLET (48B) AND ENDWALL 48C NOT PLACED.

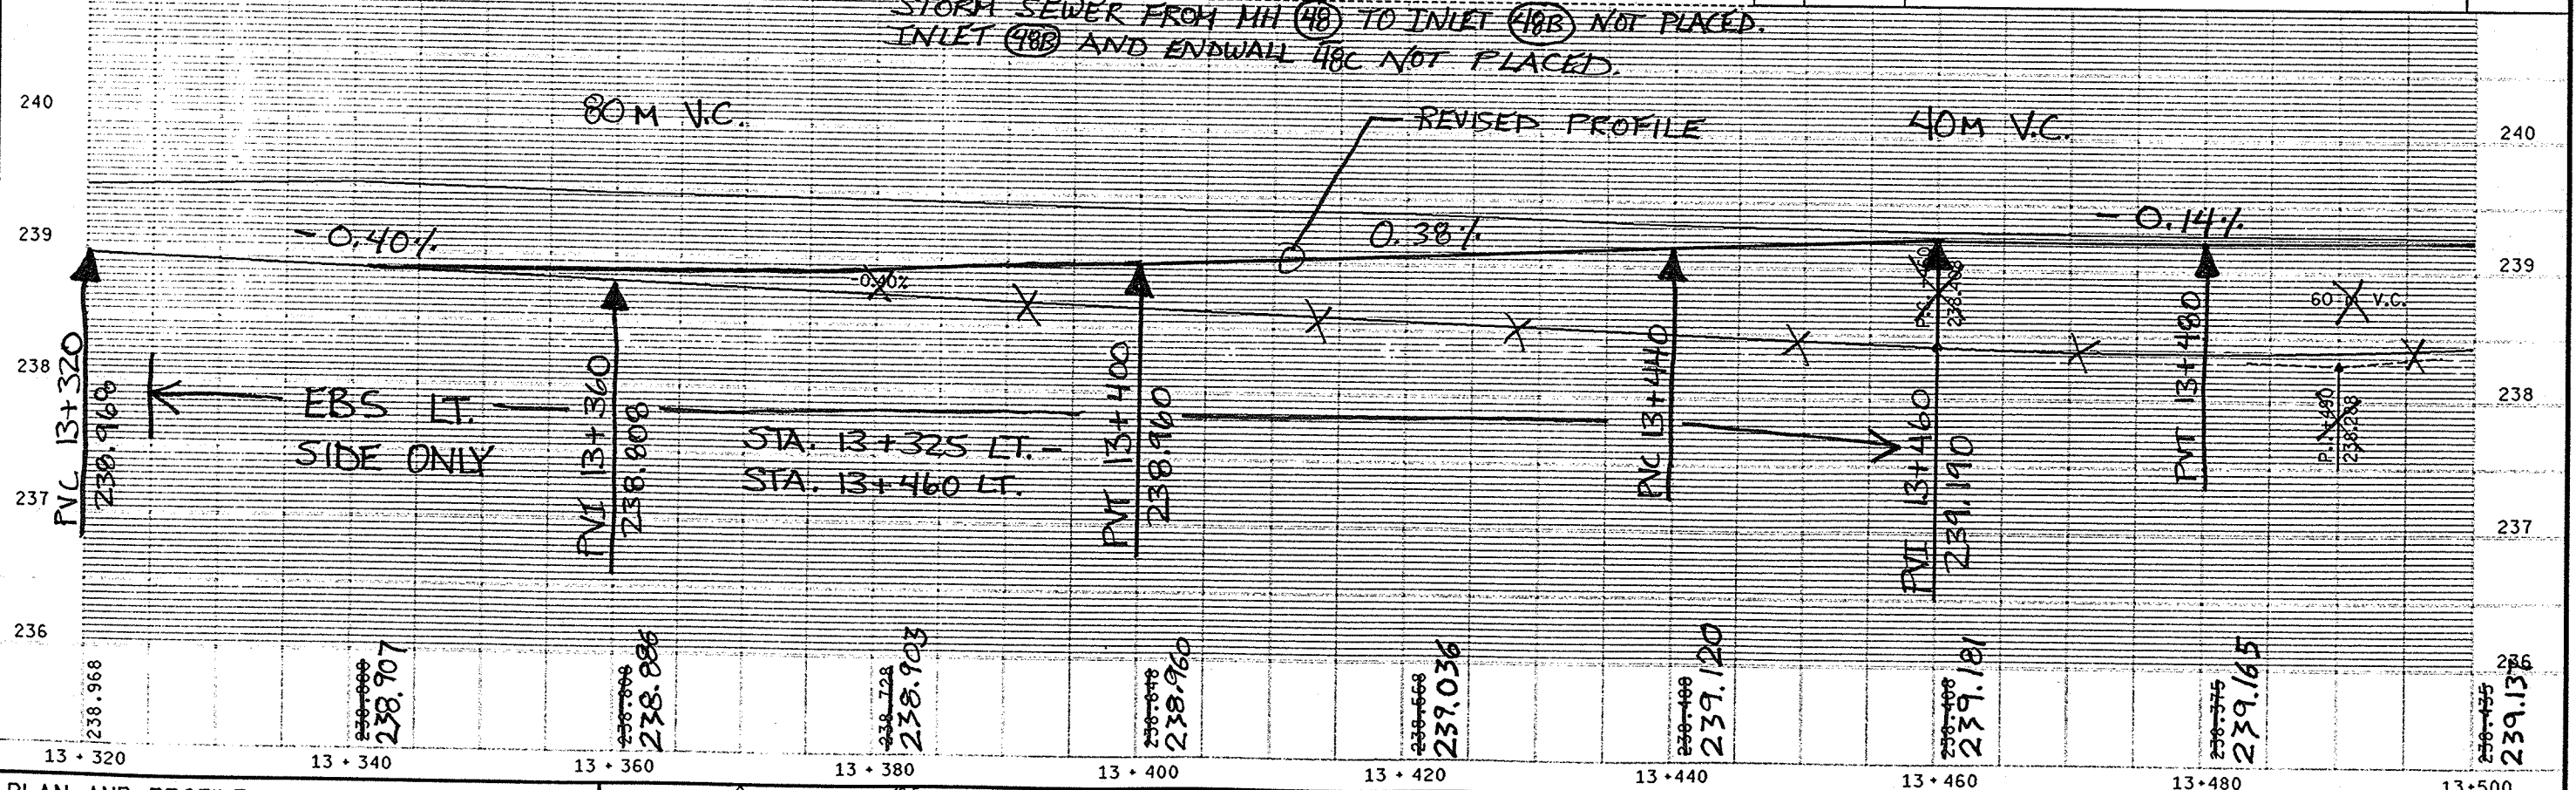


FILE NAME: 49940082.dwg
DATE OF PLOT: 4/7/08
PLOT NO: 1
DESIGN FILE IS: I:\440278\dwg\PP21.dgn

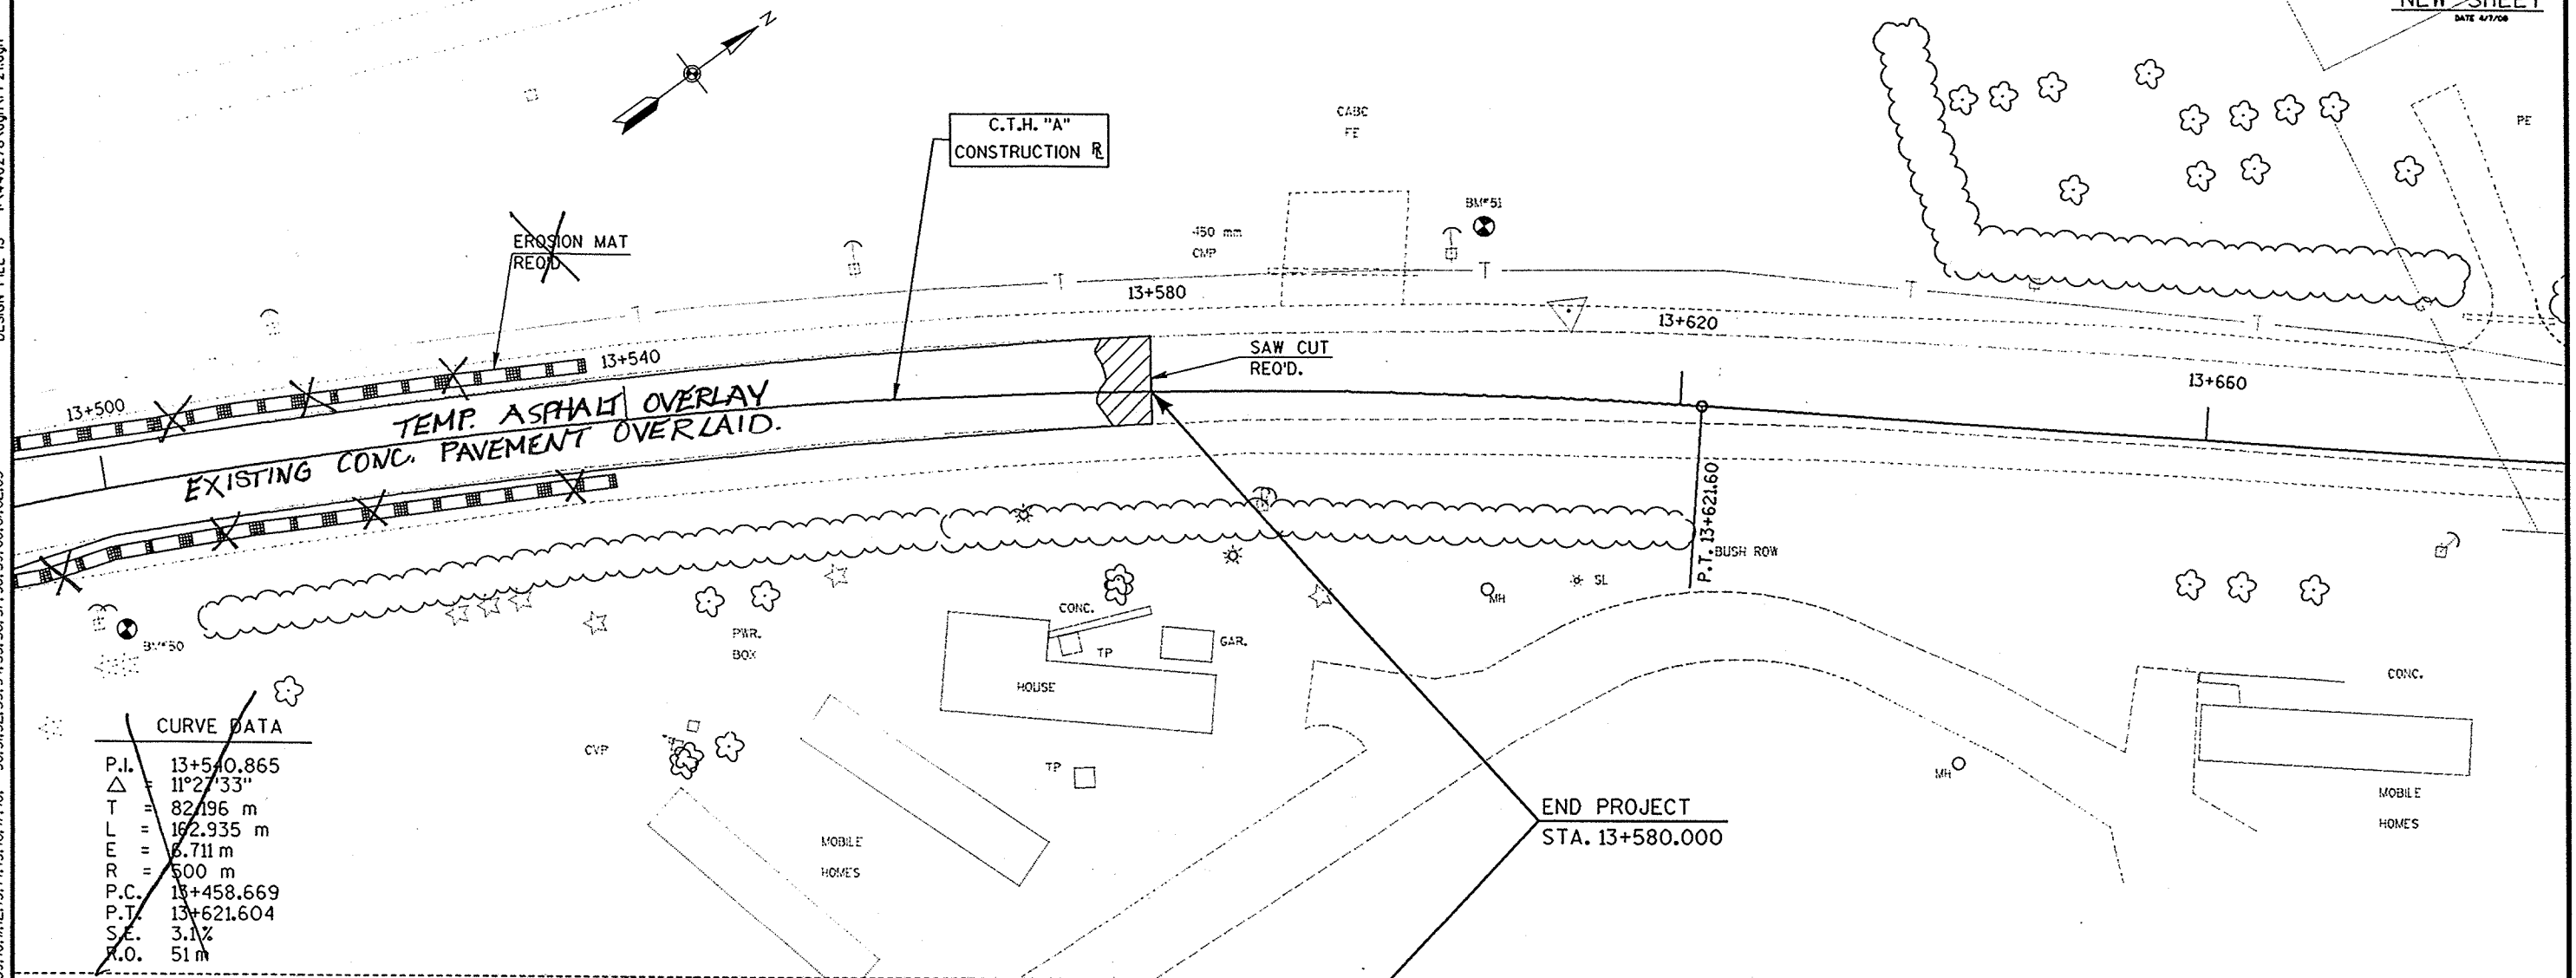

CURVE DATA

P.I.	13+540.865
Δ	11°27'33"
T	82.196 m
L	162.935 m
E	6.711 m
R	500 m
P.C.	13+458.669
P.T.	13+621.604
S.E.	3.1%
P.O.	51 m

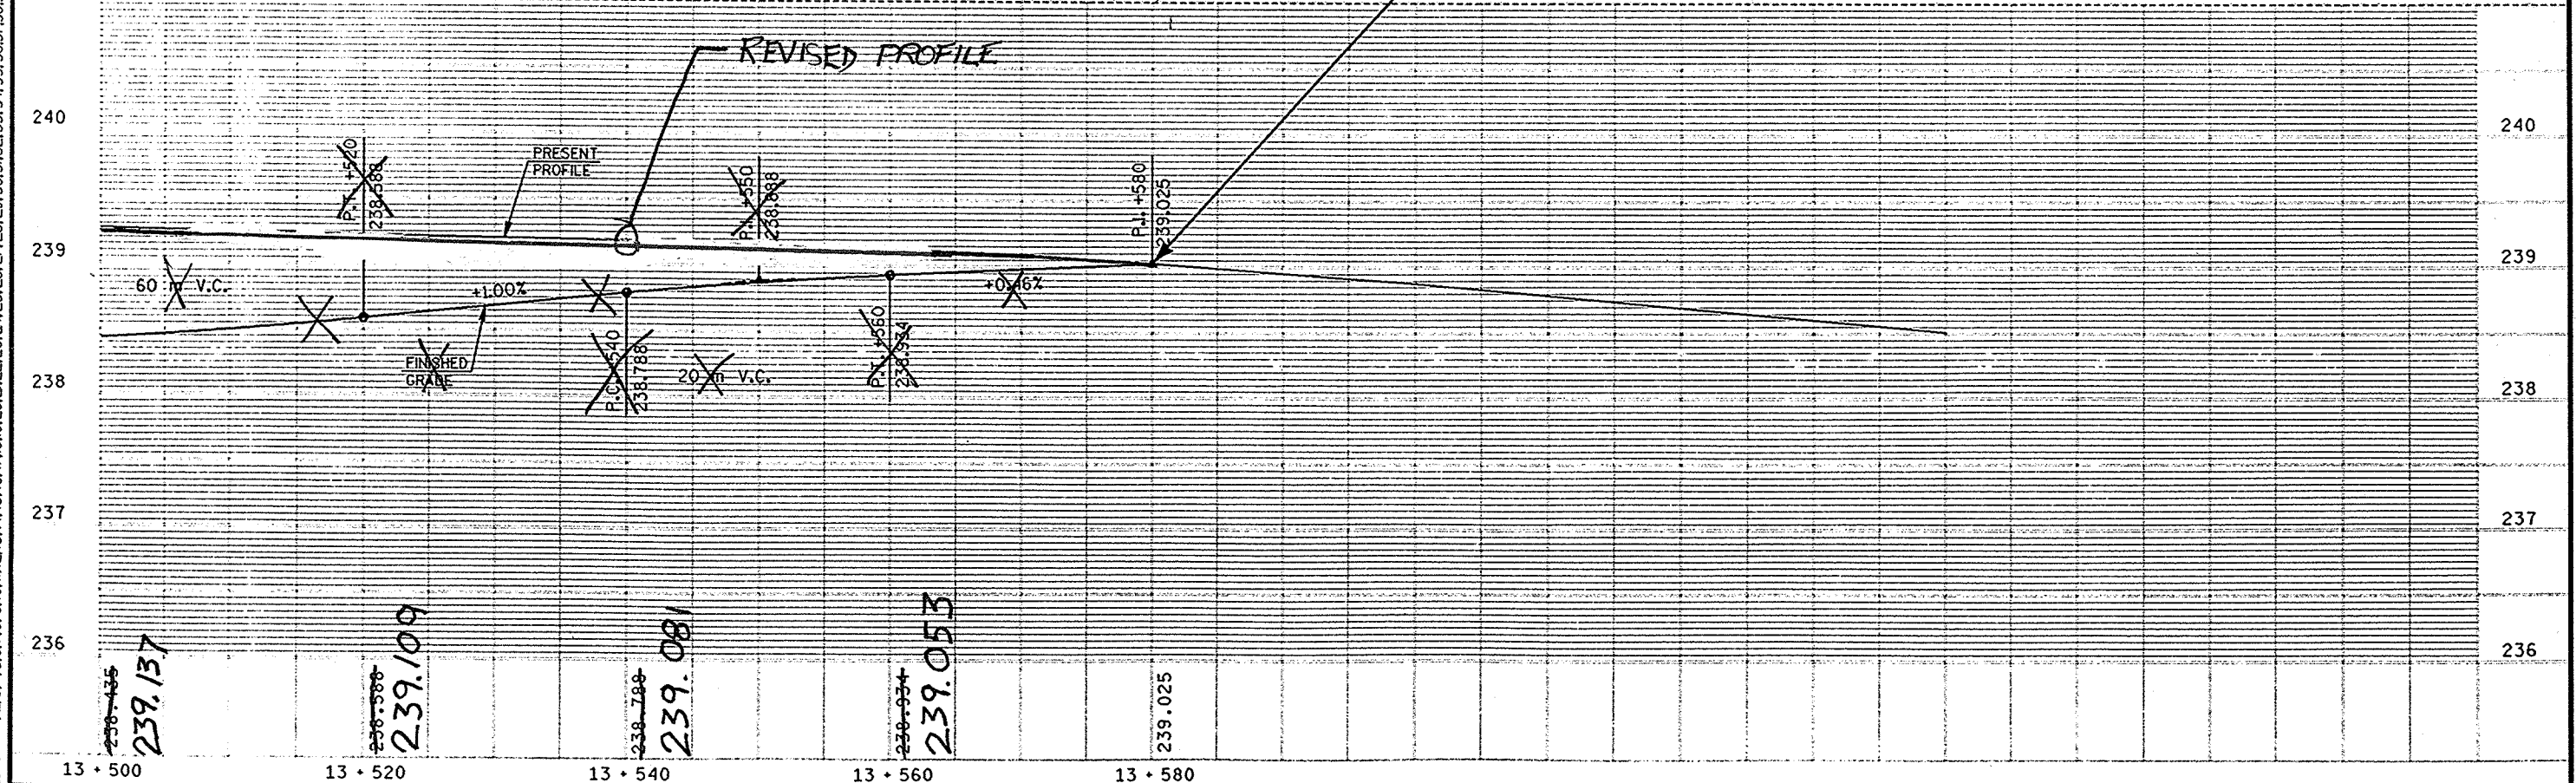



ORIGINATOR: DJD
PROJECT NO: 440278.00
LEVELS ON: 1, 2, 3, 48, 50, 51, 52, 53, 54, 55, 56, 57, 58, 59, 60, 61, 62, 63

PLOT SCALE:



PLOT NAME:

REV. DATE:

S.D.D. 8 A 5-15b
LEVELS ON - 2.3, 4, 5.6, 7.8, 9.10, 11, 12, 13, 62, 63

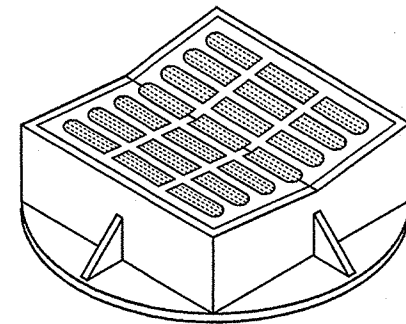
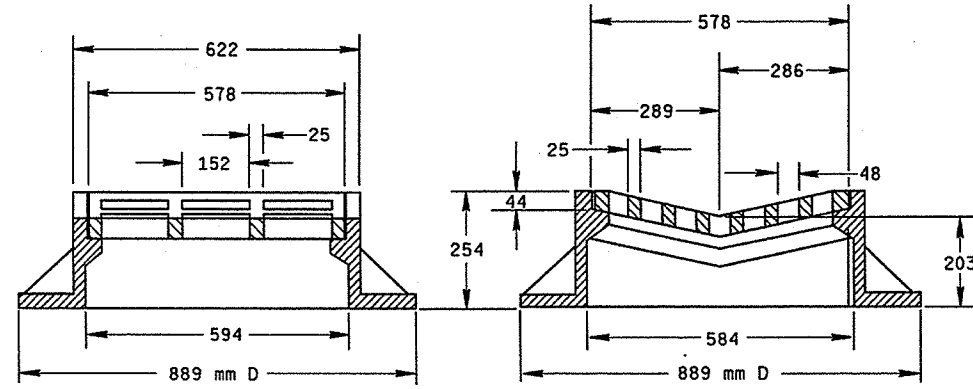


TYPE "B"
(APPROXIMATE WEIGHT 179 kg)
FRAME..... 129 kg
GRATE..... 50 kg

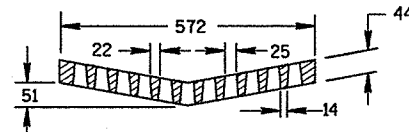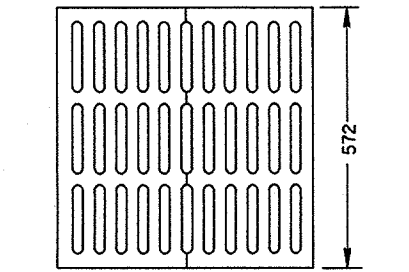

**ALTERNATIVE GRATE FOR
FOR TYPE "B" COVER**

(APPROXIMATE GRATE WEIGHT 57 kg)
GRATE..... 57 kg
USE WHERE PEDESTRIAN OR BICYCLE TRAFFIC IS POSSIBLE.
NOTED AS TYPE B-A ON THE DRAINAGE TABLE

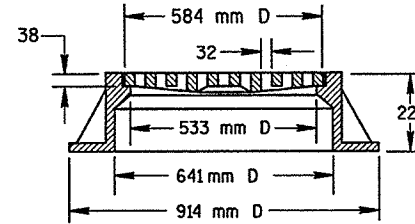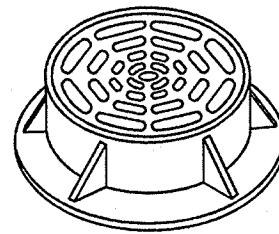

TYPE "C"
(APPROXIMATE WEIGHT 154 kg)
FRAME..... 107 kg
GRATE..... 48 kg

GENERAL NOTES

DETAILS OF CONSTRUCTION, MATERIALS AND WORKMANSHIP NOT SHOWN ON THIS DRAWING SHALL CONFORM TO THE PERTINENT REQUIREMENTS OF THE STANDARD SPECIFICATIONS AND THE APPLICABLE SPECIAL PROVISIONS.


DETAIL DRAWINGS FOR PROPOSED ALTERNATE DESIGNS FOR CATCH BASIN, MANHOLE AND INLET COVERS SHALL BE SUBMITTED TO THE ENGINEER FOR APPROVAL PROVIDING THAT SUCH ALTERNATE DESIGNS MAKE PROVISION FOR EQUIVALENT CAPACITY AND STRENGTH.

ROUND FRAMES AND COVERS SHALL HAVE CONTINUOUSLY MACHINED BEARING SURFACES TO PREVENT ROCKING AND RATTLING.

THE ACTUAL WEIGHT OF COVERS MAY VARY WITHIN 5 PERCENT, PLUS OR MINUS, OF THE APPROXIMATE WEIGHT.


NOTES

ALL DIMENSIONS ARE IN MILLIMETERS UNLESS OTHERWISE SHOWN.

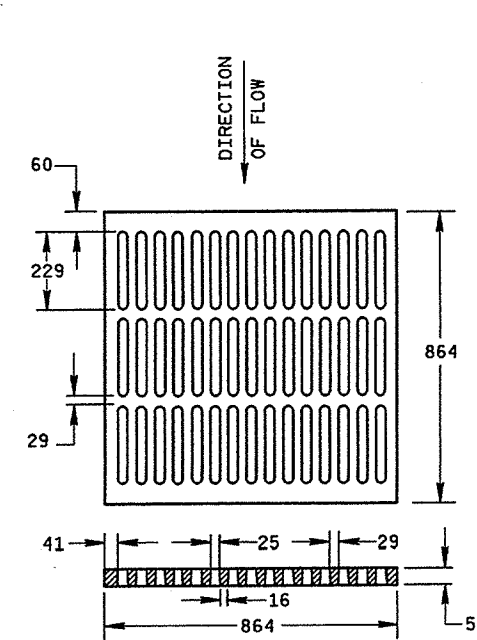


ALTERNATIVE TYPE "MS"
(APPROXIMATE GRATE WEIGHT 166 kg)
GRATE..... 166 kg

USE WHERE PEDESTRIAN OR BICYCLE TRAFFIC IS PERMITTED
NOTED AS TYPE MS-A ON THE DRAINAGE TABLE

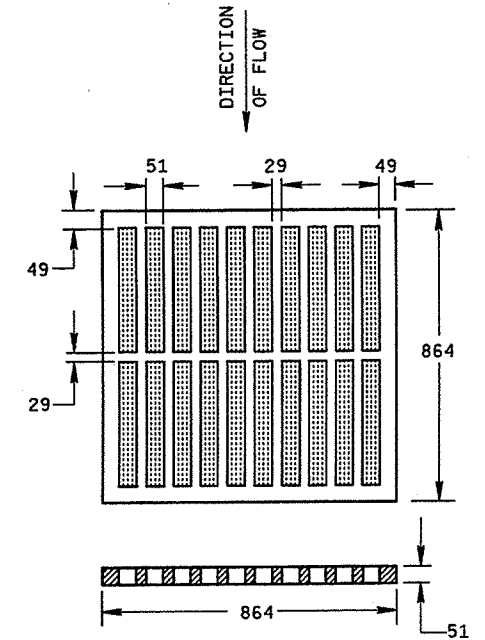


TYPE "MS"
(APPROXIMATE GRATE WEIGHT 122 kg)
GRATE..... 122 kg

USE ON FREEWAYS AND EXPRESSWAYS
NOTED AS TYPE MS ON DRAINAGE TABLE

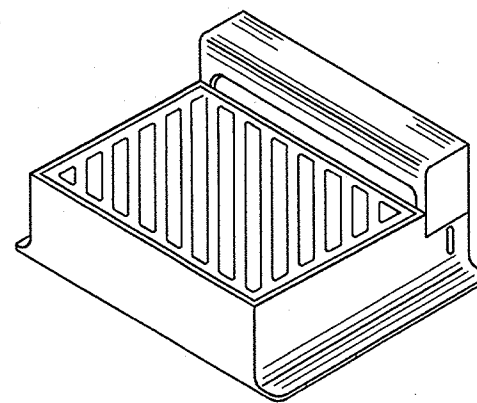

DIAGONAL SLOTS, SHALL BE ORIENTED TO THE DIRECTION OF FLOW AS ILLUSTRATED. GRATES ARE MANUFACTURED TO BE REVERSIBLE.

DIRECTION OF FLOW

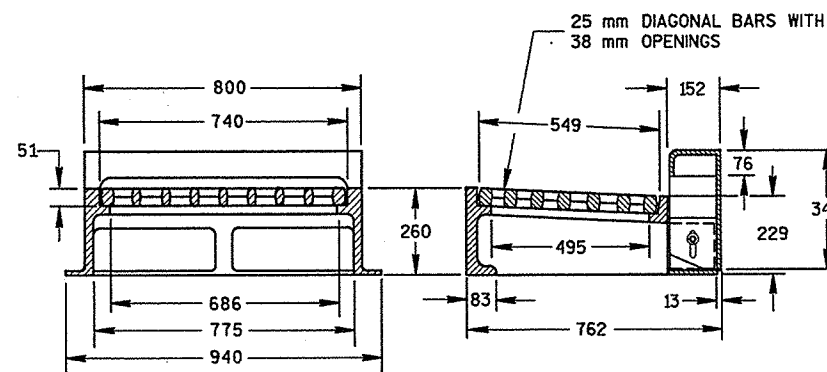

NOTE: CURB BOX HEIGHT ADJUSTABLE 152 mm TO 229 mm

TYPE "WM"
(APPROXIMATE WEIGHT 304 kg)
FRAME..... 163 kg
GRATE..... 73 kg
CURB BOX..... 68 kg

INLET COVERS
TYPE B, B-A, C, MS, MS-A, & WM

STATE OF WISCONSIN
DEPARTMENT OF TRANSPORTATION

APPROVED
8/28/92
DATE
[Signature]
CHIEF ROADWAY DEVELOPMENT ENGINEER

FHWA

PLOT SCALE:



PLOT NAME:

REV. DATE:


ORIGINATOR:

S.D.D. 8 A 5-15a
LEVELS ON - 2, 3, 4, 62, 63


NOTE:
GRATE IS REVERSIBLE.

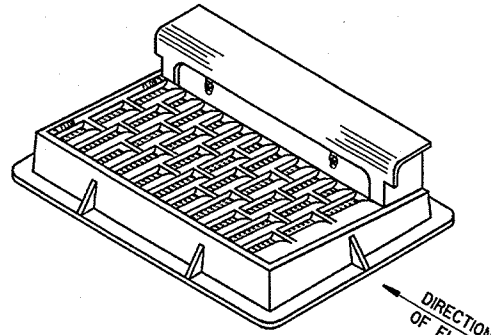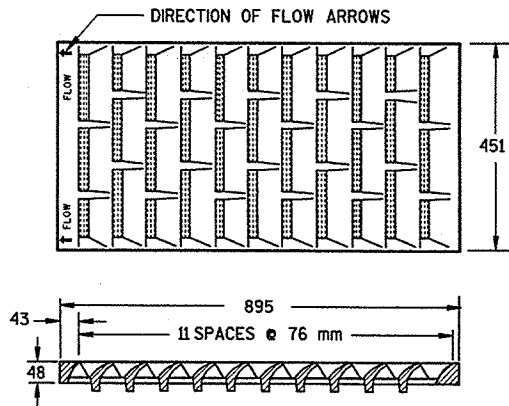

NOTE: CURB BOX HEIGHT ADJUSTABLE 150 mm TO 230 mm

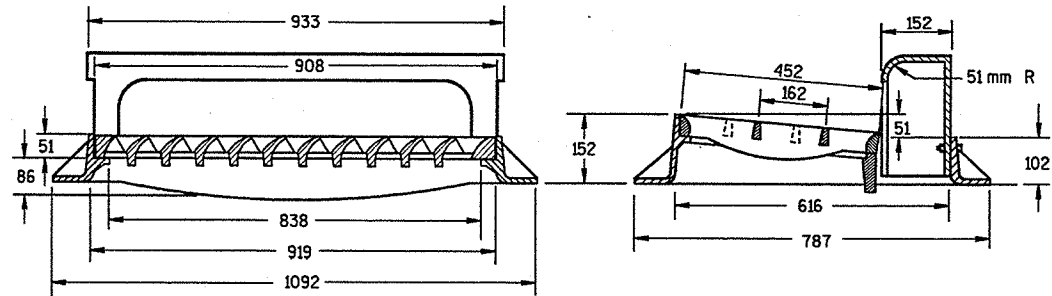

TYPE "H"
 (APPROXIMATE WEIGHT 191 kg)
 FRAME..... 79 kg
 GRATE..... 63 kg
 CURB BOX..... 49 kg

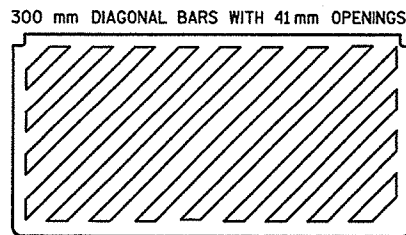

**SPECIAL GRATE FOR
TYPE "H" COVER**

(MEASURES 895 mm X 451 mm X 51 mm)
(APPROXIMATE WEIGHT 78 kg)

(NOTED AS TYPE H-S ON DRAINAGE TABLE)

NOTE:
GRATE IS REVERSIBLE.

GENERAL NOTES

DETAILS OF CONSTRUCTION, MATERIALS AND WORKMANSHIP NOT SHOWN ON THIS DRAWING SHALL CONFORM TO THE PERTINENT REQUIREMENTS OF THE STANDARD SPECIFICATIONS AND THE APPLICABLE SPECIAL PROVISIONS.



DETAIL DRAWINGS FOR PROPOSED ALTERNATE DESIGNS FOR CATCH BASIN, MANHOLE AND INLET COVERS SHALL BE SUBMITTED TO THE ENGINEER FOR APPROVAL PROVIDING THAT SUCH ALTERNATE DESIGNS MAKE PROVISION FOR EQUIVALENT CAPACITY AND STRENGTH.

ROUND FRAMES AND COVERS SHALL HAVE CONTINUOUSLY MACHINED BEARING SURFACES TO PREVENT ROCKING AND RATTLING.


THE ACTUAL WEIGHT OF COVERS MAY VARY WITHIN 5 PERCENT, PLUS OR MINUS, OF THE APPROXIMATE WEIGHT.

NOTE

ALL DIMENSIONS ARE SHOWN IN MILLIMETERS UNLESS OTHERWISE SHOWN.

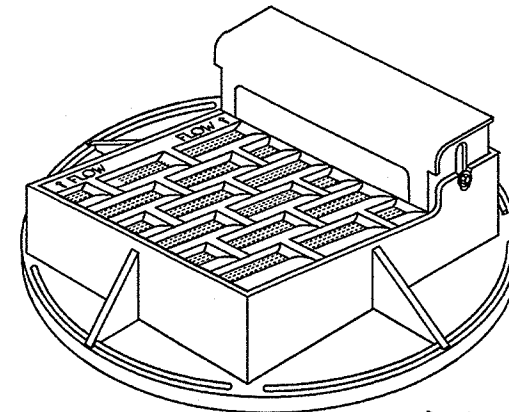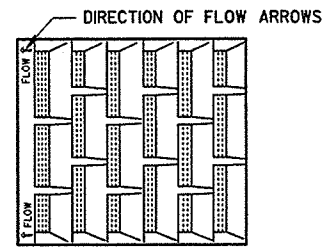

NOTE:
GRATE IS REVERSIBLE.

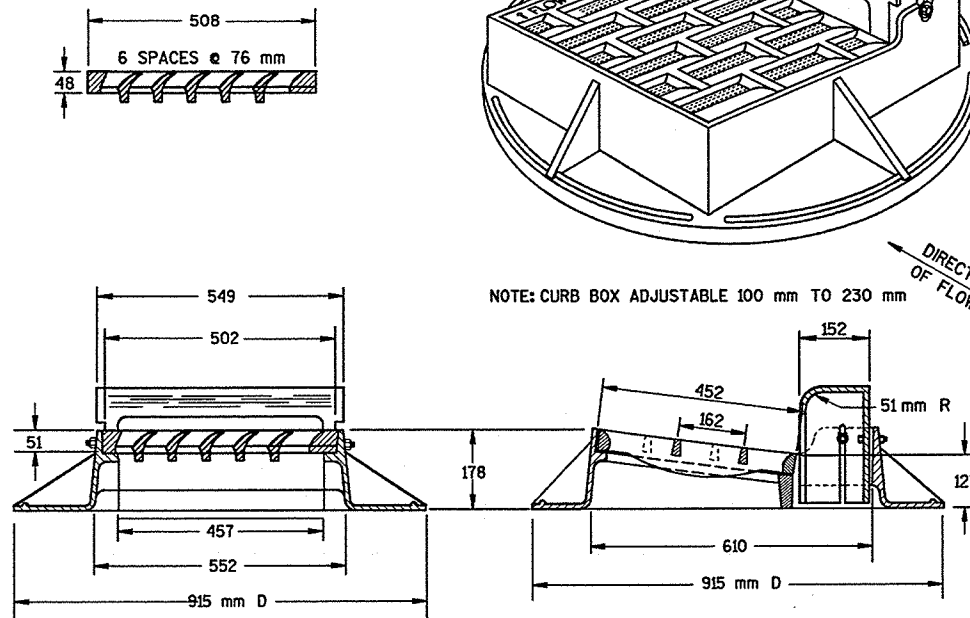


NOTE: CURB BOX ADJUSTABLE 100 mm TO 230 mm

TYPE "A"

(APPROXIMATE WEIGHT 325 LBS.)
 FRAME..... 157 LBS.
 GRATE..... 84 LBS.
 CURB BOX..... 84 LBS.

30 mm DIAGONAL BARS
WITH 30 mm OPENINGS

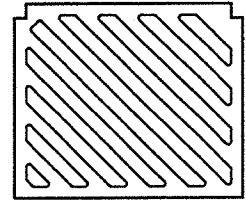

**SPECIAL GRATE FOR
TYPE "A" COVER**

(MEASURES 502 mm X 432 mm X 51 mm)

GRATE..... 38 kg

(NOTED AS TYPE A-S ON DRAINAGE TABLE)

NOTE:
GRATE IS REVERSIBLE.

**INLET COVERS
TYPE A, H, A-S, & H-S**

**STATE OF WISCONSIN
DEPARTMENT OF TRANSPORTATION**

APPROVED
8/27/98
DATE
[Signature]
CHIEF ROADWAY DEVELOPMENT ENGINEER

FHWA

PLOT SCALE:



PLOT NAME:

REV. DATE:



ORIGINATOR:

S.D.D. 8 A 5-15I



LEVELS ON - 2,3,4,5,6,7,8, 9,10,11,12,13,14,15,16,17,18,19,20,21,22,23,24,25,26,27,28,29,30,31,32,33,34,35,36,37,38,39,40,41,42,43,44,45,46,47,48,49,50,51,52,53,54,55,56,57,58,59,60,61,62,63

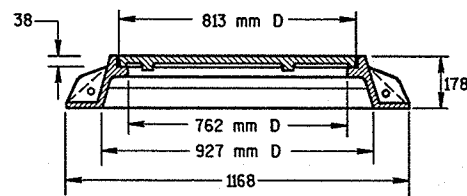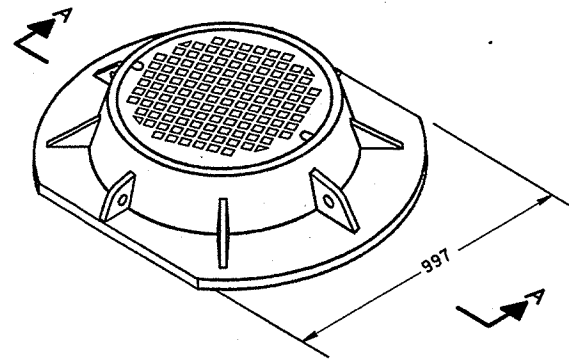

**SECTION A-A
TYPE "K"**
(APPROXIMATE WEIGHT 188 kg)
FRAME.....95 kg
LID.....93 kg

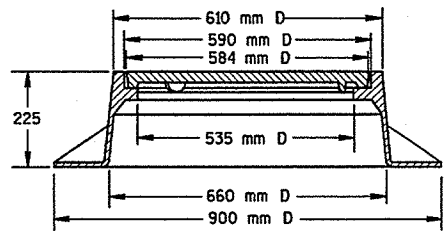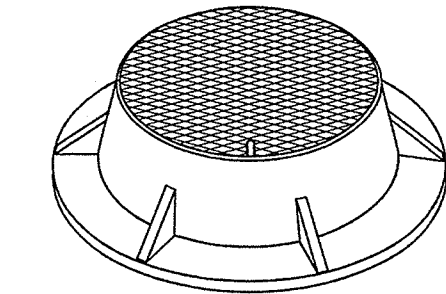

TYPE "J"
(APPROXIMATE WEIGHT 113 kg)
FRAME.....61 kg
LID.....52 kg

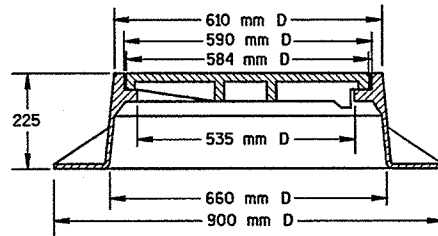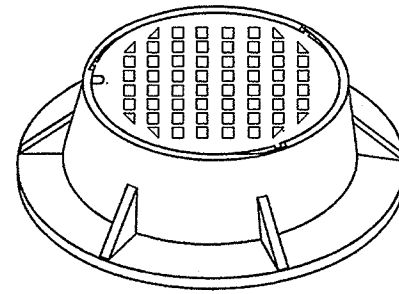

TYPE "J" SPECIAL
TYPE "B" NON-ROCKING SELF-SEAL LID
(APPROXIMATE WEIGHT 111 kg)
FRAME.....66 kg
LID.....45 kg
(NOTED AS TYPE J-S ON DRAINAGE TABLE)

GENERAL NOTES

DETAILS OF CONSTRUCTION, MATERIALS AND WORKMANSHIP NOT SHOWN ON THIS DRAWING SHALL CONFORM TO THE PERTINENT REQUIREMENTS OF THE STANDARD SPECIFICATIONS AND THE APPLICABLE SPECIAL PROVISIONS.




DETAIL DRAWINGS FOR PROPOSED ALTERNATE DESIGNS FOR MANHOLE COVERS SHALL BE SUBMITTED TO THE ENGINEER FOR APPROVAL PROVIDING THAT SUCH ALTERNATE DESIGNS MAKE PROVISION FOR EQUIVALENT CAPACITY AND STRENGTH.

ROUND FRAMES AND COVERS SHALL HAVE CONTINUOUSLY MACHINED BEARING SURFACES TO PREVENT ROCKING AND RATTLING.



THE ACTUAL WEIGHT OF COVERS MAY VARY WITHIN 5 PERCENT, PLUS OR MINUS, OF THE APPROXIMATE WEIGHT.

NOTE

ALL DIMENSIONS ARE IN MILLIMETERS UNLESS OTHERWISE SHOWN.

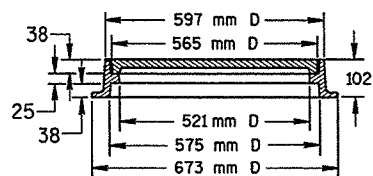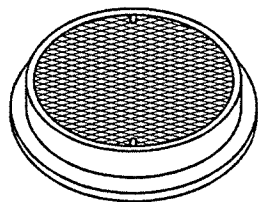
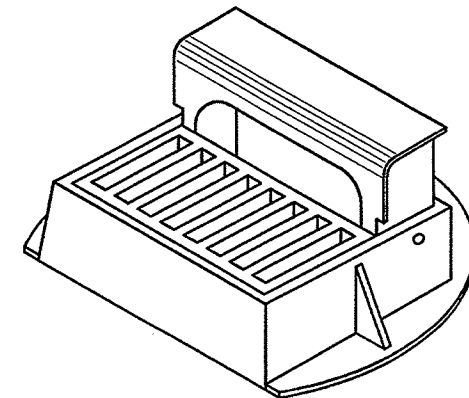


TYPE "L"
(APPROXIMATE WEIGHT 66 kg)
FRAME.....34 kg
LID.....32 kg

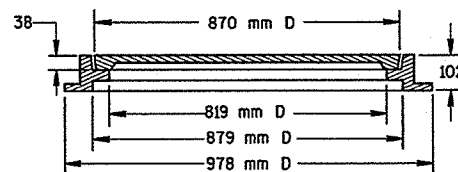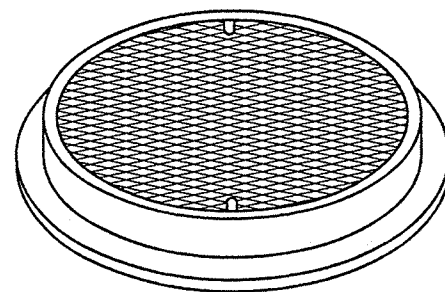

TYPE "M"
(APPROXIMATE WEIGHT 175 kg)
FRAME.....57 kg
LID.....118 kg

CURB BOX ADJUSTABLE 102 mm TO 254 mm

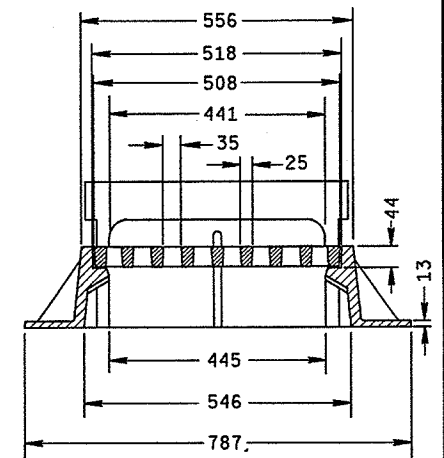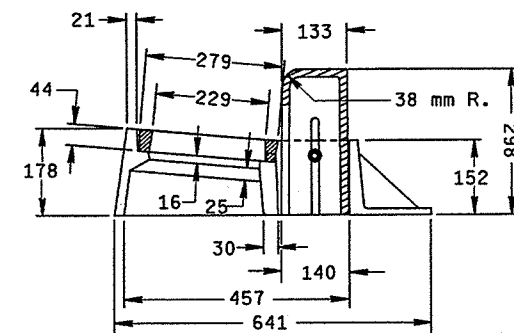

INLET COVER TYPE "Z"

(APPROXIMATE WEIGHT 155 kg)
FRAME.....90 kg
GRATE.....23 kg
CURB BOX.....42 kg

INLET COVER, TYPE Z
MANHOLE COVERS, TYPE
K, J, J-S, L & M

STATE OF WISCONSIN
DEPARTMENT OF TRANSPORTATION

APPROVED
8/27/88
DATE
[Signature]
CHIEF ROADWAY DEVELOPMENT ENGINEER

FWHA [M]

FILE NAME:

S.D.D. 8 A 5-15d


PLOT SCALE:

PLOT NAME:


REV. DATE:

ORIGINATOR:

S.D.D. 8 B 6-3
LEVELS ON - 2.3, 4, 5.6, 7.8, 9.10, 11, 12, 13, 62, 63

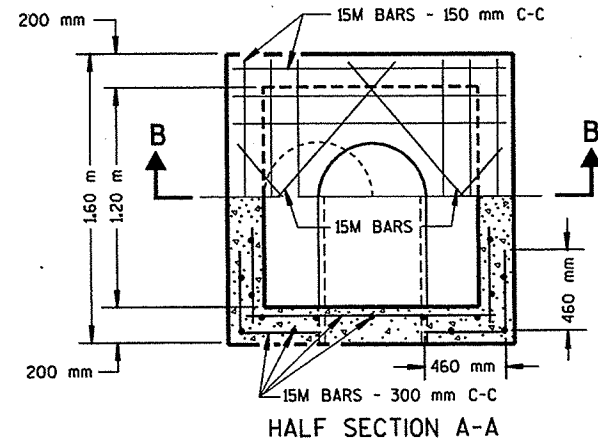


HALF SECTION A-A

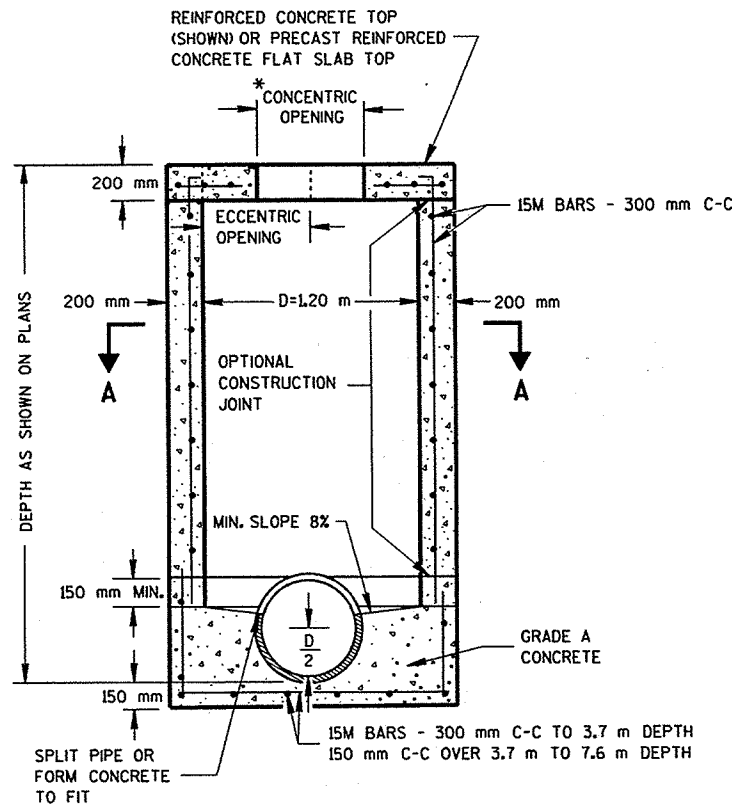


SECTION B-B
REINFORCED CONCRETE

MANHOLES TYPE 1

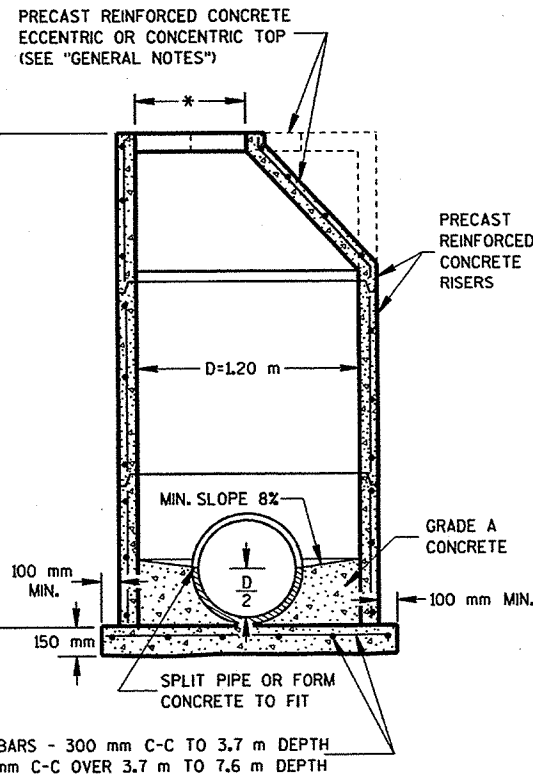

PRECAST REINFORCED CONCRETE

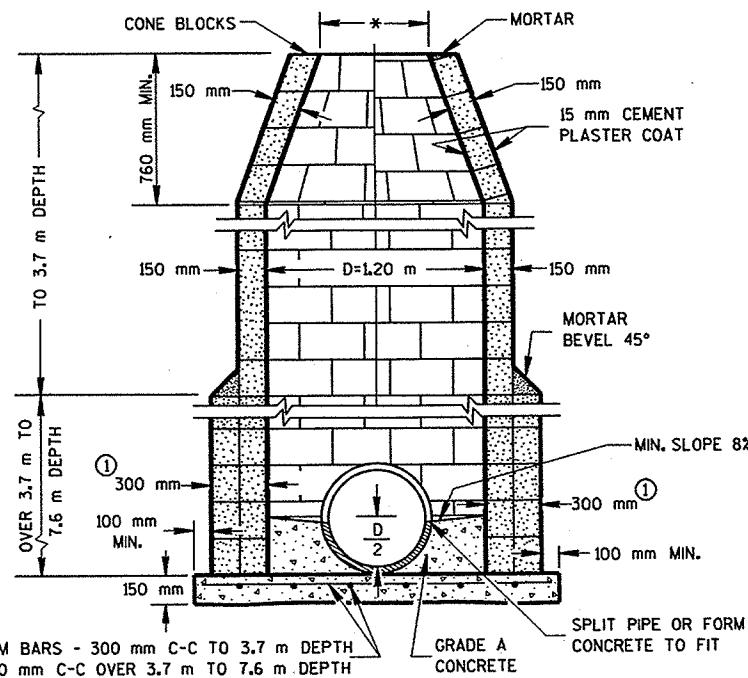

CONCRETE BLOCK

GENERAL NOTES

DETAILS OF CONSTRUCTION, MATERIALS AND WORKMANSHIP NOT SHOWN ON THIS DRAWING SHALL CONFORM TO THE PERTINENT REQUIREMENTS OF THE STANDARD SPECIFICATIONS AND THE APPLICABLE SPECIAL PROVISIONS.

DETAILED DRAWINGS FOR PROPOSED ALTERNATE DESIGNS FOR UNDERGROUND DRAINAGE STRUCTURES SHALL BE SUBMITTED TO THE ENGINEER FOR APPROVAL PROVIDING THAT SUCH ALTERNATE DESIGNS MAKE PROVISION FOR EQUIVALENT CAPACITY AND STRENGTH.

ALL DRAINAGE STRUCTURES ARE DESIGNATED ON THE PLANS AS "MANHOLES 1-C", "CATCH BASINS 1-B", "INLETS 3-H", ETC. THE FIRST DIGIT DESIGNATES THE MASONRY PORTION OF THE STRUCTURE, AND THE FOLLOWING LETTER DESIGNATES THE TYPE OF COVER TO BE USED TO COMPRISE THE COMPLETE UNIT.

PRECAST REINFORCED BASES SHALL BE PLACED ON A BED OF MATERIAL AT LEAST 150 mm IN DEPTH, WHICH MEETS THE REQUIREMENTS OF GRANULAR BACKFILL. THIS BEDDING SHALL BE COMPACTED AND PROVIDE UNIFORM SUPPORT FOR THE ENTIRE AREA OF THE BASE.

PRECAST REINFORCED CONE TOPS (ECCENTRIC OR CONCENTRIC) MAY BE USED ON CONCRETE BLOCK STRUCTURES. THE CONE TOPS SHALL BE INSTALLED ON A BED OF MORTAR.

ECCENTRIC CONE TOPS MAY BE USED ON ALL STRUCTURES, AND CONCENTRIC CONE TOPS SHALL BE USED ONLY ON STRUCTURES 1.5 m OR LESS IN DEPTH, UNLESS OTHERWISE DIRECTED BY THE ENGINEER.

STEPS MEETING THE FOLLOWING REQUIREMENTS SHALL BE INSTALLED IN ALL STRUCTURES OVER 1.5 m IN DEPTH: 400 mm C-C MAXIMUM SPACING; PROJECT A MINIMUM CLEAR DISTANCE OF 100 mm FROM THE WALL AT THE POINT OF EMBEDMENT; MINIMUM LENGTH OF 250 mm; MINIMUM WALL EMBEDMENT OF 75 mm; AND BE CAPABLE OF SUPPORTING A CONCENTRATED LOAD OF 136 kg FERROUS METAL STEPS NOT PAINTED OR TREATED TO RESIST CORROSION SHALL HAVE A MINIMUM CROSS SECTIONAL DIMENSION OF 25 mm.

SOLID ALUMINUM STEPS SHALL HAVE A MINIMUM CROSS SECTIONAL DIMENSION OF 19 mm. ALUMINUM SURFACES TO BE EMBEDDED IN CONCRETE SHALL BE GIVEN ONE COAT OF SUITABLE QUALITY PAINT, SUCH AS ZINC CHROMATE PRIMER CONFORMING TO FEDERAL SPECIFICATION TT-P-645 OR EQUIVALENT. STEPS OF APPROVED POLYPROPYLENE PLASTIC COATED REINFORCEMENT BAR ARE ACCEPTABLE.

ALL BAR STEEL REINFORCEMENT SHALL BE EMBEDDED 50 mm CLEAR UNLESS OTHERWISE SHOWN OR NOTED.

PRECAST REINFORCED CONCRETE RISERS MAY BE PLACED WITH TONGUE UP OR DOWN.

ALL PRECAST INLET UNITS SHALL CONFORM TO THE PERTINENT REQUIREMENTS OF AASHTO DESIGNATION M199M.

* USE 600 mm DIAMETER OPENING WITH TYPE "C", "L" AND "J" COVERS, OR 900 mm DIAMETER WITH TYPE "K" AND "M" COVERS.

① 2 COURSES 150 mm BLOCK.

MANHOLES TYPE 1

STATE OF WISCONSIN
DEPARTMENT OF TRANSPORTATION

APPROVED
02/07/80
DATE
CHIEF ROADWAY DEVELOPMENT ENGINEER

PLOT SCALE:

PLOT NAME:


REV. DATE:

ORIGINATOR:


S.D.D. 8 C 1-5

LEVELS ON - 2,3,4,5,6,7,8,9,10,11,12,13,14,15,16,17,18,19,20,21,22,23,24,25,26,27,28,29,30,31,32,33,34,35,36,37,38,39,40,41,42,43,44,45,46,47,48,49,50,51,52,53,54,55,56,57,58,59,60,61,62,63

*SELECTION OF SQUARE OR CIRCULAR DESIGN WILL BE BASED ON THE PIPE SIZES AND THE INLET COVER BEING UTILIZED

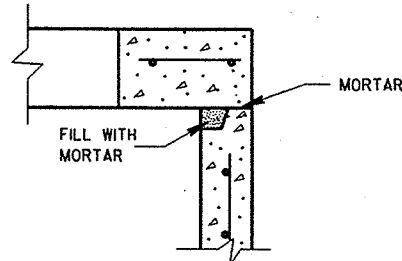

DETAIL "A"

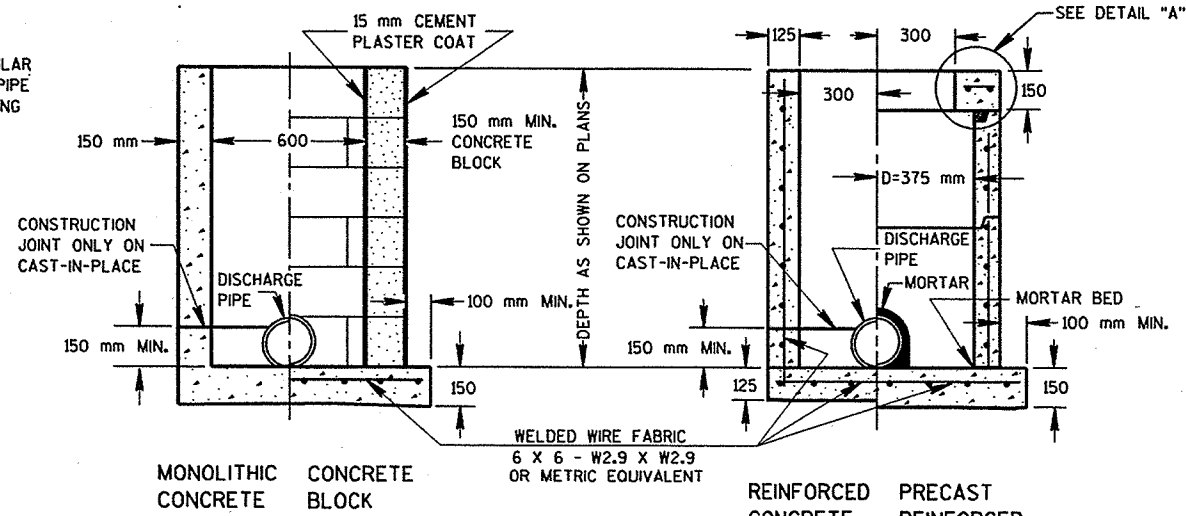

INLETS TYPE 1

GENERAL NOTES

DETAILS OF CONSTRUCTION, MATERIALS AND WORKMANSHIP NOT SHOWN ON THIS DRAWING SHALL CONFORM TO THE PERTINENT REQUIREMENTS OF THE STANDARD SPECIFICATIONS AND THE APPLICABLE SPECIAL PROVISIONS.

DETAILED DRAWINGS FOR PROPOSED ALTERNATE DESIGNS FOR UNDERGROUND DRAINAGE STRUCTURES SHALL BE SUBMITTED TO THE ENGINEER FOR APPROVAL PROVIDING THAT SUCH ALTERNATE DESIGNS MAKE PROVISION FOR EQUIVALENT CAPACITY AND STRENGTH.

ALL PRECAST INLET UNITS SHALL CONFORM TO THE PERTINENT REQUIREMENTS OF AASHTO DESIGNATION 199 M.

ALL DRAINAGE STRUCTURES ARE DESIGNATED ON THE PLANS AS "MANHOLES 1-C", "CATCH BASINS 1-B", "INLETS 3-H", ETC. THE FIRST DIGIT DESIGNATES THE MASONRY PORTION OF THE STRUCTURE, AND THE FOLLOWING LETTER DESIGNATES THE TYPE OF COVER TO BE USED TO COMPRISE THE COMPLETE UNIT.

PRECAST REINFORCED BASES SHALL BE PLACED ON A BED OF MATERIAL AT LEAST 150 mm IN DEPTH, WHICH MEETS THE REQUIREMENTS OF GRANULAR BACKFILL. THIS BEDDING SHALL BE COMPACTED AND PROVIDE UNIFORM SUPPORT FOR THE ENTIRE AREA OF THE BASE.

PRECAST REINFORCED CONCRETE FLAT SLAB TOPS MAY BE USED ON THE STRUCTURES. THE TOPS SHALL BE INSTALLED ON A BED OF MORTAR.

ALL BAR STEEL REINFORCEMENT SHALL BE EMBEDDED 50 mm CLEAR UNLESS OTHERWISE SHOWN OR NOTED.


PRECAST REINFORCED CONCRETE RISERS SHALL BE PLACED WITH TONGUE DOWN.

1 USE 760 mm OPENING FOR TYPE 2 INLETS, 915 mm. OPENING FOR TYPE 3 INLETS, AND 890 mm TYPE 4 INLETS.


2 USE 610 mm OPENING FOR TYPE 1, 2 & 3 INLETS, 775 mm OPENING FOR TYPE 4 INLETS.

NOTE


ALL DIMENSIONS ARE IN MILLIMETERS UNLESS OTHERWISE SHOWN.

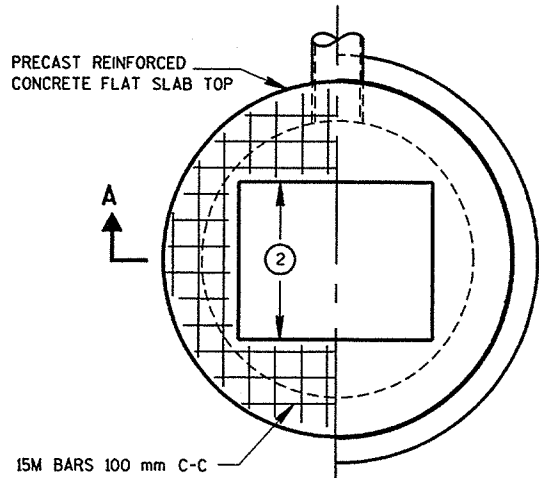


PLAN VIEW

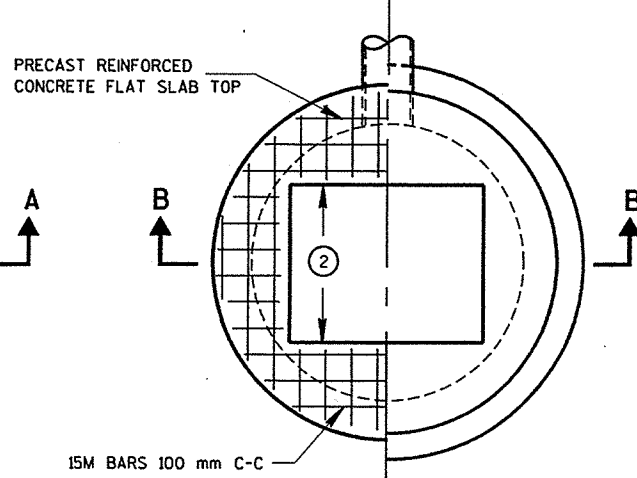


PLAN VIEW

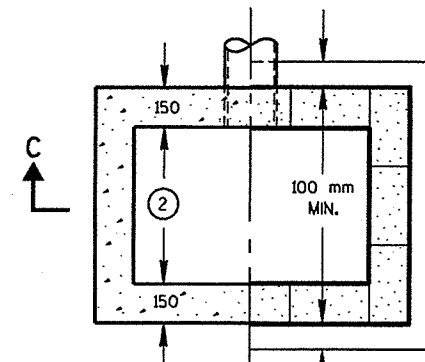

PLAN VIEW

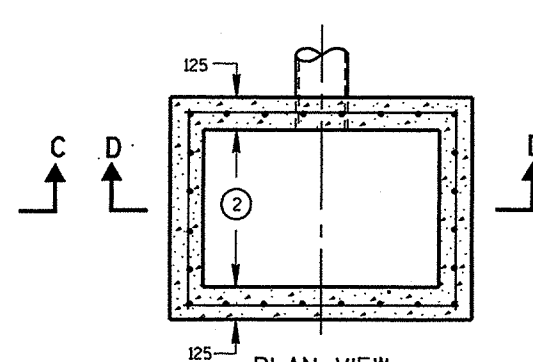


PLAN VIEW

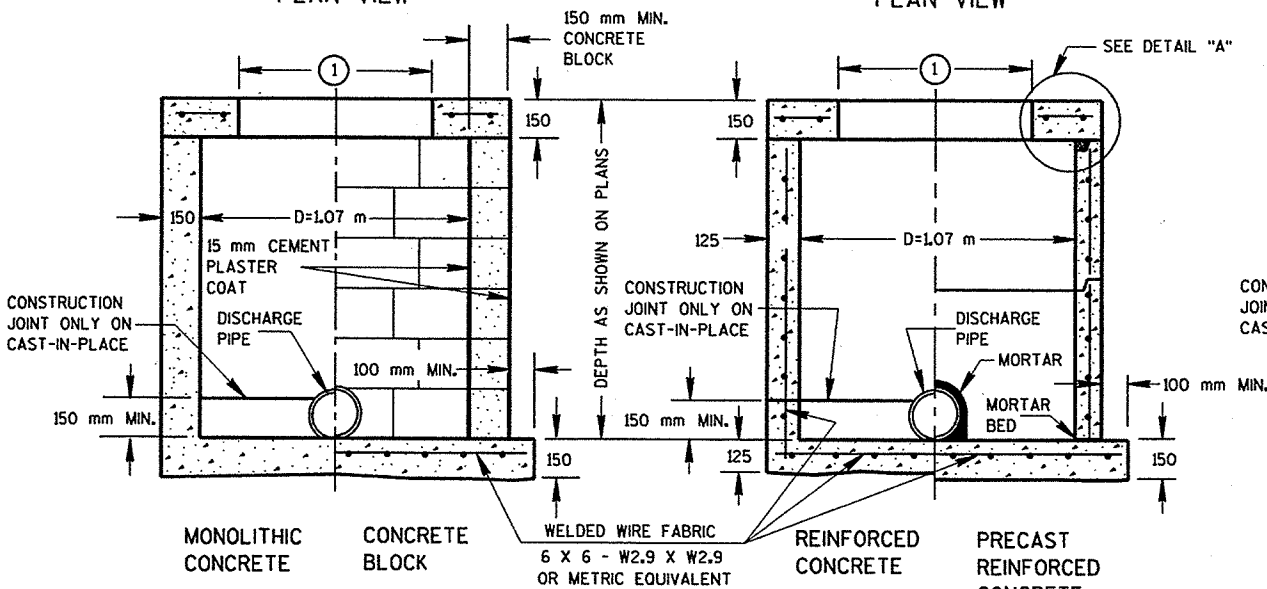

SECTION A-A

SECTION B-B

INLETS TYPE 2, 3 & 4

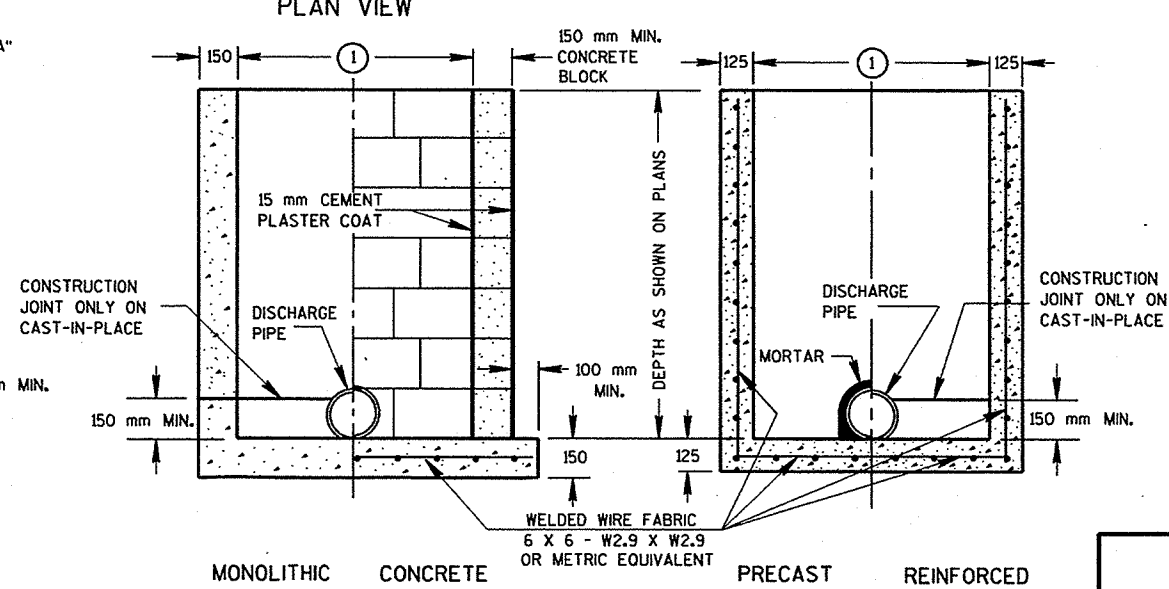

SECTION C-C

SECTION D-D

INLETS TYPE 1, 2, 3 & 4

STATE OF WISCONSIN DEPARTMENT OF TRANSPORTATION

APPROVED 01/31/95 DATE Roy L. Thompson CHIEF ROADWAY DEVELOPMENT ENGINEER

S.D.D. 8 C 1-5


PLOT SCALE:

PLOT NAME:


REV. DATE:

ORIGINATOR:


S.D.D. 8 B 7-3
LEVELS ON - 2, 3, 4, 62, 63

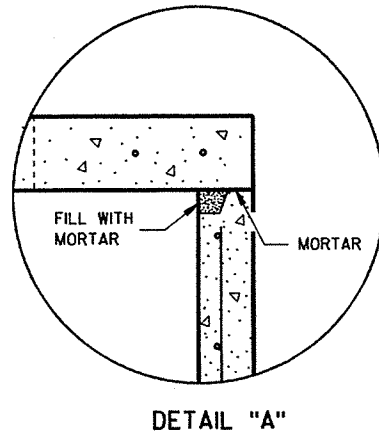


DETAIL "A"

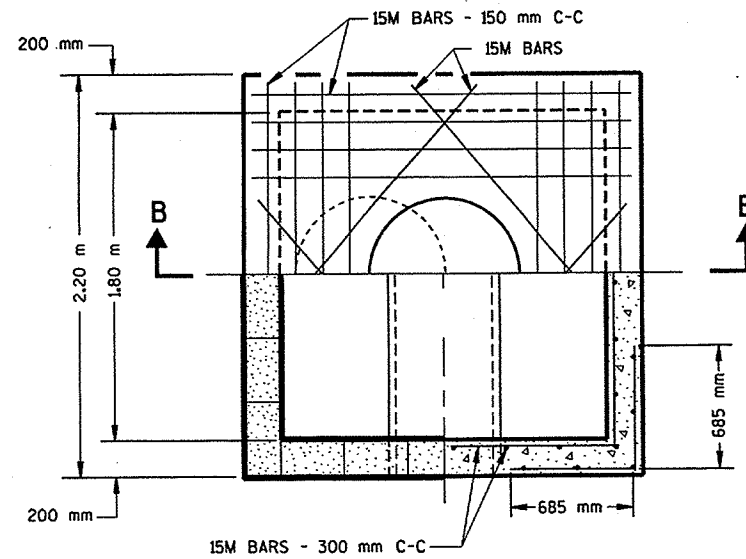


HALF SECTION A-A

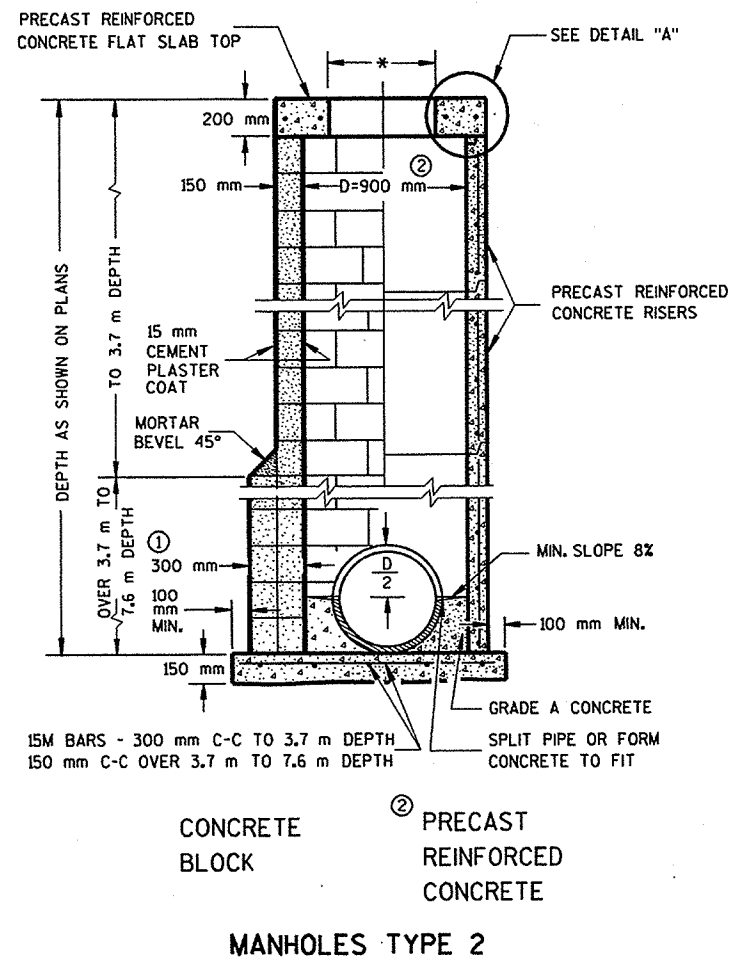

MANHOLES TYPE 2

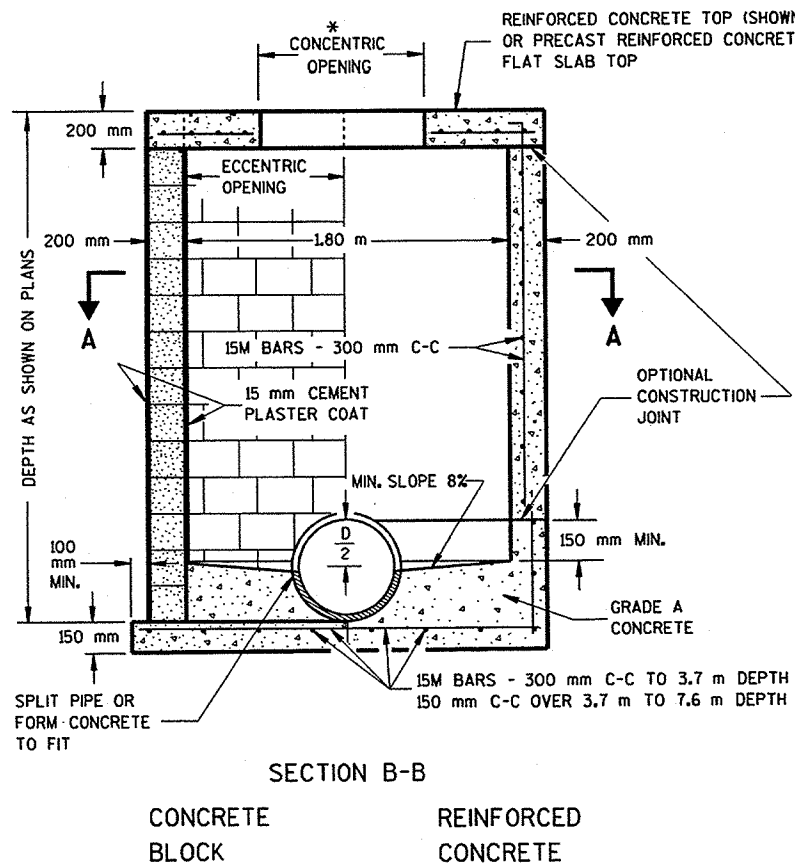

MANHOLES TYPE 3

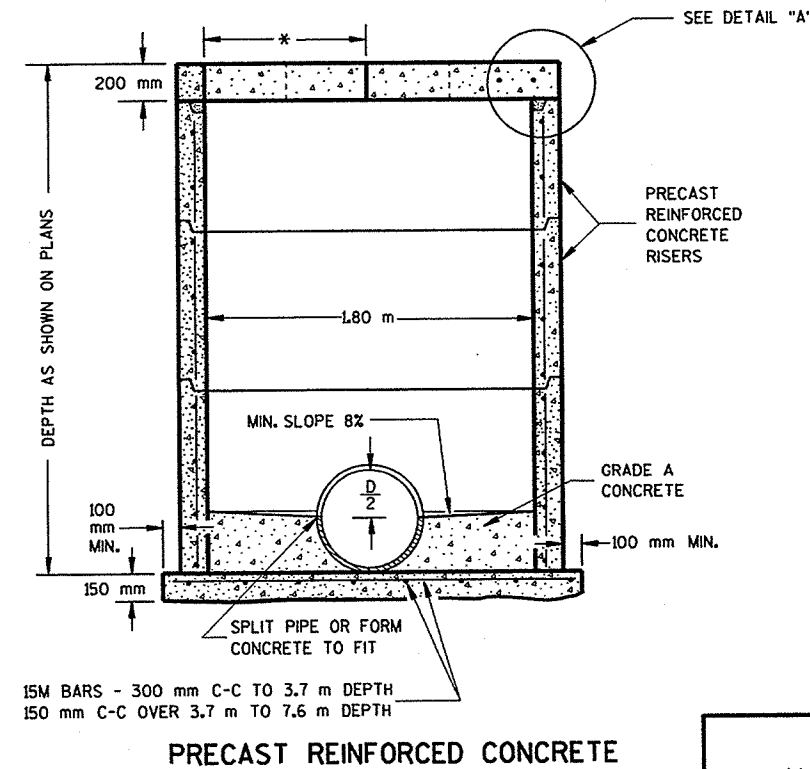

PRECAST REINFORCED CONCRETE

GENERAL NOTES

DETAILS OF CONSTRUCTION, MATERIALS AND WORKMANSHIP NOT SHOWN ON THIS DRAWING SHALL CONFORM TO THE PERTINENT REQUIREMENTS OF THE STANDARD SPECIFICATIONS AND THE APPLICABLE SPECIAL PROVISIONS.

DETAILED DRAWINGS FOR PROPOSED ALTERNATE DESIGNS FOR UNDERGROUND DRAINAGE STRUCTURES SHALL BE SUBMITTED TO THE ENGINEER FOR APPROVAL PROVIDING THAT SUCH ALTERNATE DESIGNS MAKE PROVISION FOR EQUIVALENT CAPACITY AND STRENGTH.

ALL DRAINAGE STRUCTURES ARE DESIGNATED ON THE PLANS AS "MANHOLES 1-C", "CATCH BASINS 1-B", "INLETS 3-H", ETC. THE FIRST DIGIT DESIGNATES THE MASONRY PORTION OF THE STRUCTURE, AND THE FOLLOWING LETTER DESIGNATES THE TYPE OF COVER TO BE USED TO COMPRISE THE COMPLETE UNIT.

PRECAST REINFORCED BASES SHALL BE PLACED ON A BED OF MATERIAL AT LEAST 150 mm IN DEPTH, WHICH MEETS THE REQUIREMENTS OF GRANULAR BACKFILL. THIS BEDDING SHALL BE COMPACTED AND PROVIDE UNIFORM SUPPORT FOR THE ENTIRE AREA OF THE BASE.

STEPS MEETING THE FOLLOWING REQUIREMENTS SHALL BE INSTALLED IN ALL STRUCTURES OVER 1.5 m IN DEPTH: 400 mm C-C MAXIMUM SPACING; PROJECT A MINIMUM CLEAR DISTANCE OF 100 mm FROM THE WALL AT THE POINT OF EMBEDMENT; MINIMUM LENGTH OF 150 mm; MINIMUM WALL EMBEDMENT OF 75 mm; AND BE CAPABLE OF SUPPORTING A CONCENTRATED LOAD OF 136 kg FERROUS METAL STEPS NOT PAINTED OR TREATED TO RESIST CORROSION SHALL HAVE A MINIMUM CROSS SECTIONAL DIMENSION OF 25 mm.

SOLID ALUMINUM STEPS SHALL HAVE A MINIMUM CROSS SECTIONAL DIMENSION OF 19 mm. ALUMINUM SURFACES TO BE EMBEDDED IN CONCRETE SHALL BE GIVEN ONE COAT OF SUITABLE QUALITY PAINT, SUCH AS ZINC CHROMATE PRIMER CONFORMING TO FEDERAL SPECIFICATION TT-P-645 OR EQUIVALENT. STEPS OF APPROVED POLYPROPYLENE PLASTIC COATED REINFORCEMENT BAR ARE ACCEPTABLE.

ALL BAR STEEL REINFORCEMENT SHALL BE EMBEDDED 50 mm CLEAR UNLESS OTHERWISE SHOWN OR NOTED.

PRECAST REINFORCED CONCRETE RISERS MAY BE PLACED WITH TONGUE UP OR DOWN.

ALL PRECAST INLET UNITS SHALL CONFORM TO THE PERTINENT REQUIREMENTS OF AASHTO DESIGNATION M199M.

* USE 600 mm DIAMETER OPENING WITH TYPE "C", "L" AND "J" COVERS, OR 900 mm DIAMETER WITH TYPE "K" AND "M" COVERS.

① 2 COURSES 150 mm BLOCK.

② WHEN CONNECTING PIPES ARE 600 mm OR LARGER THE PRECAST MANHOLES MAY BE INCREASED TO 107 m DIAMETER.

MANHOLES TYPE 2 & 3

STATE OF WISCONSIN
DEPARTMENT OF TRANSPORTATION

APPROVED
01/27/95
DATE
Hory R. Stanton
CHIEF ROADWAY DEVELOPMENT ENGINEER
FHWA


PLOT SCALE:

PLOT NAME:


REV. DATE:

ORIGINATOR:


S.D.D. 8 D 1-12
LEVELS ON - 2.3, 4, 5.6, 7.8, 9.10, 11, 12, 13, 62, 63

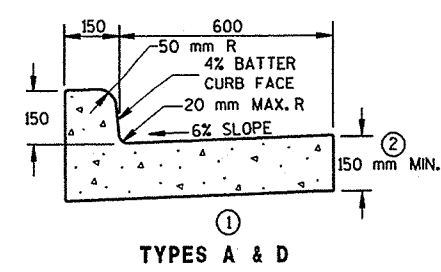


TYPES A & D

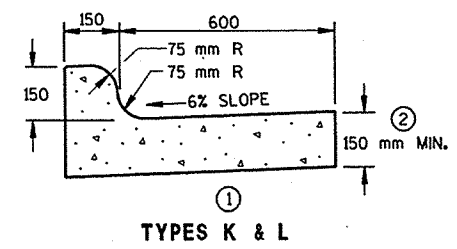


TYPES K & L

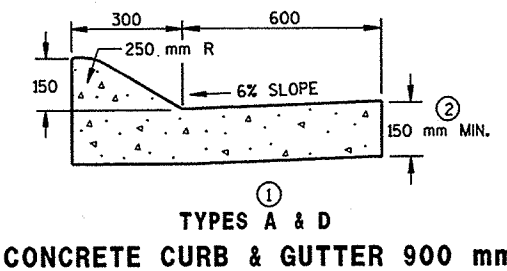


TYPES A & D
CONCRETE CURB & GUTTER 900 mm

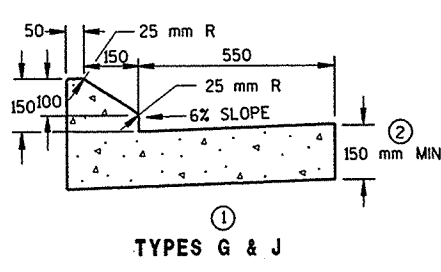

TYPES G & J

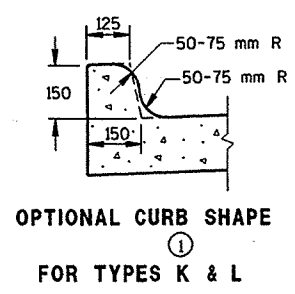


OPTIONAL CURB SHAPE
FOR TYPES K & L

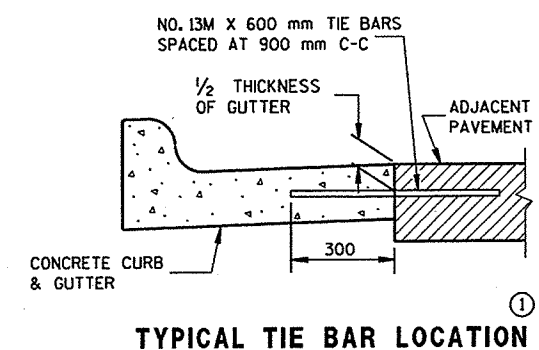


TYPICAL TIE BAR LOCATION

CONCRETE CURB & GUTTER 750 mm

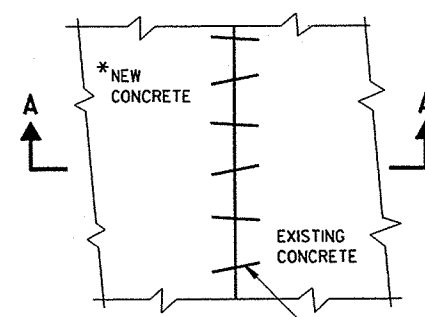

PLAN VIEW


*NEW CURB & GUTTER,
SURFACE DRAINS,
CONCRETE PAVEMENT
OR OTHER NEW CONCRETE.

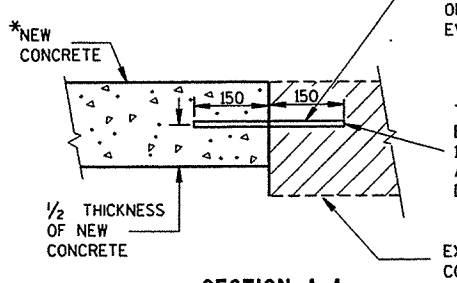


SECTION A-A
PAVEMENT TIES

NO. 19M X 300 mm DEF. BARS
SPACED 900 mm C-C,
INSTALLED ON 6:1 SKEW
HORIZONTALLY. DIRECTION
OF SKEW ALTERNATING AFTER
EVERY ONE OR TWO BARS.


THE HOLE FOR THE BAR SHALL
BE DRILLED TO A DEPTH OF
175 mm AND TO SUCH A DIAMETER
AS TO PROVIDE A TIGHT
DRIVEN FIT

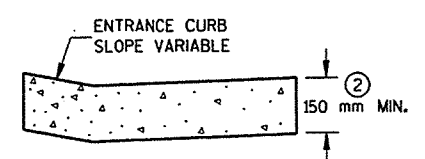


DRIVEWAY ENTRANCE CURB
(WHEN DIRECTED BY THE ENGINEER)

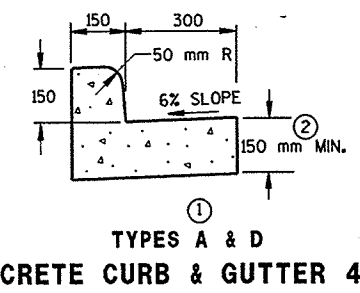


TYPES A & D
CONCRETE CURB & GUTTER 450 mm

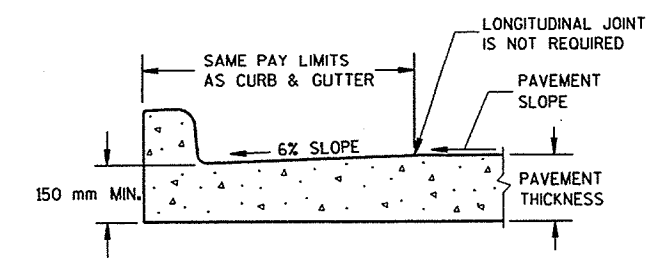


PARTIAL SECTION OF PAVEMENT
WITH INTEGRAL CURB & GUTTER

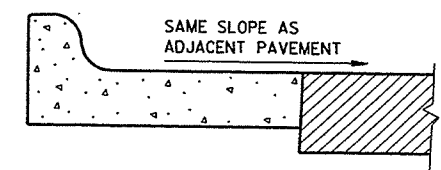

REVERSE SLOPE GUTTER
(TYPICAL FOR ALL CURB & GUTTER TYPES)

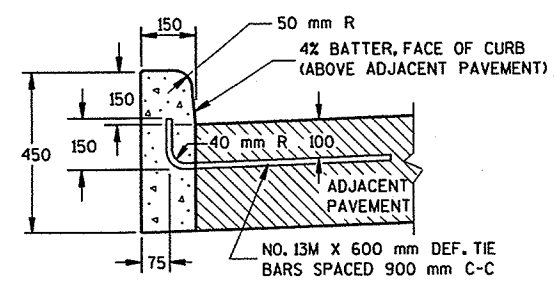

TYPES A & D

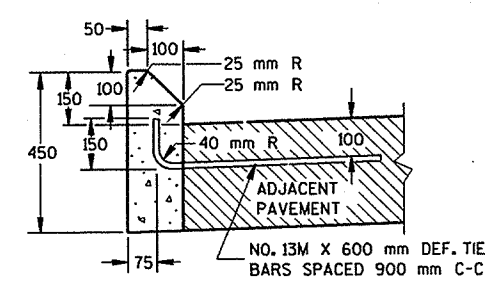

TYPES G & J

CONCRETE CURB

GENERAL NOTES

DETAILS OF CONSTRUCTION, MATERIALS AND WORKMANSHIP NOT SHOWN ON THIS DRAWING SHALL CONFORM TO THE PERTINENT REQUIREMENTS OF THE CONTRACT.

PAVEMENT TIES AND TIE BARS SHALL BE EPOXY COATED IN CONFORMANCE WITH SUBSECTION 505.2.6.2 OF THE STANDARD SPECIFICATIONS.

INTEGRAL CURB & GUTTER SHALL CONFORM TO THE DETAILS SHOWN FOR CONCRETE CURB & GUTTER INCLUDING THE TRANSVERSE GUTTER SLOPE. A LONGITUDINAL CONSTRUCTION JOINT IS NOT REQUIRED WITH INTEGRAL CURB AND GUTTER.

WHERE THE TRANSVERSE JOINTS IN THE PAVEMENT ARE REQUIRED TO BE SEALED, THE JOINTS IN THE INTEGRAL CURB AND GUTTER SHALL BE SEALED TO THE FACE OF CURB WITH THE SAME TYPE OF SEALANT. THE COST OF FURNISHING AND INSTALLING THIS SEALANT SHALL BE INCIDENTAL TO THE ITEM CONCRETE CURB AND GUTTER.

UNLESS OTHERWISE SHOWN ON THE TYPICAL CROSS SECTIONS, THE BASE COURSE AND UNCLASSIFIED EXCAVATION LIMITS ARE 600 mm BEHIND THE BACK OF CURBS.

- ① TIE BARS ARE REQUIRED FOR CURB AND GUTTER TYPES A, G AND K.
- ② THE BOTTOM OF CURB AND GUTTER MAY BE CONSTRUCTED EITHER LEVEL OR PARALLEL TO THE SLOPE OF THE SUBGRADE OR BASE COURSE PROVIDED A 150 mm MINIMUM GUTTER THICKNESS IS MAINTAINED.
- ③ WHEN REVERSE SLOPE GUTTER IS REQUIRED, THE LOCATION(S) WILL BE SHOWN ELSEWHERE IN THE PLAN.

NOTE

DIMENSIONS ARE IN MILLIMETERS UNLESS OTHERWISE SHOWN.

CONCRETE CURB, CONCRETE CURB & GUTTER AND PAVEMENT TIES

STATE OF WISCONSIN
DEPARTMENT OF TRANSPORTATION

APPROVED
10/22/96
DATE
Roy T. Thompson
CHIEF ROADWAY DEVELOPMENT ENGINEER

FWA


S.D.D. 8 E 9-5
 LEVELS ON • 2, 3, 4, 62, 63

PLOT SCALE:

PLOT NAME:

REV. DATE:

ORIGINATOR:

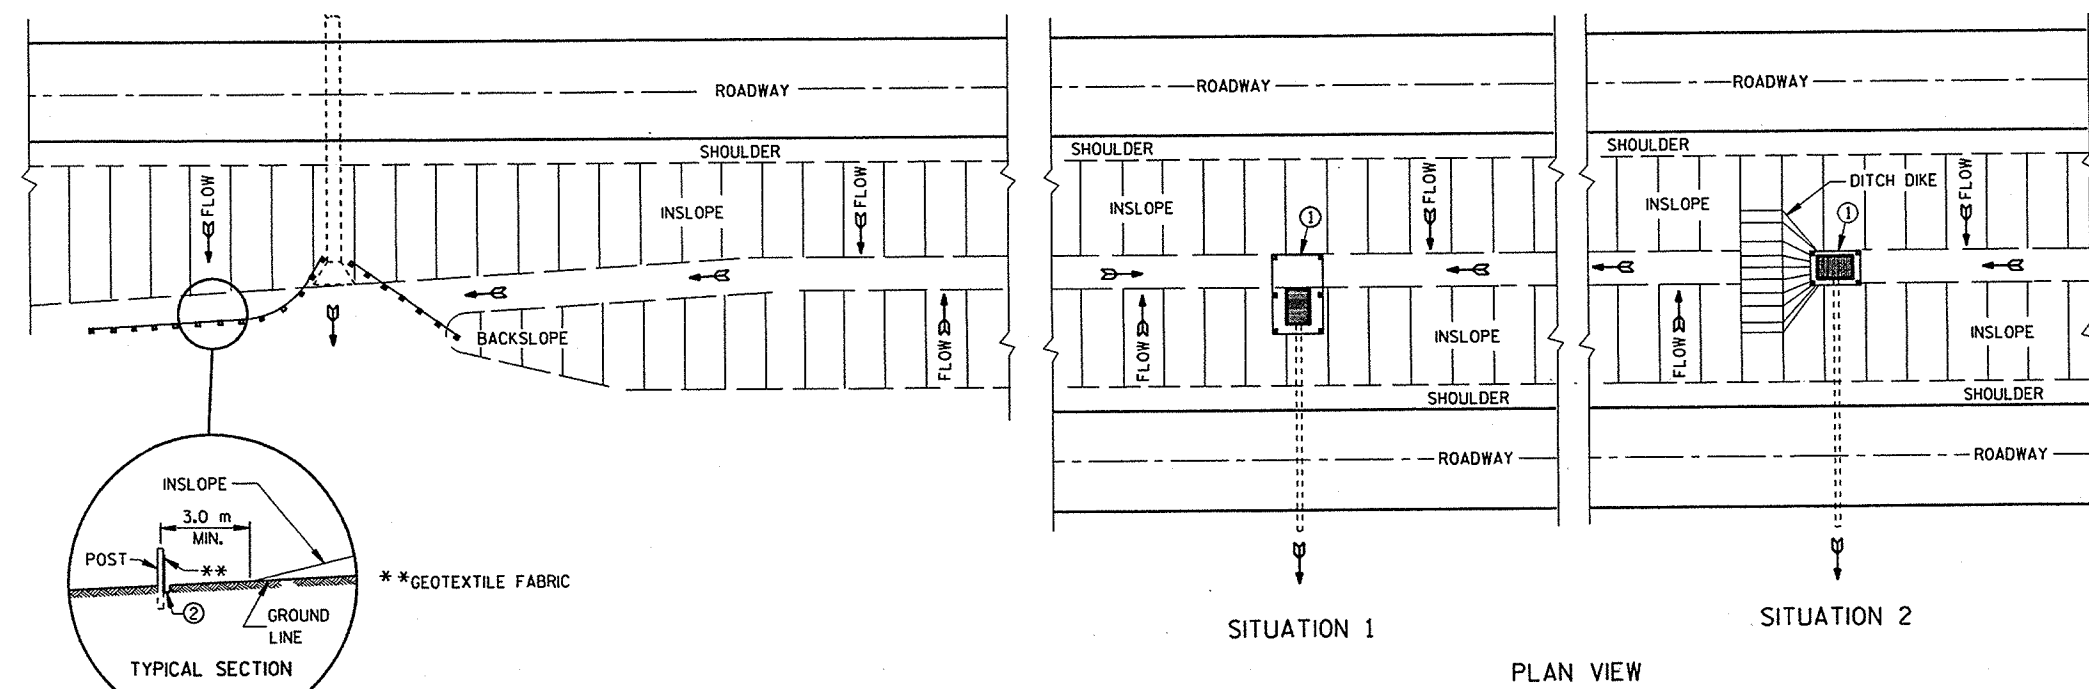


TYPICAL APPLICATIONS OF SILT FENCE

SILT FENCE AT MEDIAN SURFACE DRAINS


GENERAL NOTES

- DETAILS OF CONSTRUCTION NOT SHOWN ON THIS DRAWING SHALL CONFORM TO THE PERTINENT REQUIREMENTS OF THE STANDARD SPECIFICATIONS AND APPLICABLE SPECIAL PROVISIONS.
- ① HORIZONTAL BRACE WITH 50 mm X 100 mm WOODEN FRAME OR EQUIVALENT AT TOP OF POSTS AS DIRECTED BY THE ENGINEER.
 - ② TRENCH SHALL BE A MINIMUM OF 100 mm WIDE & 150 mm DEEP TO BURY AND ANCHOR THE GEOTEXTILE FABRIC. FOLD MATERIAL TO FIT TRENCH AND BACKFILL & COMPACT TRENCH WITH EXCAVATED SOIL.
 - ③ WOOD POSTS SHALL BE A MINIMUM SIZE OF 30 mm X 30 mm OF OAK OR HICKORY.

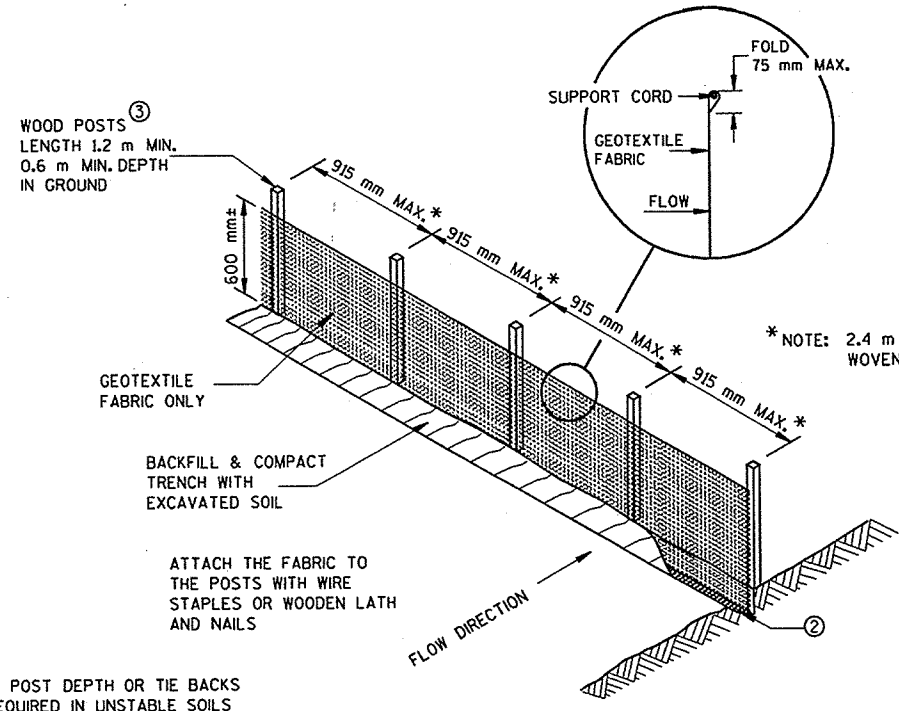


SILT FENCE (NON-REINFORCED)

NOTE: ADDITIONAL POST DEPTH OR TIE BACKS MAY BE REQUIRED IN UNSTABLE SOILS

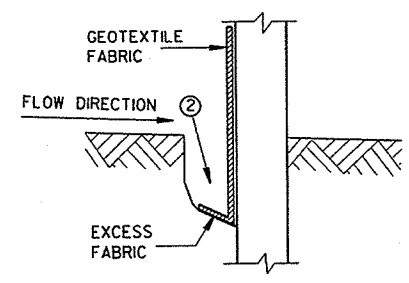

TRENCH DETAIL

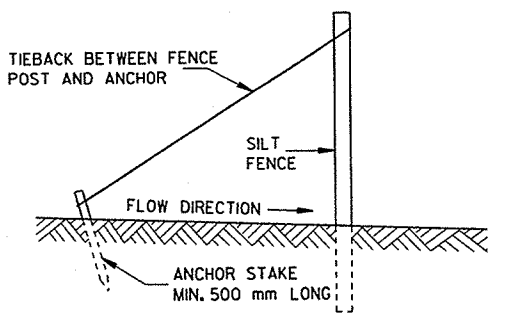

SILT FENCE TIE BACK (WHEN REQUIRED BY THE ENGINEER)

SILT FENCE	
STATE OF WISCONSIN DEPARTMENT OF TRANSPORTATION	
APPROVED 03/11/96 DATE	 CHIEF ROADWAY DEVELOPMENT ENGINEER
FHWA	

PLOT SCALE:

PLOT NAME:

REV. DATE:

ORIGINATOR:


S.D.D. 8 F 1-11
LEVELS ON - 2.3, 4, 5.6, 7.8, 9.10, 11, 12, 13, 62, 63

METAL APRON ENDWALLS											
PIPE DIA. (mm)	MIN. THICK. (mm)		DIMENSIONS (MILLIMETERS)							APPROX. SLOPE	BODY
	STEEL	ALUM.	A (±1")	B (MAX.)	H (±1")	L (±1/2")	L ₁ (1)	L ₂ (1)	W (±2")		
300	1.6	1.5	150	150	150	535	305	445	610	1:2.5	1 Pc.
375	1.6	1.5	180	205	150	660	355	552	760	1:2.5	1 Pc.
450	1.6	1.5	205	255	150	790	380	718	915	1:2.5	1 Pc.
525	1.6	1.5	230	305	150	915	455	752	1065	1:2.5	1 Pc.
600	1.6	1.5	255	330	150	1040	455	949	1220	1:2.5	1 Pc.
750	2.0	1.9	305	405	205	1300	455	1327	1525	1:2.5	1 Pc.
900	2.0	1.9	355	480	230	1525	610	1905	1830	1:2.5	2 Pc.
1050	2.8	2.7	405	560	280	1755	610	1921	2135	1:2.5	2 Pc.
1200	2.8	2.7	455	685	305	1980	610	2057	2285	1:2.5	3 Pc.
1350	2.8	2.7	455	760	305	2140	760	2172	2590	1:2.25	3 Pc.
1500	2.8x	2.7x	455	840	305	2210	—	—	2895	1:2	3 Pc.
1650	2.8x	2.7x	455	915	305	2210	—	—	3050	1:2	3 Pc.
1800	2.8x	2.7x	455	990	305	2210	—	—	3200	1:2	3 Pc.
1950	2.8x	2.7x	455	1070	305	2210	—	—	3355	1:1.5	3 Pc.
2100	2.8x	2.7x	455	1145	305	2210	—	—	3505	1:1.5	3 Pc.
2250	2.8x	2.7x	455	940	305	2210	—	—	3660	1:1.5	3 Pc.
2400	2.8x	2.7x	455	890	305	2210	—	—	3960	1:1.5	3 Pc.


* EXCEPT CENTER PANEL SEE GENERAL NOTES

REINFORCED CONCRETE APRON ENDWALLS									
PIPE DIA. (mm)	DIMENSIONS (MILLIMETERS)							APPROX. SLOPE	
	T	A	B	C	D	E	G		
305	51	102	610	1241	1851	610	51	1:3	
380	57	152	686	1168	1854	762	57	1:3	
450	64	229	686	1168	1854	914	64	1:3	
525	70	229	915	953	1867	1067	70	1:3	
600	76	241	1105	762	1867	1219	76	1:3	
675	83	267	1257	610	1867	1372	83	1:3	
750	89	305	1372	502	1867	1524	89	1:3	
900	102	381	1600	883	2483	1829	102	1:3	
1050	114	533	1600	889	2489	1981	114	1:3	
1200	127	610	1829	660	2489	2134	127	1:3	
1350	140	686	1651	**635**	**2496**	2286	140	1:2.4	
1500	152	**762**	1524	991	2515	2448	152	1:2	
1650	165	**610**	**1829**	**533**	2515	2591	165	1:2	
1800	178	**610**	**1981**	**533**	2515	2743	178	1:2	
1950	190	**610**	1981	533	2515	2896	195	1:2	
2100	203	915	2299	533	2515	3048	210	1:1.5	
2250	216	1041	2222	610	2832	3353	216	1:1.5	


* MINIMUM
** MAXIMUM

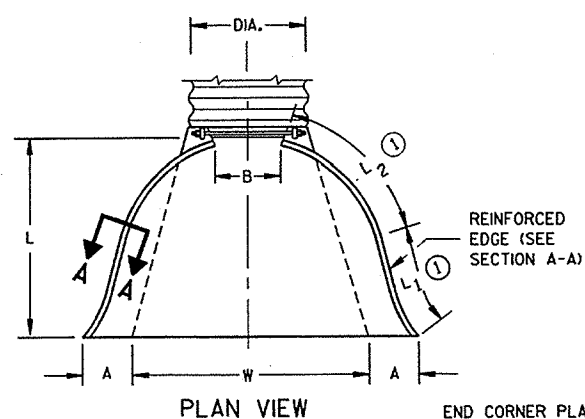

PLAN VIEW

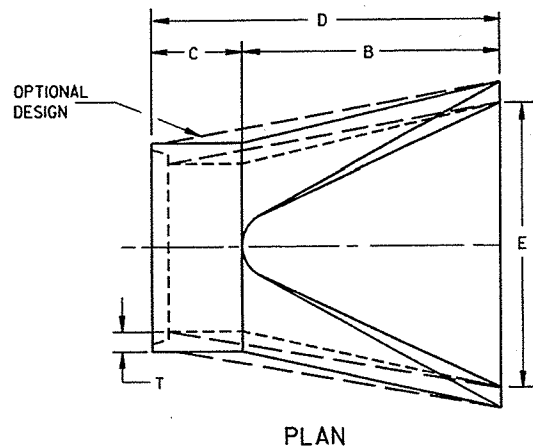


PLAN

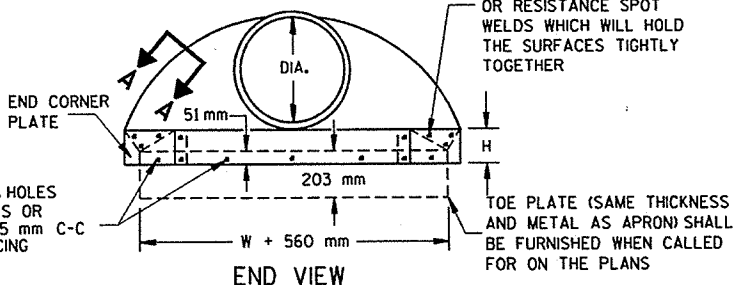


END VIEW


END CORNER PLATES MAY BE FASTENED TO APRON PROPER BY BOLTS, RIVETS, OR RESISTANCE SPOT WELDS WHICH WILL HOLD THE SURFACES TIGHTLY TOGETHER
TOE PLATE (SAME THICKNESS AND METAL AS APRON) SHALL BE FURNISHED WHEN CALLED FOR ON THE PLANS

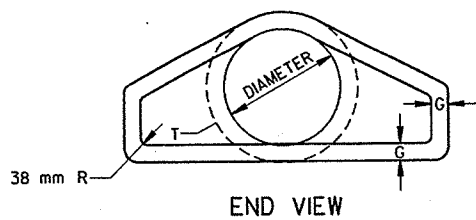

END VIEW

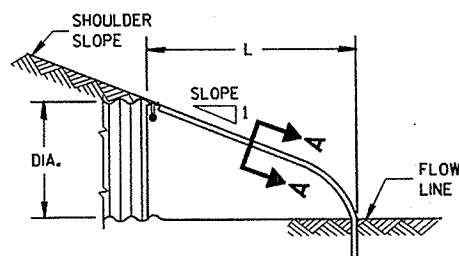


SIDE ELEVATION METAL ENDWALLS

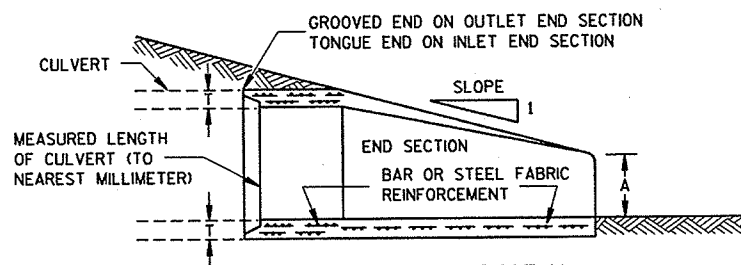


LONGITUDINAL SECTION CONCRETE ENDWALLS

25 mm WIDE, 2.7 mm THICK GALVANIZED STRAP WITH STANDARD 152 mm X 13mm BAND BOLT AND NUT

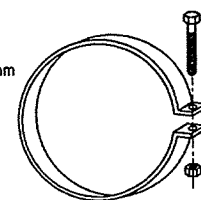


ALTERNATE FOR TYPE 1 CONNECTION END SECTION CONNECTOR STRAP

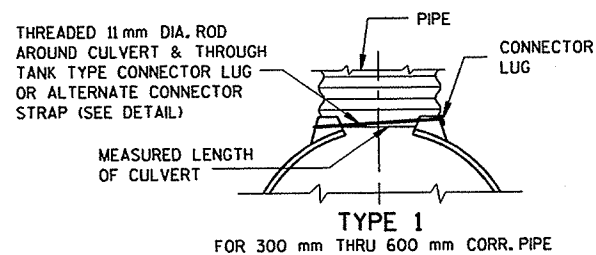


TYPE 1 FOR 300 mm THRU 600 mm CORR. PIPE


THREADED 11 mm DIA. ROD OVER TOP OF APRON, SIDE LUGS TO BE RIVETED TO APRON

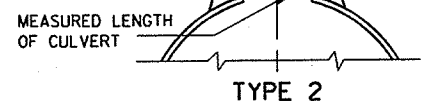

TYPE 2 FOR 750 mm THRU 2400 mm CORR. PIPE

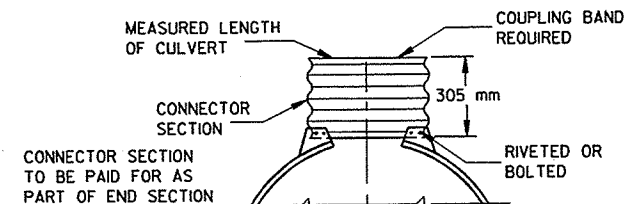

TYPE 3 FOR 1050 mm THRU 2400 mm CORR. PIPE

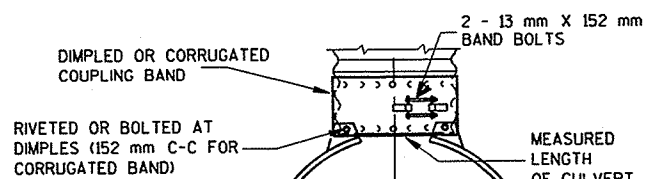

TYPE 5 ALTERNATE FOR: ALL SIZES CORRUGATED CIRCULAR PIPE


NOTE: DIMPLED BAND FITS OVER OUTSIDE OF ENDWALL, AND CORRUGATED BAND FITS INSIDE ENDWALL. DIMPLED BAND MAY BE USED WITH HELICALLY CORRUGATED PIPE.

FOR CIRCUMFERENTIALLY CORRUGATED PIPE USE ENDWALL CONNECTION DETAILS 1, 2, 3 OR 5 AS APPLICABLE.

FOR HELICALLY CORRUGATED PIPE USE ENDWALL CONNECTION DETAILS 1, 2 OR 5.

FOR HELICALLY CORRUGATED PIPES WITH TWO CIRCUMFERENTIAL CORRUGATIONS AT EACH END USE ENDWALL CONNECTION DETAILS 1, 2 OR 3.

CONNECTION DETAILS

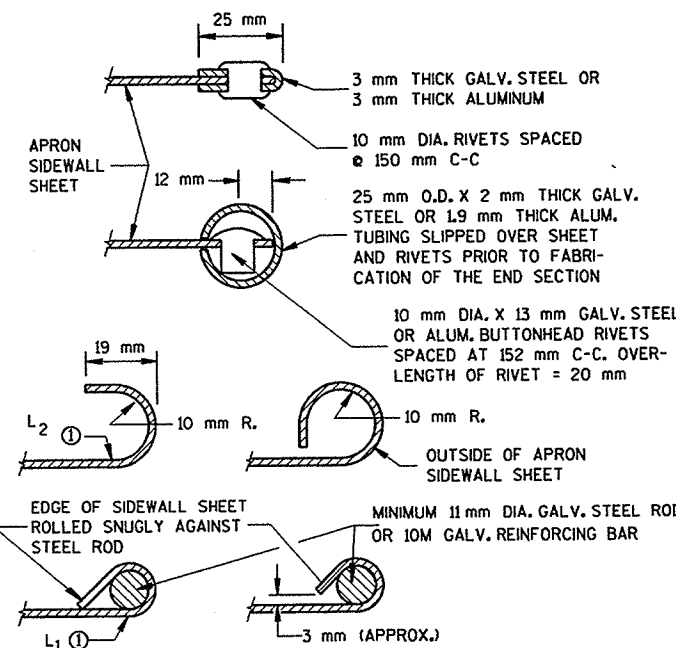

SECTION A-A

GENERAL NOTES

DETAILS OF CONSTRUCTION, MATERIALS AND WORKMANSHIP NOT SHOWN ON THIS DRAWING SHALL CONFORM TO THE PERTINENT REQUIREMENTS OF THE STANDARD SPECIFICATIONS AND THE APPLICABLE SPECIAL PROVISIONS.

CONCRETE CULVERT ENDWALLS MAY NOT BE USED WITH GALVANIZED STEEL OR ALUMINUM CULVERT PIPE OR VICE VERSA. GALVANIZED STEEL OR ALUMINUM ENDWALLS SHALL NORMALLY BE INSTALLED ON CULVERT PIPE OF THE SAME METAL.

ALL THREE PIECE STEEL APRON ENDWALLS FOR 1500 mm DIAMETER PIPE AND LARGER SHALL HAVE 2.8 mm SIDES AND 3.5 mm CENTER PANELS. ALL THREE PIECE ALUMINUM APRON ENDWALLS FOR 1500 mm DIAMETER PIPE AND LARGER SHALL HAVE 3.4 mm SIDES AND 3.4 mm CENTER PANELS. THE WIDTH OF CENTER PANELS SHALL BE GREATER THAN 20 PERCENT OF THE PIPE PERIMETER.

LAP SEAMS SHALL BE TIGHTLY JOINED BY GALVANIZED RIVETS OR BOLTS FOR STEEL UNITS AND ALUMINUM RIVETS AND BOLTS FOR ALUMINUM UNITS. FOR THE 1500 mm THROUGH 2400 mm DIAMETER APRON ENDWALL SIZES, THE REINFORCED EDGES AND CENTER PANEL SEAMS SHALL BE FURTHER REINFORCED WITH GALVANIZED STEEL OR ALUMINUM STIFFENER ANGLES. THE ANGLES SHALL BE ATTACHED BY GALVANIZED NUTS AND BOLTS FOR STEEL UNITS AND ALUMINUM NUTS AND BOLTS FOR ALUMINUM UNITS.

WHERE TWO OR MORE PIPES WITH APRON ENDWALLS ARE LAID ADJACENT TO EACH OTHER, THEY SHALL BE SEPARATED BY A DISTANCE SUFFICIENT TO PROVIDE A MINIMUM CLEARANCE OF 152 mm BETWEEN APRON ENDWALLS.

① FOR PIPE SIZES UP TO 1500 mm DIAMETER, A 180° ROLLED EDGE MAY BE USED INSTEAD OF STEEL ROD REINFORCEMENT. SEE SECTION A-A.

APRON ENDWALLS FOR CULVERT PIPE

STATE OF WISCONSIN DEPARTMENT OF TRANSPORTATION

APPROVED 01/27/95 DATE DATE CHIEF ROADWAY DEVELOPMENT ENGINEER

FWHA


PLOT SCALE:

PLOT NAME:


REV. DATE:

ORIGINATOR:

S.D.D. 8 F 4-5
LEVELS ON - 2, 3, 4, 62, 63

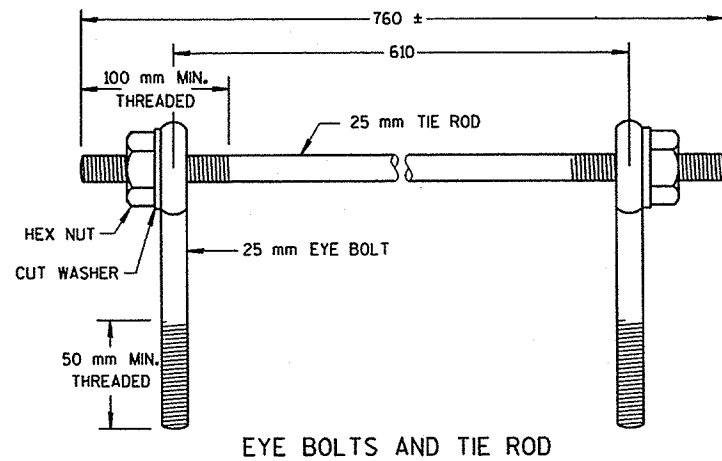

EYE BOLTS AND TIE ROD

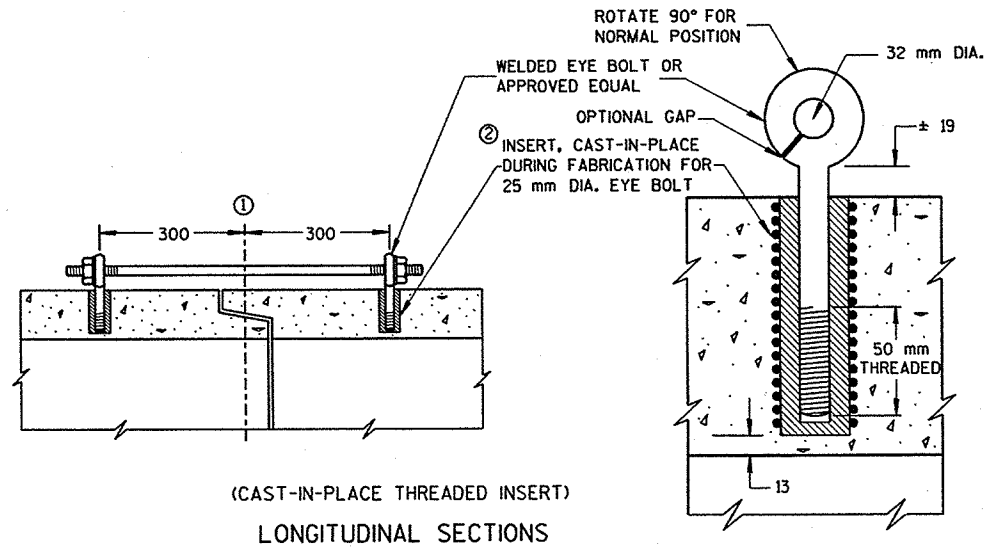

(CAST-IN-PLACE THREADED INSERT)
LONGITUDINAL SECTIONS


GENERAL NOTES

CONCRETE CULVERT PIPE SHALL BE TIED TOGETHER IN THE MANNER ILLUSTRATED BY THIS DETAIL AT LOCATIONS DESIGNATED ON THE PLAN. THE CONTRACTOR MAY USE EITHER ALTERNATE 1, 2 OR 3 FOR DRAINAGE STRUCTURES, ONLY ALTERNATE 1 AND 3 MAY BE USED FOR CATTLE PASSES, UNLESS OTHERWISE STATED IN THE CONTRACT THE MATERIALS, FABRICATION AND WORK NECESSARY TO THE CULVERT PIPE AS INDICATED ON THE PLANS AND BY THIS DETAIL WILL BE CONSIDERED INCIDENTAL TO CULVERT PIPE, REINFORCED CONCRETE CULVERT PIPE, OR REINFORCED CONCRETE PIPE CATTLE PASS.


DETAILED DRAWINGS FOR PROPOSED ALTERNATE DESIGNS FOR JOINT TIES SHALL BE SUBMITTED TO THE ENGINEER FOR APPROVAL.

- ① CENTERLINE OF TONGUE AND GROOVE OR BELL AND SPIGOT JOINTS.
- ② THE INSIDE OF THE THREADED INSERTS SHALL BE CLEAN TO ALLOW THE INSERTION OF THREADED EYE BOLTS.
- ③ HOLES SHALL BE CAST-IN-PLACE OR DRILLED.
- ④ BOLT PROJECTION INSIDE OF PIPE SHALL NOT EXCEED 50 mm.
- ⑤ ROD DIAMETER + 25 mm.
- ⑥ LENGTH ADEQUATE TO EXTEND TO WITHIN 13 mm OF THE INNER SURFACE OF THE PIPE.

EYE BOLT AND TIE ROD ASSEMBLY (ALTERNATE NO. 1)

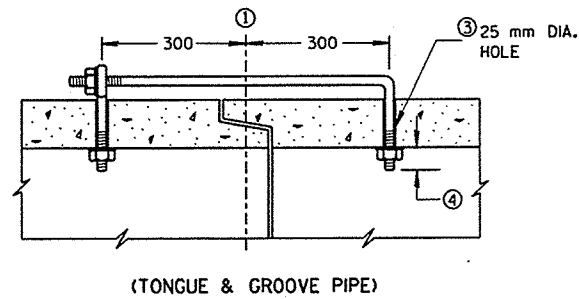

(TONGUE & GROOVE PIPE)

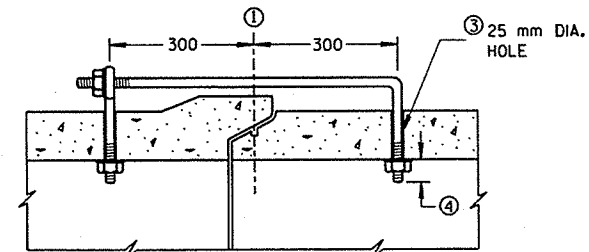


(MODIFIED BELL PIPE)
LONGITUDINAL SECTION

EYE BOLT DIMENSION TABLE

PIPE SIZE	L = LENGTH	
	TONGUE & GROOVE PIPE	MODIFIED BELL PIPE
400-600	115	160
750	130	180
900	140	180
1000	150	
1200	165	
1500	190	
1650	200	


ADJUSTABLE TIE ROD TABLE

PIPE DIAMETER	TIE ROD DIAMETER	D	L ₁	N
300-1500	16	16	125	13
1650-2100	19	19	125	13
2250-2700	25	25	180	36

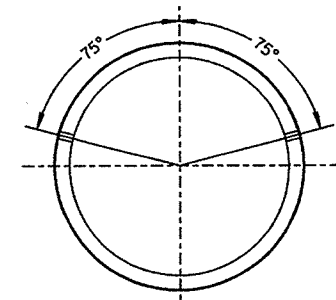

PLACEMENT OF (2) CAST-IN-PLACE INSERTS OR HOLES DURING FABRICATION FOR PIPE SECTIONS REQUIRING TIE RODS

TRANSVERSE SECTION

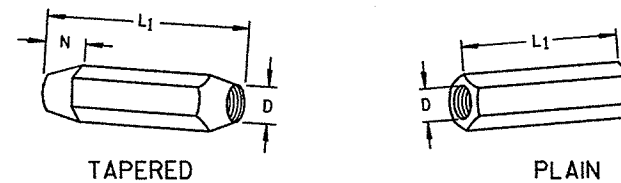

TAPERED


PLAIN

RIGHT AND LEFT THREADS

SLEEVE NUTS


NOTE

ALL DIMENSIONS IN THIS DRAWING ARE IN MILLIMETERS.

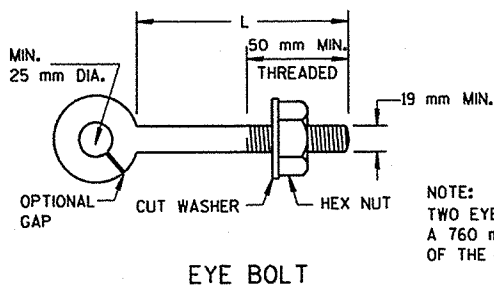

EYE BOLT


NOTE:
TWO EYE BOLTS MAY BE USED WITH A 760 mm LONG THREADED ROD IN LIEU OF THE 90° BENT TIE ROD.

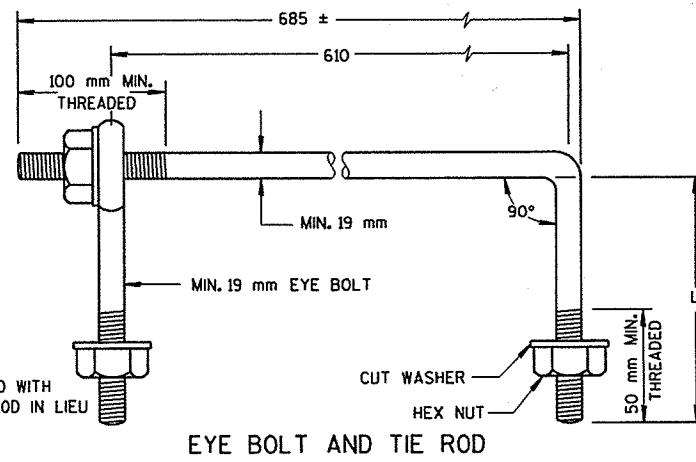

EYE BOLT AND TIE ROD

(JOINT TIES FOR 450 mm TO 1650 mm DIA. CONCRETE PIPE)

EYE BOLT AND TIE ROD ASSEMBLY (ALTERNATE NO. 2)

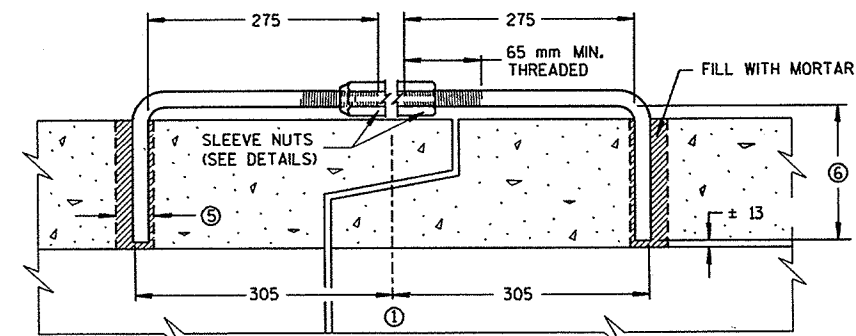

LONGITUDINAL SECTION

(JOINT TIES FOR 300 mm TO 2700 mm DIA. CONCRETE PIPE)

ADJUSTABLE TIE ROD (ALTERNATE NO. 3)

JOINT TIES FOR CONCRETE PIPE

STATE OF WISCONSIN
DEPARTMENT OF TRANSPORTATION

APPROVED
DATE 01/27/95
DATE
Rory L. Thompson
CHIEF ROADWAY DEVELOPMENT ENGINEER

FHWA



FILE NAME:


PLOT SCALE:

PLOT NAME:

REV. DATE:

ORIGINATOR:

S.D.D. 8 F 10-1
LEVELS ON - 2,3,4,5,6,7,8, 9,10,11,12,13,14,15,16,17,18,19,20,21,22,23,24,25,26,27,28,29,30,31,32,33,34,35,36,37,38,39,40,41,42,43,44,45,46,47,48,49,50,51,52,53,54,55,56,57,58,59,60,61,62,63

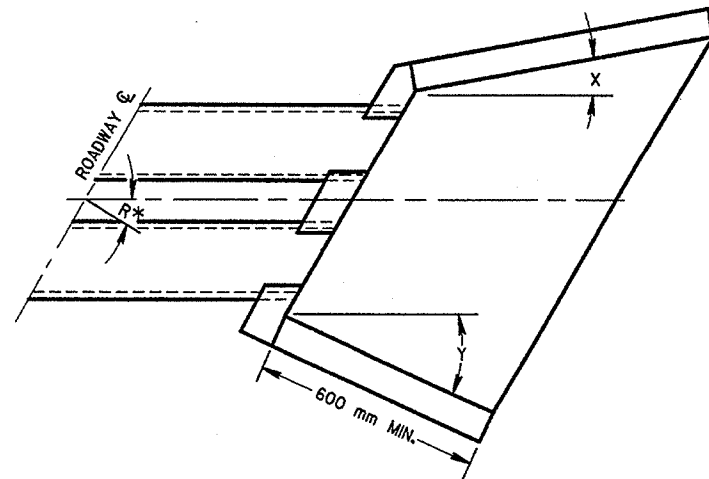

WINGWALL ANGLE DETAILS

INLET			OUTLET		
R*	X	Y	R*	X	Y
0 - 7°	30°	30°	0 - 15°	15°	15°
8 - 22°	25°	"	16 - 45°	10°	"
23 - 37°	20°	"	46 - 75°	5°	"
38 - 52°	15°	"	OVER 75°	0°	"
53 - 67°	10°	"			
68 - 82°	5°	"			
OVER 82°	0°	"			

*R = NUMBER OF DEGREES RIGHT OR LEFT HAND FORWARD

GENERAL NOTES

DETAILS OF CONSTRUCTION, MATERIALS AND WORKMANSHIP NOT SHOWN ON THIS DRAWING SHALL CONFORM TO THE PERTINENT REQUIREMENTS OF THE STANDARD SPECIFICATIONS AND THE APPLICABLE SPECIAL PROVISIONS.


FILL SLOPES FLATTER THAN 1:2.5 SHALL BE WARPED TO MEET THE TOP OF THE WINGWALLS.

ALL STEEL REINFORCEMENT AND WELDED STEEL WIRE FABRIC SHALL BE EMBEDDED 50 mm CLEAR UNLESS OTHERWISE NOTED.


1 MINIMUM REINFORCEMENT SHALL BE 6 X 6 - W4.0 X W4.0 (OR METRIC EQUIVALENT) OR 5M BARS SPACED 300 mm C-C IN BOTH DIRECTIONS.

2 THE SPACE BETWEEN PIPES SHALL BE AS FOLLOWS:


DIAMETER OR SPAN	SPACE
UP TO AND INCLUDING 1220 mm	600 mm
OVER 1220 mm TO 1830 mm	1/2 DIA. OR SPAN
OVER 1830 mm	915 mm

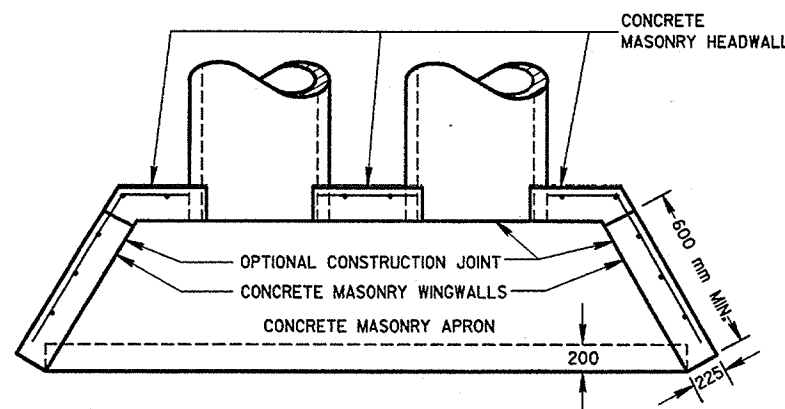


PLAN VIEW
CULVERT PIPE AND PIPE ARCH

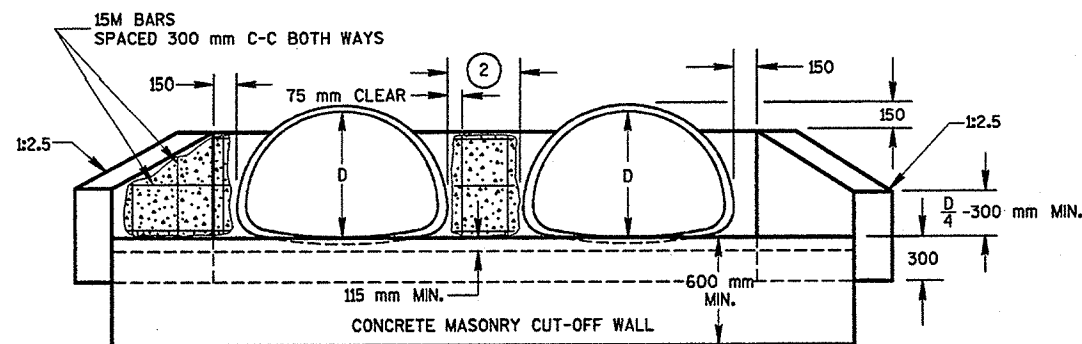

END ELEVATION
PIPE ARCH

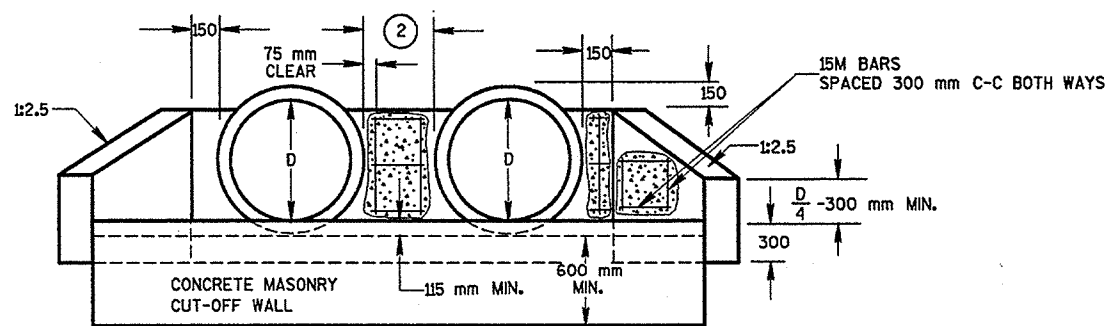

END ELEVATION
CULVERT PIPE

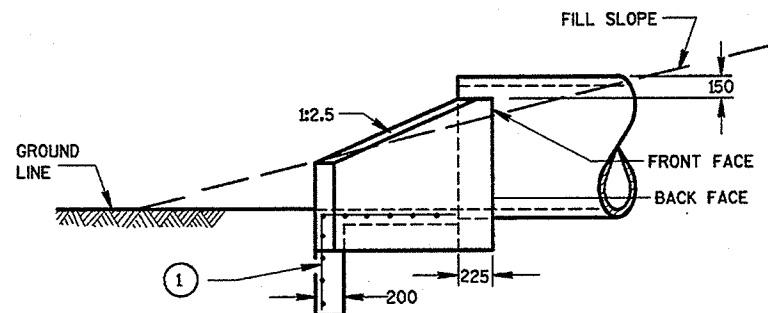

SIDE ELEVATION
CULVERT PIPE AND PIPE ARCH


NOTE

ALL DIMENSIONS ARE IN MILLIMETERS UNLESS OTHERWISE SPECIFIED


CONCRETE MASONRY ENDWALLS FOR
CULVERT PIPE AND PIPE ARCH

STATE OF WISCONSIN
DEPARTMENT OF TRANSPORTATION

APPROVED
9/14/98
DATE
FRWA
[Signature]
CHIEF ROADWAY DEVELOPMENT ENGINEER

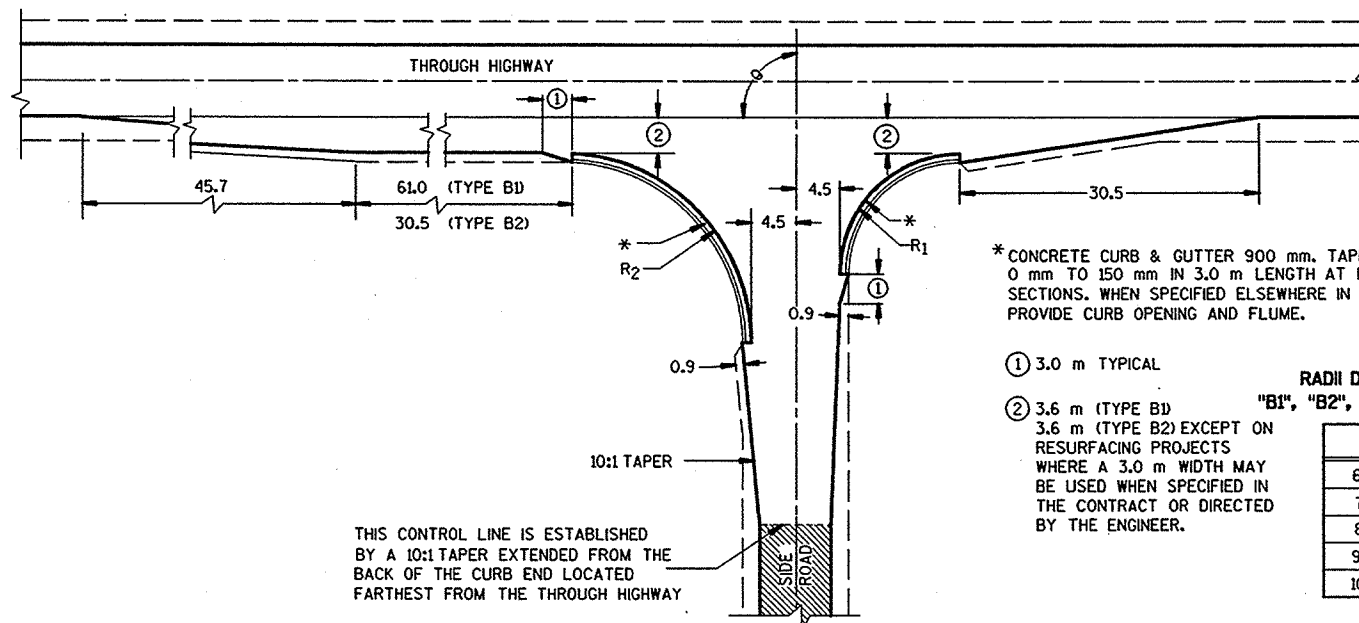

TYPE "B1" AND "B2"

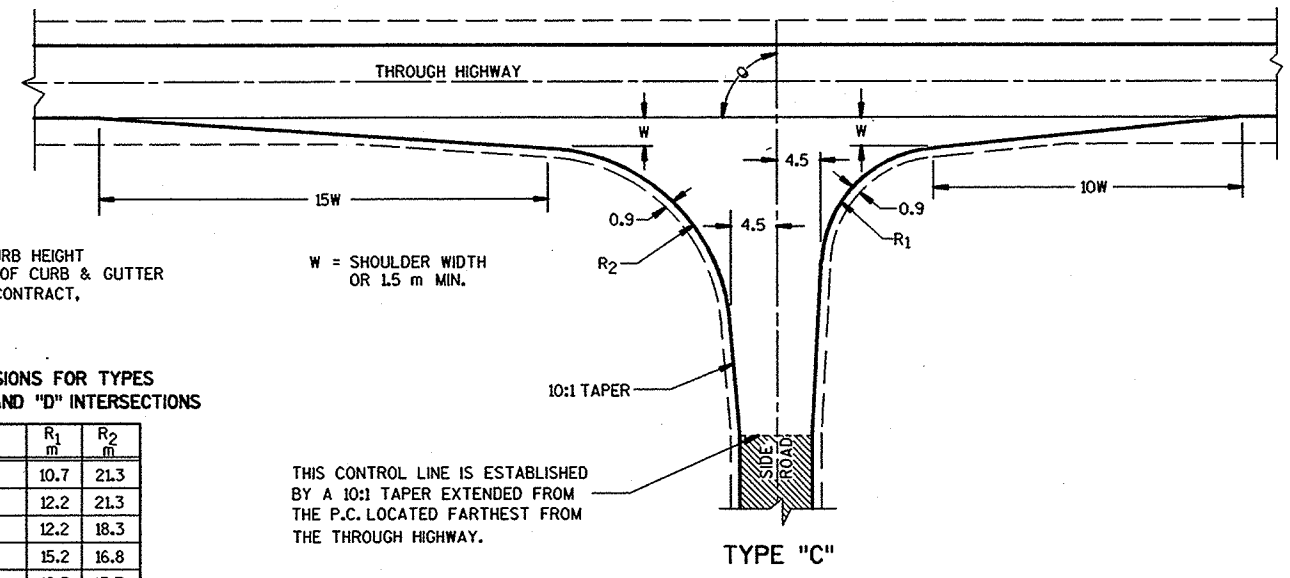

TYPE "C"

* CONCRETE CURB & GUTTER 900 mm. TAPER CURB HEIGHT 0 mm TO 150 mm IN 3.0 m LENGTH AT ENDS OF CURB & GUTTER SECTIONS. WHEN SPECIFIED ELSEWHERE IN THE CONTRACT, PROVIDE CURB OPENING AND FLUME.

- ① 3.0 m TYPICAL
- ② 3.6 m (TYPE B1)
3.6 m (TYPE B2) EXCEPT ON RESURFACING PROJECTS WHERE A 3.0 m WIDTH MAY BE USED WHEN SPECIFIED IN THE CONTRACT OR DIRECTED BY THE ENGINEER.

RADI DIMENSIONS FOR TYPES "B1", "B2", "C" AND "D" INTERSECTIONS

θ	R ₁ m	R ₂ m
65-70	10.7	21.3
71-80	12.2	21.3
81-90	12.2	18.3
91-100	15.2	16.8
101-110	18.3	13.7

THIS CONTROL LINE IS ESTABLISHED BY A 10:1 TAPER EXTENDED FROM THE P.C. LOCATED FARTHEST FROM THE THROUGH HIGHWAY.

GENERAL NOTES

DESIGNS MAY BE USED INTERCHANGEABLY IN COMBINATION OR SEPARATELY FOR ANY ONE COMPLETE INTERSECTION DEPENDING UPON INTERSECTION ANGLE AND SURFACING OF EACH APPROACH ROADWAY.


SIDE ROAD SURFACING NOTE

WHEN THE SIDE ROAD IS NOT PRESENTLY PAVED, PAVEMENT SHALL BE PLACED TO THE LIMITS SHOWN UNLESS OTHERWISE PROVIDED IN THE CONTRACT. WHERE THE CONSTRUCTION LIMITS ARE BEYOND THE PAVING LIMITS, CRUSHED AGGREGATE SURFACING SHALL BE PLACED BETWEEN THE PAVING LIMITS AND CONSTRUCTION LIMITS.


WHEN THE SIDE ROAD IS PRESENTLY PAVED, NEW PAVEMENT SHALL BE PLACED TO THE LIMITS OF DESIGN AS SHOWN AND BEYOND, IF NECESSARY, TO MEET EXISTING PAVEMENT.

WHEN THE SIDE ROAD IS THE CONSTRUCTION PROJECT, THE INTERSECTION SURFACING SHALL BE THE SAME AS FOR THE PROJECT.

EXISTING SURFACE

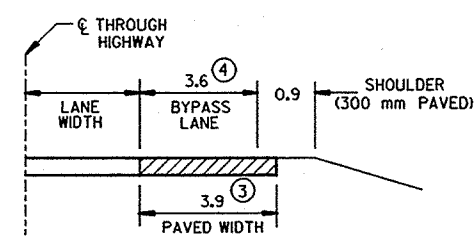


SECTION A-A
(SHOWING BYPASS LANE AND SHOULDER)

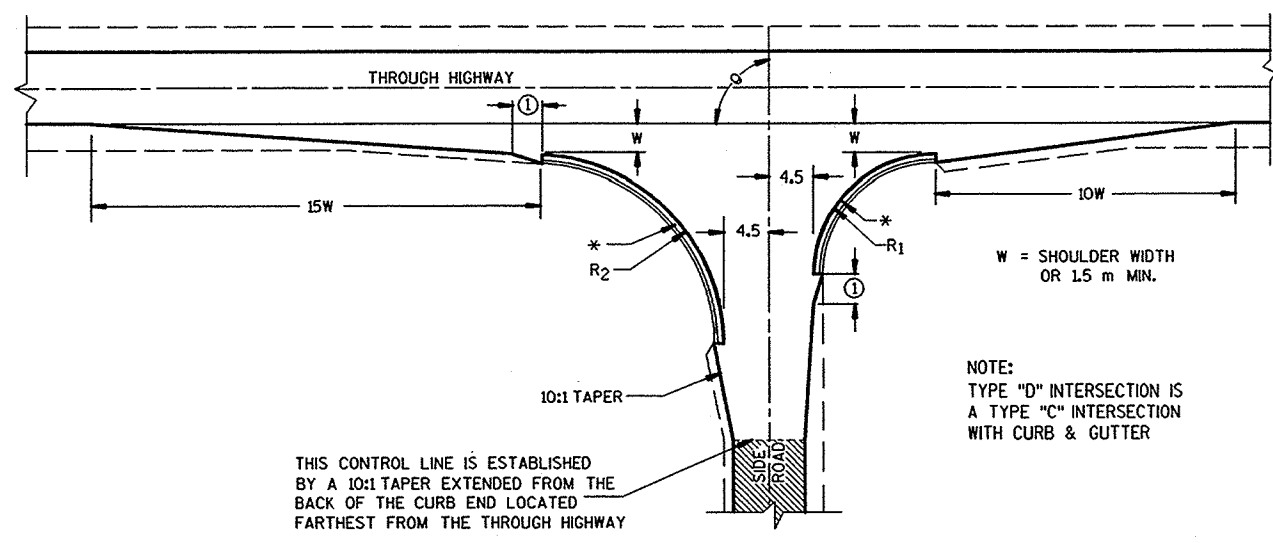

TYPE "D"

W = SHOULDER WIDTH OR 1.5 m MIN.

NOTE:
TYPE "D" INTERSECTION IS A TYPE "C" INTERSECTION WITH CURB & GUTTER

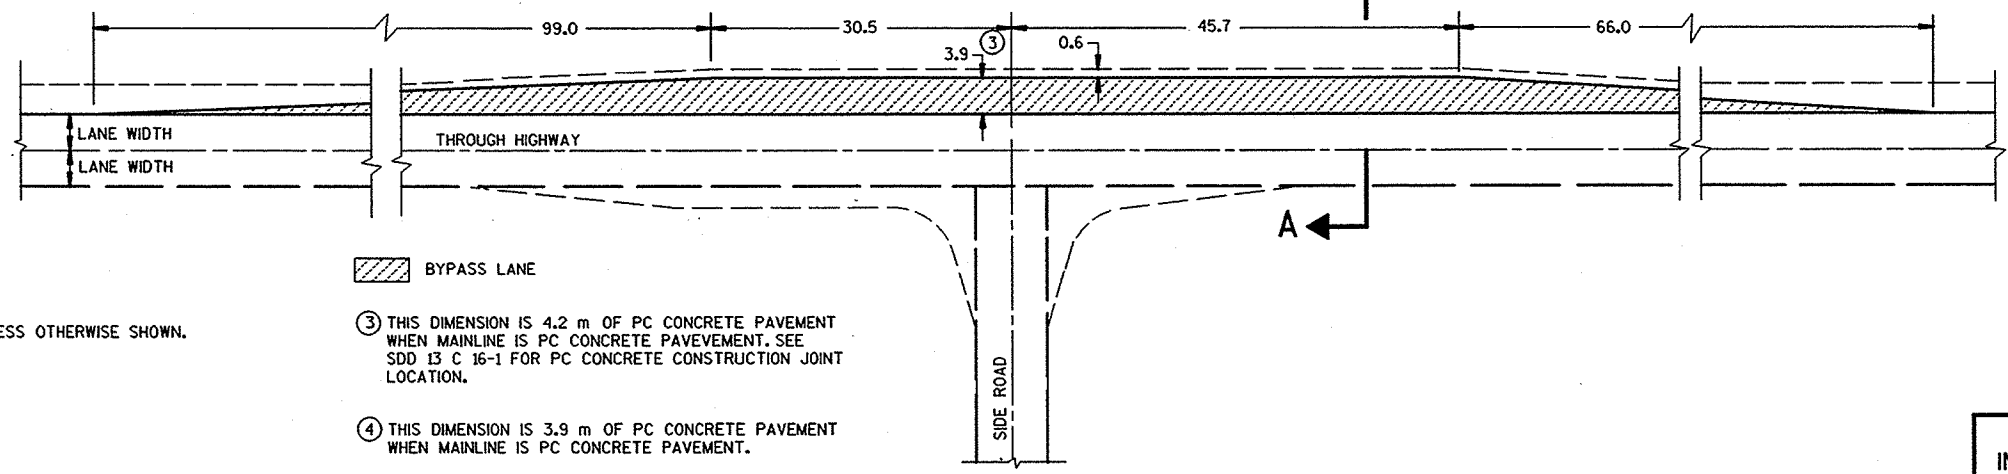


- BYPASS LANE
- ③ THIS DIMENSION IS 4.2 m OF PC CONCRETE PAVEMENT WHEN MAINLINE IS PC CONCRETE PAVEMENT. SEE SDD 13 C 16-1 FOR PC CONCRETE CONSTRUCTION JOINT LOCATION.
- ④ THIS DIMENSION IS 3.9 m OF PC CONCRETE PAVEMENT WHEN MAINLINE IS PC CONCRETE PAVEMENT.

TEE INTERSECTION BYPASS LANE DETAIL

NOTE:
ALL DIMENSIONS ARE IN METERS UNLESS OTHERWISE SHOWN.

AT-GRADE SIDE ROAD INTERSECTION, TYPES "B1", "B2", "C" AND "D" AND TEE INTERSECTION BYPASS LANE
STATE OF WISCONSIN DEPARTMENT OF TRANSPORTATION



S.D.D. 9 A 1-11a

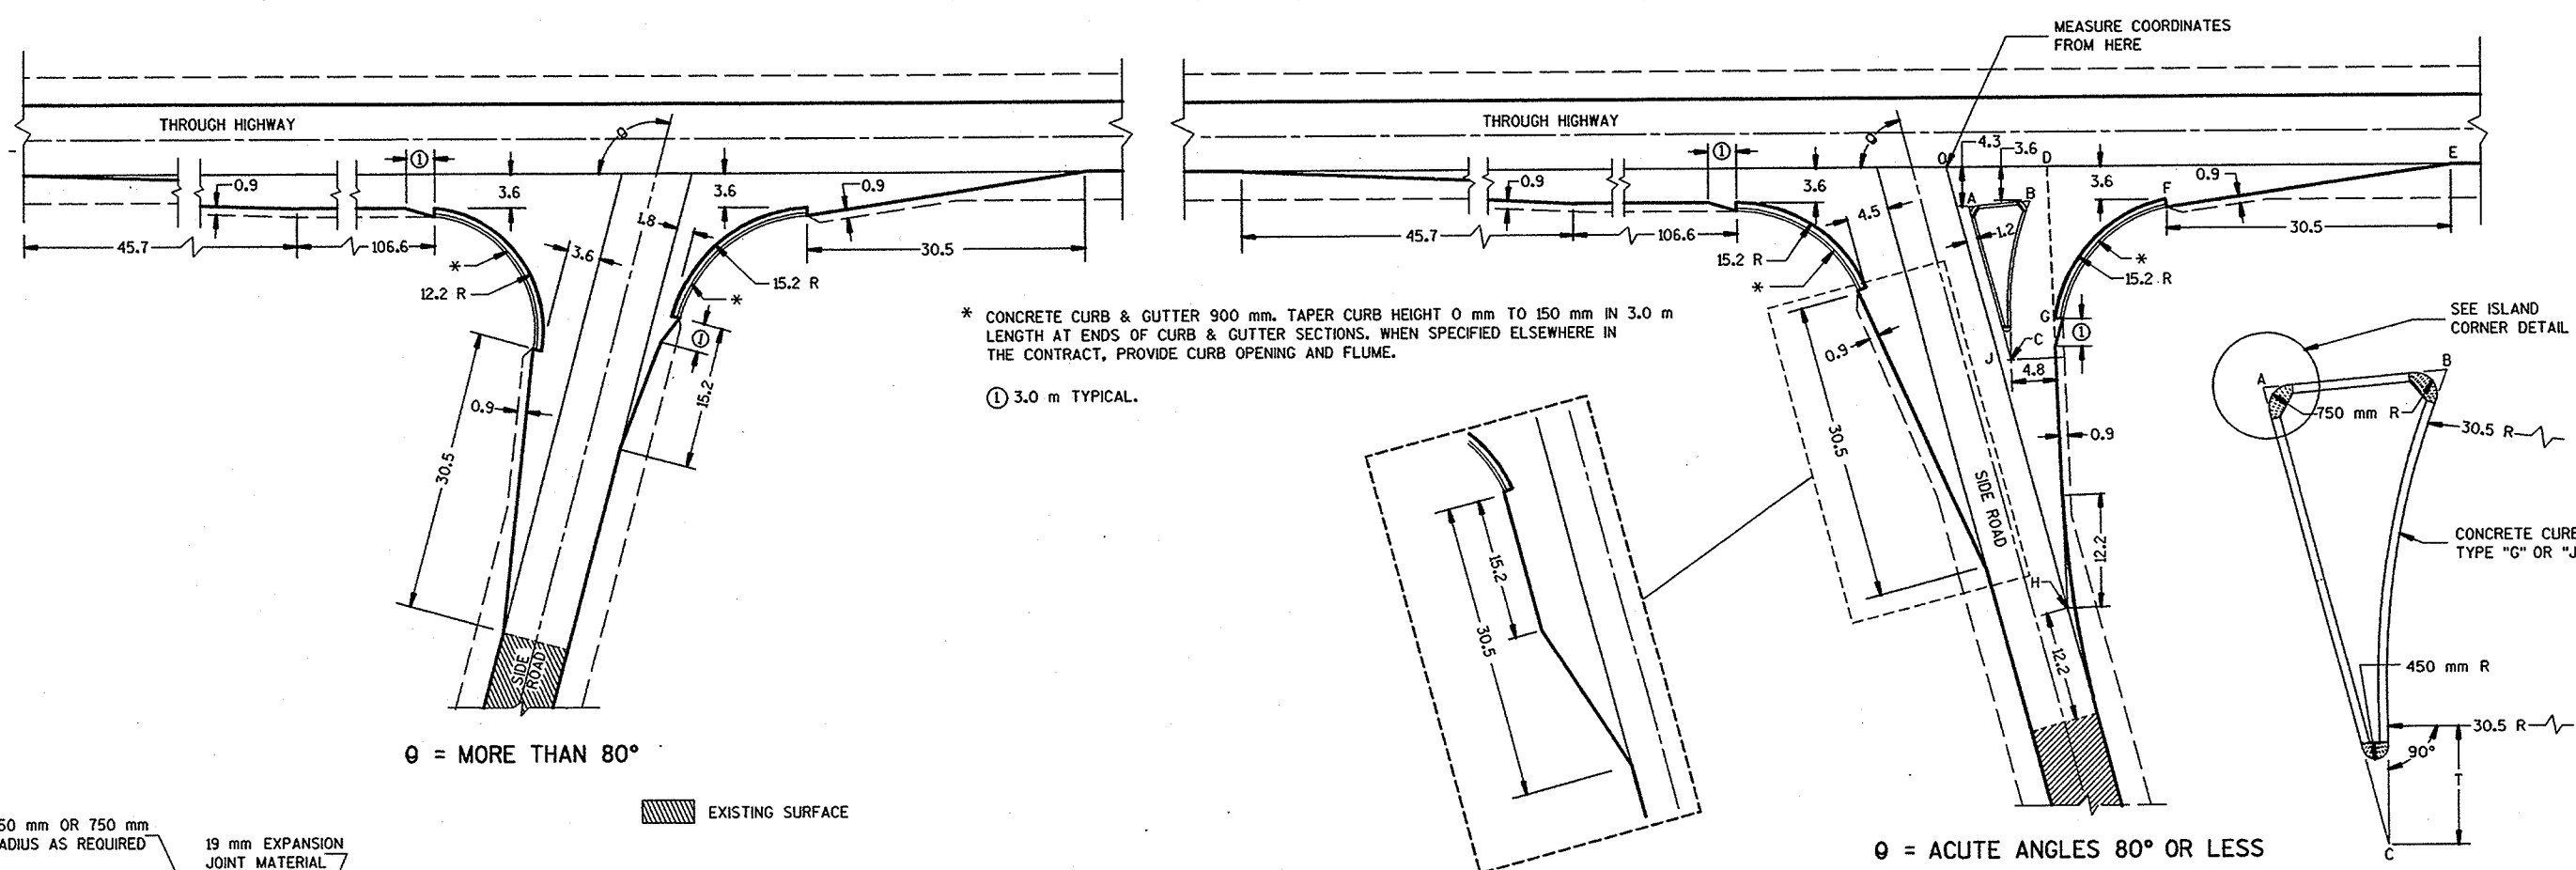

* CONCRETE CURB & GUTTER 900 mm. TAPER CURB HEIGHT 0 mm TO 150 mm IN 3.0 m LENGTH AT ENDS OF CURB & GUTTER SECTIONS. WHEN SPECIFIED ELSEWHERE IN THE CONTRACT, PROVIDE CURB OPENING AND FLUME.
 (1) 3.0 m TYPICAL.

SIDE ROAD WIDENING AND TAPER REQUIRED WHERE THE THROUGH HIGHWAY CARRIES TWO-WAY TRAFFIC
 theta = ACUTE ANGLES 70° OR LESS

NOTE:
 ALL DIMENSIONS ARE IN METERS UNLESS OTHERWISE SHOWN.

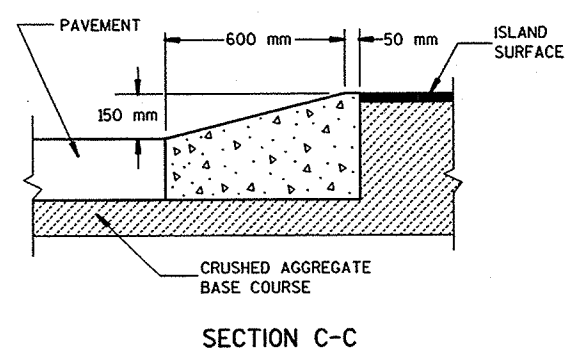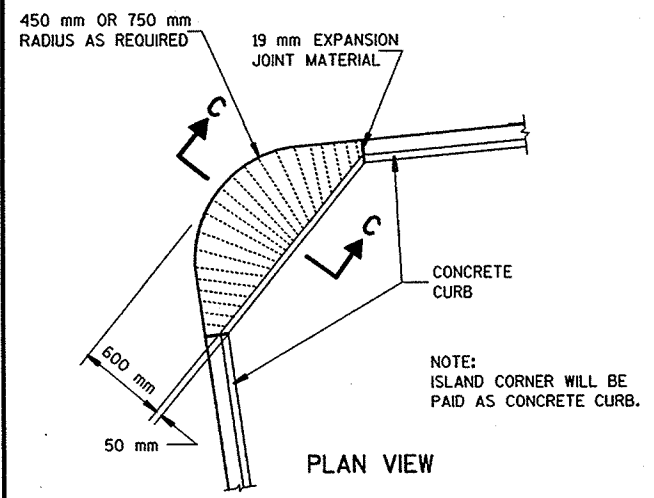

ISLAND CORNER DETAIL
 (TO BE CONSTRUCTED AT ALL ISLAND CORNERS)

TABLE OF DIMENSIONS FOR
 VARIABLE SIDE ROAD INTERSECTION ANGLES
 (INTERPOLATE VALUES FOR ANGLES NOT SHOWN)

ANGLE θ DEGREES	COORDINATES IN METERS (MEASURED FROM POINT "O")								LENGTH IN METERS				
	A	B	C	D	E	F	G	H	AB	AC	T	OJ	OH
60	3.87	13.52	14.13	12.59	61.85	31.72	19.40	25.90	9.68	20.52	1.80	26.18	51.79
	-4.30	-3.60	-22.07	0.0	0.0	-3.60	-22.96	-44.85					
65	3.33	11.74	11.51	11.84	59.15	29.02	16.39	21.50	8.44	19.36	2.90	24.66	50.87
	-4.30	-3.60	-21.84	0.0	0.0	-3.60	-21.75	-46.10					
70	2.84	10.19	9.06	11.22	56.76	26.62	13.79	17.11	7.38	18.19	3.78	23.20	50.02
	-4.30	-3.60	-21.39	0.0	0.0	-3.60	-20.52	-47.00					
75	2.39	8.82	6.79	10.72	54.60	24.47	11.53	12.73	6.46	16.99	4.46	21.76	49.19
	-4.30	-3.60	-20.71	0.0	0.0	-3.60	-19.28	-47.51					
80	1.98	7.61	4.72	10.32	52.67	22.54	9.60	8.41	5.68	15.81	5.02	20.39	48.43
	-4.30	-3.60	-19.87	0.0	0.0	-3.60	18.02	-47.69					

TYPE "A" SIDE ROAD INTERSECTION DETAILS

AT-GRADE SIDE ROAD INTERSECTION, TYPE "A"

STATE OF WISCONSIN
 DEPARTMENT OF TRANSPORTATION

APPROVED: *[Signature]*
 DATE: 4/23/98
 CHIEF ROADWAY DEVELOPMENT ENGINEER

FWA

S.D.D. 9 A 1-11b


PLOT SCALE:

PLOT NAME:

REV. DATE:


ORIGINATOR:

S.D.D. 9 B 2-6
LEVELS ON - 2, 3, 4, 62, 63

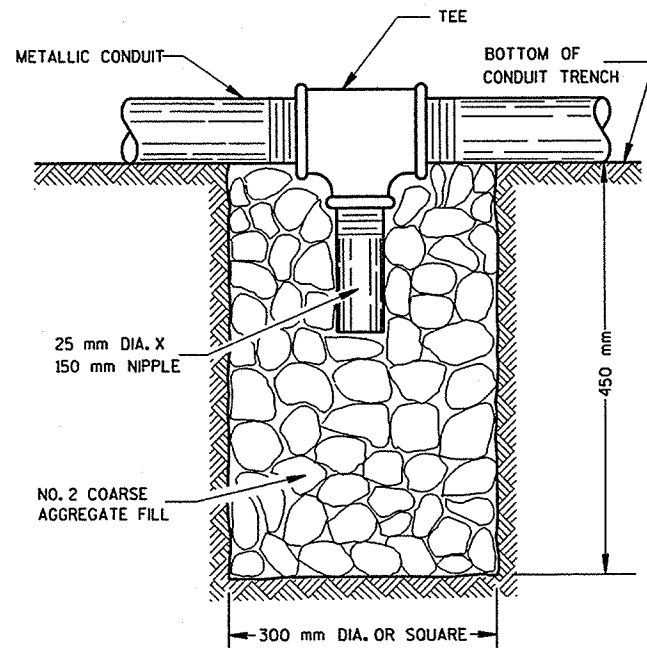

NOTE: INSTALL AT LOCATIONS WHERE METALLIC CONDUITS CANNOT BE PITCHED TO DRAIN INTO A PULL BOX.

DRAIN SUMP FOR METALLIC CONDUIT

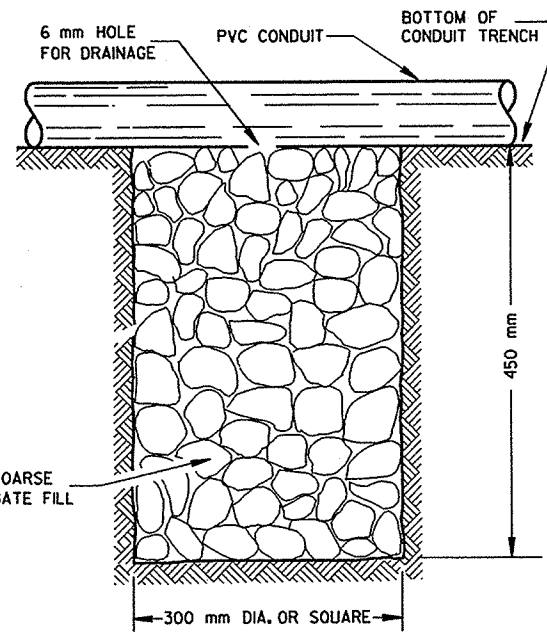

NOTE: INSTALL AT LOCATIONS WHERE PVC CONDUITS CANNOT BE PITCHED TO DRAIN INTO A PULL BOX.

DRAIN SUMP FOR PVC CONDUIT

GENERAL NOTES

DETAILS OF CONSTRUCTION, MATERIALS AND WORKMANSHIP NOT SHOWN ON THIS DRAWING SHALL CONFORM TO THE PERTINENT REQUIREMENTS OF THE CONTRACT.

METRIC MEASUREMENTS ARE BASED ON 25 mm (NOMINAL) PER INCH.

METALLIC (STANDARD SPECIFICATION 652.2.2) OR NONMETALLIC (STANDARD SPECIFICATION 652.2.3) CONDUIT SHALL BE FURNISHED AND PLACED AS SHOWN.

DEPTH OF CONDUIT INSTALLED BELOW THE TRAVELED WAY SHALL BE 600 mm MINIMUM AND 900 mm MAXIMUM.

DEPTH OF CONDUIT INSTALLED THAT IS NOT BELOW THE TRAVELED WAY SHALL BE 450 mm MIN. AND 900 mm MAXIMUM.

ANY EXCEPTION TO THE MAXIMUM DEPTH SHALL BE ONLY WITH THE WRITTEN APPROVAL OF THE ENGINEER.

THE TRENCH SHALL NOT BE BACKFILLED PRIOR TO INSPECTION OF THE CONDUIT.

ALL METALLIC CONDUIT RACEWAY ENDS SHALL BE REAMED AND THREADED.

ALL METALLIC CONDUIT IN WHICH WIRE OR CABLE IS TO BE INSTALLED SHALL BE BUSHED WITH APPROVED THREADED BUSHINGS BEFORE INSTALLATION OF THE WIRE OR CABLE.

ALL METALLIC CONDUITS IN WHICH WIRE OR CABLE IS NOT TO BE INSTALLED SHALL BE CAPPED WITH THREADED PROTECTIVE CAPS, AS APPROVED BY THE ENGINEER.

ALL NONMETALLIC CONDUIT SHALL BE CAPPED OR PLUGGED IMMEDIATELY AFTER INSTALLATION AND SHALL REMAIN CAPPED OR PLUGGED UNTIL WIRE/CABLES ARE INSTALLED.

NONMETALLIC CONDUITS IN WHICH WIRE OR CABLE IS NOT BEING INSTALLED SHALL REMAIN CAPPED OR PLUGGED.

BENDING OF PVC ELECTRICAL CONDUIT SHALL BE ACCOMPLISHED BY USING A BLANKET OR EMERSION TYPE TANK DESIGNED FOR THE PURPOSE OF BENDING PVC ELECTRICAL CONDUIT.

ALL CUT ENDS SHALL BE TRIMMED INSIDE AND OUTSIDE TO REMOVE ALL ROUGH EDGES ON NONMETALLIC CONDUIT. (SEE NEC 347.5)

WHEN REQUIRED TO CONNECT NONMETALLIC CONDUIT TO METALLIC CONDUIT, ONLY U.L. LISTED ADAPTER FITTINGS SHALL BE USED.


PRIOR TO CONDUIT ACCEPTANCE, CONDUIT CAPS OR PLUGS SHALL BE REMOVED, AND THE CAPS, PLUGS AND CONDUIT ENDS SHALL BE THOROUGHLY CLEANED AND THEN THE CAPS OR PLUGS REINSTALLED TO ENSURE THAT THE CAPS OR PLUGS CAN BE EASILY REMOVED IN THE FUTURE.

ALL CONDUIT BEING FURNISHED AND INSTALLED SHALL HAVE THE U.L. LABEL FIRMLY ATTACHED.

CONDUIT RUNS SHALL BE THE SAME SIZE PIPE FROM ONE END TO THE OTHER (FROM PULL BOX TO PULL BOX-OR-JUNCTION BOX TO JUNCTION BOX-OR-BASE TO BASE, ETC.).


POLY ROPE OR A PULL WIRE SHALL BE INSTALLED AS STATED IN THE STANDARD SPECIFICATION, ITEM 652.3.1.1.

ALL CONDUIT RUNS SHALL BE STRAIGHT (WITHOUT BENDS) FROM PULL BOX TO PULL BOX, PULL BOX TO BASE AND BASE TO BASE AS SHOWN ON THE PLANS UNLESS OTHERWISE APPROVED BY THE PROJECT ENGINEER.

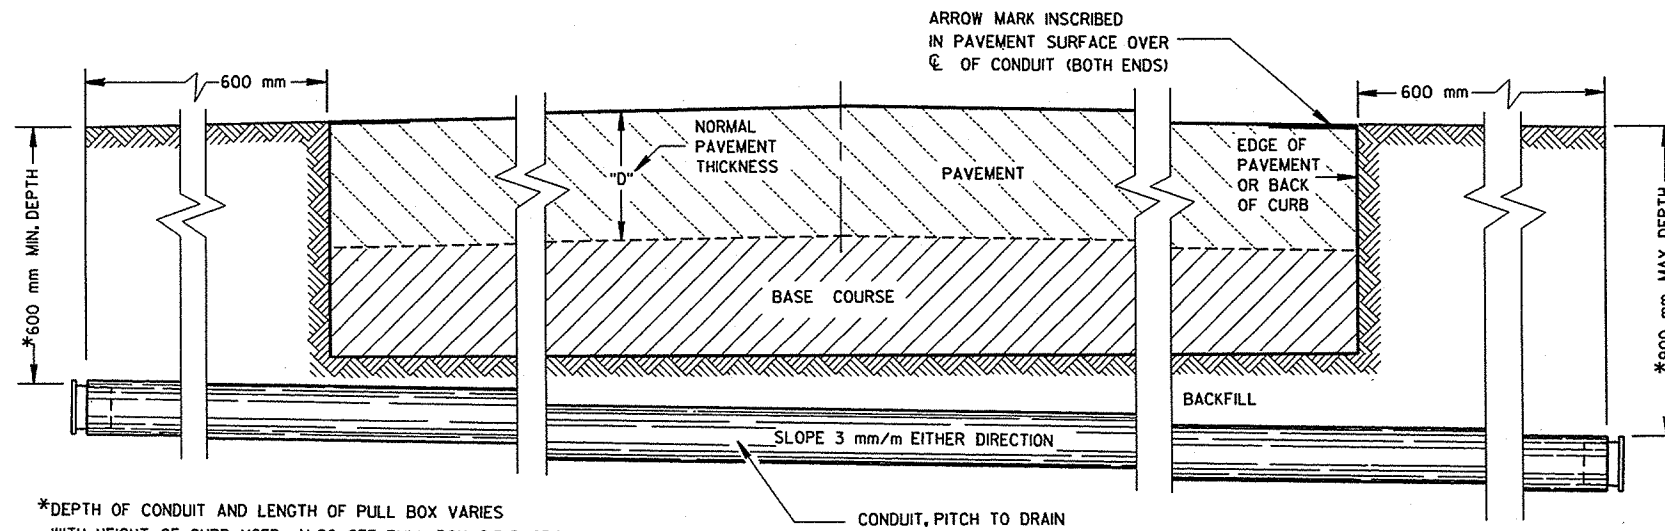

*DEPTH OF CONDUIT AND LENGTH OF PULL BOX VARIES WITH HEIGHT OF CURB USED. ALSO SEE PULL BOX S.D.D. 9B4

SIDE ELEVATION DETAIL FOR CONDUIT UNDER PAVED HIGHWAYS

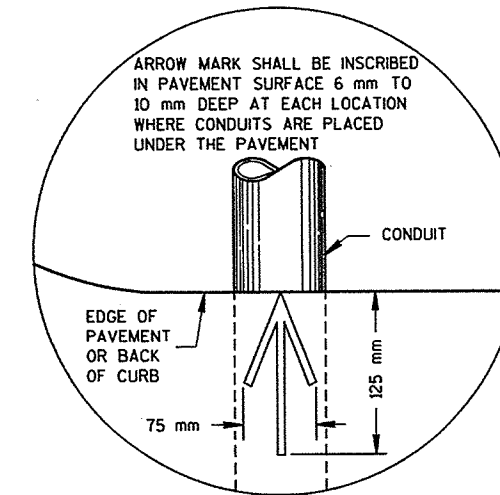

PLAN VIEW ARROW MARK


CONDUIT

STATE OF WISCONSIN
DEPARTMENT OF TRANSPORTATION

APPROVED
DATE 10/21/96
STATE ELECTRICAL ENGINEER FOR HIGHWAYS


FHWA

M

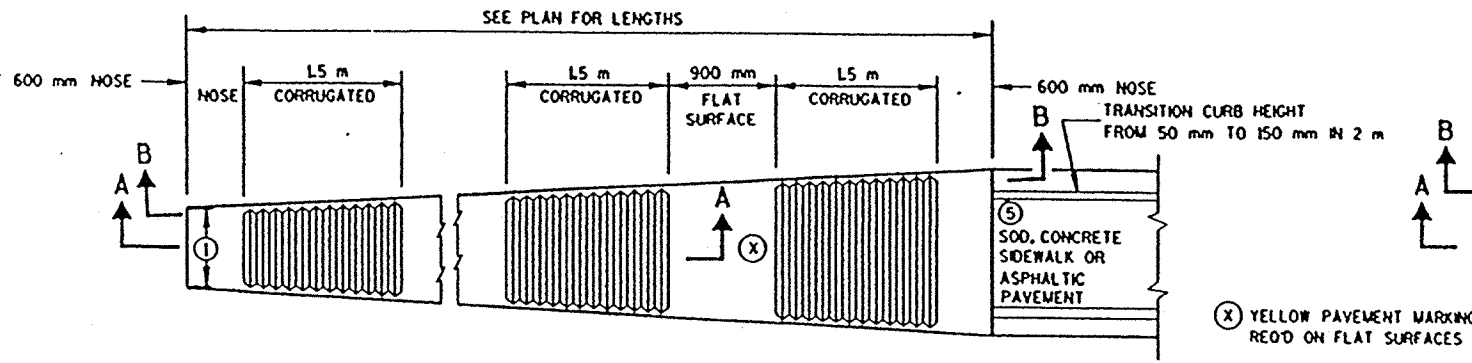


PLAN VIEW

VARIABLE WIDTH CONCRETE CORRUGATED MEDIAN

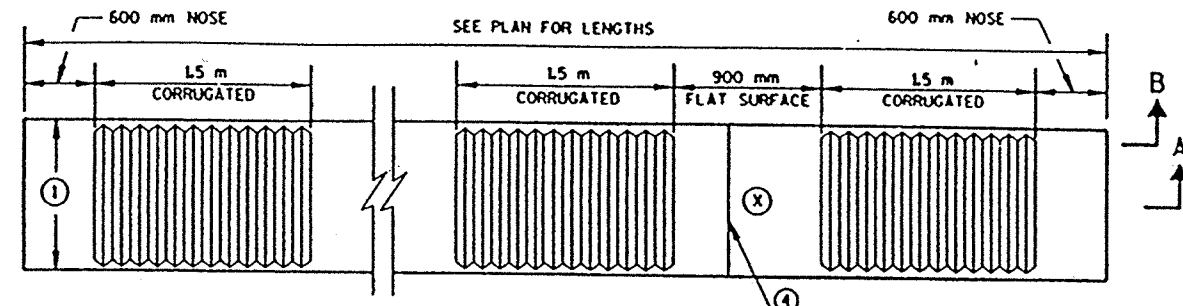


PLAN VIEW


UNIFORM WIDTH CONCRETE CORRUGATED MEDIAN

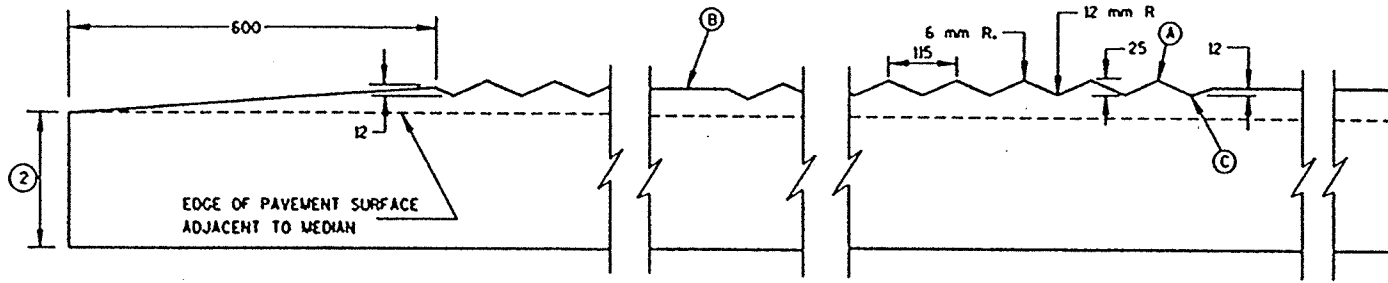

SECTION A-A
LONGITUDINAL SECTION

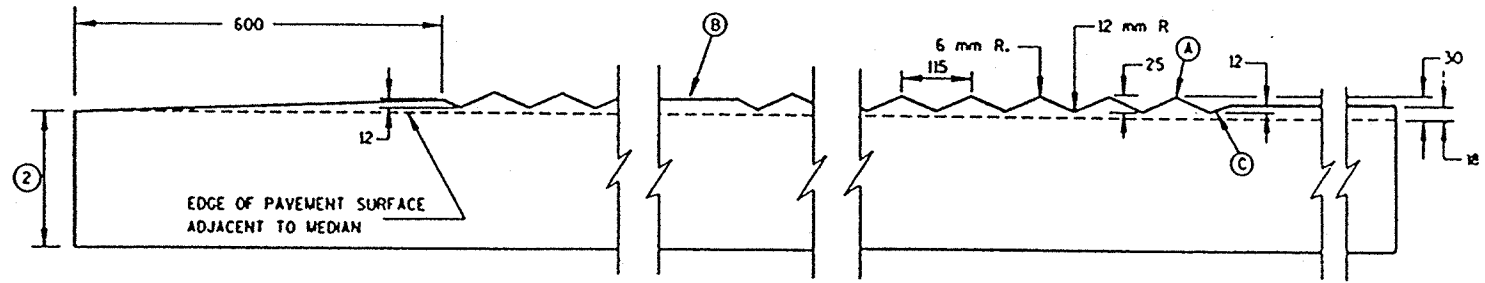

SECTION B-B
LONGITUDINAL SECTION

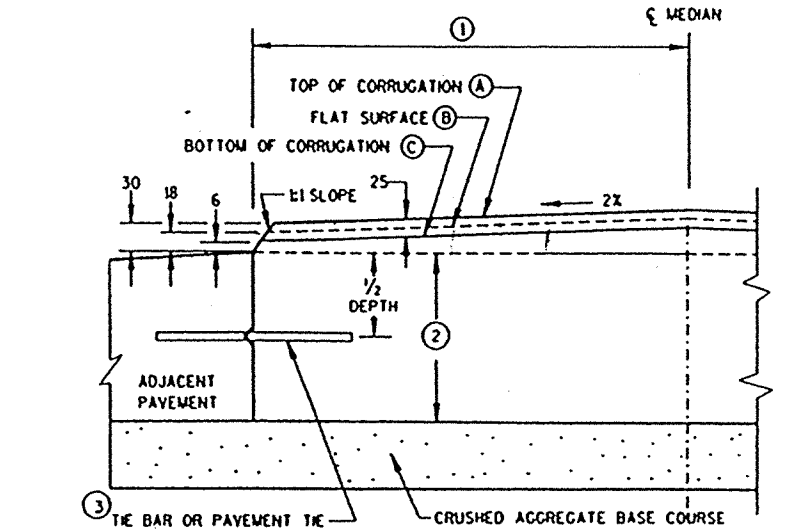

HALF CROSS SECTION
CONCRETE CORRUGATED MEDIAN AND ADJACENT PAVEMENT

GENERAL NOTES

DETAILS OF CONSTRUCTION, MATERIALS AND WORKMANSHIP NOT SHOWN ON THIS DRAWING SHALL CONFORM TO THE PERTINENT REQUIREMENTS OF THE STANDARD SPECIFICATIONS AND THE APPLICABLE SPECIAL PROVISIONS.

- ① SEE PLANS FOR CONSTANT OR VARIABLE WIDTH.
- ② THE DEPTH OF THE CONCRETE MEDIAN SHALL EQUAL THE DEPTH OF THE ADJACENT PAVEMENT STRUCTURE. ADJACENT PAVEMENT STRUCTURE DETAILS ARE SHOWN IN THE PLAN. TYPICAL OPTIONS ARE:
 - (1) NEW OR EXISTING CONCRETE PAVEMENT.
 - (2) ASPHALTIC CONCRETE OVER NEW OR EXISTING CONCRETE BASE COURSE.
 - (3) ASPHALTIC PAVEMENT OVER CRUSHED AGGREGATE BASE COURSE.
- ③ TIE BARS OR PAVEMENT TIES REQUIRED IN NEW CONCRETE PAVEMENT OR CONCRETE BASE COURSE. TIE BARS SHALL BE NO. 13 X 600 mm SPACED AT 600 mm C-C. PAVEMENT TIES REQUIRED IN EXISTING CONCRETE PAVEMENT OR CONCRETE BASE COURSE. PAVEMENT TIES SHALL BE NO. 19 X 300 mm SPACED AT 900 mm C-C INSTALLED ON A HORIZONTAL SKEW OF 6:1 THE DIRECTION OF SKEW SHALL ALTERNATE AFTER EVERY ONE OR TWO BARS.
- ④ CONCRETE PAVEMENT TRANSVERSE CONTRACTION JOINTS SHALL BE CONSTRUCTED TO MATCH THE JOINTS IN ADJACENT CONCRETE PAVEMENT. WHERE ADJACENT PAVEMENT IS ASPHALT WITH CRUSHED AGGREGATE BASE. TRANSVERSE CONTRACTION JOINTS SHALL BE PROVIDED AT 6 m INTERVALS.
- ⑤ SURFACE TYPE AND DETAILS ARE DEFINED ELSEWHERE IN THE PLAN.

NOTE:

ALL DIMENSIONS ARE IN MILLIMETERS UNLESS OTHERWISE SHOWN.

CONCRETE CORRUGATED MEDIAN

STATE OF WISCONSIN
DEPARTMENT OF TRANSPORTATION

APPROVED
DATE 07/30/88
Rory J. Thompson
CHIEF ROADWAY DEVELOPMENT ENGINEER


PLOT SCALE:

PLOT NAME:



REV. DATE:

ORIGINATOR:


S.D.D. 13 B 1-4
LEVELS ON - 2, 3, 4, 62, 63

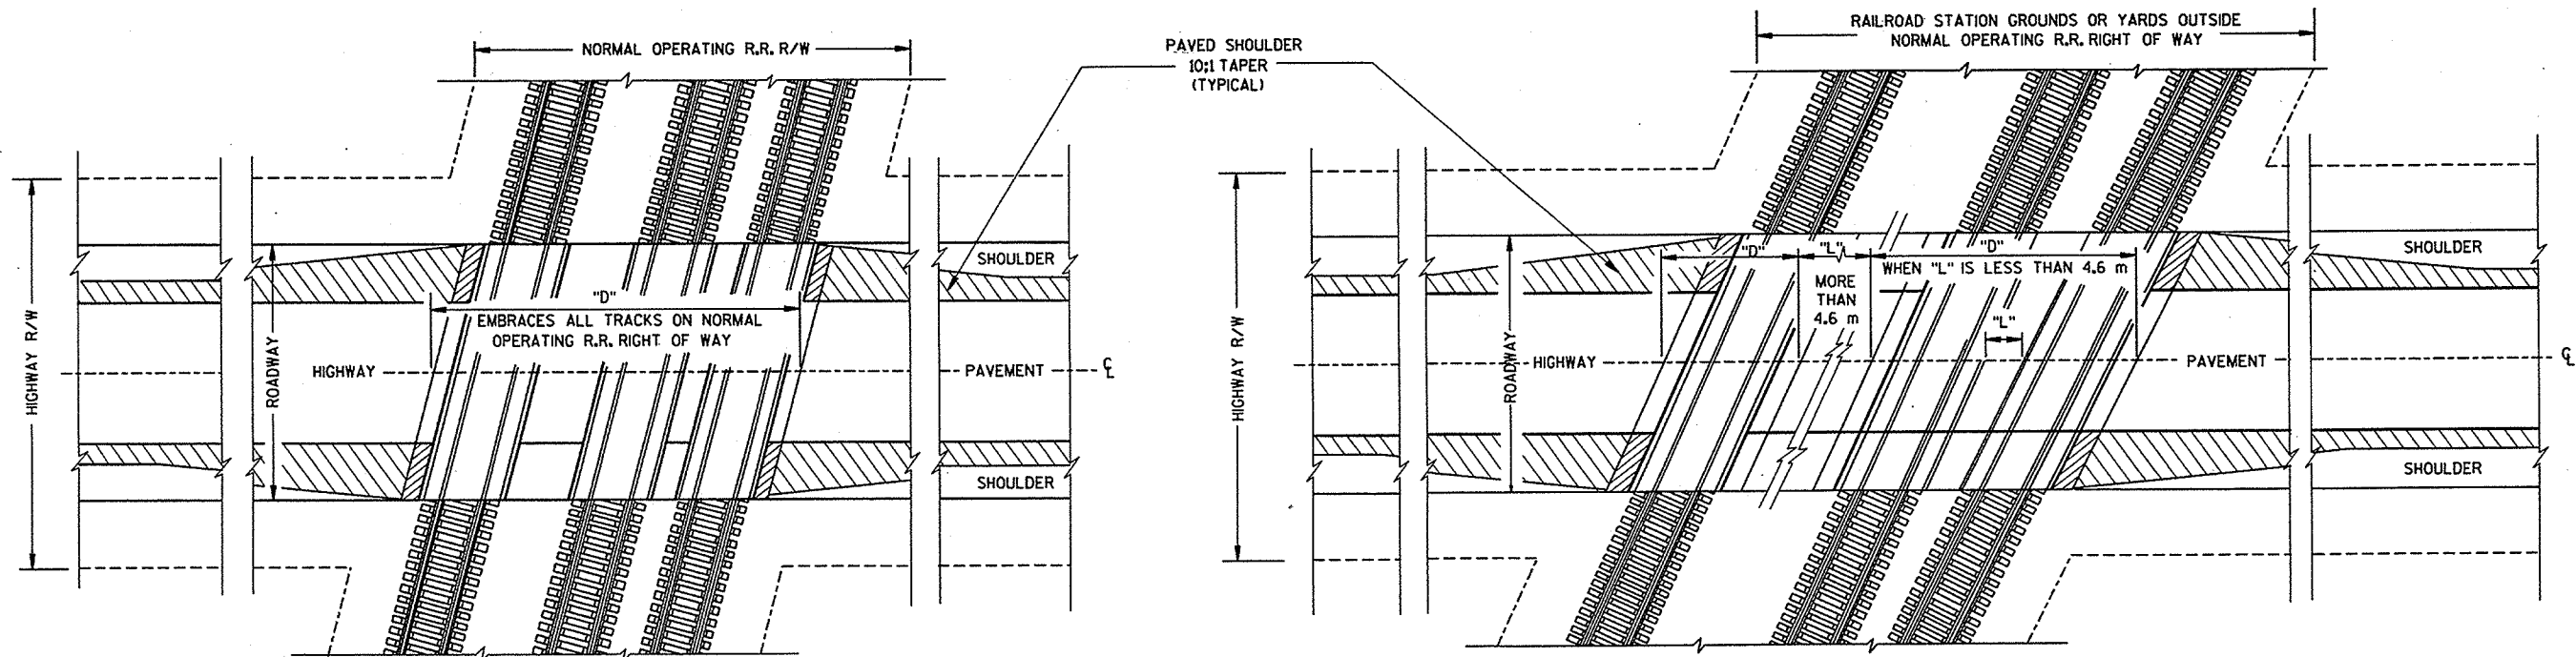

**TYPICAL TYPES OF RAILROAD GRADE CROSSING
SHOWING THE RAILROAD'S LIMIT OF RESPONSIBILITY
AND MEASUREMENT DETAILS**

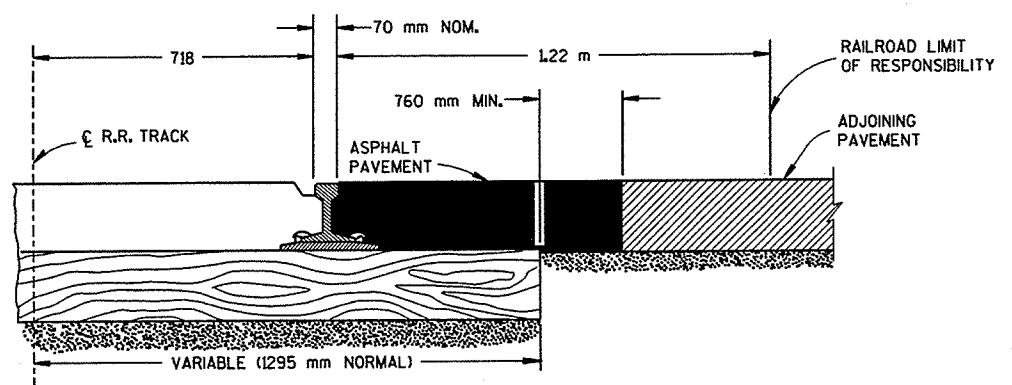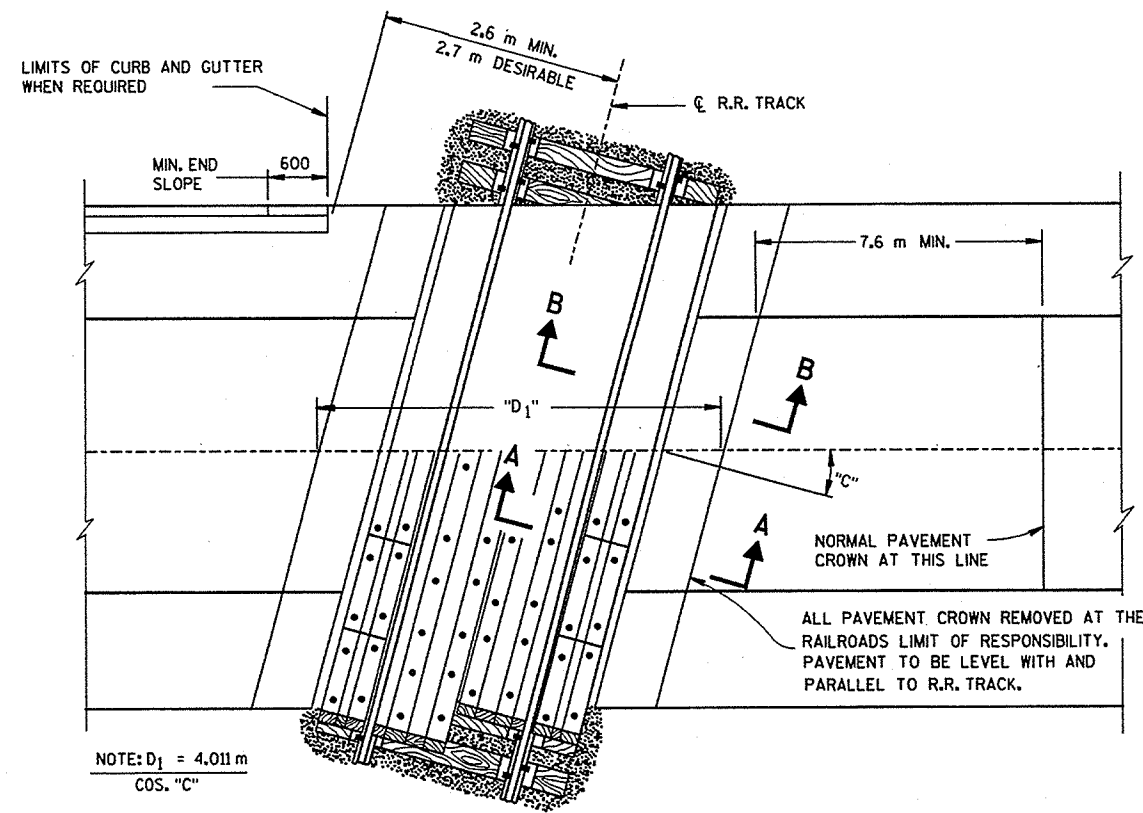

SECTION B-B

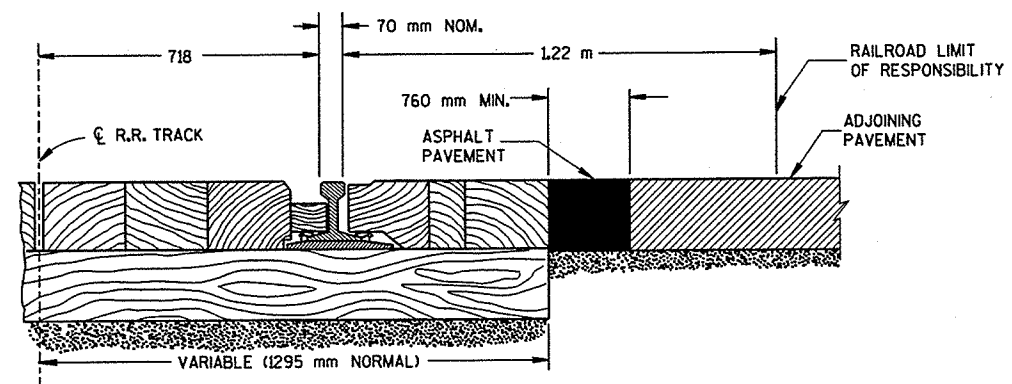

SECTION A-A

RAILROAD APPROACH CONSTRUCTION DETAILS

GENERAL NOTES

DETAILS OF CONSTRUCTION, MATERIALS AND WORKMANSHIP NOT SHOWN ON THIS DRAWING SHALL CONFORM TO THE PERTINENT REQUIREMENTS OF THE STANDARD SPECIFICATIONS AND THE APPLICABLE SPECIAL PROVISIONS.

"D" & "D₁" = EXCEPTION TO NET LENGTH OF ϕ . PAVING OR SURFACING AND SHOULDER MATERIAL WITHIN LIMITS DESIGNATED BY "D" OR "D₁" TO BE AT EXPENSE OF RAILROAD COMPANY. TRACKAGE TO INDUSTRIAL SITES TO BE TREATED SAME AS TRACKAGE TO R.R. STATION GROUNDS OR YARDS OUTSIDE OF NORMAL OPERATING R/W.

MODULAR CROSSINGS SHALL BE INSTALLED IN ACCORDANCE WITH THE MANUFACTURER'S SPECIFICATIONS.

NOTE


ALL DIMENSIONS ARE IN MILLIMETERS UNLESS OTHERWISE SHOWN.

PAVEMENT DETAILS
FOR RAILROAD APPROACH


STATE OF WISCONSIN
DEPARTMENT OF TRANSPORTATION

APPROVED
01/27/95
DATE
Roy J. Stinson
CHIEF ROADWAY DEVELOPMENT ENGINEER
FIRMA

FILE NAME:

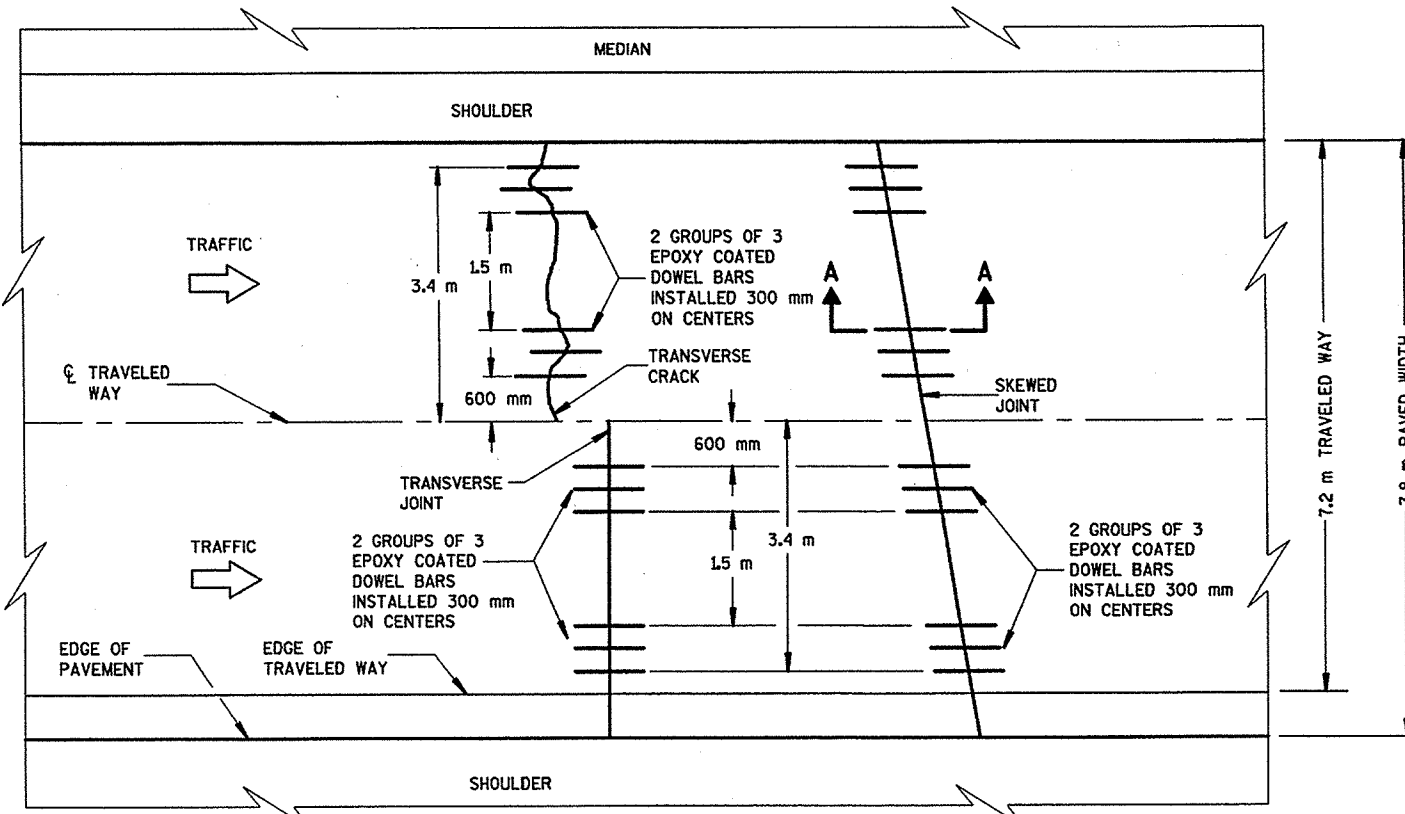

**RETROFIT DOWEL BAR SPACING
DIVIDED HIGHWAY**

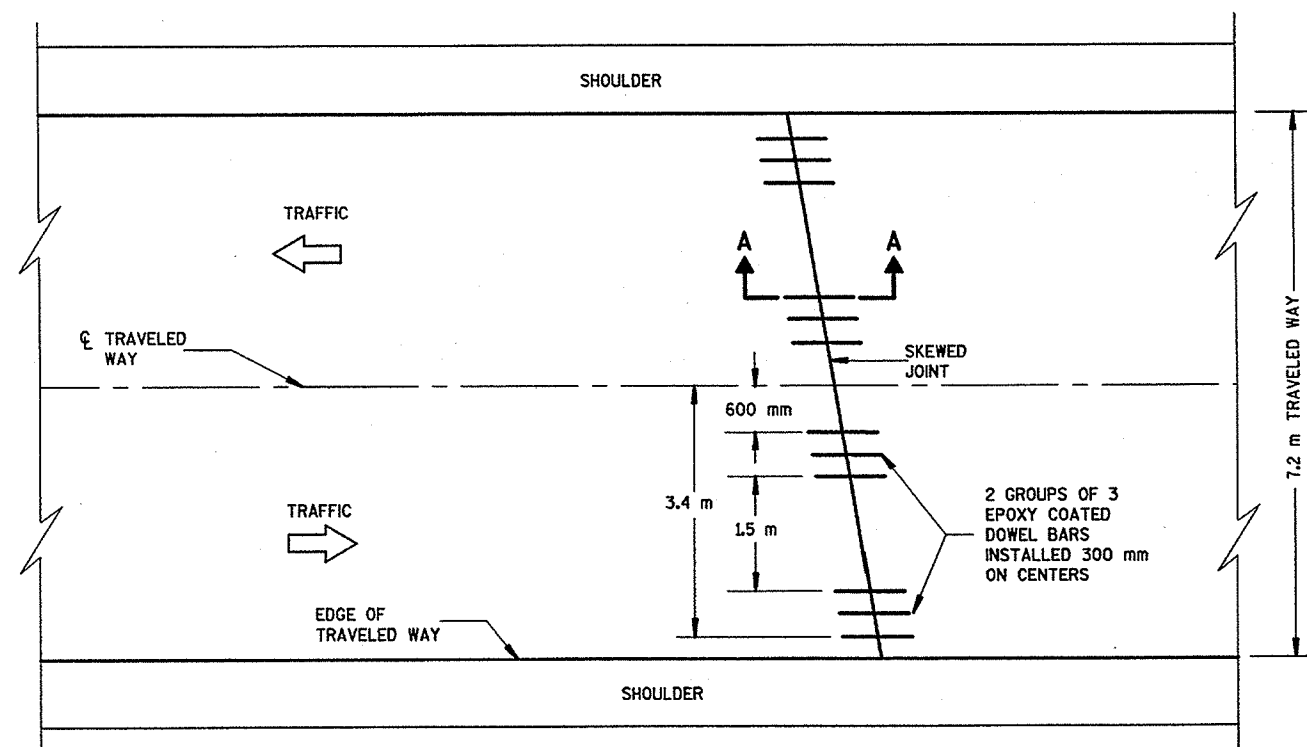


**RETROFIT DOWEL BAR SPACING
TWO-LANE TWO-WAY HIGHWAY**

RETROFIT DOWEL BAR INSTALLATION


GENERAL NOTES

DETAILS OF CONSTRUCTION, MATERIAL AND WORKMANSHIP NOT SHOWN ON THIS DRAWING SHALL CONFORM TO THE PERTINENT REQUIREMENTS OF THE STANDARD SPECIFICATIONS AND THE APPLICABLE SPECIAL PROVISION.

- ① FOAM CORE BOARD IS TO BE SIZED AND SHAPED TO FIT INTO THE JOINT OR CRACK, EXTEND TO OR BEYOND THE TOP SURFACE OF THE LOWER SLAB, AND FIT TIGHTLY AROUND THE DOWEL.
- ② FINISHED ELEVATION AFTER CONTINUOUS DIAMOND GRINDING, WHEN REQUIRED.

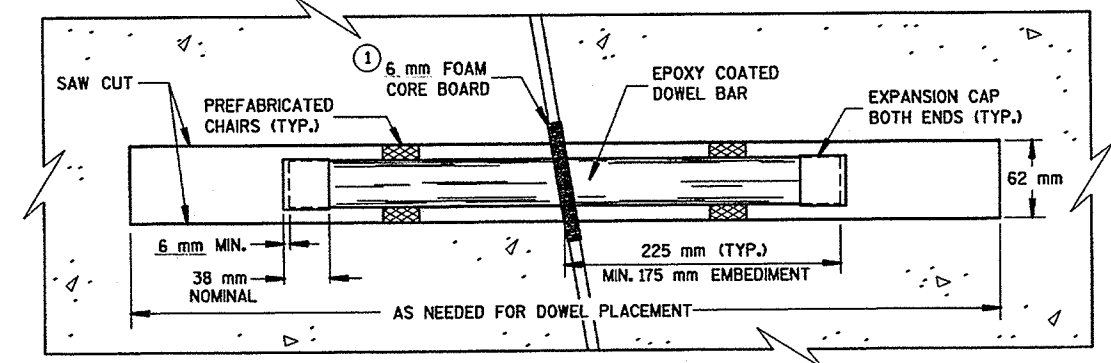


PLAN VIEW

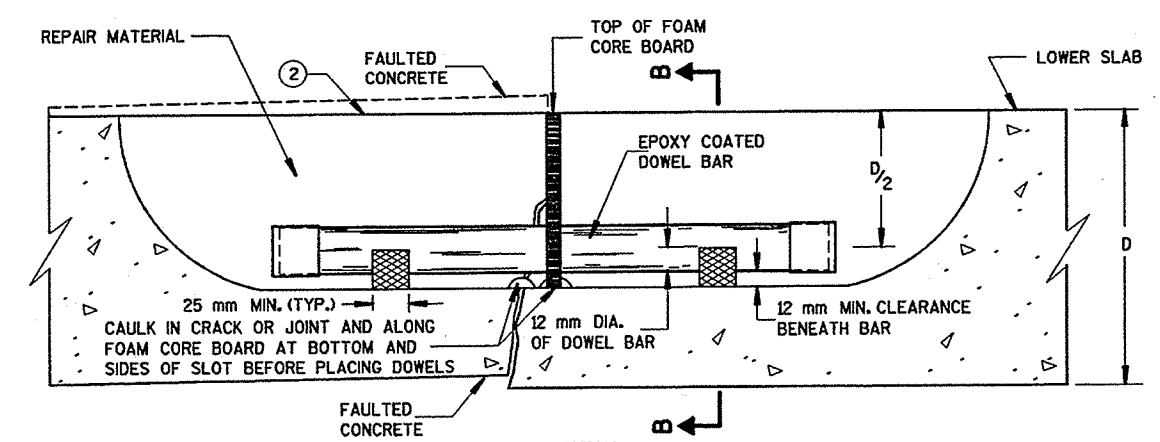


SIDE VIEW

SECTION A-A

DOWEL BAR INSTALLATION DETAIL

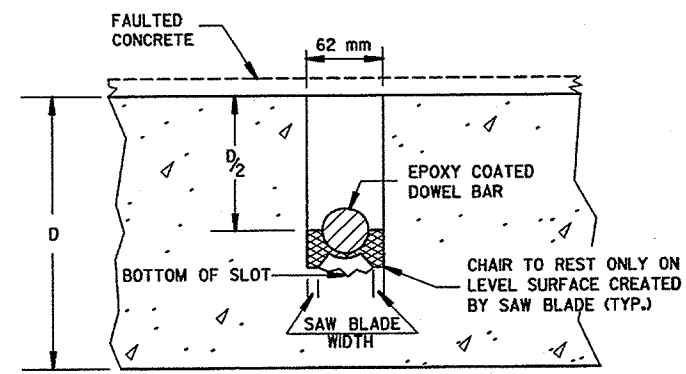

SECTION B-B

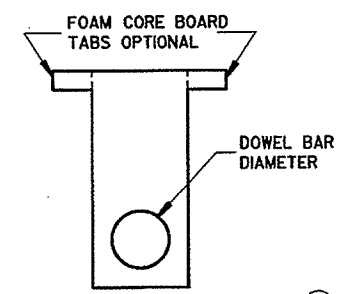

6 mm FOAM CORE BOARD ①

PAVEMENT DEPTH	DOWEL BAR SIZE
225 mm OR LESS	32 mm X 450 mm
MORE THAN 225 mm	38 mm X 450 mm

DOWEL BAR SIZE TABLE

RETROFIT DOWEL BARS

STATE OF WISCONSIN
DEPARTMENT OF TRANSPORTATION

APPROVED
10-1-98
DATE
CHIEF PAVEMENTS & RESEARCH ENGINEER
FHWA

S.D.D. 13 C 10-1






PLOT SCALE:

PLOT NAME:

REV. DATE:

ORIGINATOR:

S.D.D. 13 C 13-3
LEVELS ON - 2, 3, 4, 62, 63

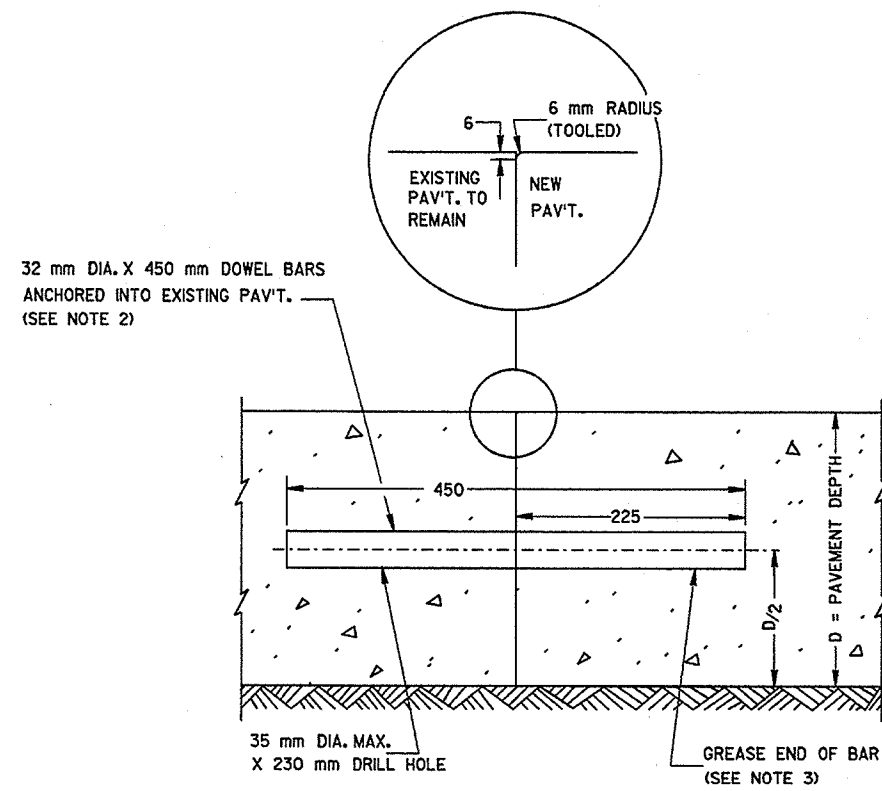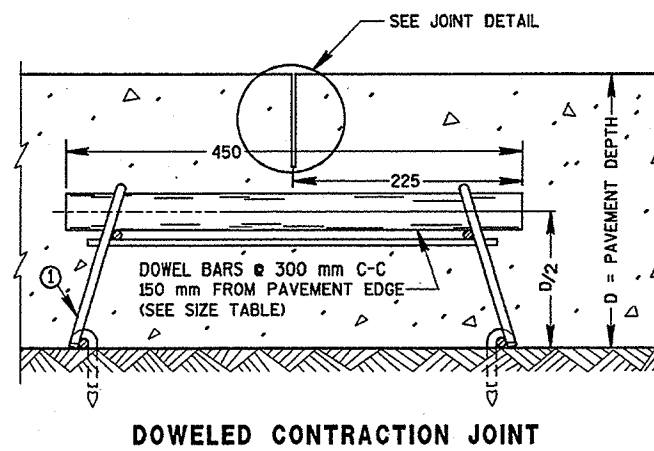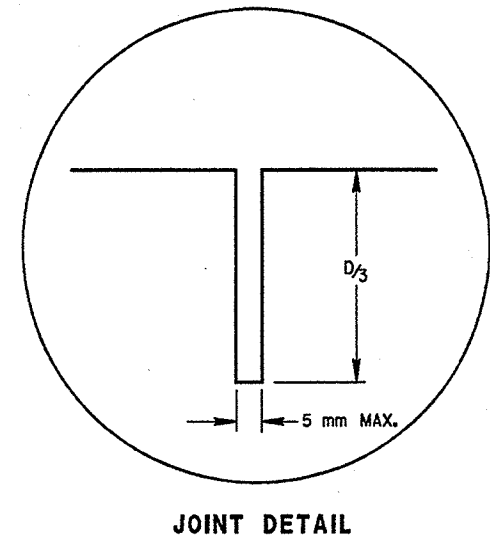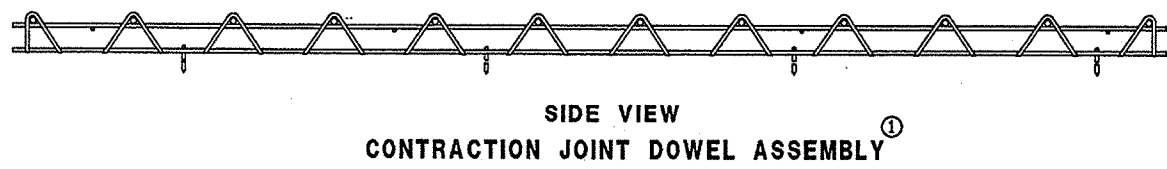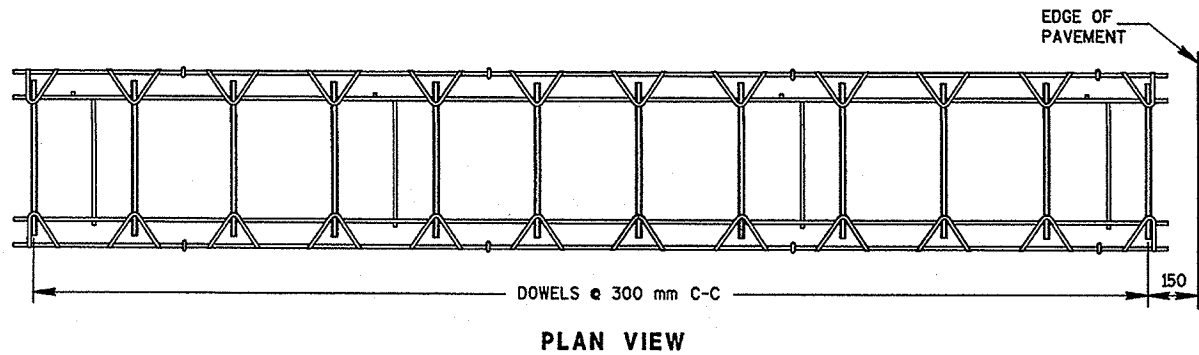

GENERAL NOTES

DETAILS OF CONSTRUCTION NOT SHOWN ON THIS DRAWING SHALL CONFORM TO THE STANDARD SPECIFICATIONS AND SPECIAL PROVISIONS.

CONTRACTION JOINTS

UNLESS OTHERWISE SPECIFIED, CONTRACTION JOINTS SHALL BE NORMAL TO THE CENTERLINE. THE LOCATION OF CONTRACTION JOINTS THROUGH INTERSECTIONS SHALL BE AS SHOWN ON THE PLANS OR AS DIRECTED BY THE ENGINEER.

CONTRACTION JOINTS SHALL NOT BE SEALED OR FILLED.

DOWEL BARS SHALL BE INSTALLED PARALLEL TO THE PAVEMENT CENTERLINE AND SURFACE.

CONSTRUCTION JOINTS

CONSTRUCTION JOINTS SHALL BE A MINIMUM OF 1.2 m FROM THE NEAREST CONTRACTION JOINT AND ALIGNED EITHER PARALLEL TO CONTRACTION JOINTS OR AT 90° TO THE CENTERLINE.

TIE BARS MAY BE INSERTED THROUGH THE HEADER BOARD AFTER THE CONCRETE HAS BEEN POURED.



- ① ALTERNATIVE DESIGNS OF THE DOWEL ASSEMBLY MAY BE USED WHEN APPROVED BY THE ENGINEER. MECHANICAL DOWEL BAR IMPLANTERS MAY BE USED INSTEAD OF DOWEL ASSEMBLIES.
- ② DOWEL BARS SHALL BE ANCHORED INTO DRILL HOLES WITH AN APPROVED EPOXY GROUT.
- ③ THE FREE END OF DOWEL BARS SHALL RECEIVE A THIN UNIFORM COATING OF BOND BREAKING GREASE.
- ④ DOWEL BARS INSTALLED BY DRILLING SHALL BE SPACED 380 mm ON CENTER. THE GROUPING OF DOWEL BARS SHALL BE CENTERED INSIDE THE SLAB BASED ON ALL THE FOLLOWING SITUATIONS:

BETWEEN THE EDGES OF PAVEMENTS WITHOUT LONGITUDINAL JOINTS OR BETWEEN THE EDGE OF PAVEMENT AND NEAREST LONGITUDINAL JOINT OR BETWEEN TWO ADJACENT LONGITUDINAL JOINTS.

THE CLEAR DISTANCE FROM THE EDGE OF PAVEMENT OR LONGITUDINAL JOINT TO THE NEAR EDGE OF DOWEL BAR NEAREST THAT EDGE OR JOINT SHALL BE A MINIMUM OF 150 mm AND A MAXIMUM OF 355 mm.

NOTE

ALL DIMENSIONS ARE SHOWN IN MILLIMETERS UNLESS OTHERWISE SHOWN.

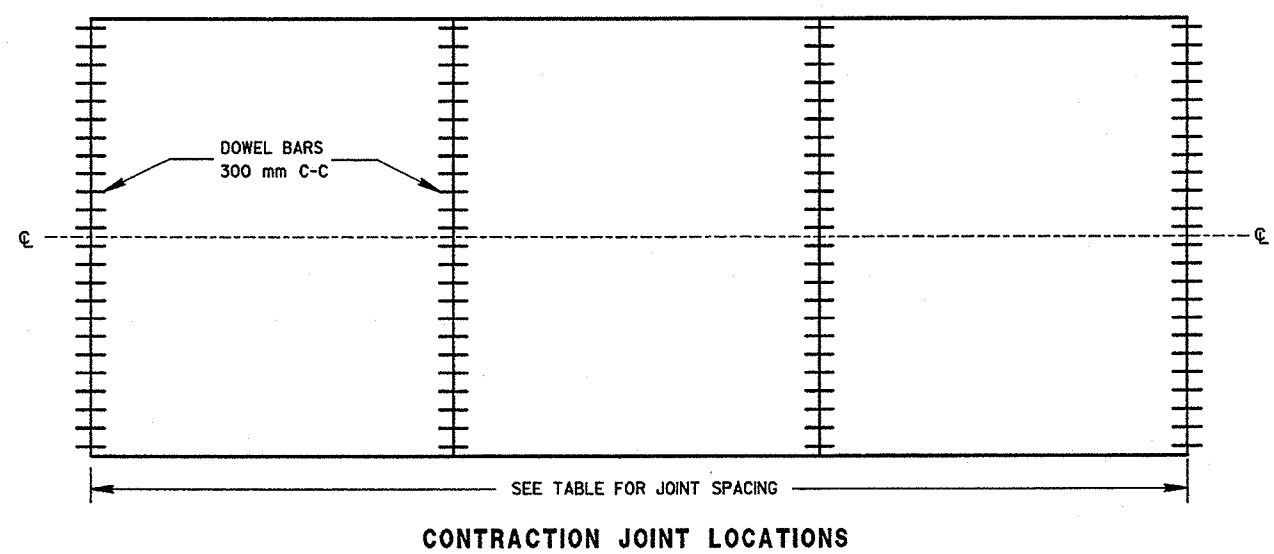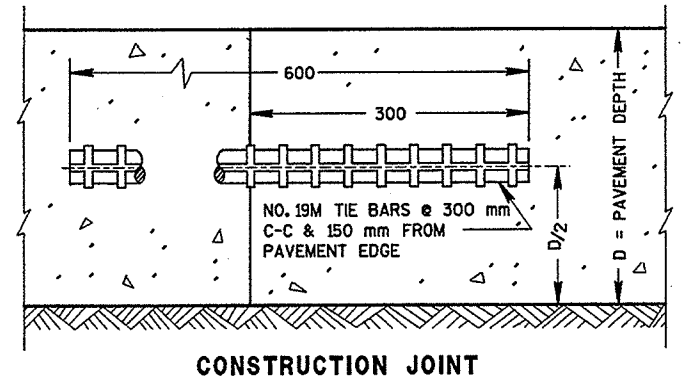

PAVEMENT DEPTH, DOWEL BAR SIZE AND JOINT SPACING TABLE

PAVEMENT DEPTH (D)	DOWEL BAR DIAMETER	CONTRACTION JOINT SPACING
150, 165 mm	32 mm	3.6 m
175, 190 mm	32 mm	4.3 m
200, 215 mm	32 mm	4.5 m
225, 240 mm	32 mm	4.5 m
250 mm & ABOVE	38 mm	5.5 m

URBAN DOWELED CONCRETE PAVEMENT

STATE OF WISCONSIN DEPARTMENT OF TRANSPORTATION

APPROVED
9-24-98
DATE

[Signature]
CHIEF PAVEMENTS & RESEARCH ENGINEER

FILE NAME:

PLOT SCALE:

PLOT NAME:




REV. DATE: 8-10-95

ORIGINATOR:



S.D.D. 15 C 2-3

LEVELS ON - 2,3,4,5,6,7,8,9,10,11,12,13,14,15,16,17,18,19,20,21,22,23,24,25,26,27,28,29,30,31,32,33,34,35,36,37,38,39,40,41,42,43,44,45,46,47,48,49,50,51,52,53,54,55,56,57,58,59,60,61,62,63

FILE NAME:

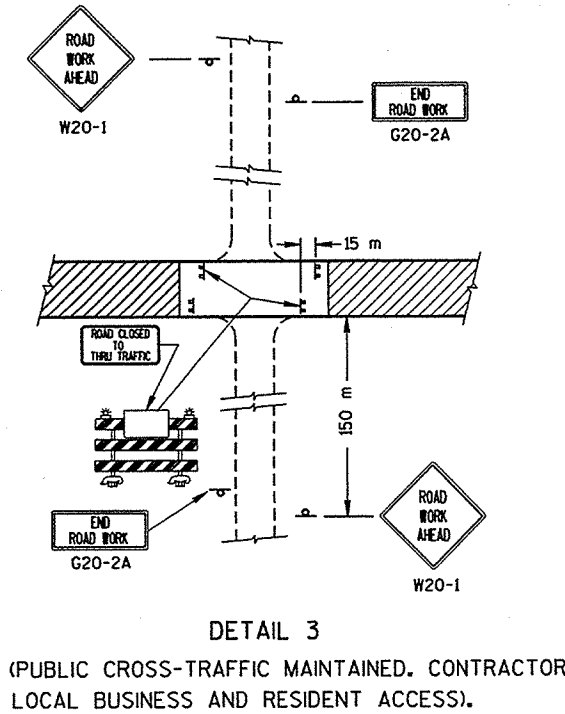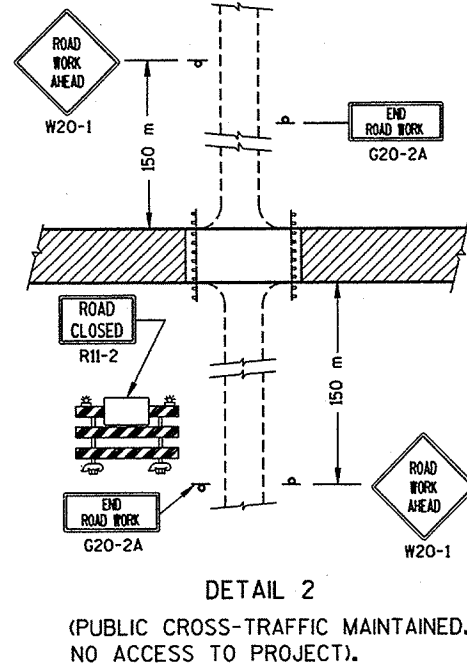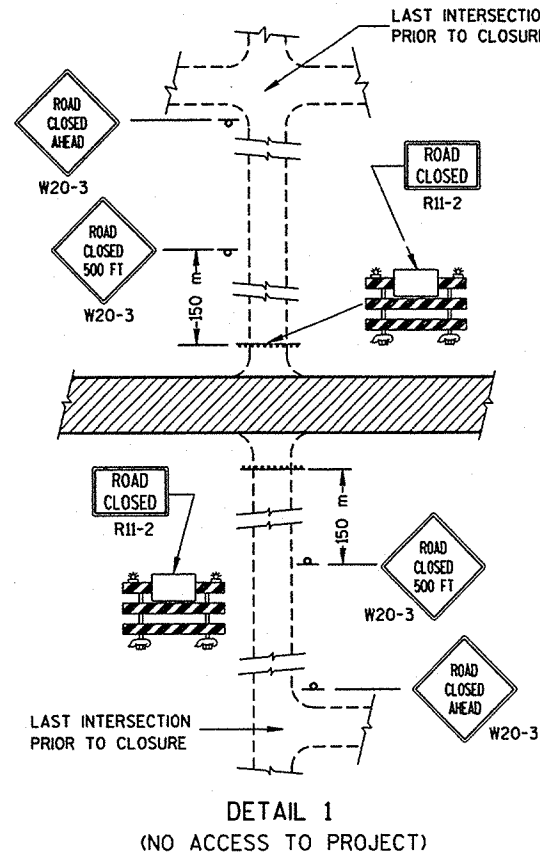

SIDEROAD CLOSURES

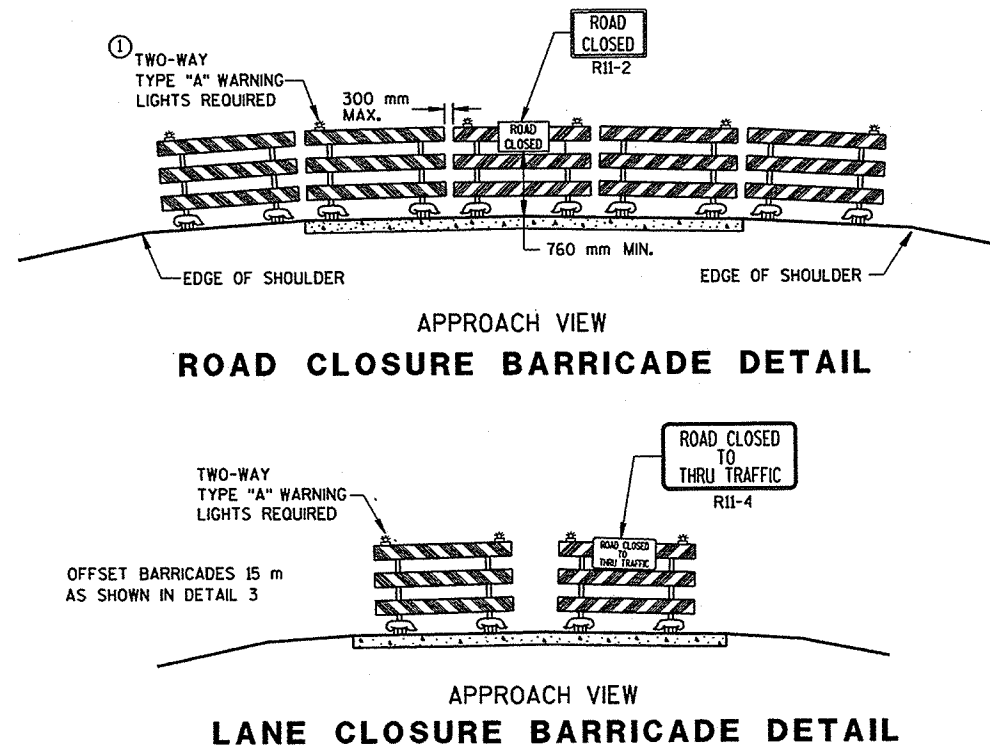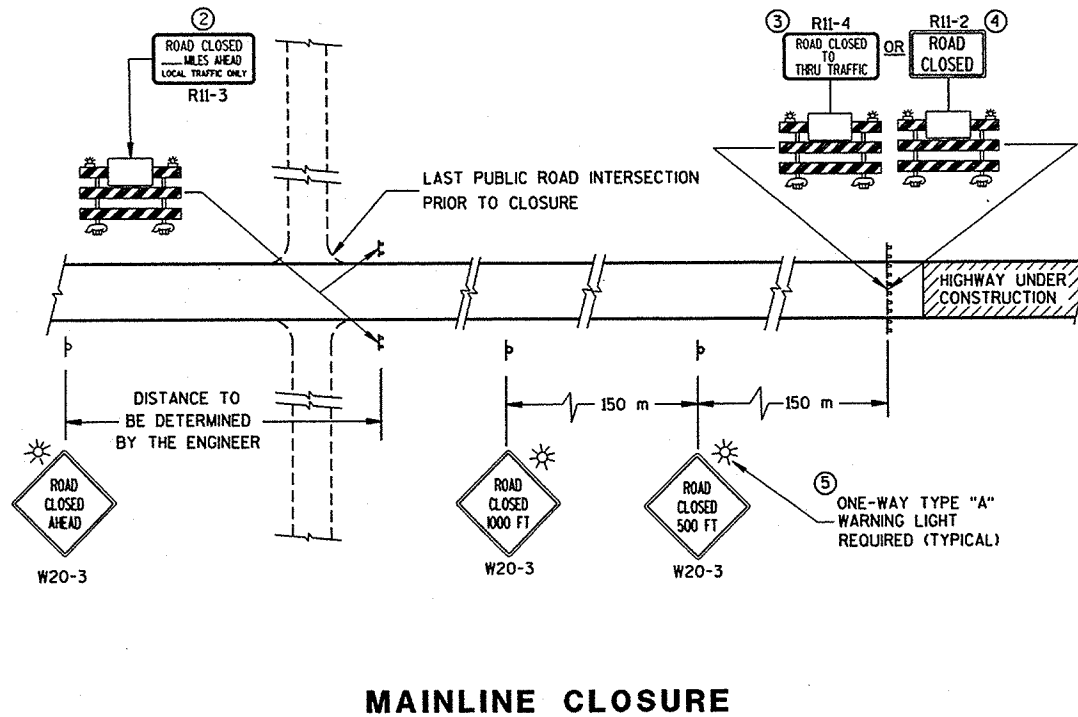

GENERAL NOTES

DETAILS OF TRAFFIC CONTROL DEVICES AND THEIR LOCATION NOT SHOWN ON THIS DRAWING SHALL CONFORM TO THE PERTINENT REQUIREMENTS OF THE WISCONSIN MANUAL OF TRAFFIC CONTROL DEVICES, THE PLANS, SPECIFICATIONS AND CONTRACT.

SIGN AND BARRICADE LOCATIONS MAY BE ADJUSTED IN THE FIELD AS DIRECTED BY THE ENGINEER. ANY EXISTING TRAFFIC SIGNS THAT CONFLICT WITH THIS WORK SHALL BE COVERED AS DIRECTED BY THE ENGINEER. ALL "STOP" OR OTHER REGULATORY SIGNS ON THE SIDE ROADS SHALL NOT BE DISTURBED, EXCEPT WHEN NECESSARY TO COMPLETE THE WORK. THE SIGNS MUST THEN BE IMMEDIATELY REESTABLISHED.

ALL TYPE III BARRICADES SHALL HAVE RAILS REFLECTORIZED ON BOTH FACES. STRIPES SHALL BE PROPERLY SLOPED DOWN TOWARD THE TRAFFIC SIDE OR AS SHOWN IN THE ROAD CLOSURE BARRICADE DETAIL FOR FULL ROAD CLOSURES. TYPE "A" LOW INTENSITY FLASHING WARNING LIGHTS SHALL BE VISIBLE ON BOTH SIDES OF THE BARRICADE.

THE ROAD CLOSED SIGN (R11-2), ROAD CLOSED MILES AHEAD SIGN (R11-3) AND THE ROAD CLOSED TO THRU TRAFFIC SIGN (R11-4) SHALL BE ATTACHED ONLY TO THE TOP RAIL OF THE TYPE III BARRICADE. THE SIGNS SHALL NOT COVER MIDDLE RAIL.

TYPE "H" REFLECTIVE SHEETING SHALL BE USED ON ALL BARRICADES, TYPE I, II AND III, AND ON ALL R11-3 AND R11-4 SIGNS.

ALL SIGNS SHALL BE 1200 mm X 1200 mm UNLESS OTHERWISE NOTED BELOW:

R11-2, "ROAD CLOSED" SIGNS SHALL BE 1200 mm X 750 mm.

R11-3, AND R11-4 SIGNS SHALL BE 1500 mm X 750 mm.

G20-2A SIGNS SHALL BE 1200 mm X 600 mm.

- TWO WARNING LIGHTS SHALL BE PROVIDED ON THE CENTER BARRICADE AND AT LEAST ONE WARNING LIGHT SHALL BE PROVIDED ON EACH OF THE OTHER BARRICADES WITHIN THE ROADWAY LIMITS. SPACING OF THE WARNING LIGHTS SHALL BE UNIFORM TO THE EDGE OF ROADWAY AS SHOWN.
- THESE SIGNS AND BARRICADES ARE NOT REQUIRED IF ROAD CLOSURE BEGINS AT INTERSECTION.
- FOR ROAD CLOSURE WITH LOCAL ACCESS TO PROJECT, SEE LANE CLOSURE BARRICADE DETAIL.
- FOR ROAD CLOSURE WITHOUT LOCAL ACCESS TO PROJECT, SEE ROAD CLOSURE BARRICADE DETAIL.
- ONE-WAY LIGHTS SHALL BE PROVIDED ON ALL ADVANCE WARNING SIGNS. THE UNIT SHALL BE POSITIONED SUCH THAT THE LIGHT SOURCE IS OUTSIDE THE SIGN FACE AND AT THE TOP OF THE SIGN.

- POST MOUNTED WARNING SIGN
- TYPE III BARRICADES WITH TYPE "H" REFLECTIVE SHEETING
- TYPE "A" LOW INTENSITY FLASHING WARNING LIGHT (FOR NIGHT USE)
- WORK AREA

BARRICADES AND SIGNS FOR ROAD CLOSURES

STATE OF WISCONSIN
DEPARTMENT OF TRANSPORTATION

APPROVED

8-10-95
DATE

Charles J. Spang
DIRECTOR, OFFICE OF TRAFFIC

FWA

M

S.D.D. 15 C 2-3

PLOT SCALE: 6-28-95


PLOT NAME:

REV. DATE:


ORIGINATOR:

S.D.D. 15 C 8-8a

LEVELS ON - 2, 3, 4, 62, 63

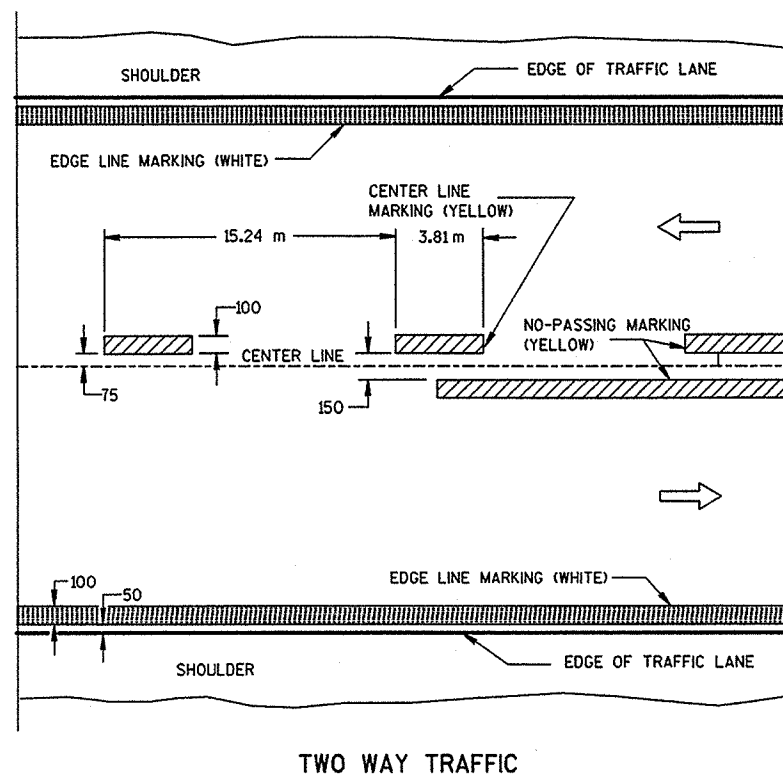


TWO WAY TRAFFIC

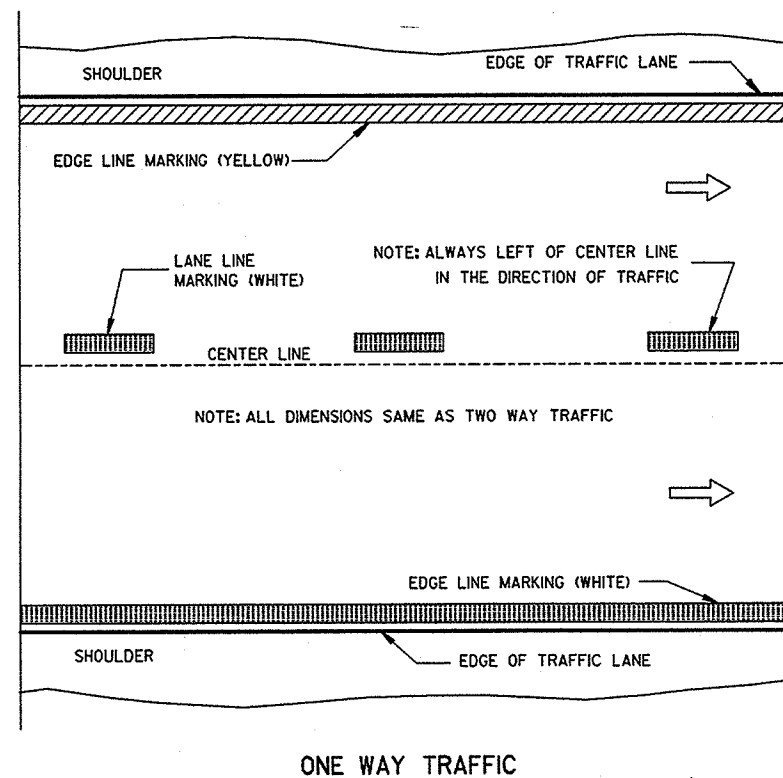


ONE WAY TRAFFIC

PERMANENT PAVEMENT MARKING

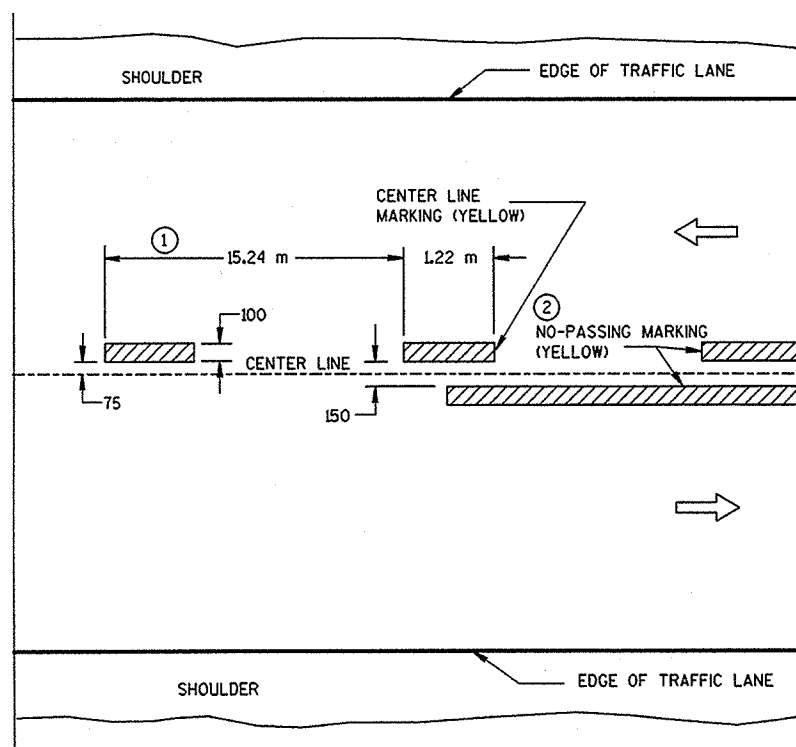

TWO WAY TRAFFIC

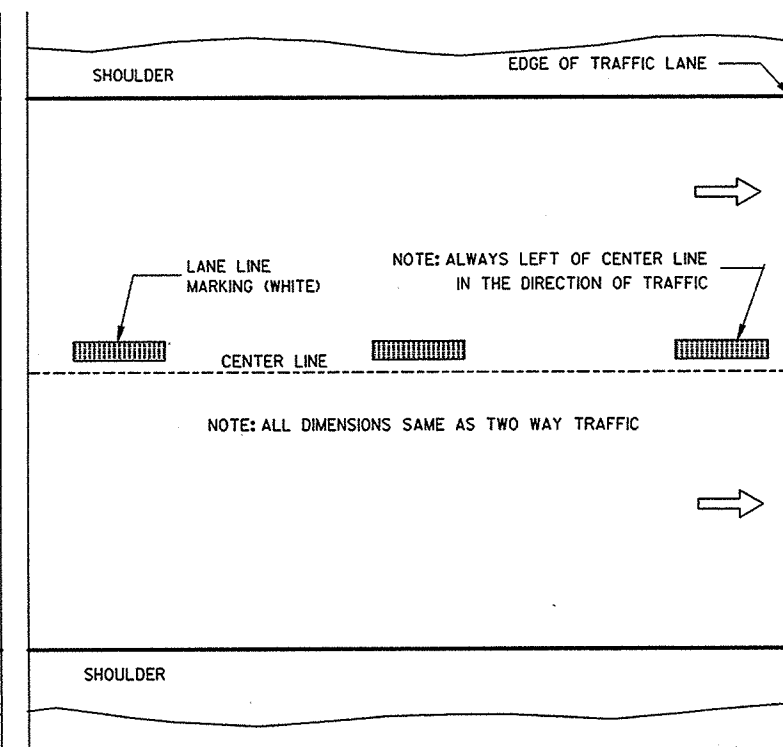

ONE WAY TRAFFIC

TEMPORARY (INTERMEDIATE) PAVEMENT MARKING
(SHOWS CYCLE FOR TEMPORARY CENTER LINE OR TEMPORARY LANE LINE MARKING)

GENERAL NOTES

DETAILS OF CONSTRUCTION NOT SHOWN ON THIS DRAWING SHALL CONFORM TO STANDARD SPECIFICATIONS AND SPECIAL PROVISIONS.

- ① HALF CYCLE LENGTHS (7.62 m±) WITH 600 mm MINIMUM STRIPE LENGTHS SHALL BE PROVIDED ON ROADWAYS (INCLUDING TEMPORARY TRAVELED WAYS) WITH REVERSE CURVATURE, CURVATURE OF OVER 5 DEGREES OR WHEN DIRECTED BY THE ENGINEER TO MARK UNUSUAL ALIGNMENT OF THE TRAVELED WAY.
- ② NO PASSING ZONE TEMPORARY PAVEMENT MARKING IS REQUIRED TO BE PLACED, WHERE APPROPRIATE, ALONG WITH CENTERLINE TEMPORARY PAVEMENT MARKING WHEN A SAME DAY PERMANENT PAVEMENT MARKING ITEM IS INCLUDED IN THE CONTRACT.

NOTE

ARROW SYMBOL (⇨) SHOWS DIRECTION OF TRAVEL
ALL DIMENSIONS ARE IN MILLIMETERS UNLESS OTHERWISE SHOWN.

PAVEMENT MARKING
(MAINLINE)

STATE OF WISCONSIN
DEPARTMENT OF TRANSPORTATION

APPROVED
4-10-98
DATE

Christa J. Spang
CHIEF SIGNS AND MARKING ENGINEER

FHWA

M

PLOT SCALE:


PLOT NAME:

REV. DATE: 8-9-95

ORIGINATOR:

S.D.D. 15 C 8-8b


LEVELS ON - 2,3,4,5,6,7,8,9,10,11,12,13,14,15,16,17,18,19,20,21,22,23,24,25,26,27,28,29,30,31,32,33,34,35,36,37,38,39,40,41,42,43,44,45,46,47,48,49,50,51,52,53,54,55,56,57,58,59,60,61,62,63

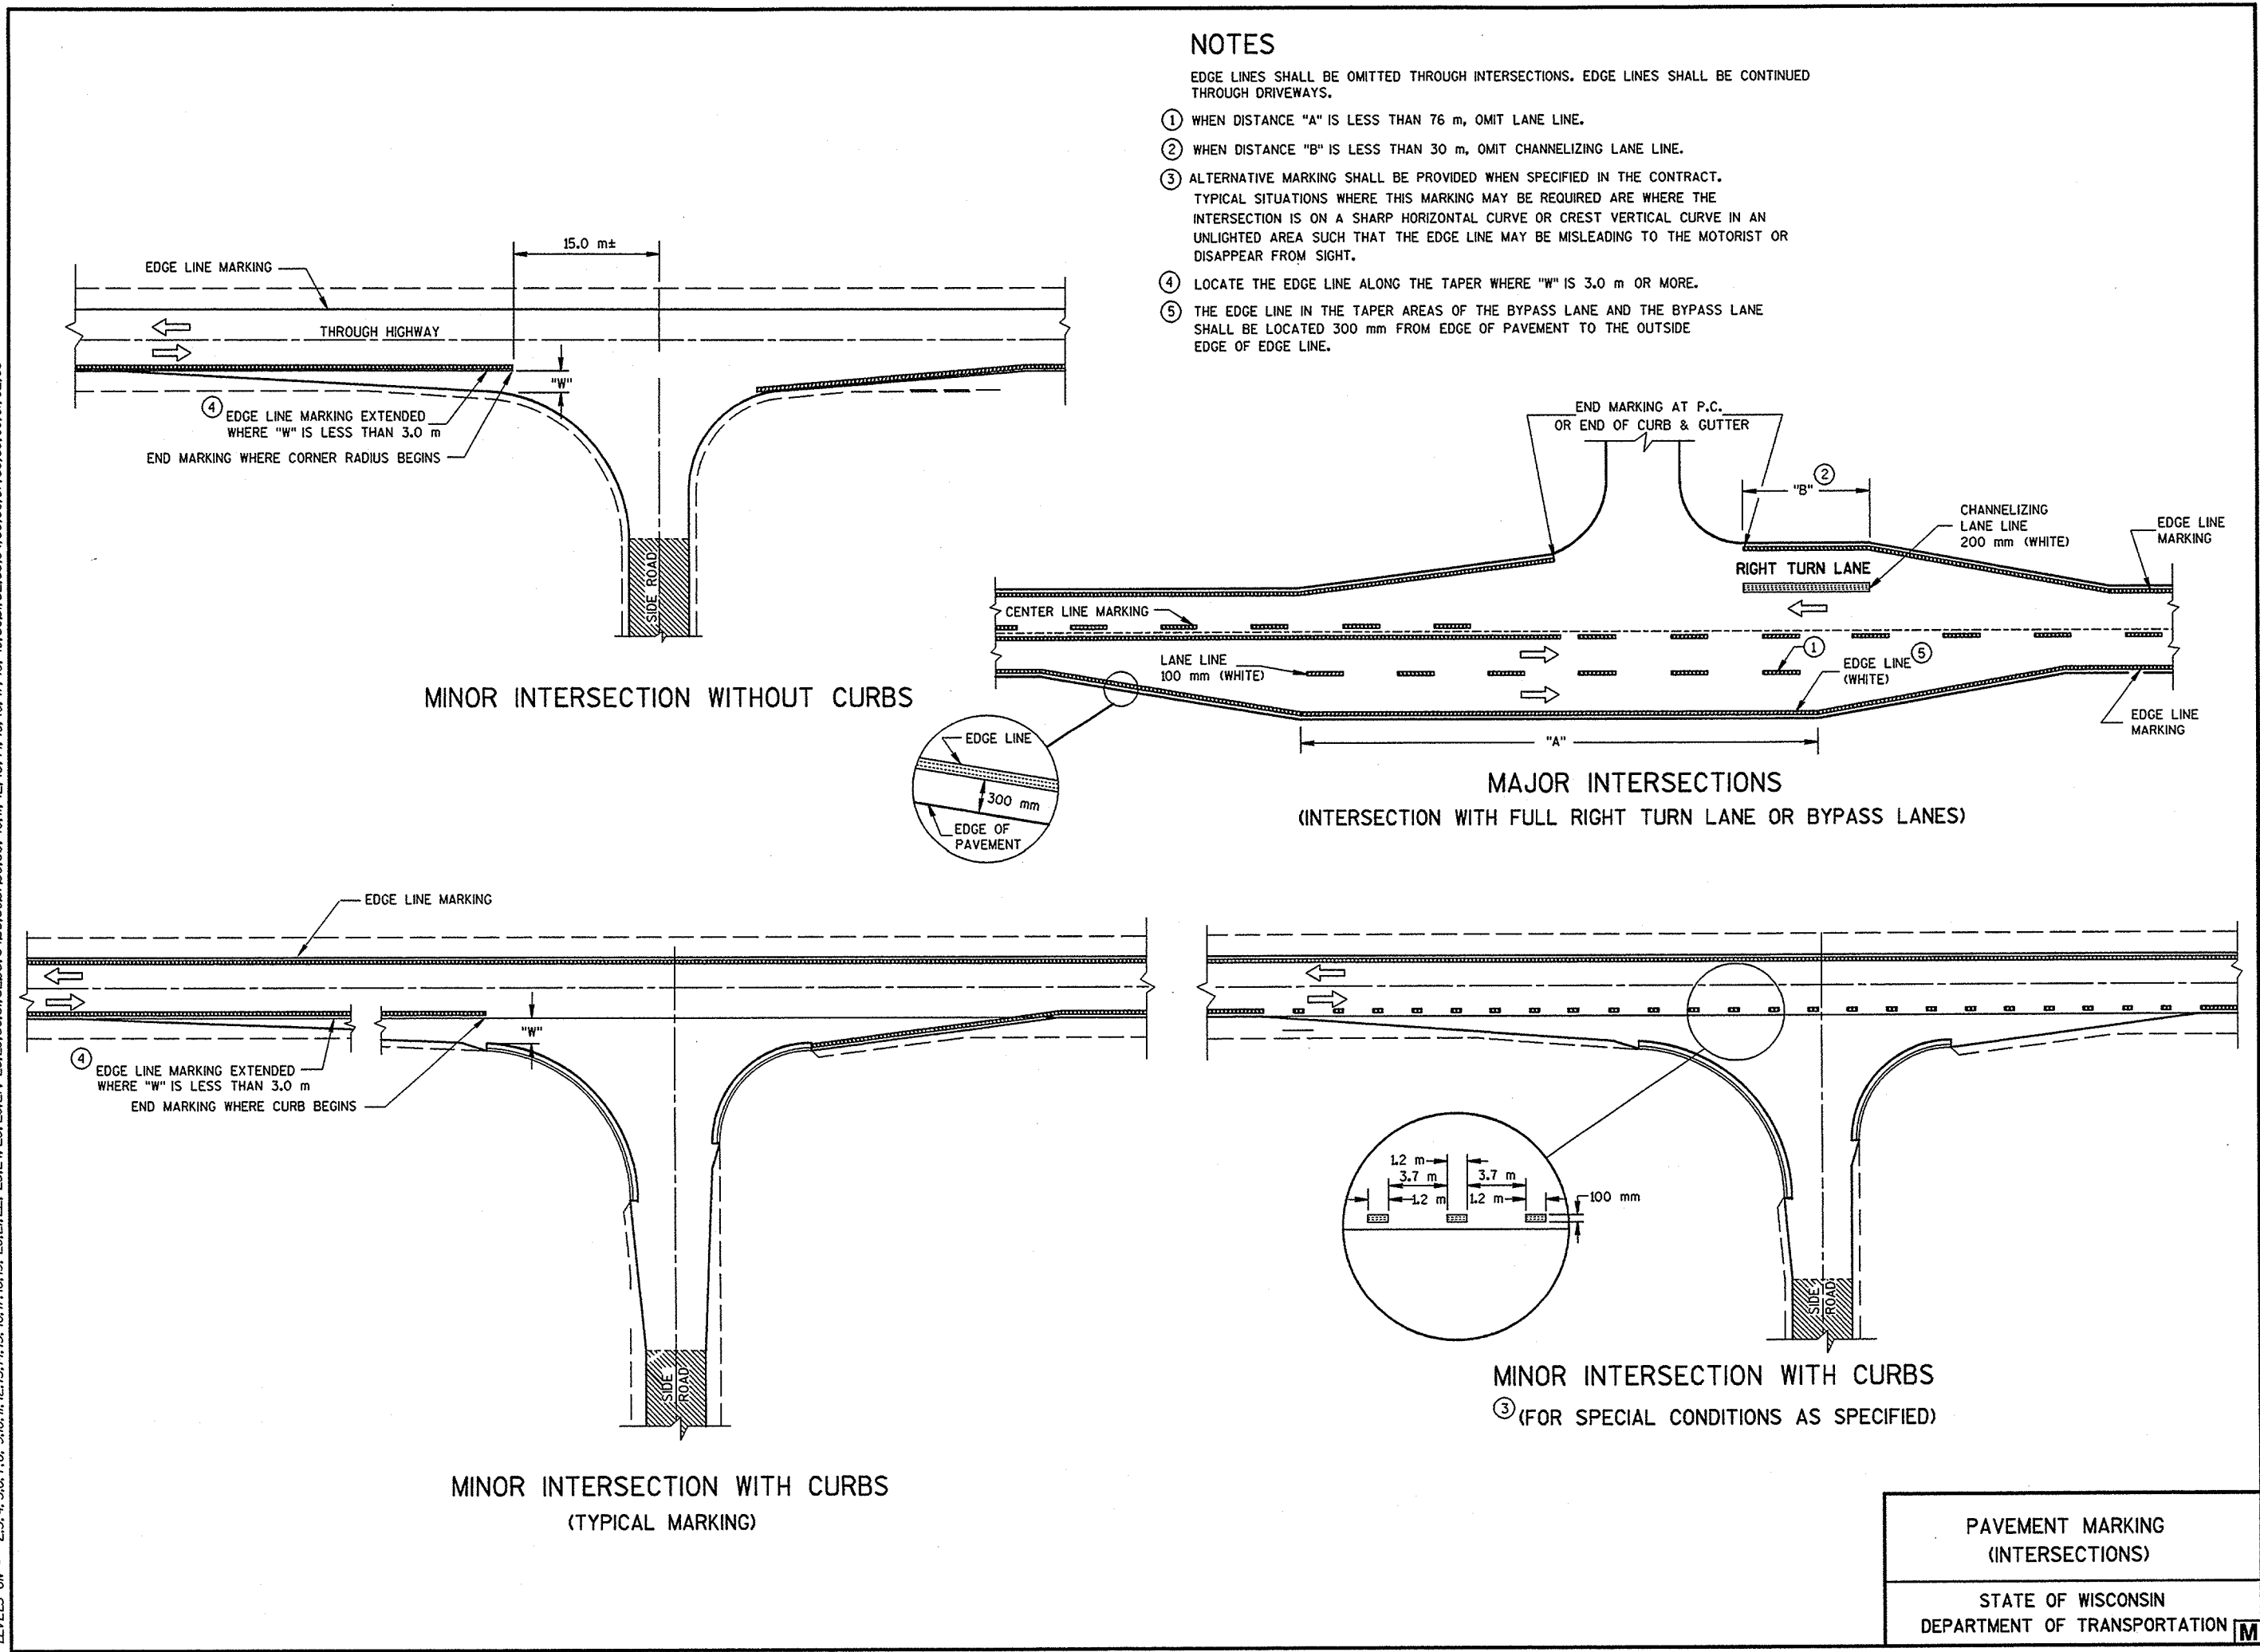


PAVEMENT MARKING
(INTERSECTIONS)

STATE OF WISCONSIN
DEPARTMENT OF TRANSPORTATION **M**


MATCH LINE

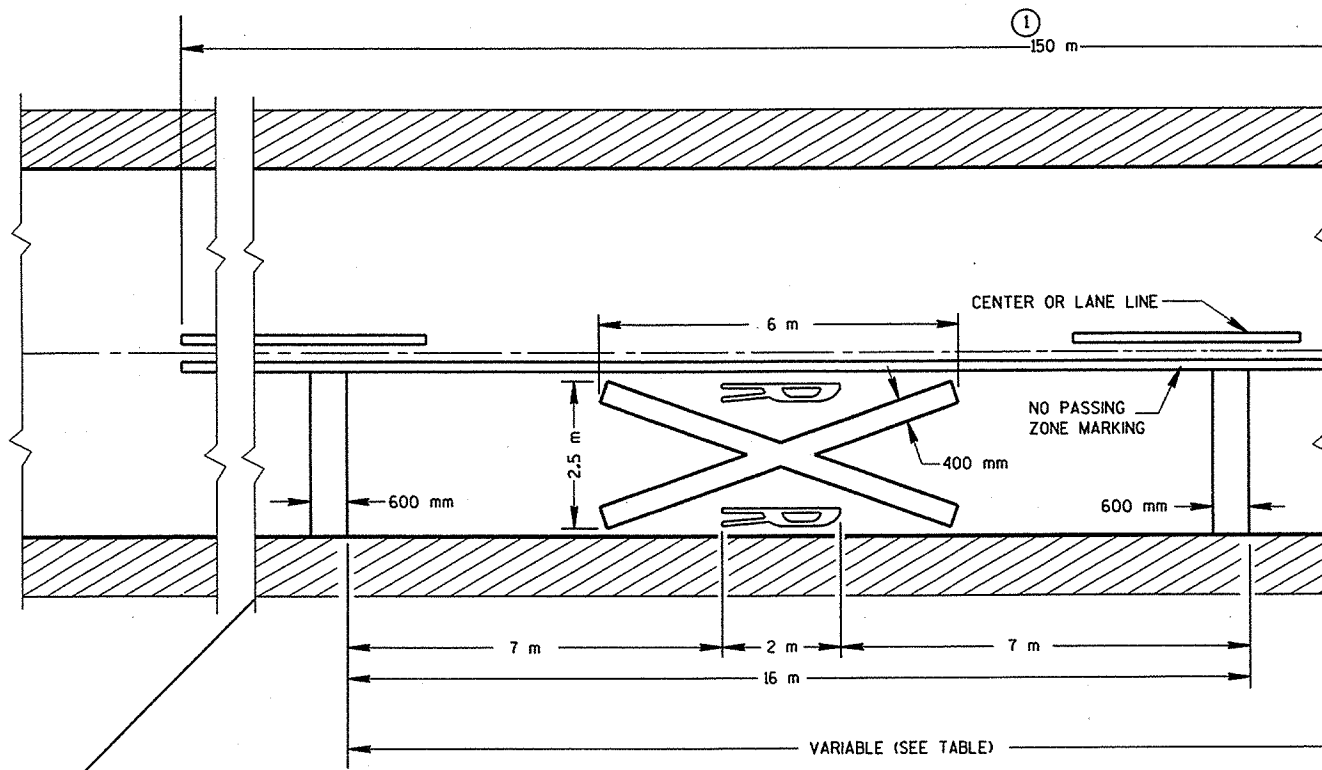

PAVEMENT MARKING

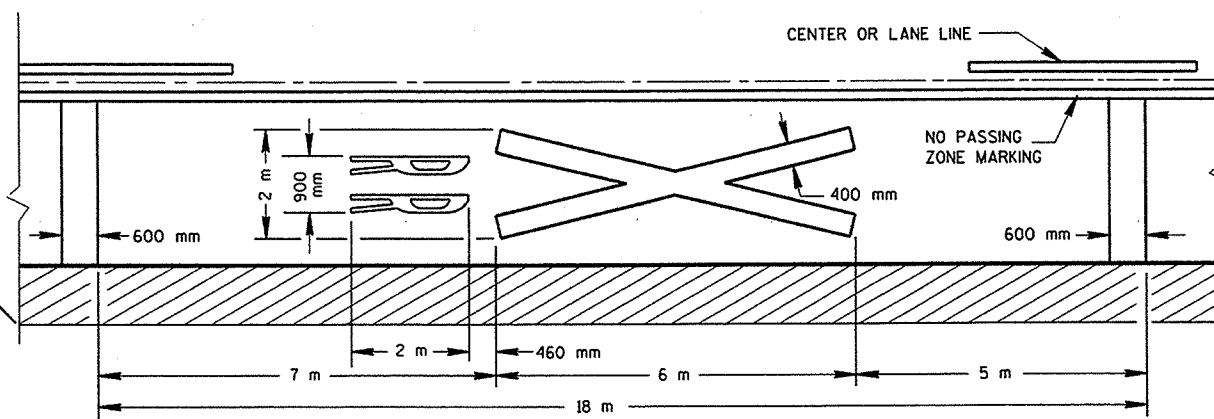

ALTERNATE PAVEMENT MARKING

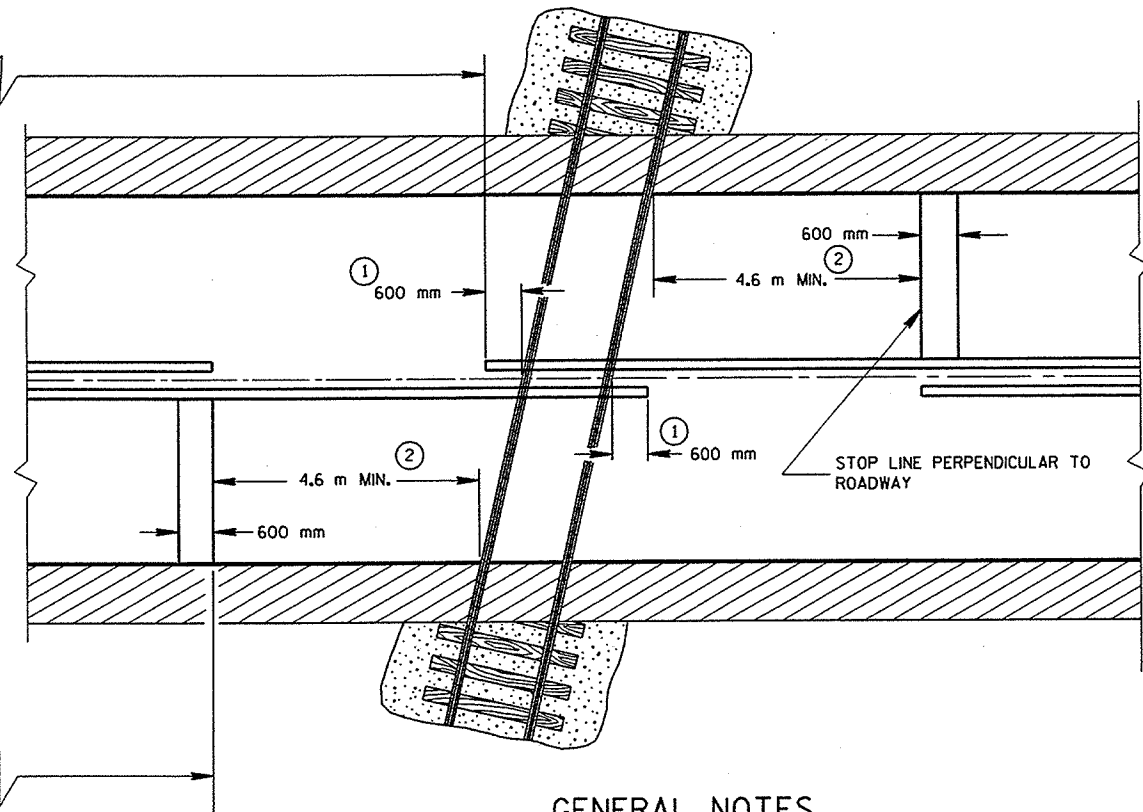

Posted Speed (M.P.H.)	Variable Dimension	
	(Feet)	(Meters)
25	150	45
30	200	60
35	250	75
40	325	100
45	400	125
50	475	145
55	500	170

GENERAL NOTES

DETAILS OF CONSTRUCTION, MATERIALS, AND WORKMANSHIP NOT SHOWN ON THIS DRAWING SHALL CONFORM TO THE PERTINENT REQUIREMENTS OF THE STANDARD SPECIFICATIONS AND THE APPLICABLE SPECIAL PROVISIONS.

THE DISTANCE FROM THE RAILROAD CROSSING MARKING TO THE NEAREST TRACK WILL VARY ACCORDING TO THE APPROACH SPEED AND THE SIGHT DISTANCE OF THE VEHICULAR TRAFFIC. DIMENSIONS SHOWN IN THE TABLE SHALL BE USED UNLESS OTHERWISE SHOWN ON THE PLANS.

A THREE-LANE ROADWAY SHOULD BE MARKED WITH A CENTERLINE FOR TWO-LANE APPROACH OPERATION ON THE APPROACH TO A CROSSING.

ON MULTI-LANE ROADS THE TRANSVERSE BANDS SHOULD EXTEND ACROSS ALL APPROACH LANES, AND INDIVIDUAL R X R SYMBOLS SHOULD BE USED IN EACH APPROACH LANE. ALL LETTERS AND SYMBOLS SHALL BE IN CONFORMANCE WITH THE "STANDARD ALPHABETS FOR HIGHWAY SIGNS AND PAVEMENT MARKINGS" (ADOPTED BY THE FEDERAL HIGHWAY ADMINISTRATION).

TRANSVERSE BANDS AND R X R SYMBOL ARE REFLECTIVE WHITE. SOLID LONGITUDINAL LINE IS REFLECTIVE YELLOW ON BIDIRECTIONAL TRAVELED WAYS AND IS OMITTED ON UNIDIRECTIONAL TRAVELED WAYS. DASHED LONGITUDINAL LINE IS REFLECTIVE YELLOW WHEN IT IS BETWEEN LANES OF TRAFFIC MOVING IN OPPOSITE DIRECTIONS AND REFLECTIVE WHITE WHEN IT IS BETWEEN LANES OF TRAFFIC MOVING IN THE SAME DIRECTION.

CENTER OR LANE LINES AND NO PASSING ZONE MARKINGS SHOWN ON THIS DRAWING ARE REQUIRED AND PAID FOR UNDER OTHER ITEMS IN THE CONTRACT.

- ① MARKING LIMITS MAY BE EXTENDED AS DIRECTED BY THE ENGINEER TO MEET ADJACENT NO PASSING ZONE MARKINGS.
- ② MINIMUM 2.4 m TO GATE IF PRESENT.

PAVEMENT MARKING DETAILS
FOR RAILROAD-HIGHWAY
GRADE CROSSINGS

STATE OF WISCONSIN
DEPARTMENT OF TRANSPORTATION

APPROVED
8-7-95
DATE

Christa J. Spang
for DIRECTOR, OFFICE OF TRAFFIC

FHWA **M**

PLOT SCALE:


PLOT NAME:

REV. DATE: 6-29-95


ORIGINATOR:

S.D.D. 15 C 8-8e


LEVELS ON - 2,3,4,5,6,7,8, 9,10,11,12,13,14,15,16,17,18,19, 20,21,22, 23,24,25,26,27, 28,29,30,31, 32,33, 34,35,36,37,38,39, 40,41, 42,43,44,45,46,47,48, 49,50,51,52,53,54,55,56,57,58,59,60,61,62,63

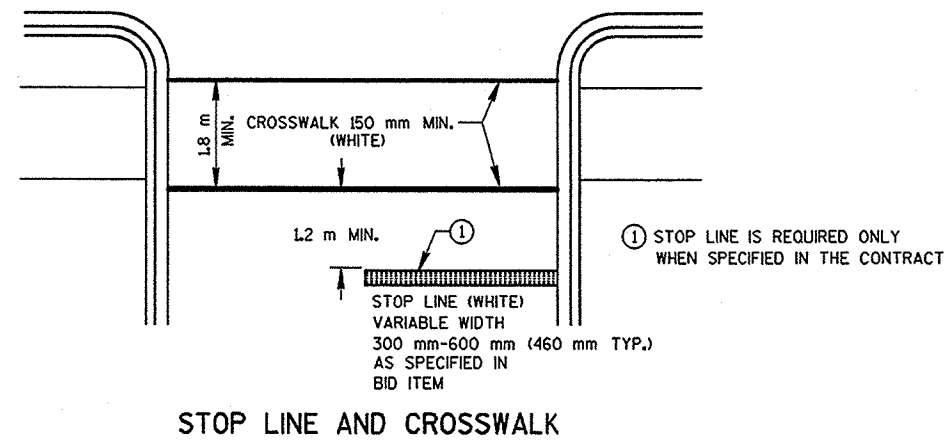


STOP LINE AND CROSSWALK

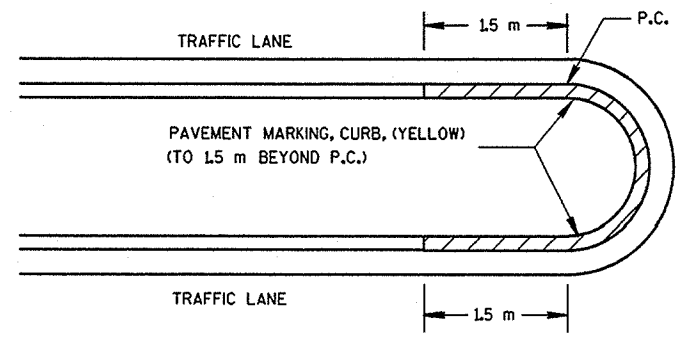


MEDIAN CURB

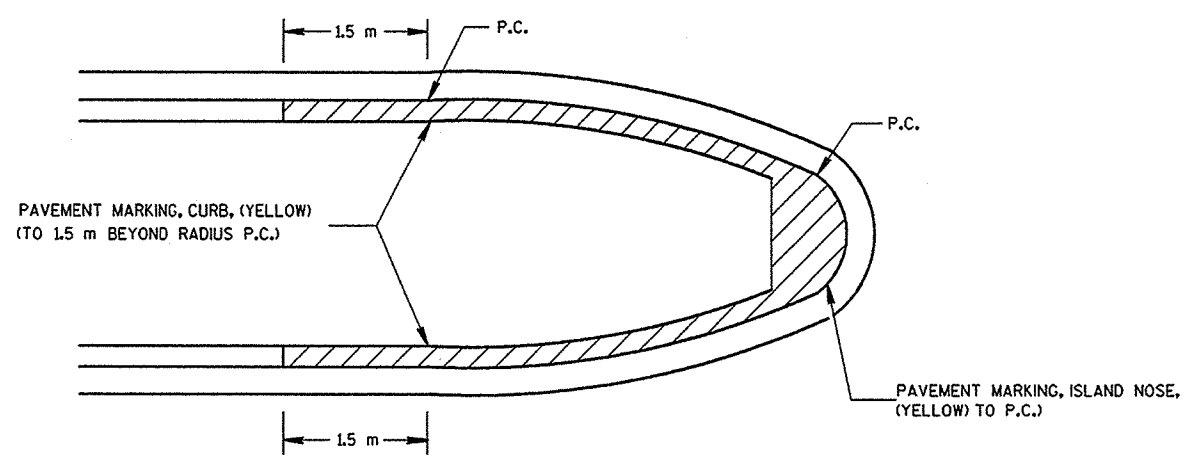

BULLET NOSE ISLAND

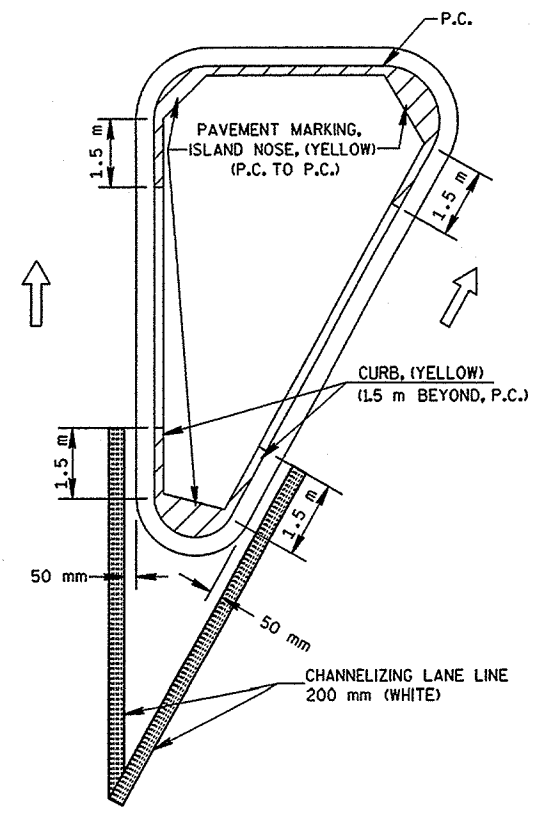

LARGE ISLAND
(GREATER THAN 15.0 m PERIMETER OR ANY SIDE
GREATER THAN 8.0 m BETWEEN CURVES)

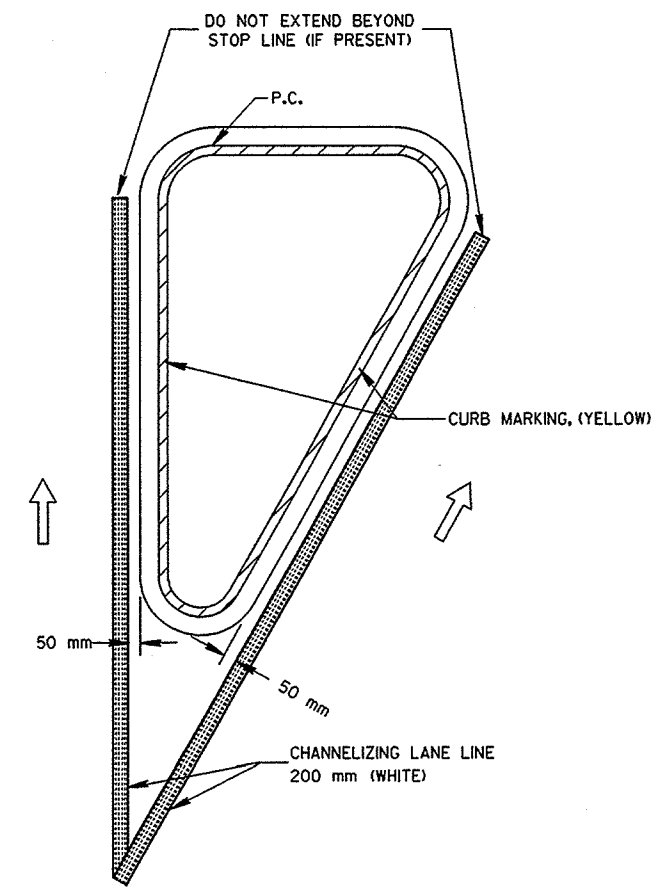

SMALL ISLAND
(LESS THAN 15.0 m PERIMETER OR ANY SIDE
LESS THAN 8.0 m BETWEEN CURVES)

NOTE:
ARROW SYMBOL (→)
SHOWS DIRECTION OF TRAVEL

PAVEMENT MARKING (ISLANDS, STOP LINE & CROSS WALK)	
STATE OF WISCONSIN DEPARTMENT OF TRANSPORTATION	
APPROVED 4-10-98 DATE	<i>Christa J. Spang</i> CHIEF SIGNS AND MARKING ENGINEER
FHWA	M

FILE NAME:

S.D.D. 15 C 8-8e


PLOT SCALE:

PLOT NAME:


REV. DATE:

ORIGINATOR:


S.D.D. 15 C 11-5
LEVELS ON - 2, 3, 4, 62, 63

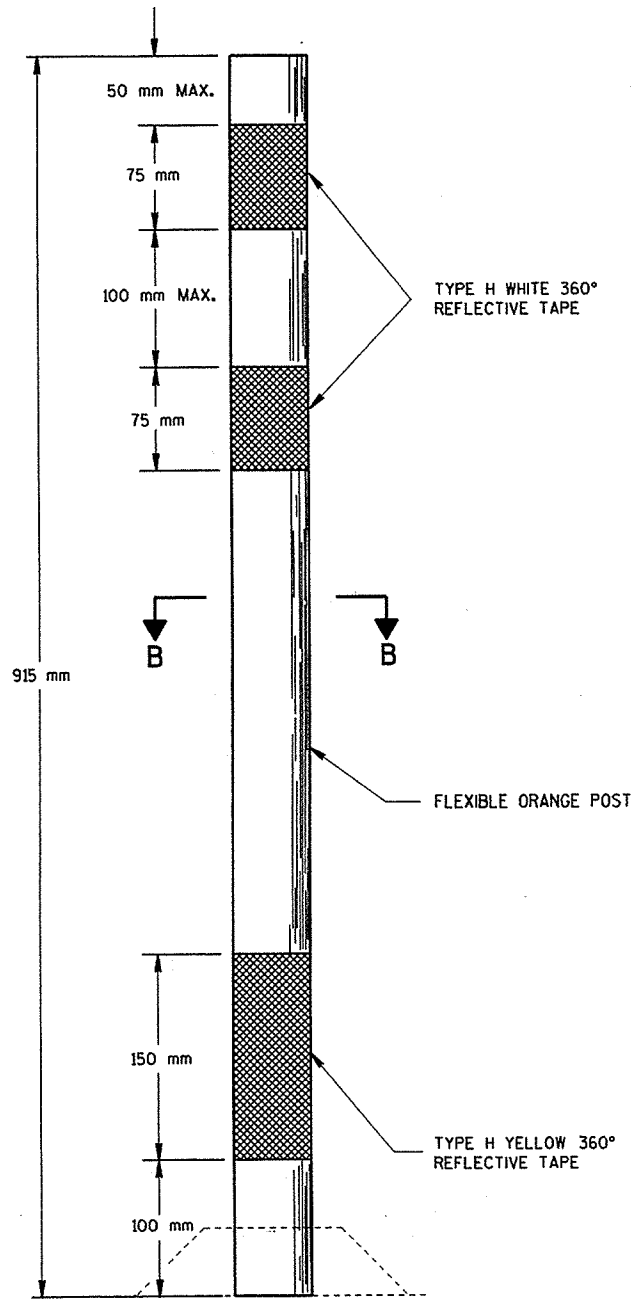

FLEXIBLE TUBULAR MARKER POST

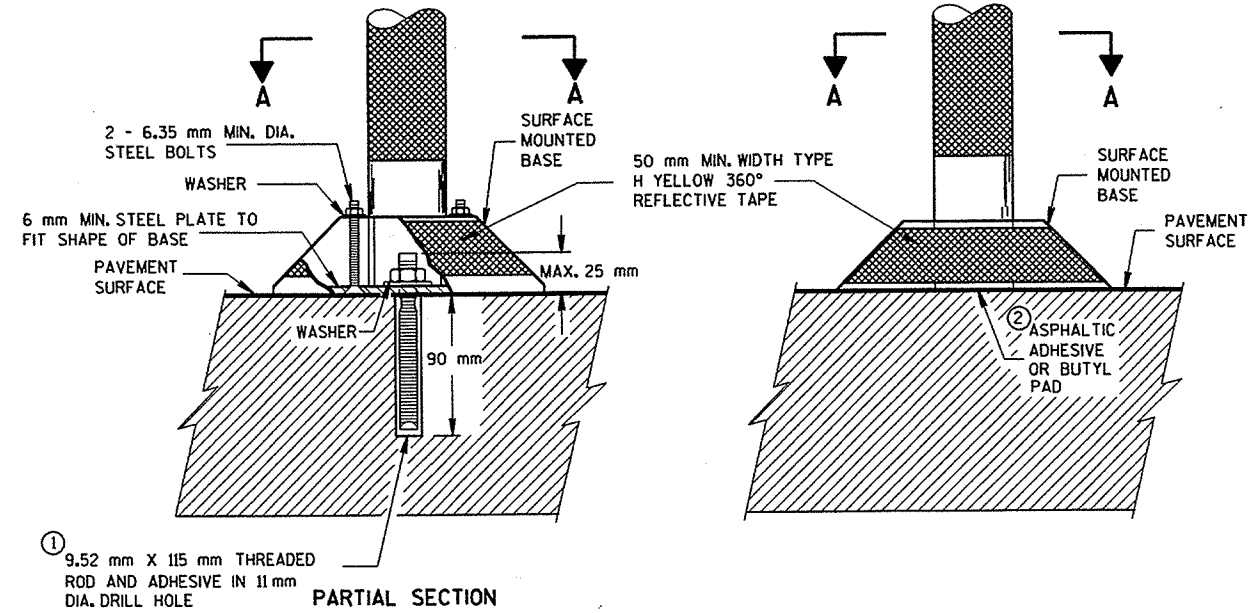

PARTIAL SECTION TO SHOW BOLTS
POST BASES ON NEW OR EXISTING PAVEMENT

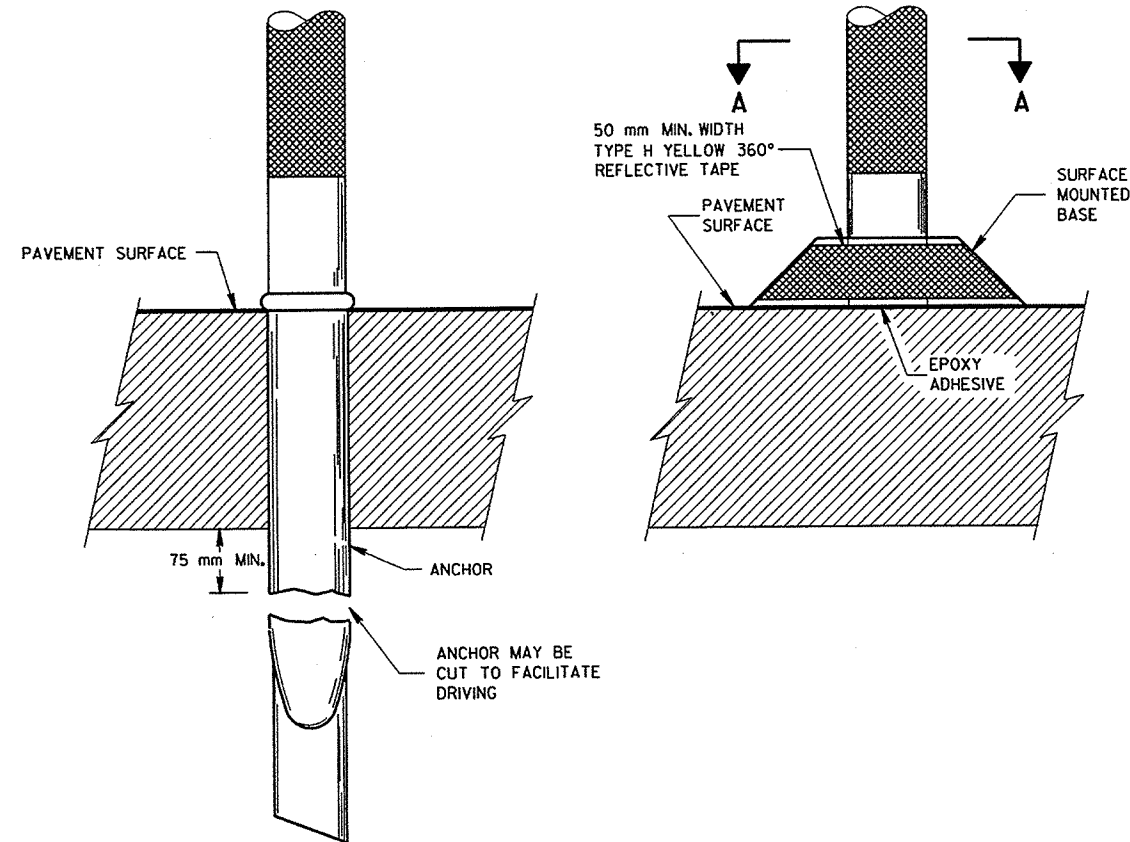


POST ANCHOR AND BASE ON PAVEMENT WHICH WILL BE REMOVED

GENERAL NOTES


DETAILS OF CONSTRUCTION NOT SHOWN ON THIS DRAWING SHALL CONFORM TO THE PERTINENT REQUIREMENTS OF THE STANDARD SPECIFICATIONS AND APPLICABLE SPECIAL PROVISIONS.

SURFACE MOUNTED BASES SHALL BE FURNISHED IN ACCORDANCE WITH MANUFACTURERS RECOMMENDATIONS TO BE COMPATIBLE WITH FLEXIBLE TUBULAR MARKER POSTS TO A SIZE AND SHAPE THAT WILL PROVIDE A STABLE POST FOUNDATION WHEN SECURED TO THE PAVEMENT.

- ① THREADED ROD SHALL BE MACHINED DOWN TO 7.11 mm DIA. 31.75 mm FROM THE TOP.
- ② THE ASPHALTIC ADHESIVE OR BUTYL PAD FURNISHED SHALL BE IN ACCORDANCE WITH MANUFACTURER'S RECOMMENDATIONS.

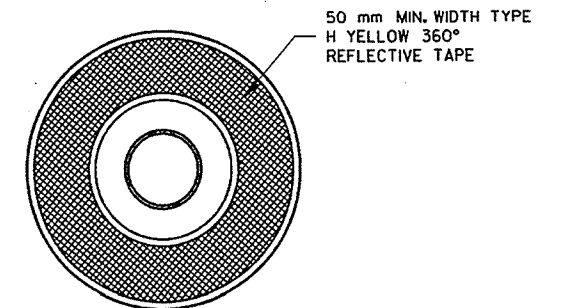

SECTION A-A
SURFACE MOUNTED BASE

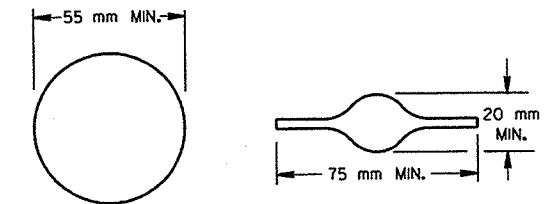

SECTION B-B
ALTERNATIVE SHAPES

FLEXIBLE TUBULAR MARKER POST, ANCHOR & BASES

STATE OF WISCONSIN
DEPARTMENT OF TRANSPORTATION

APPROVED

8-7-95
DATE

Christa J. Spang
DIRECTOR, OFFICE OF TRAFFIC

FWHA

PLOT SCALE:



PLOT NAME:

REV. DATE: 7-6-95

ORIGINATOR:

S.D.D. 15 D 6-2

LEVELS ON - 2,3,4,5,6,7,8,9,10,11,12,13,14,15,16,17,18,19,20,21,22,23,24,25,26,27,28,29,30,31,32,33,34,35,36,37,38,39,40,41,42,43,44,45,46,47,48,49,50,51,52,53,54,55,56,57,58,59,60,61,62,63

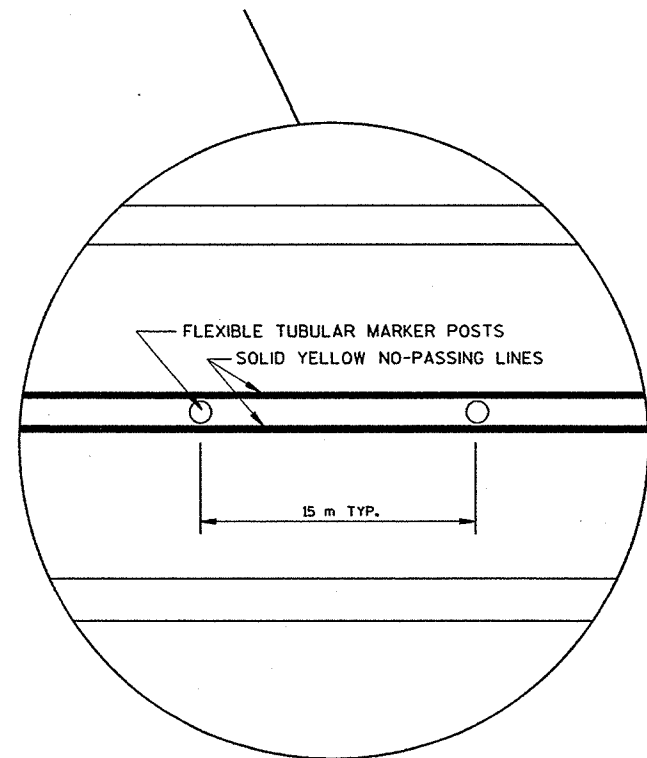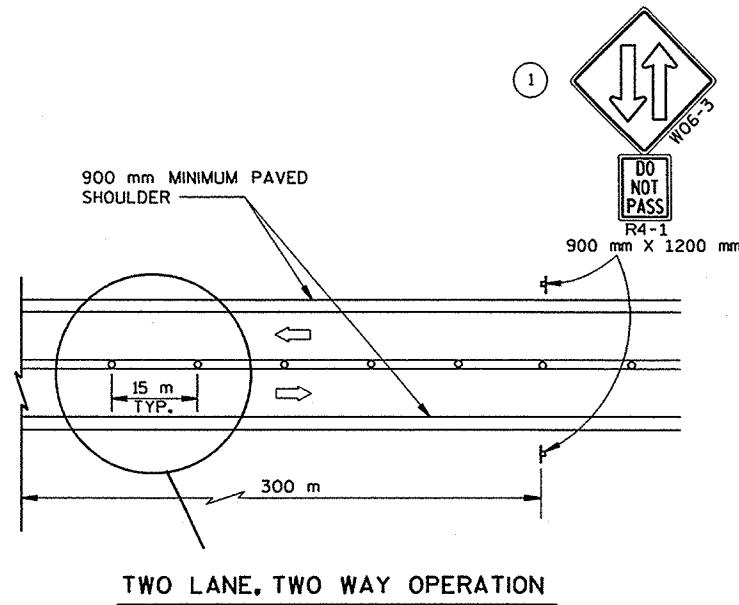

- LEGEND**
- ⊣ POST WITH ATTACHED SIGN
 - FLEXIBLE TUBULAR MARKER AND BASE
 - ⇨ DIRECTION OF TRAFFIC

GENERAL NOTES :

ALL SIGNS ARE 1200 mm X 1200 mm UNLESS OTHERS NOTED.

"WO" IS THE SAME AS "W" EXCEPT THE BACKGROUND IS ORANGE.

ANY SIGNS TEMPORARY OR EXISTING, WHICH CONFLICT WITH THE TRAFFIC CONTROL "IN USE" SHALL BE REMOVED OR COVERED AS NEEDED AND AS APPROVED BY THE ENGINEER. NO WARNING LIGHTS SHALL BE WORKING ON "COVERED" OR "DOWNED" SIGNS.

THE EXACT NUMBER, LOCATION, AND SPACING OF ALL SIGNS AND DEVICES SHALL BE ADJUSTED TO FIT FIELD CONDITIONS AS APPROVED BY THE ENGINEER.

THE SPACING BETWEEN SIGNS SHOULD BE ADJUSTED TO NOT CONFLICT WITH AND TO PROVIDE A MINIMUM OF 60 m, (150 m DESIRABLE) DISTANCE TO EXISTING SIGNS.


A SINGLE ROW OF FLEXIBLE TUBULAR MARKERS ON CENTERLINE EXTEND FOR THE ENTIRE LENGTH OF TWO-WAY TRAFFIC @ 15 m SPACING.

COVER EXISTING CENTERLINE STRIPE WITH TEMPORARY PAVEMENT MARKING, 100 mm DOUBLE YELLOW.



R2-1
1200 mm X 1500 mm
(BLACK AND WHITE)

IF THE REGULATORY SPEED HAS BEEN REDUCED, A SPEED LIMIT SIGN SHALL BE LOCATED 500 m BEYOND THE END OF THE ACCELERATION LANE OF EACH ENTRANCE RAMP. THERE SHOULD BE A SPEED LIMIT SIGN INCORPORATED A MINIMUM OF EVERY 3 OR 5 km.

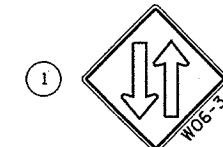

THE W06-3 WITH THE W057-51 SHALL BE LOCATED 60 m BEYOND THE END OF THE ACCELERATION LANE OF EACH ENTRANCE RAMP AND/OR 150 m BEYOND ANY SIDEROAD. THE W06-3 WITH THE R4-1 SHALL BE LOCATED 300 m BEYOND THE W06-3 AND THE W057-51 AND THE SIGNS SHALL BE ALTERNATED WITH 1.5 km INTERVALS BETWEEN W06-3 SIGNS.

TRAFFIC CONTROL, TWO LANE TWO WAY OPERATION	
STATE OF WISCONSIN DEPARTMENT OF TRANSPORTATION	
APPROVED 8-7-95 DATE	<i>Christie J. Seany</i> for DIRECTOR, OFFICE OF TRAFFIC
FHWA M	

S.D.D. 15 D 6-2

FILE NAME:

EARTHWORK DATA

CR2
 PLOT TABLE * aplot72100er+tm80pp.tbl
 DATE OF PLOT = 07/25/99
 PLOT FILE IS I:\440278.dgn\MISC.dgn

50, 51, 52, 53, 54, 55, 56, 57, 58, 59, 60, 61, 62, 63, 34, 35, 36, 37, 38, 39, 40, 41, 42, 43, 44, 45, 46, 47, 48, 49

PLOT NAME:
 SCALE:

DATE: 7/1/99
 FILE NAME:

ORIGINATOR: DJD
 PROJECT NO: 440278.00
 REVISION: BY:
 DATE REVISION:

LEVELS ON * 1, 2, 3, 61, 62


STATION	END AREA		FACTORS		VOLUMES		VOLUMES		MASS HAUL
	CUT	FILL	CUT	FILL	CUT	FILL	CUT	FILL	
	(m2)	(m2)			(m3)	(m3)	(m3)	(m3)	(m3)
PROJECT 4994-00-78									
10+000	5.5	0.4	1.0	1.3	0	0	0	0	0
10+020	3.3	0.8	1.0	1.3	88	16	88	16	72
10+040	6.3	0.6	1.0	1.3	96	18	184	34	150
10+060	7.4	0.2	1.0	1.3	137	10	321	44	277
10+080	7.9	0.0	1.0	1.3	153	3	474	47	427
10+100	9.0	0.0	1.0	1.3	168	0	642	47	595
10+120	8.3	0.3	1.0	1.3	173	4	815	51	764
10+140	7.9	0.6	1.0	1.3	162	12	977	62	915
10+160	7.2	0.6	1.0	1.3	151	16	1128	78	1050
10+180	6.9	0.5	1.0	1.3	140	13	1268	91	1177
10+200	6.7	0.5	1.0	1.3	136	13	1404	104	1300
10+220	7.0	0.6	1.0	1.3	137	14	1541	118	1423
10+240	5.6	0.9	1.0	1.3	126	20	1667	138	1529
10+260	5.1	1.0	1.0	1.3	107	26	1774	164	1610
10+280	5.0	0.7	1.0	1.3	101	22	18138	186	1689
10+300	4.4	1.0	1.0	1.3	94	22	1969	208	1761
10+320	3.9	2.0	1.0	1.3	83	39	2052	247	1805
10+340	4.1	1.9	1.0	1.3	80	51	2132	298	1834
10+360	5.7	2.8	1.0	1.3	99	62	2231	360	1871
10+380	4.7	5.5	1.0	1.3	105	109	2336	469	1867
10+400	5.2	2.2	1.0	1.3	99	101	2435	571	1864
10+420	5.8	0.9	1.0	1.3	110	40	2545	611	1934
10+440	6.9	0.6	1.0	1.3	128	20	2673	631	2043
10+460	8.3	0.0	1.0	1.3	153	8	2826	638	2188
10+480	10.5	0.0	1.0	1.3	188	0	3014	638	2376
10+500	9.3	0.0	1.0	1.3	198	0	3212	638	2574
10+520	9.3	0.3	1.0	1.3	187	4	3399	642	2757
10+540	8.2	0.9	1.0	1.3	175	16	3574	658	2916
10+560	8.1	0.5	1.0	1.3	163	18	3737	676	3061
10+580	8.4	0.9	1.0	1.3	165	18	3902	694	3208
10+600	8.1	0.6	1.0	1.3	165	20	4067	714	3353
10+620	10.0	1.2	1.0	1.3	181	25	4248	738	3510
10+640	10.9	0.3	1.0	1.3	209	21	4457	759	3698
10+660	11.9	0.2	1.0	1.3	227	7	4684	766	3918
10+680	10.8	0.3	1.0	1.3	227	7	4911	772	4139
10+700	9.9	0.3	1.0	1.3	207	8	5118	780	4338
10+720	9.0	0.4	1.0	1.3	189	9	5307	789	4518
10+740	8.9	1.1	1.0	1.3	179	20	5486	809	4677
10+760	8.2	0.4	1.0	1.3	172	20	5658	828	4830
10+780	10.5	0.0	1.0	1.3	187	5	5845	833	5012
10+800	8.7	1.4	1.0	1.3	192	18	6037	852	5186
10+820	8.4	2.1	1.0	1.3	171	46	6208	897	5311
10+840	8.8	2.8	1.0	1.3	172	64	6380	961	5419
10+860	11.2	0.0	1.0	1.3	200	36	6580	997	5583
10+880	11.9	1.8	1.0	1.3	231	23	6811	1021	5791
10+900	12.7	2.4	1.0	1.3	246	55	7057	1075	5982
10+920	12.2	5.1	1.0	1.3	249	98	7306	1173	6133
10+940	12.4	4.7	1.0	1.3	246	127	7552	1300	6252
10+960	11.8	5.3	1.0	1.3	241	130	7793	1430	6363
10+980	11.2	4.6	1.0	1.3	230	129	8023	1559	6464
11+000	11.1	3.5	1.0	1.3	223	104	8246	1663	6583
11+020	11.8	0.0	1.0	1.3	229	46	8475	1708	6767
11+040	10.4	2.0	1.0	1.3	222	26	8697	1734	6963
11+060	10.6	2.6	1.0	1.3	210	60	8907	1794	7113
11+080	10.8	2.1	1.0	1.3	214	61	9121	1855	7266

STATION	END AREA		FACTORS		VOLUMES		VOLUMES		MASS HAUL
	CUT	FILL	CUT	FILL	CUT	FILL	CUT	FILL	
	(m2)	(m2)			(m3)	(m3)	(m3)	(m3)	(m3)
11+100	12.1	0.4	1.0	1.3	229	31	9350	1886	7464
11+120	13.2	0.3	1.0	1.3	253	9	9603	1895	7708
11+140	14.1	0.1	1.0	1.3	273	7	9876	1902	7974
11+160	14.0	0.1	1.0	1.3	281	3	10157	1905	8253
11+180	13.5	0.1	1.0	1.3	275	3	10432	1907	8525
11+200	14.9	0.0	1.0	1.3	283	1	10715	1908	8807
11+220	13.3	0.2	1.0	1.3	282	3	10997	1911	9086
11+240	12.7	0.4	1.0	1.3	260	7	11257	1918	9340
11+260	11.6	0.6	1.0	1.3	243	13	11500	1931	9570
11+280	8.9	2.1	1.0	1.3	205	36	11705	1967	9738
11+300	5.7	4.4	1.0	1.3	145	86	11850	2053	9797
11+320	4.7	2.6	1.0	1.3	103	91	11953	2144	9809
11+340	3.6	5.8	1.0	1.3	82	111	12035	2254	9781
11+360	3.9	5.3	1.0	1.3	74	144	12109	2399	9711
11+380	4.3	5.7	1.0	1.3	81	143	12190	2542	9649
11+400	5.2	4.2	1.0	1.3	95	129	12285	2670	9615
11+420	6.6	20.2	1.0	1.3	118	319	12403	2989	9414
11+440	10.4	4.5	1.0	1.3	169	321	12572	3310	9262
11+460	5.9	2.0	1.0	1.3	162	85	12734	3394	9340
11+480	7.5	1.0	1.0	1.3	133	39	12867	3433	9434
11+500	8.7	0.3	1.0	1.3	161	17	13028	3450	9578
11+520	9.8	0.1	1.0	1.3	185	5	13213	3455	9758
11+540	11.4	0.2	1.0	1.3	212	4	13425	3459	9966
11+560	12.1	0.5	1.0	1.3	235	9	13660	3468	10192
PROJECT 4994-00-82 CATEGORY 0010									
11+580	12.5	0.0	1.0	1.3	246	7	13906	3475	10431
11+600	11.6	0.1	1.0	1.3	241	1	14147	3476	10671
11+618	10.8	0.3	1.0	1.3	203	4	14350	3480	10870
11+620	10.9	0.3	1.0	1.3	21	1	14371	3481	10890
11+640	11.2	0.5	1.0	1.3	220	10	14591	3492	11099
11+660	11.5	0.6	1.0	1.3	226	14	14817	3506	11311
11+680	11.2	0.9	1.0	1.3	227	20	15044	3526	11518
11+700	11.4	1.1	1.0	1.3	225	26	15269	3552	11717
11+720	11.9	0.7	1.0	1.3	233	22	15502	3574	11928
11+740	13.4	0.3	1.0	1.3	253	13	15755	3587	12168
11+760	14.1	0.2	1.0	1.3	275	7	16030	3593	12437
11+780	13.6	0.4	1.0	1.3	277	8	16307	3601	12706
11+800	13.2	0.4	1.0	1.3	267	10	16574	3611	12963
11+820	12.7	0.5	1.0	1.3	258	12	16832	3623	13209
11+837	12.4	0.7	1.0	1.3	212	13	17044	3636	13408
11+840	12.3	0.7	1.0	1.3	38	3	17082	3639	13443
11+860	12.3	0.4	1.0	1.3	246	16	17328	3654	13674
11+880	12.7	0.2	1.0	1.3	250	8	17578	3662	13916
11+900	13.2	0.1	1.0	1.3	259	4	17837	3666	14171
11+920	13.6	0.2	1.0	1.3	268	4	18105	3670	14435
11+940	14.3	0.1	1.0	1.3	279	3	18384	3673	14712
11+960	15.1	0.1	1.0	1.3	294	3	18678	3675	15003
11+980	15.3	0.1	1.0	1.3	304	3	18982	3678	15304
12+000	15.2	0.1	1.0	1.3	305	3	19287	3680	15607
12+020	14.5	0.2	1.0	1.3	297	4	19584	3684	15900
12+040	13.9	0.3	1.0	1.3	284	5	19868	3689	16179
12+060	13.5	0.5	1.0	1.3	274	10	20142	3700	16442
12+080	12.6	0.4	1.0	1.3	261	12	20403	3712	16692
12+100	11.2	0.3	1.0	1.3	238	9	20641	3721	16920
12+120	10.7	0.6	1.0	1.3	219	13	20860	3734	17126
12+140	10.6	0.5	1.0	1.3	213	14	21073	3748	17325
12+160	11.1	0.4	1.0	1.3	217	12	21290	3760	17530
12+180	12.3	0.2	1.0	1.3	234	8	21524	3767	17757
12+200	14.0	0.0	1.0	1.3	263	3	21787	3770	18017
12+220	14.9	0.0	1.0	1.3	290	0	22077	3770	18307

STATION	END AREA		FACTORS		VOLUMES		VOLUMES		MASS HAUL
	CUT	FILL	CUT	FILL	CUT	FILL	CUT	FILL	
	(m2)	(m2)			(m3)	(m3)	(m3)	(m3)	(m3)
12+240	12.9	0.0	1.0	1.3	279	0	22356	3770	18586
12+260	11.4	0.1	1.0	1.3	243	1	22599	3771	18828
12+280	11.4	0.1	1.0	1.3	229	3	22828	3774	19054
12+300	10.0	0.3	1.0	1.3	215	5	23		

GB2
 PEN TABLE = splo1721dger-amhd1fx.tbl
 DATE OF PLOT = 11/24/99
 PLOT NAME = P:\LASER\A1R000001001.PRF
 DGN FILE = I:\440278\dgn\ysec\rc0001001.dgn

ORIGINATOR:
 LEVELS ON = 1, 2, 3, 61, 62.

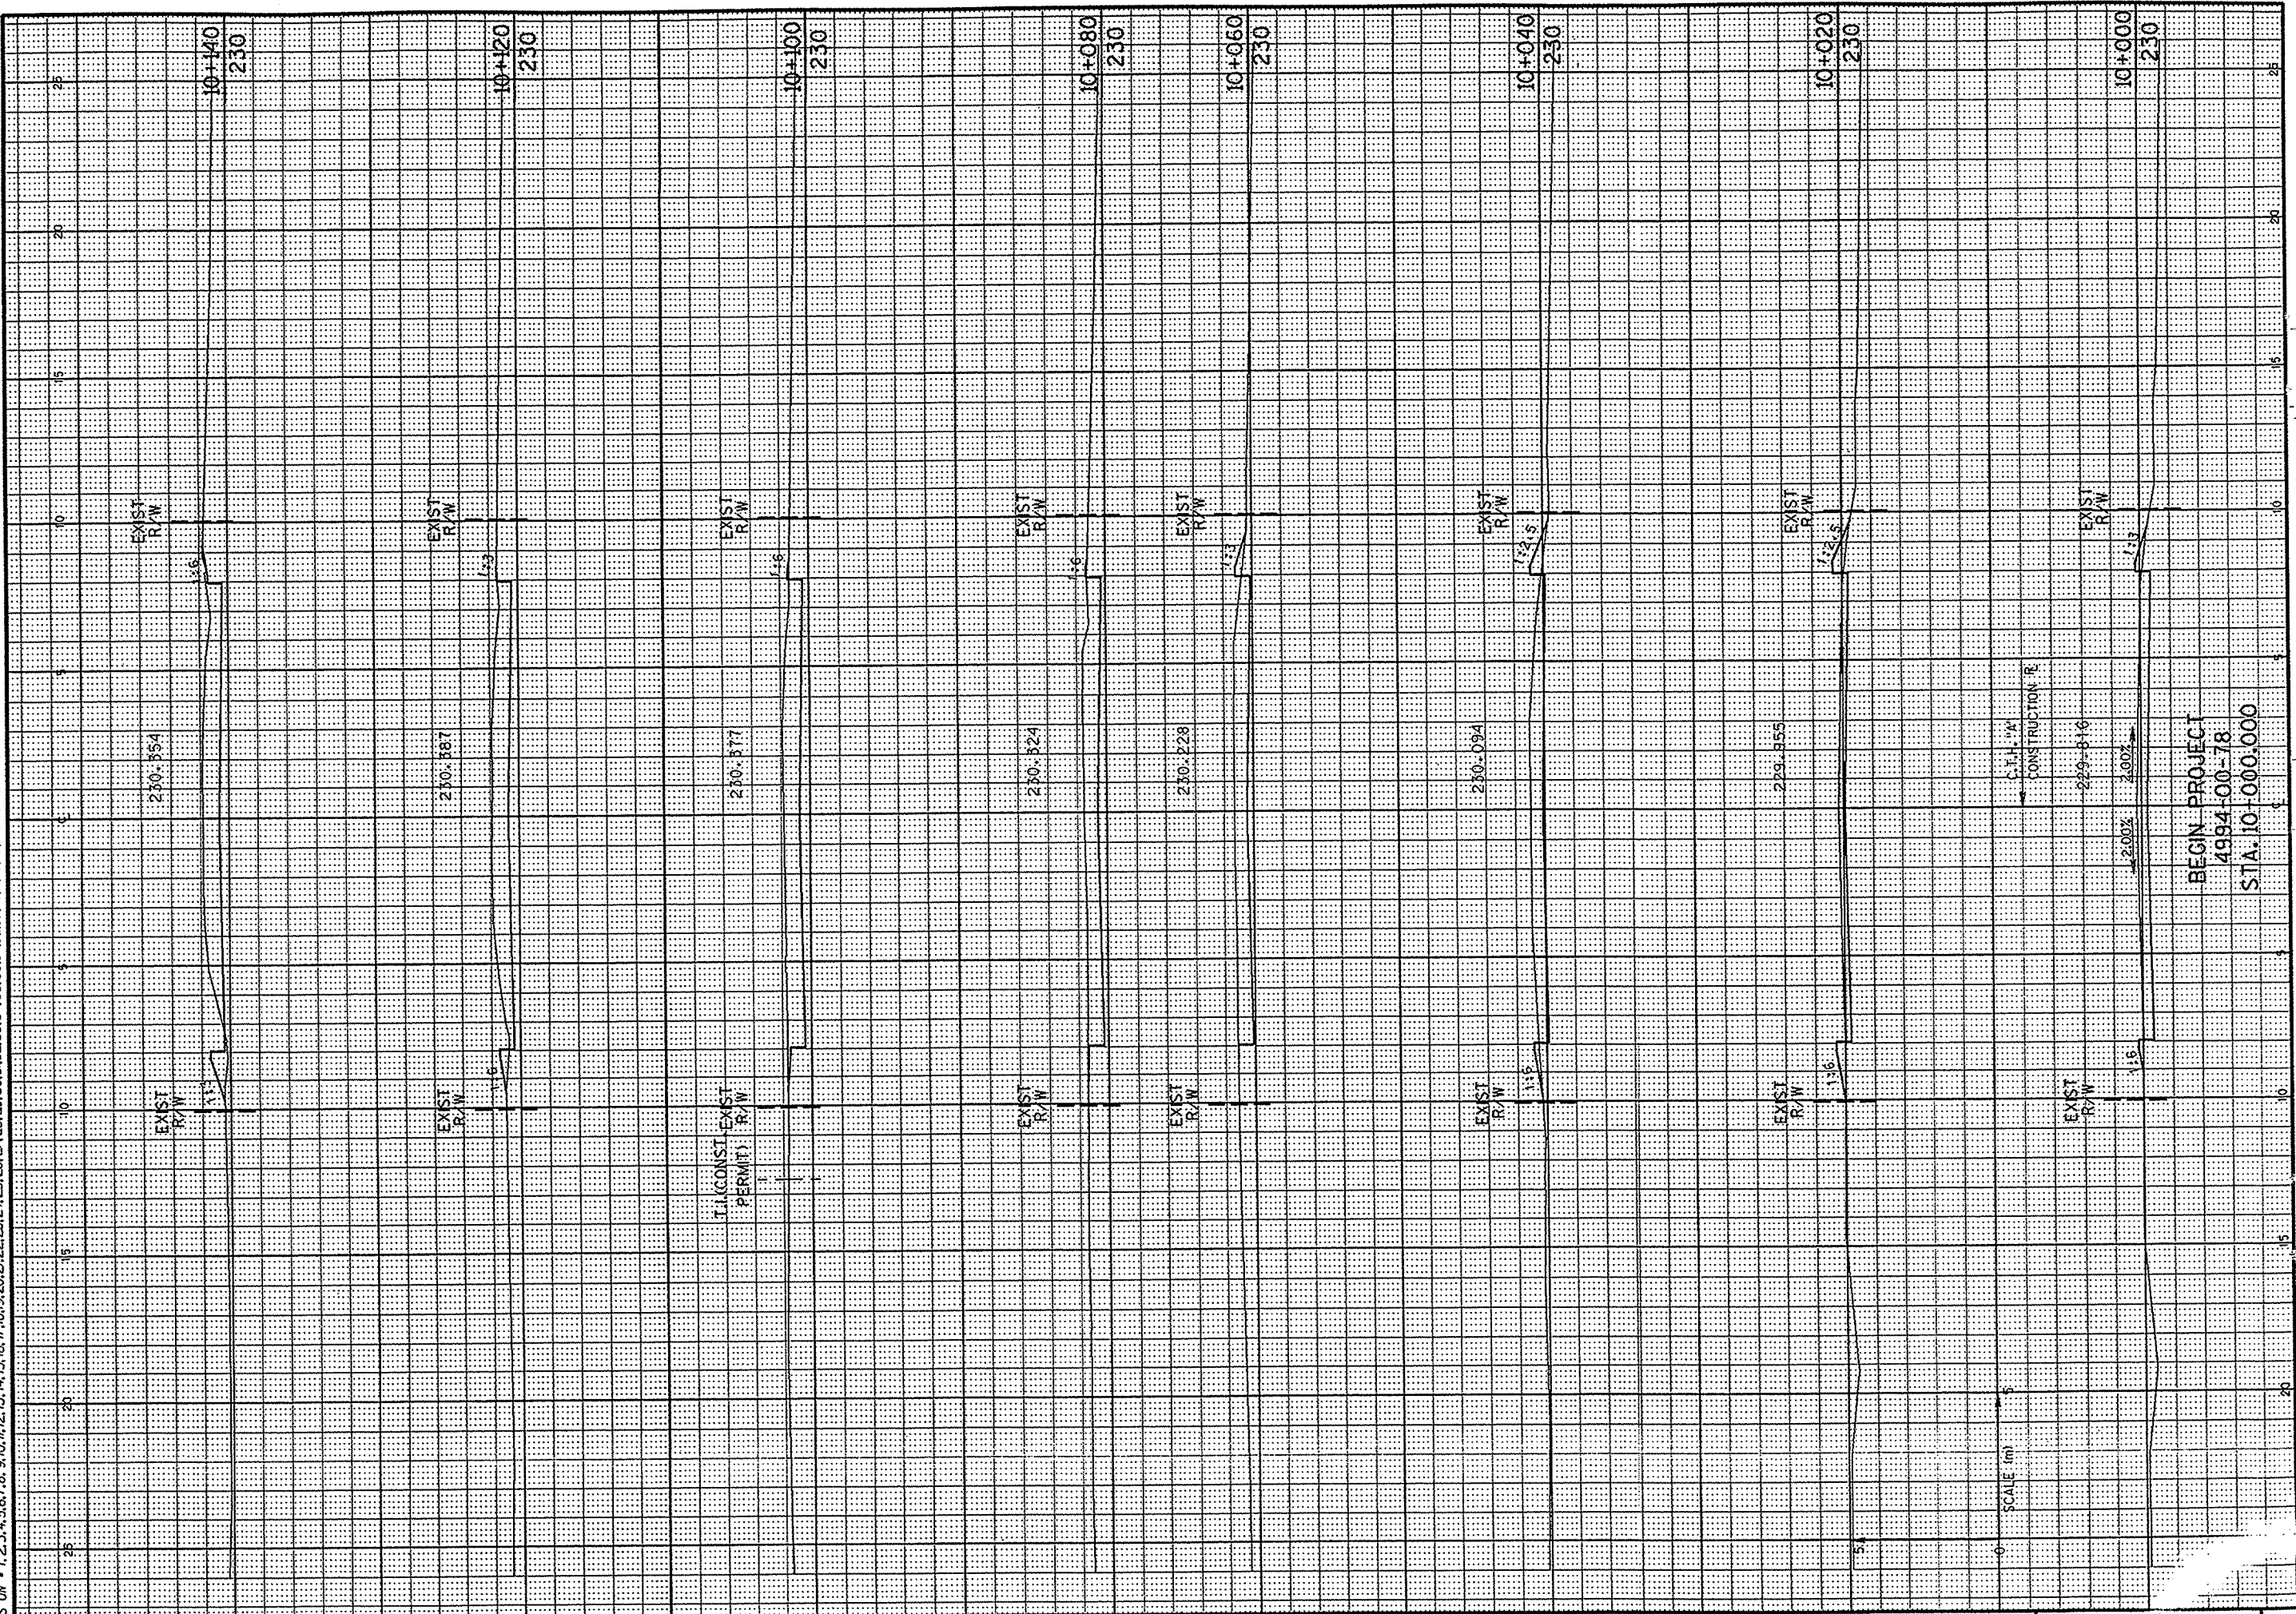

CROSS SECTION

HWY: C.T.H. "A"

COUNTY: WINNEBAGO

STATE PROJECT NO: 4994-00-78

SHEET NO: 9.2


M

FILE NAME:

WIDOT: MSH7

GB2
 PEN TABLE = #plot72\user\mhof\fxs.tbl
 DATE OF PLOT 11/24/98
 PLOT NAME = P:\LASERA3\RC002001\PRF
 DGN FILE = I:\440278\dgn\ysec\rc002001.dgn

ORIGINATOR:
 LEVELS ON = 1, 2, 3, 61, 62.

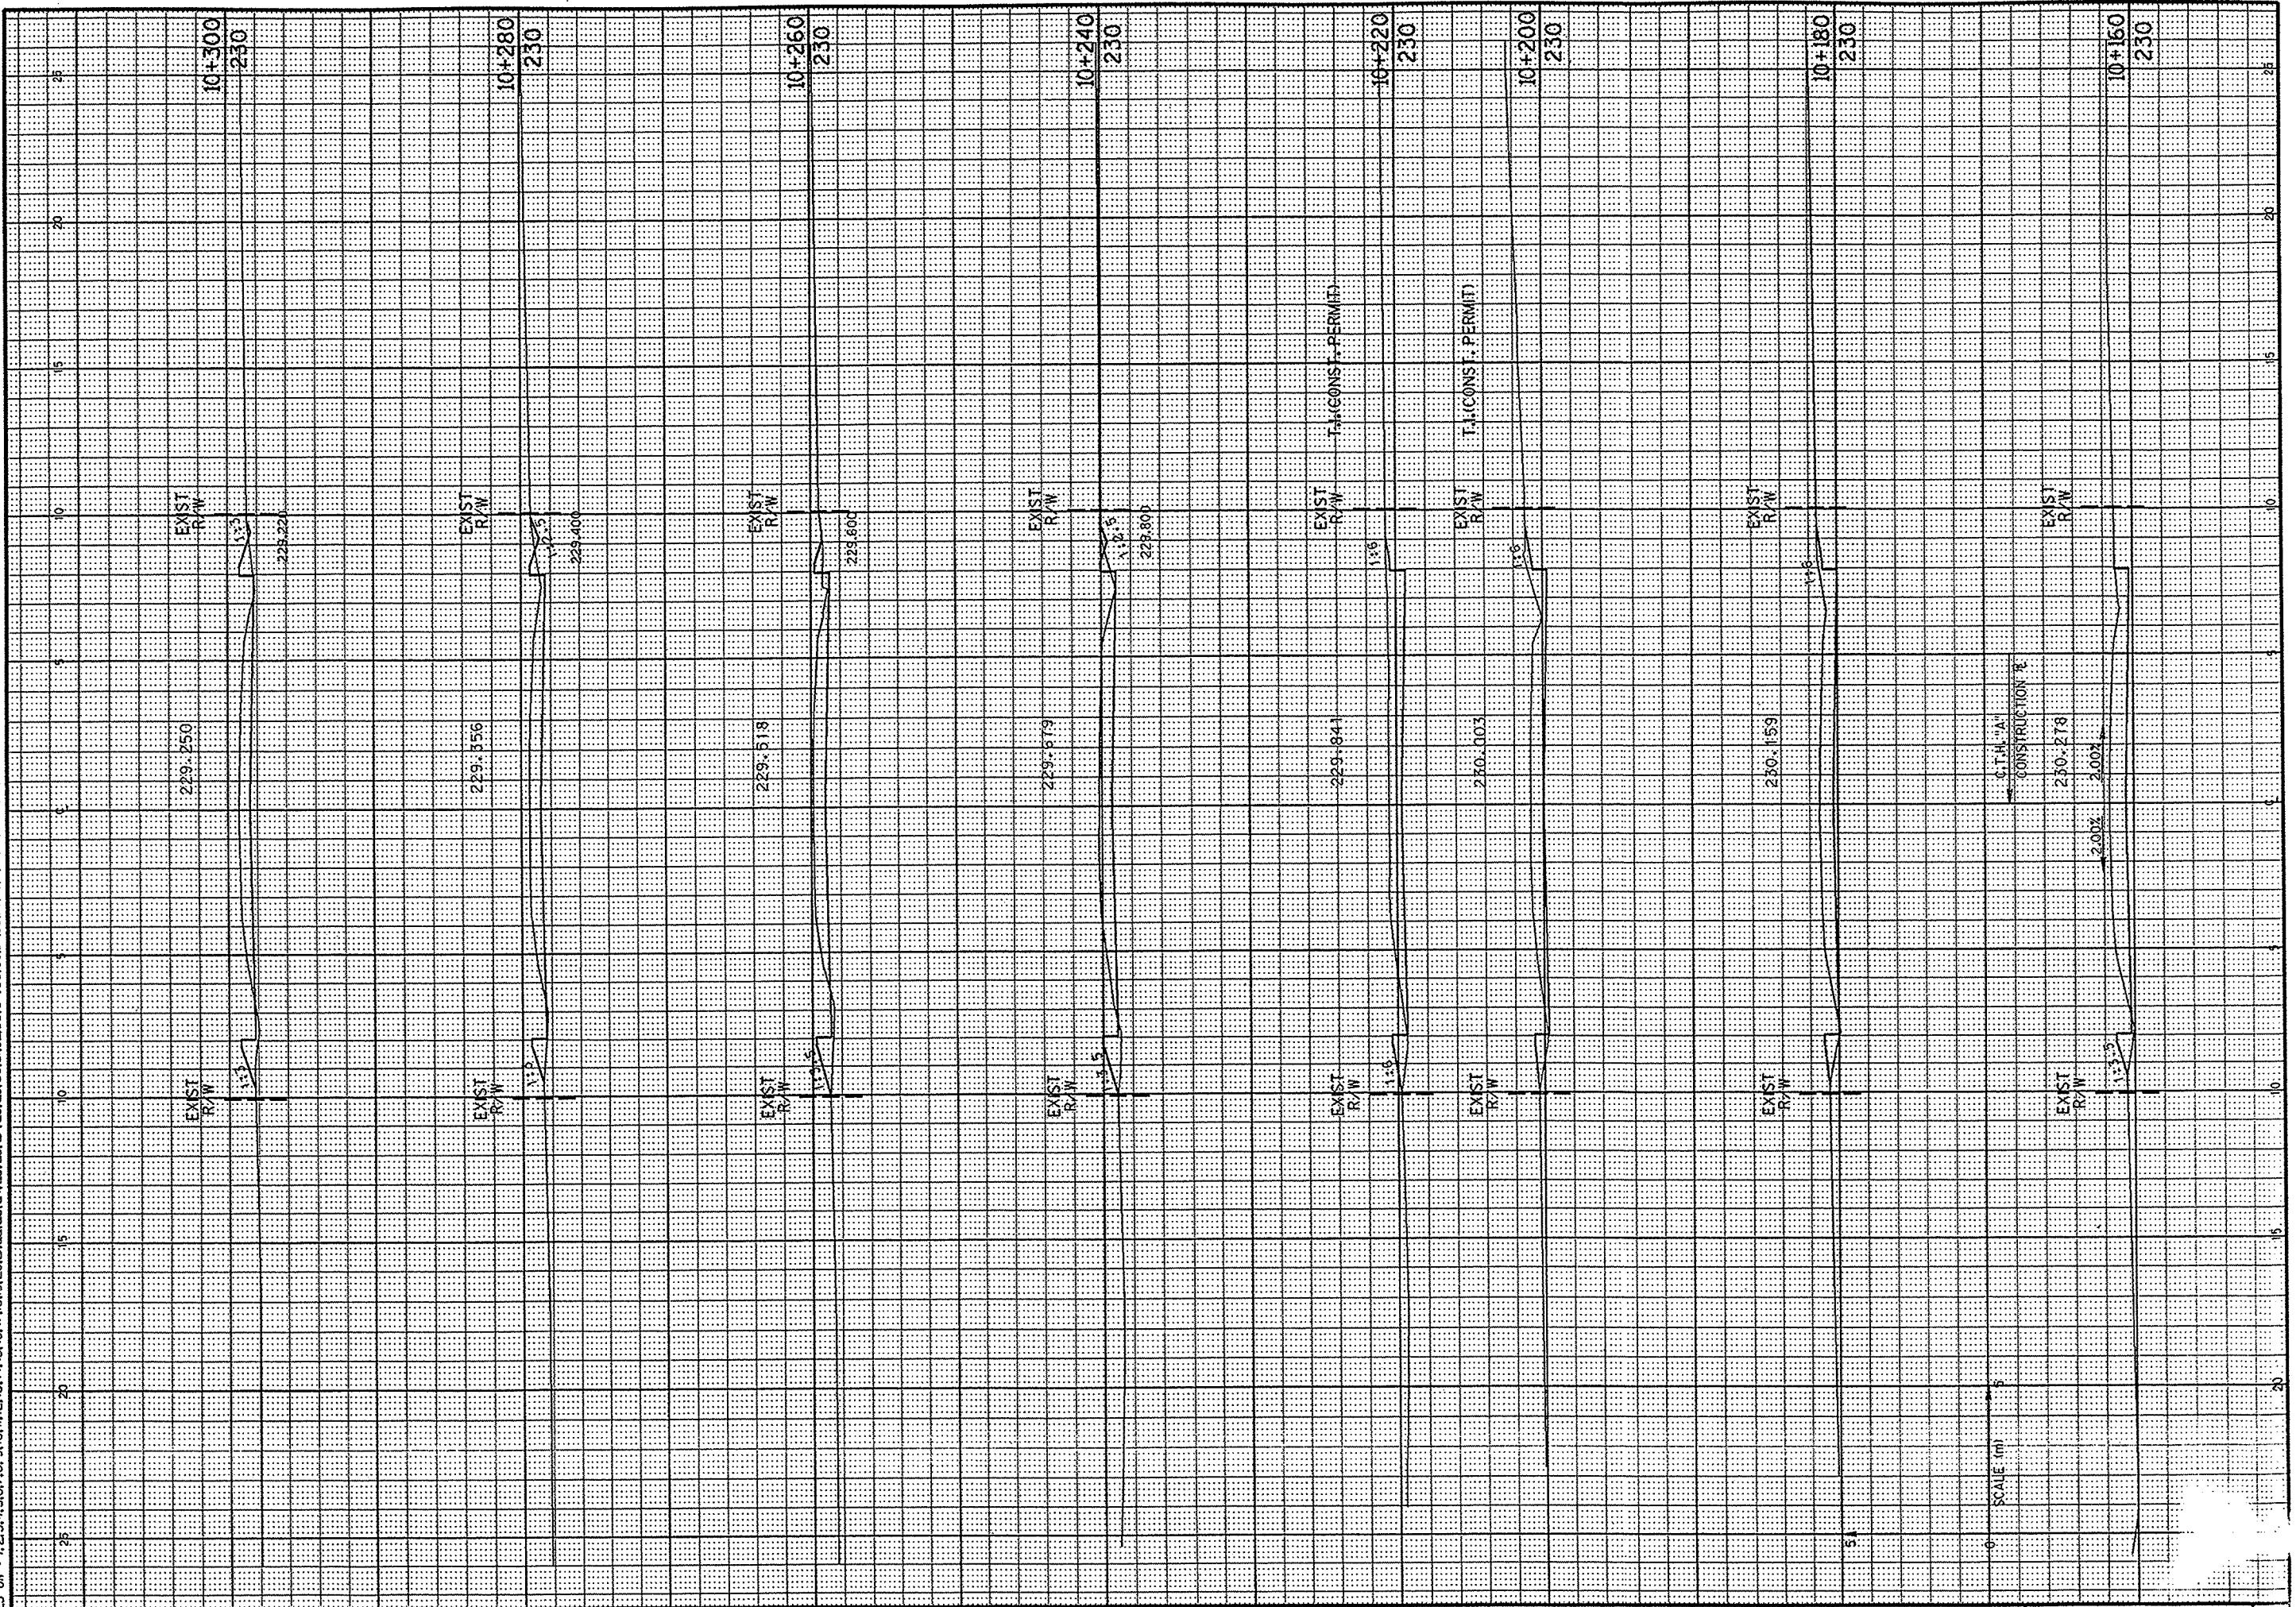

CROSS SECTION

HWY: C.T.H. "A"

COUNTY: WINNEBAGO


STATE PROJECT NO: 4994-00-78

SHEET NO: 9.3

FILE NAME:

GB2
 PEN TABLE = #plot724\user\mholf\ss.tbl
 DATE OF PLOT = 11/24/98
 PLOT NAME = P:\LASER\31\RC00\001\PRF
 DGN FILE = P:\440278\dgn\sssec\rc00\001.dgn

ORIGINATOR:
 LEVELS ON = 1, 2, 3, 61, 62

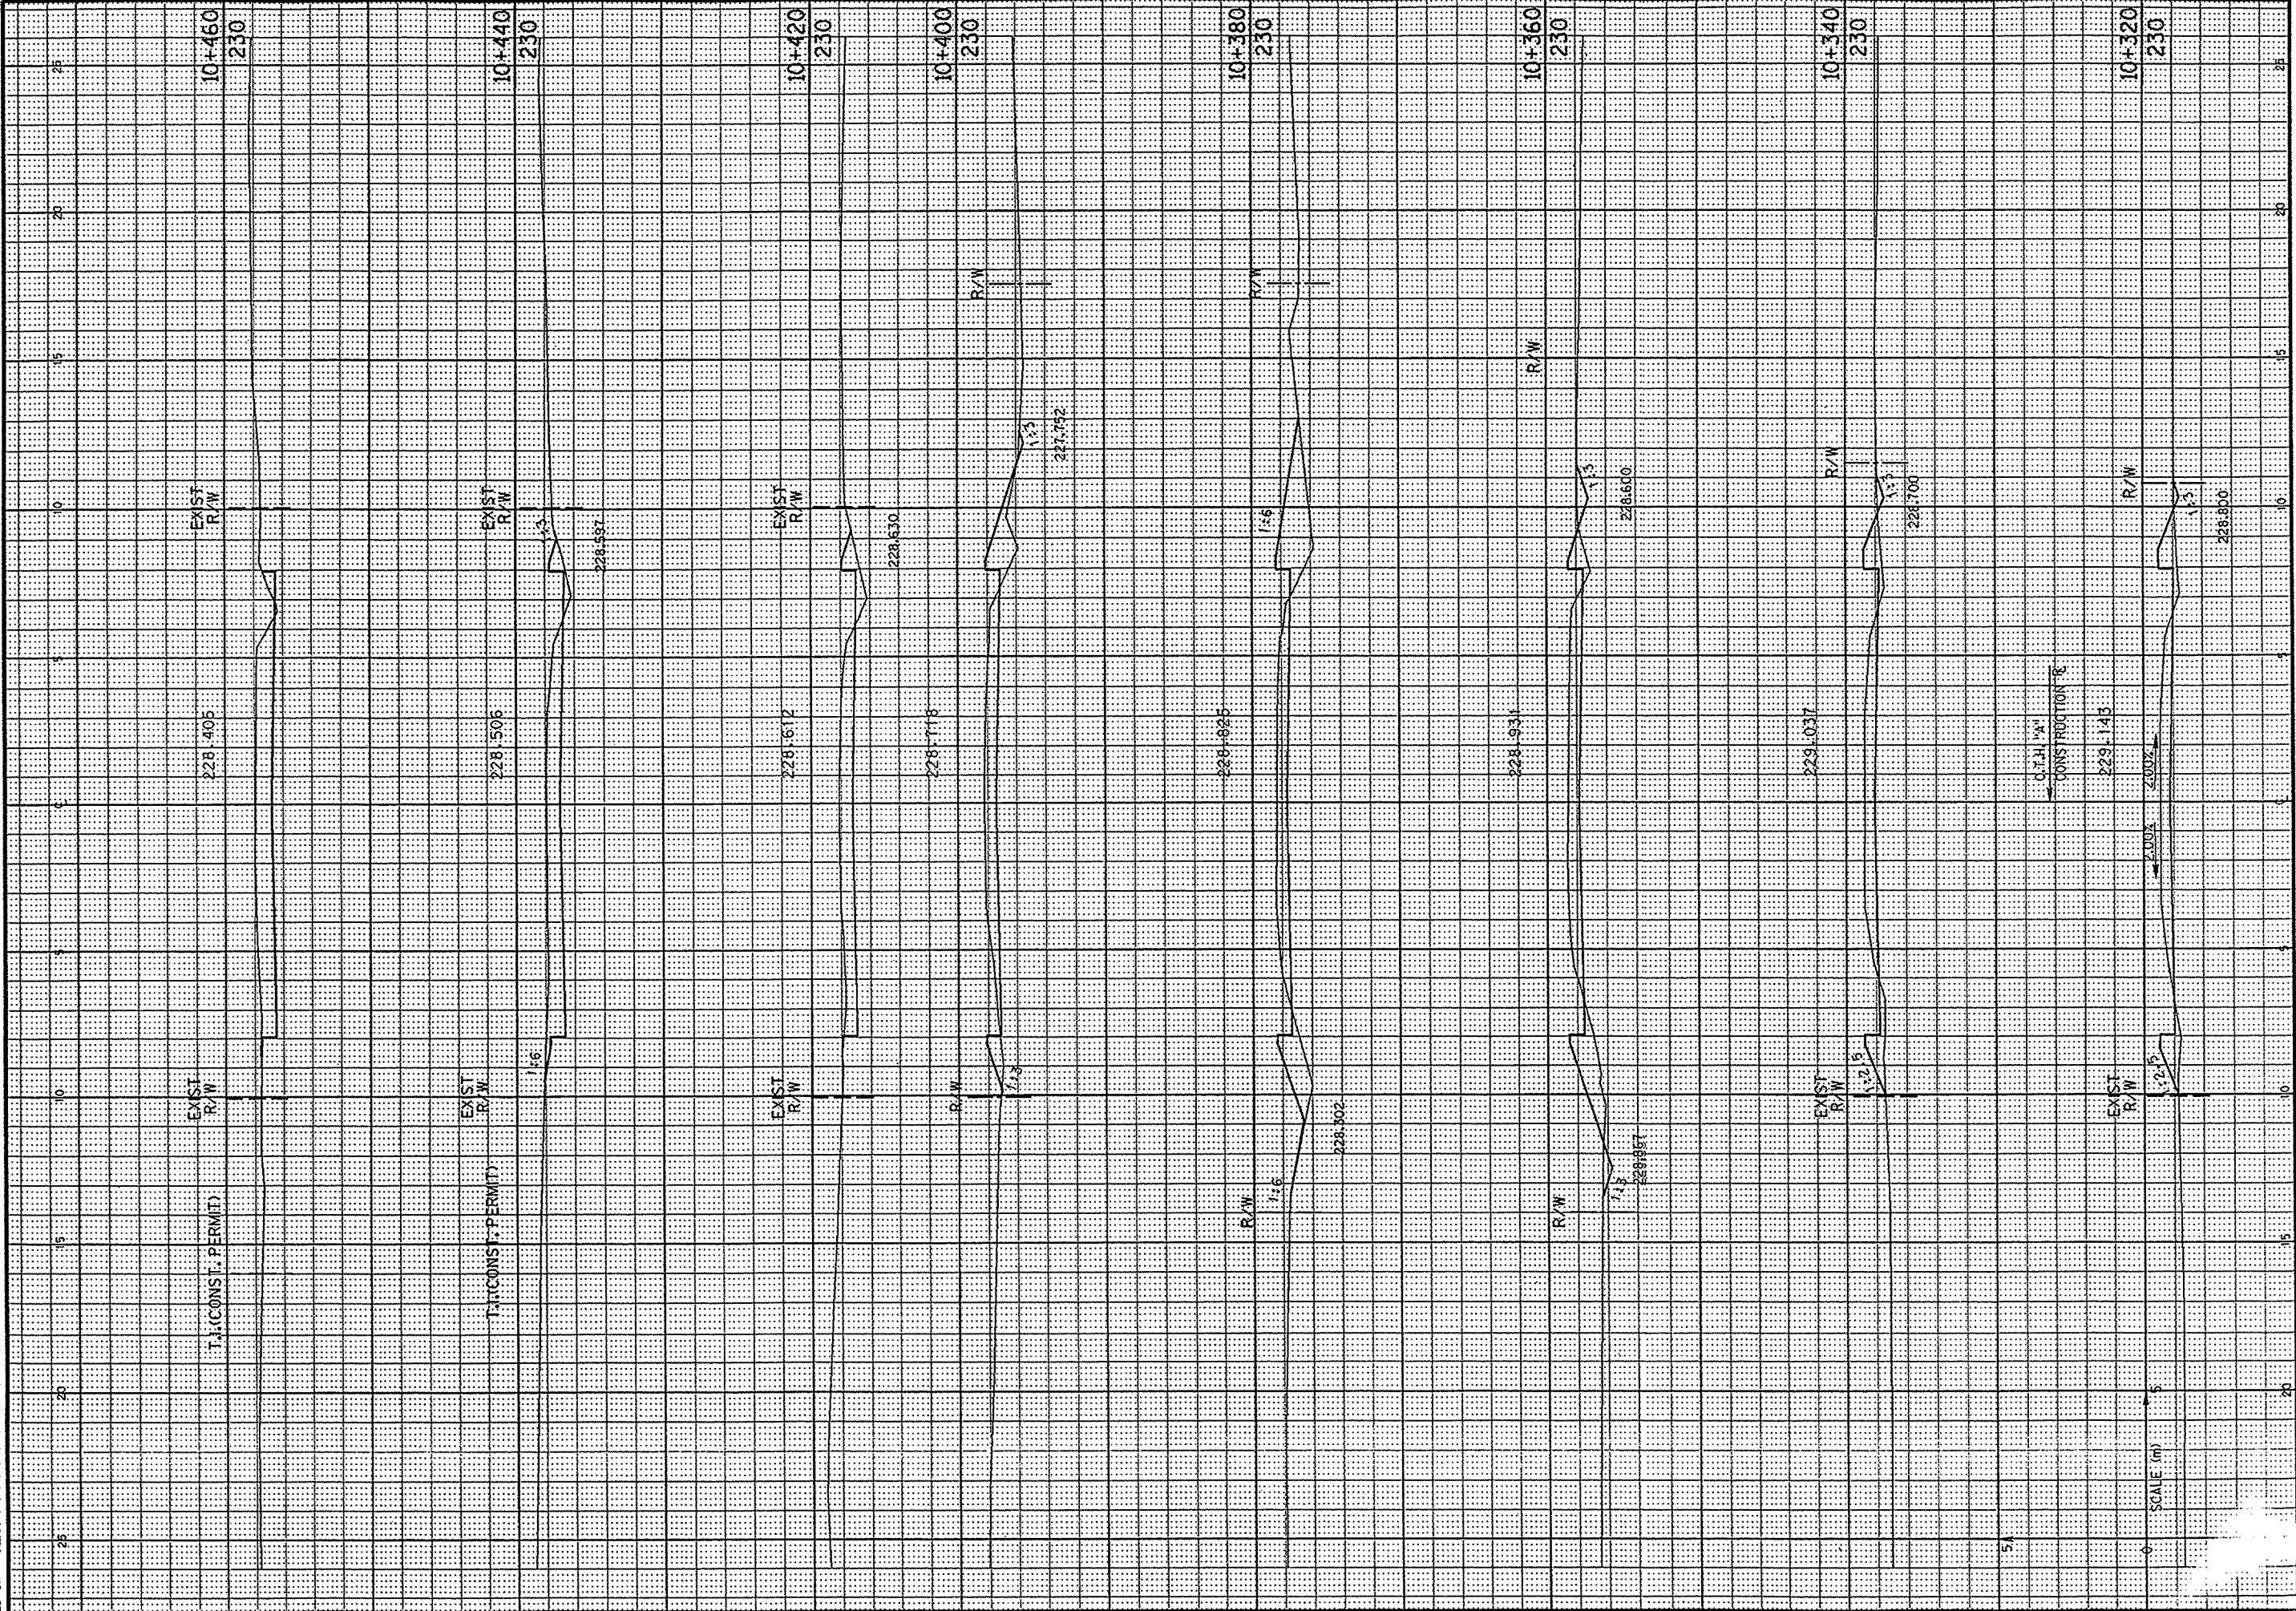

CROSS SECTION

HWY: C.T.H. "A"

COUNTY: WINNEBAGO

STATE PROJECT NO: 4994-00-78


SHEET NO: 9.4

FILE NAME:

WINNEBAGO

GB2 TABLE = #010721050r-amholfxs.tbl
 DATE OF PLOT = 11/24/98
 PLOT NAME = P:\LASER\3\RC004001.PRF
 DGN FILE = I:\440278\5gn\sscc\rc004001.dgn

ORIGINATOR:
 LEVELS ON = 1, 2, 3, 61, 62

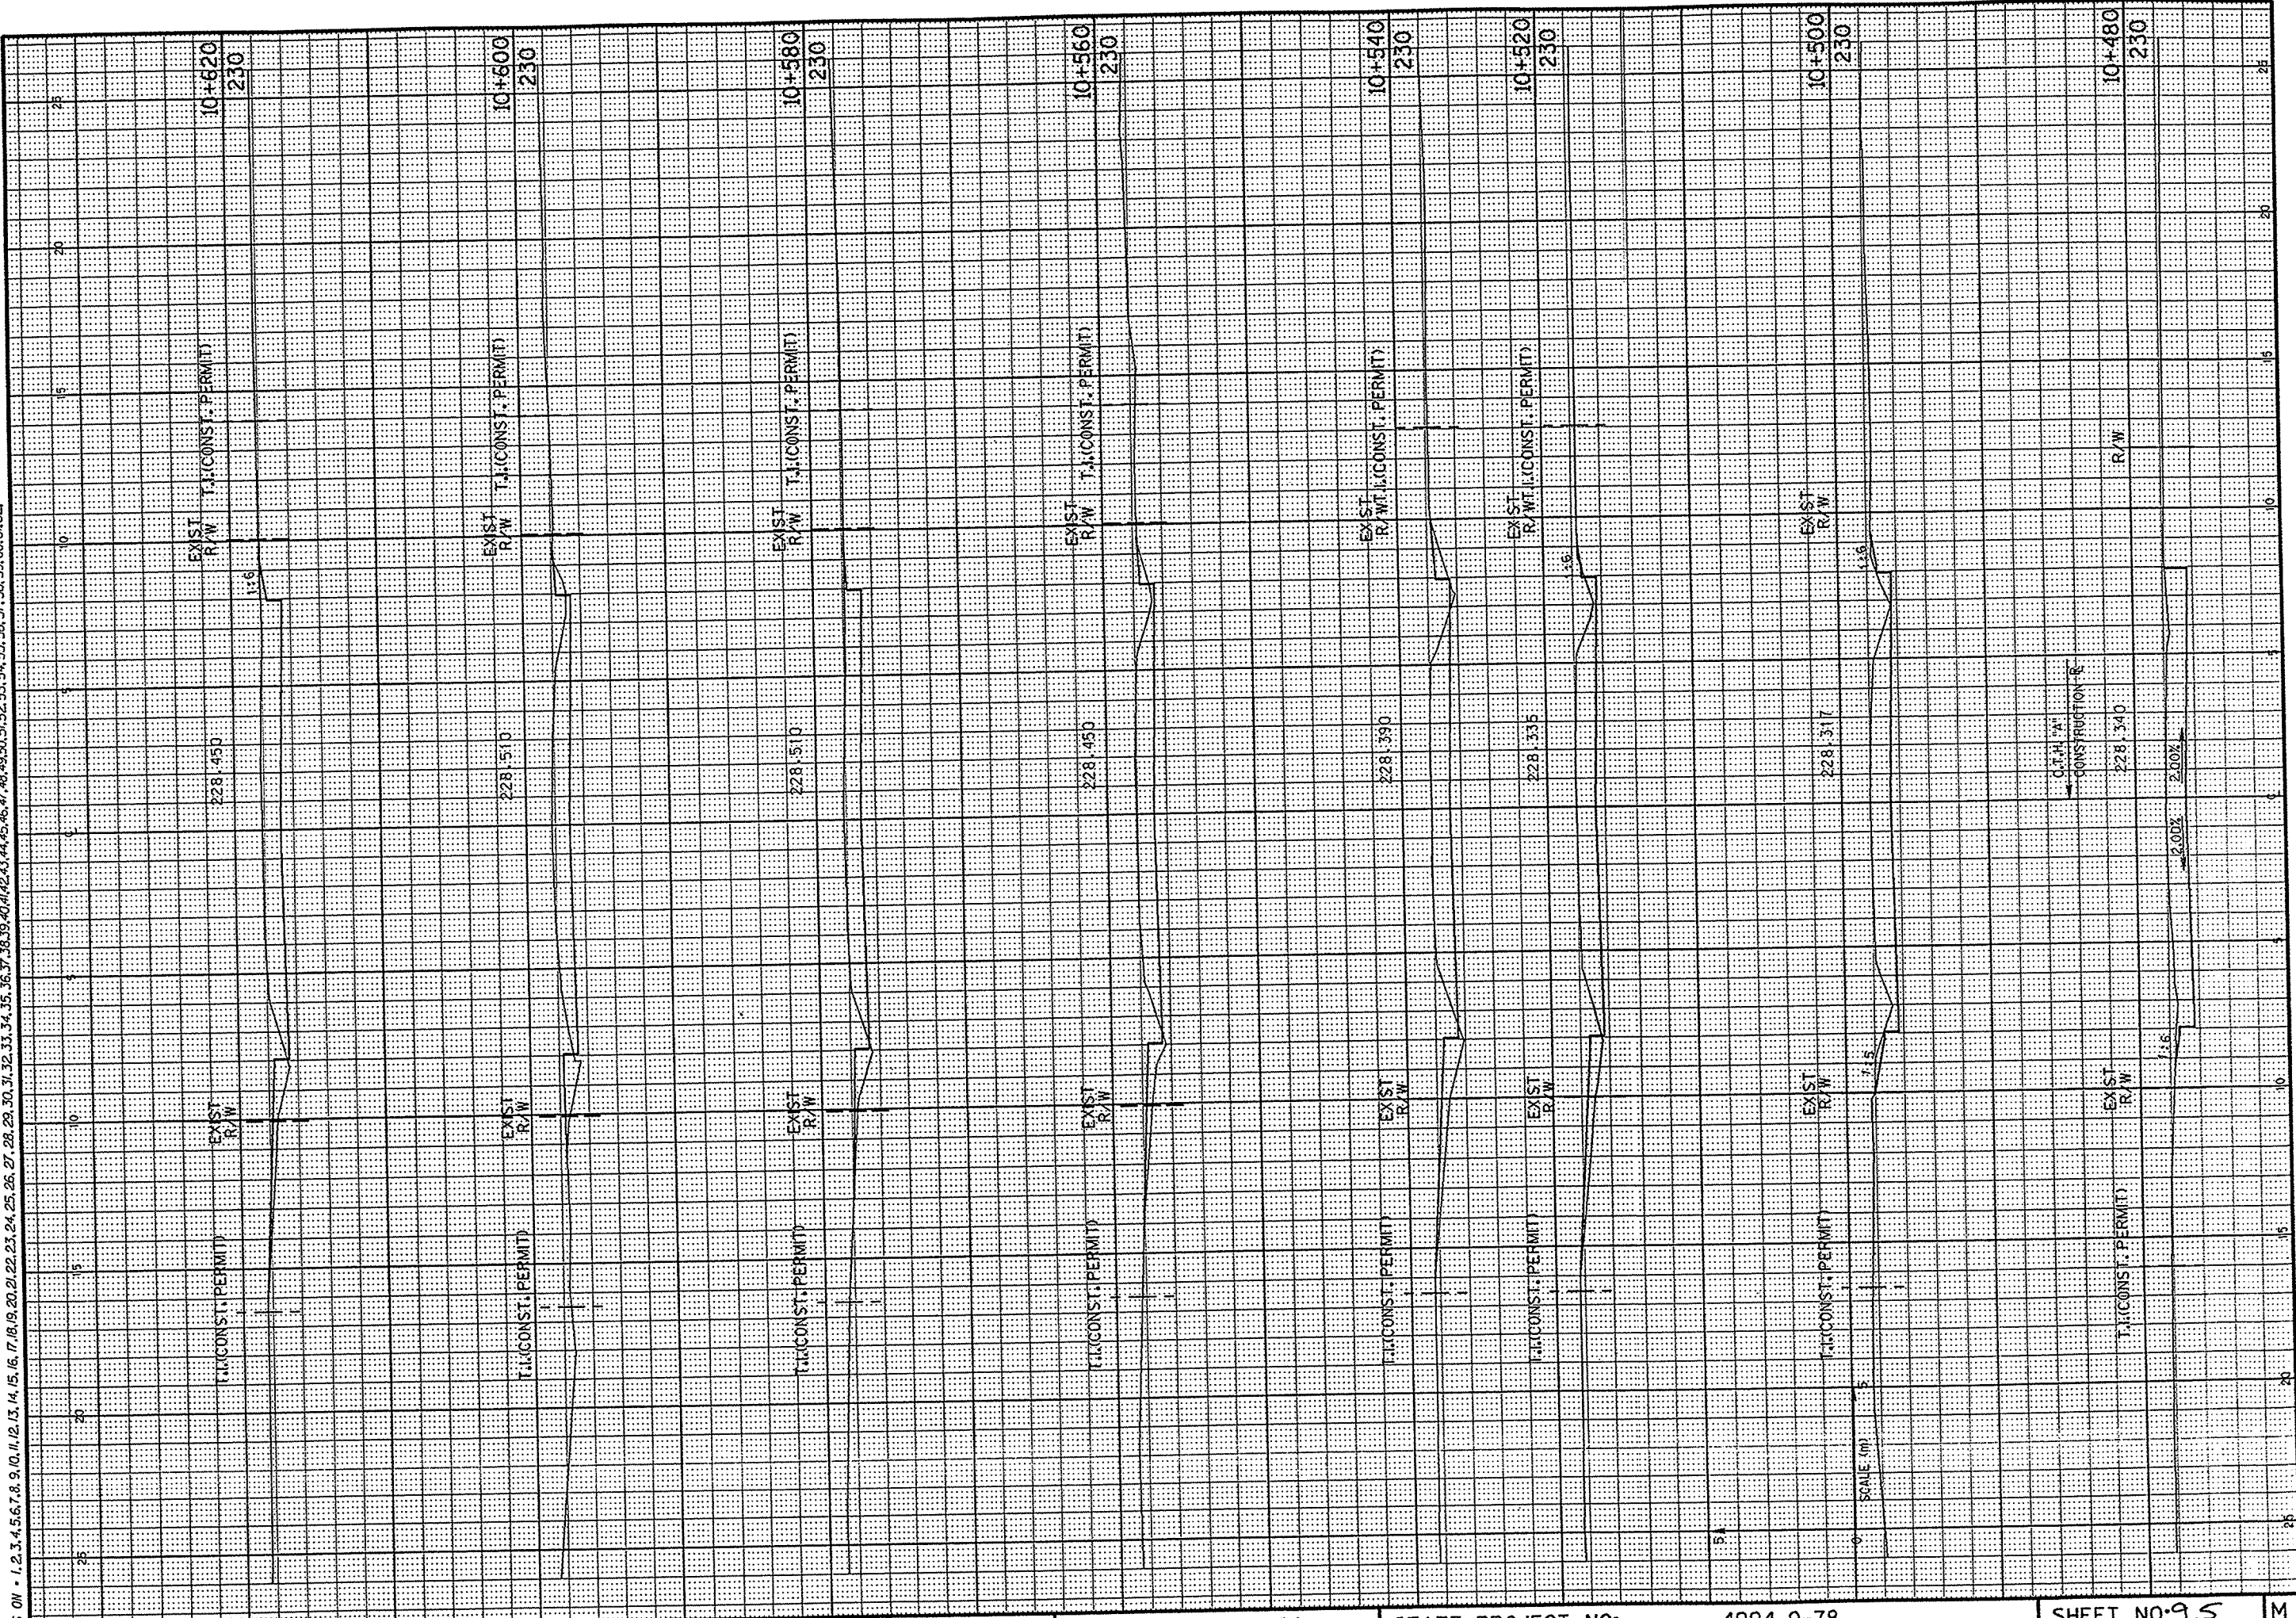

CROSS SECTION

HWY: C.T.H. "A"

COUNTY: WINNEBAGO

STATE PROJECT NO:

4994-0-78

SHEET NO: 9.5


M

FILE NAME:

W:\DOT: MSHT21

CB2
 REV. TABLE = #plot724cser-tnhd1fxs.tbl
 DATE OF PLOT = 11/24/98
 PLOT NAME = P:\L\SERV3\F0005001.PRF
 DGN FILE = I:\440278\dgn\3acc\rc005001.dgn

ORIGINATOR:
 LEVELS ON = 1, 2, 3, 61, 62

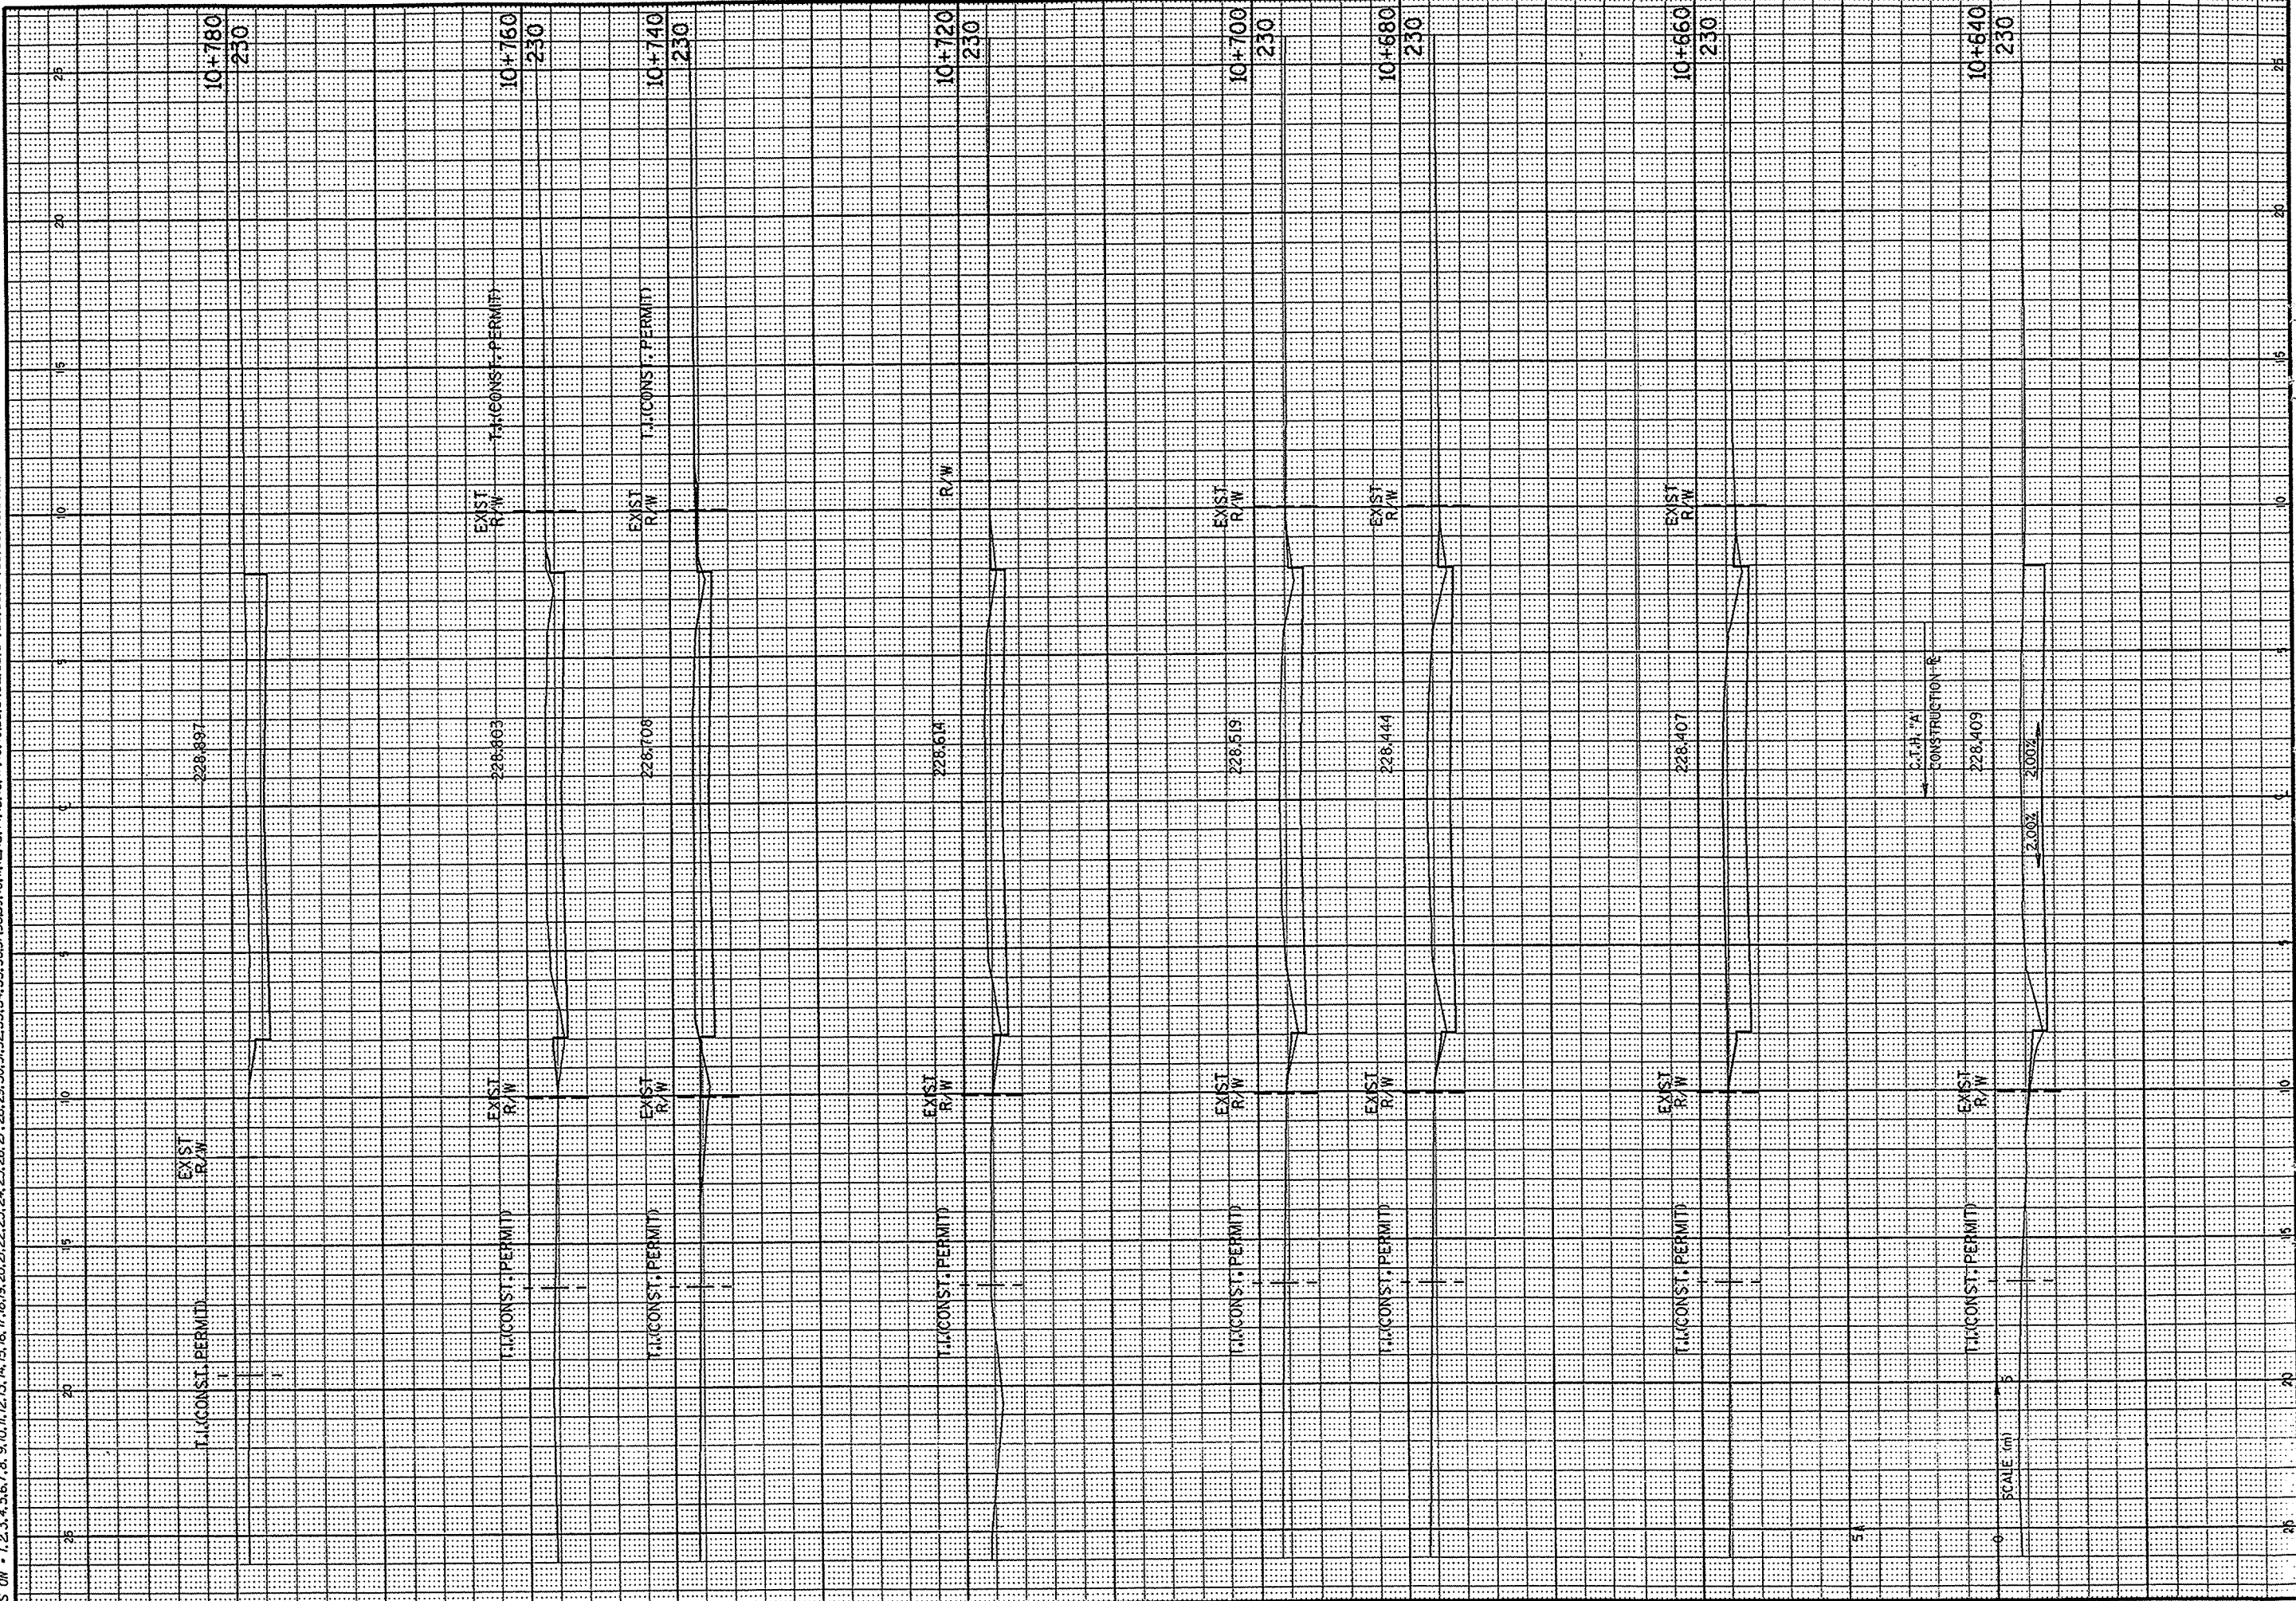

CROSS SECTION

HWY: C.T.H. "A"

COUNTY: WINNEBAGO

STATE PROJECT NO: 4994-00-78

SHEET NO: 9.6


M

FILE NAME:

WI6DOT: MSHT21

GB2
 PEN TABLE = #plot723user=hhofas.tbl
 DATE OF PLOT = 11/24/98
 PLOT NAME = P:\LASERA\3R000600\PRF
 DGN FILE = P:\440278\1.dgn\ysec\16000001.dgn

ORIGINATOR:
 LEVELS ON = 1, 2, 3, 61, 62.

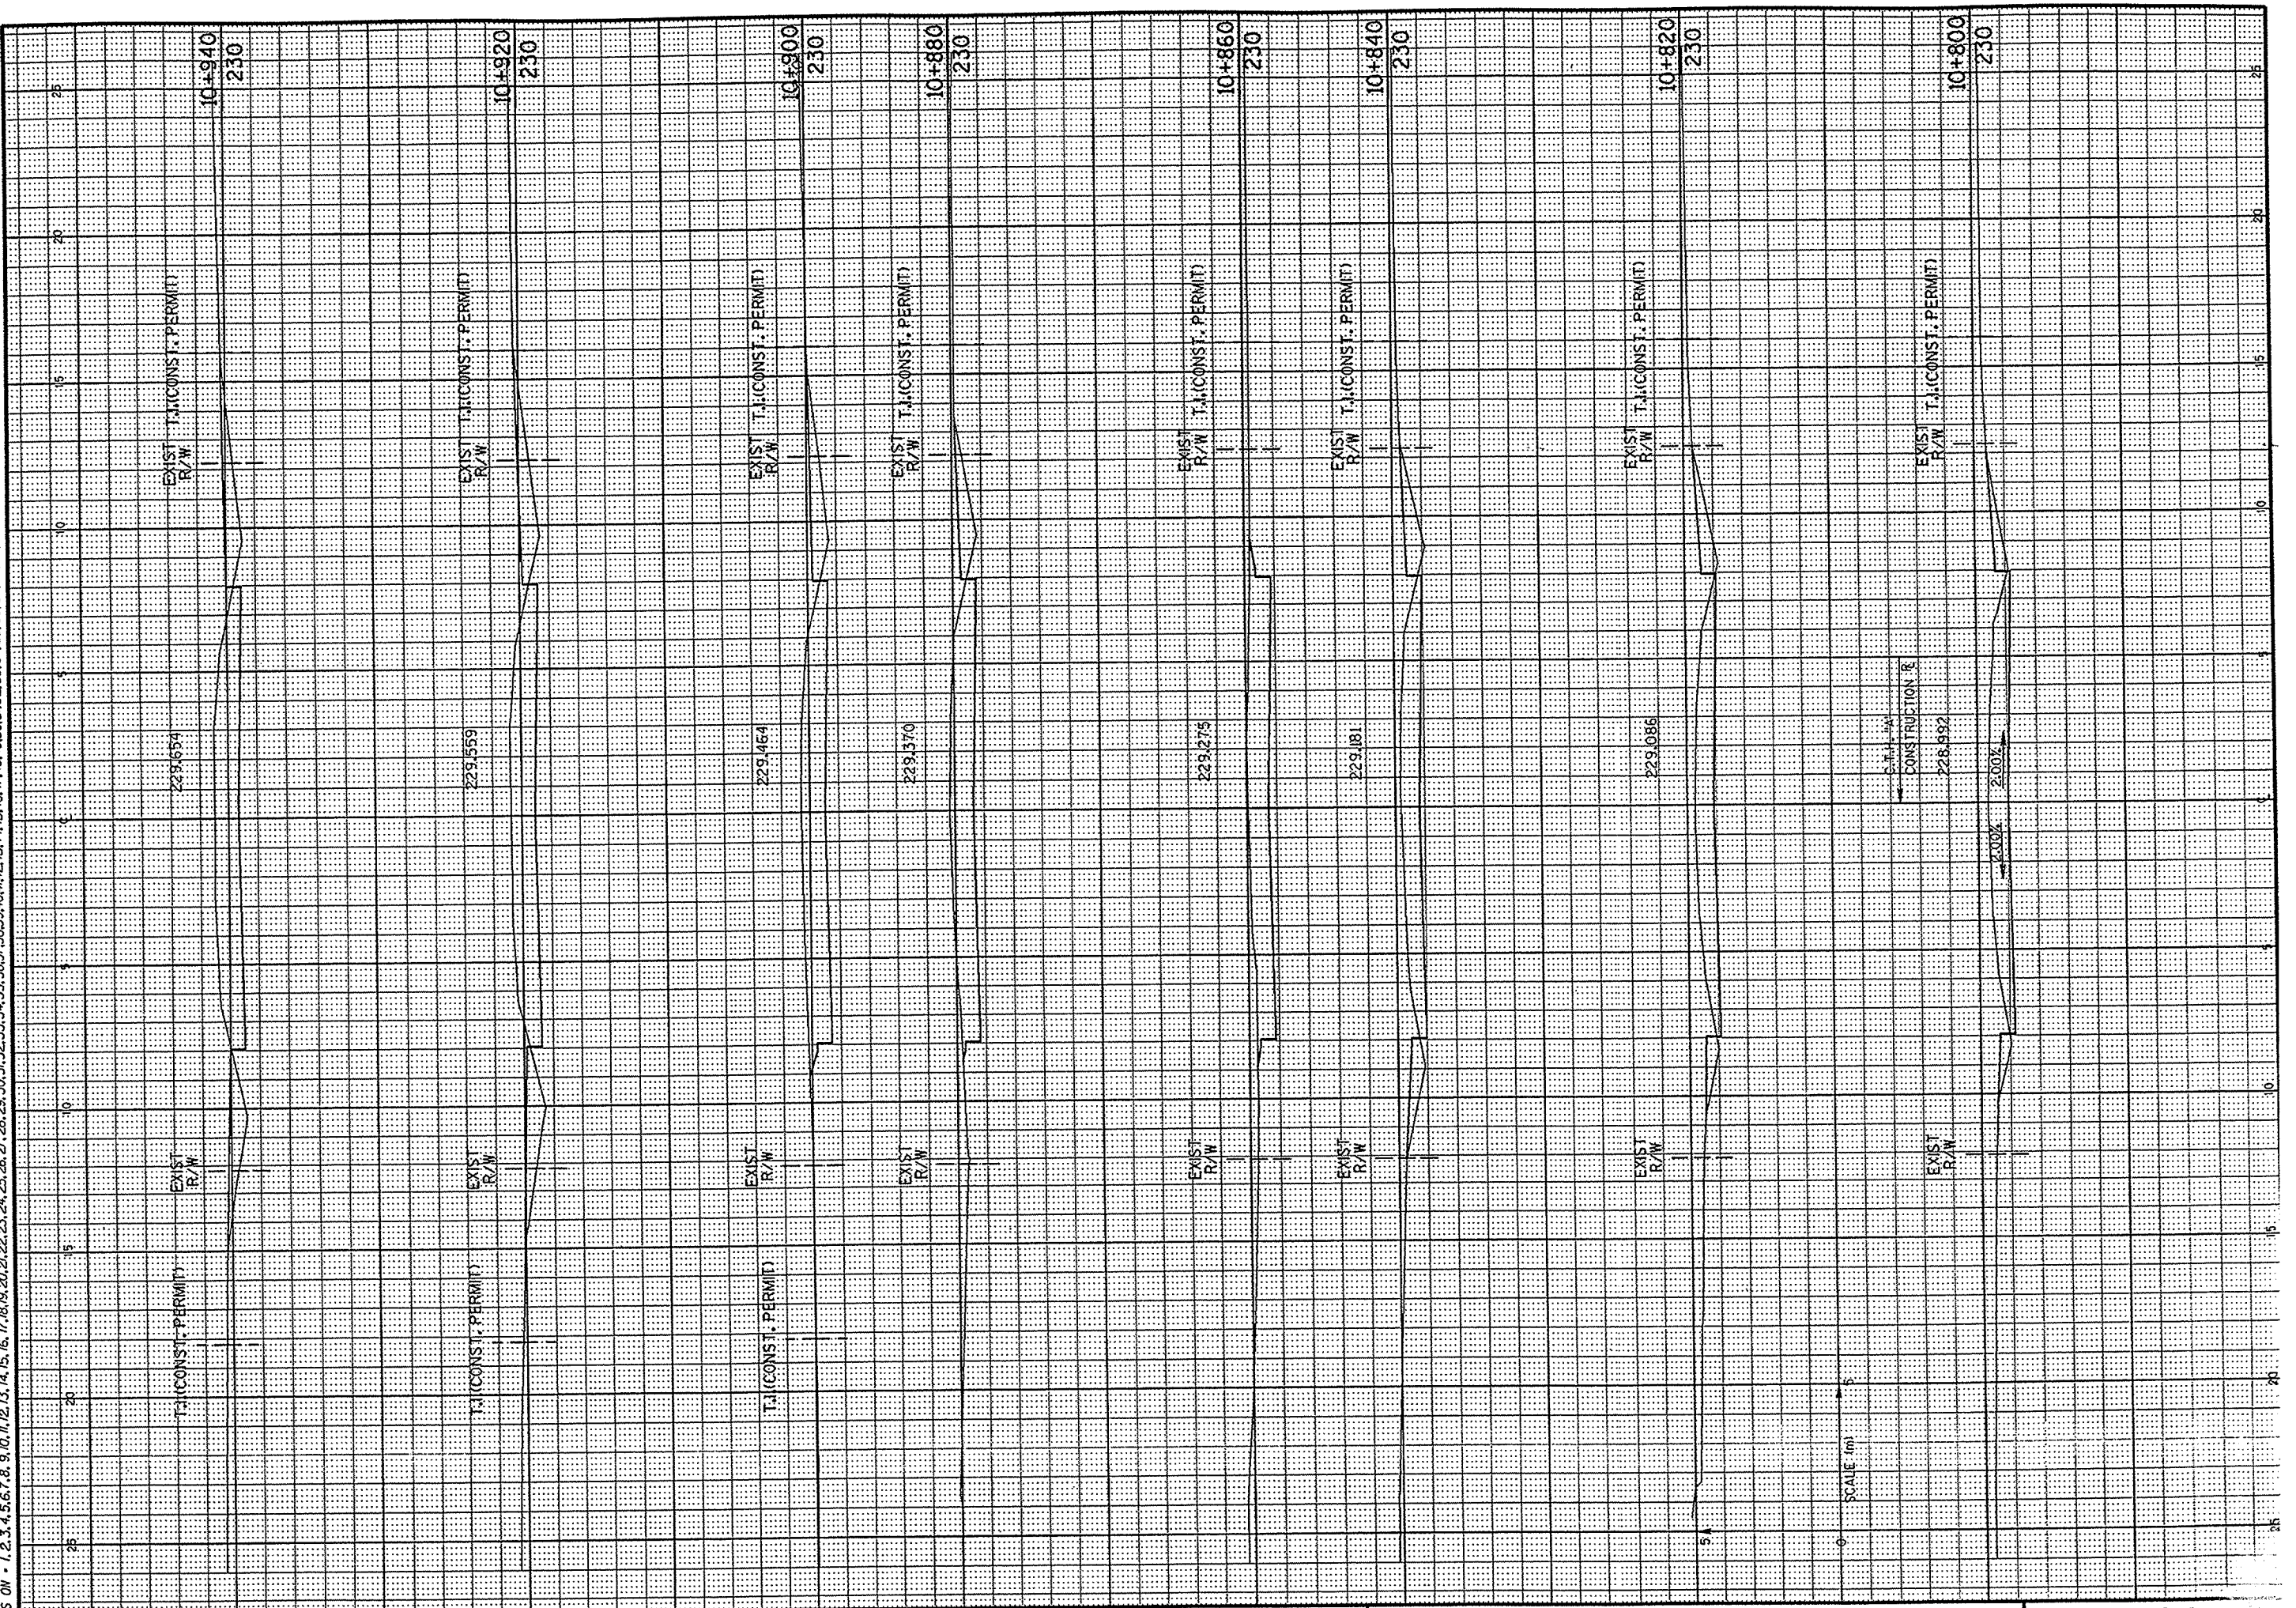

CROSS SECTION

HWY: C.T.H. "A"

COUNTY: WINNEBAGO

STATE PROJECT NO: 4994-00-78


SHEET NO: 9.7

FILE NAME:

WIDBOT.PLOT2

GB2
 PEN TABLE = p:\plot72\hoseer\mhdf\vs.tbl
 DATE OF PLOT = 11/24/96
 PLOT NAME = P:\LASERA\3ARC000700.LPRF
 DGN FILE = I:\440278\dgn\vscc vc007001.dgn

ORIGINATOR:
 LEVELS ON = 1, 2, 3, 61, 62.

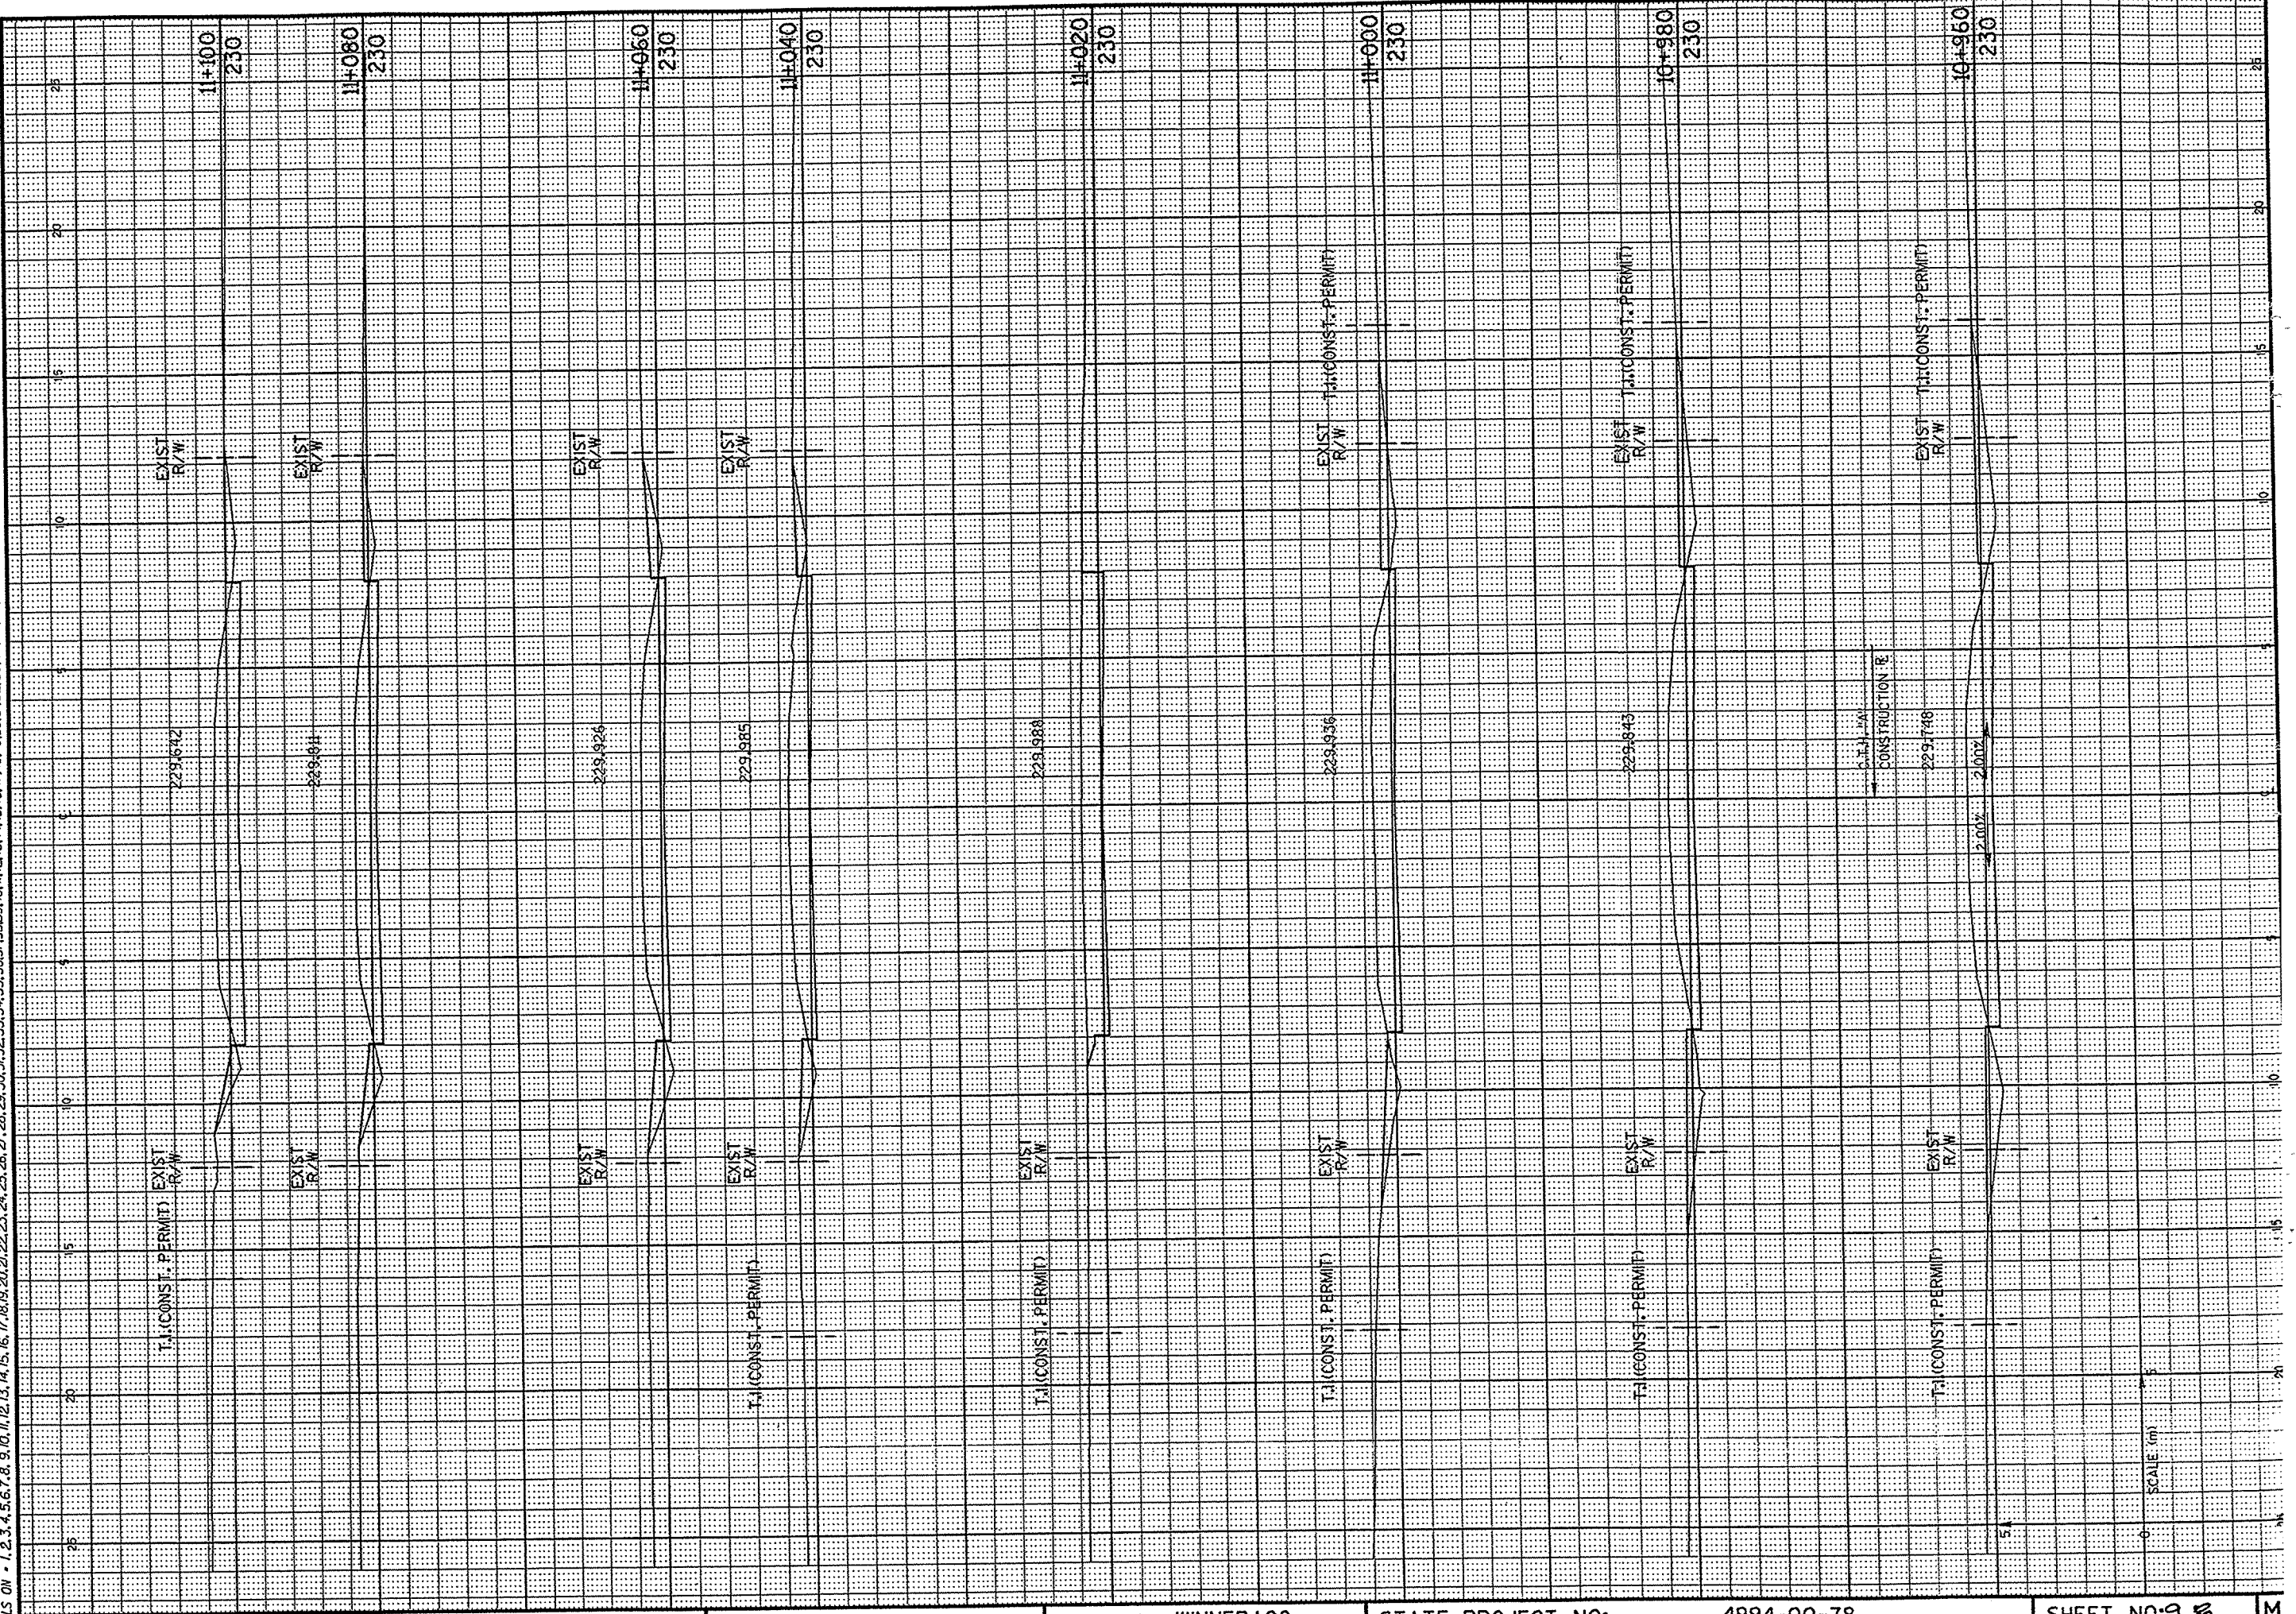

CROSS SECTION

HWY: C.T.H. "A"

COUNTY: WINNEBAGO

STATE PROJECT NO:

4994-00-78

SHEET NO: 9.8

M

FILE NAME:

WEDOT: MSHT

CB2
 PEN TABLE = splot1724user-embhdifxs.tbl
 DATE OF PLOT = 11/24/98
 PLOT NAME = P:\H\ASER3\RC008001.PRF
 DGN FILE = I:\40278\dgn\asec\rc008001.dgn

ORIGINATOR:
 LEVELS ON = 1, 2, 3, 61, 62



CROSS SECTION

HWY: C.T.H. "A"

COUNTY: WINNEBAGO

STATE PROJECT NO: 4994-00-78

SHEET NO: 99

M

FILE NAME:

WLEDOT: MSHT21

GBZ
 PEN TABLE = *plot72iuser-1mhalfxs.tbl
 DATE OF PLOT 11/24/98
 PLOT NAME = P:\LASERA3\RC009001.PRF
 DGN FILE = \440278.dgn\sec\rc009001.dgn

ORIGINATOR:
 LEVELS ON = 1, 2, 3, 61, 62



CROSS SECTION

HWY: C.T.H. "A"

COUNTY: WINNEBAGO

STATE PROJECT NO: 4994-00-78

SHEET NO: 9.10


M

FILE NAME:

WISDOT: MSHT21

GB2
 PEN TABLE = p:\plot72\user\mhalf\ks.tbl
 DATE OF PLOT = 11/25/98
 PLOT NAME = P:\LASERA3\RC00001\PRF
 DGN FILE = P:\440278\dgn\ksec\rc00001.dgn

ORIGINATOR:
 LEVELS ON = 1, 2, 3, 61, 62.

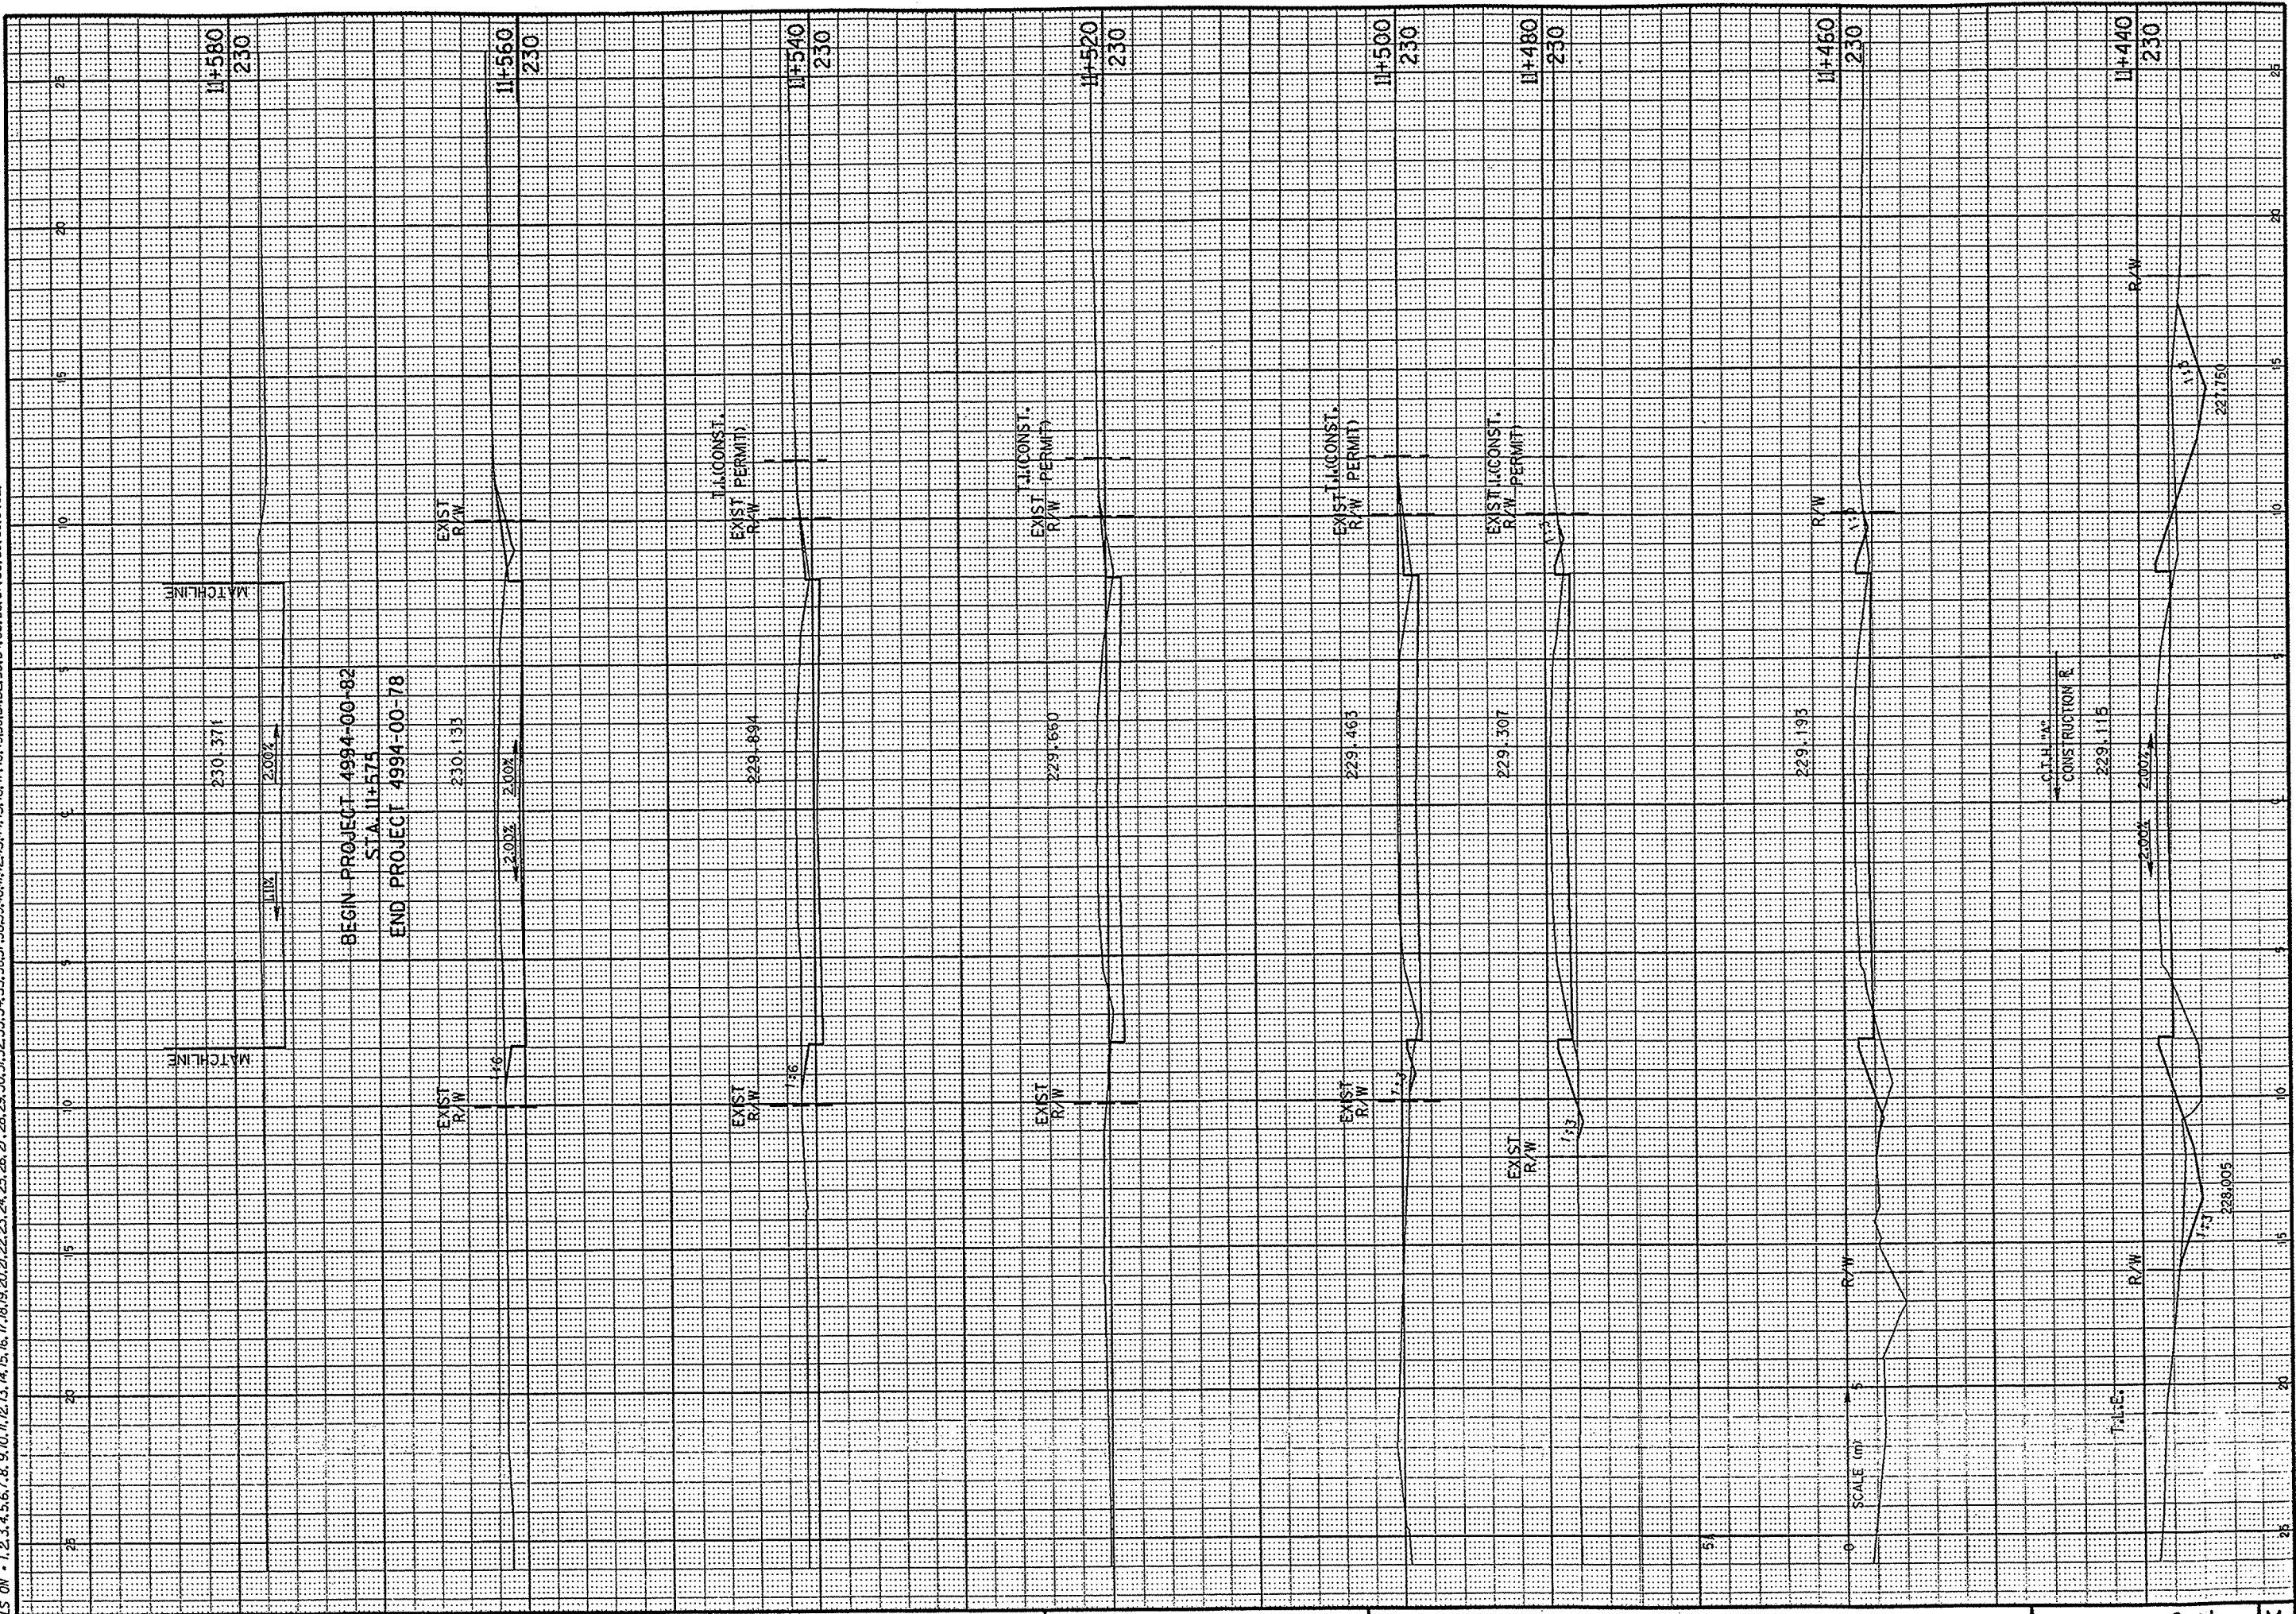


FILE NAME:

WI&DOT: MSHT21

GB2
 PEN TABLE = #plot724laser.tbl
 DATE OF PLOT = 11/24/98
 PLOT NAME = P:\LASER\31RC0100LPRF
 DGN FILE = I:\440278\dgn\sec\rc01001.dgn

ORIGINATOR:
 LEVELS ON = 1, 2, 3, 61, 62

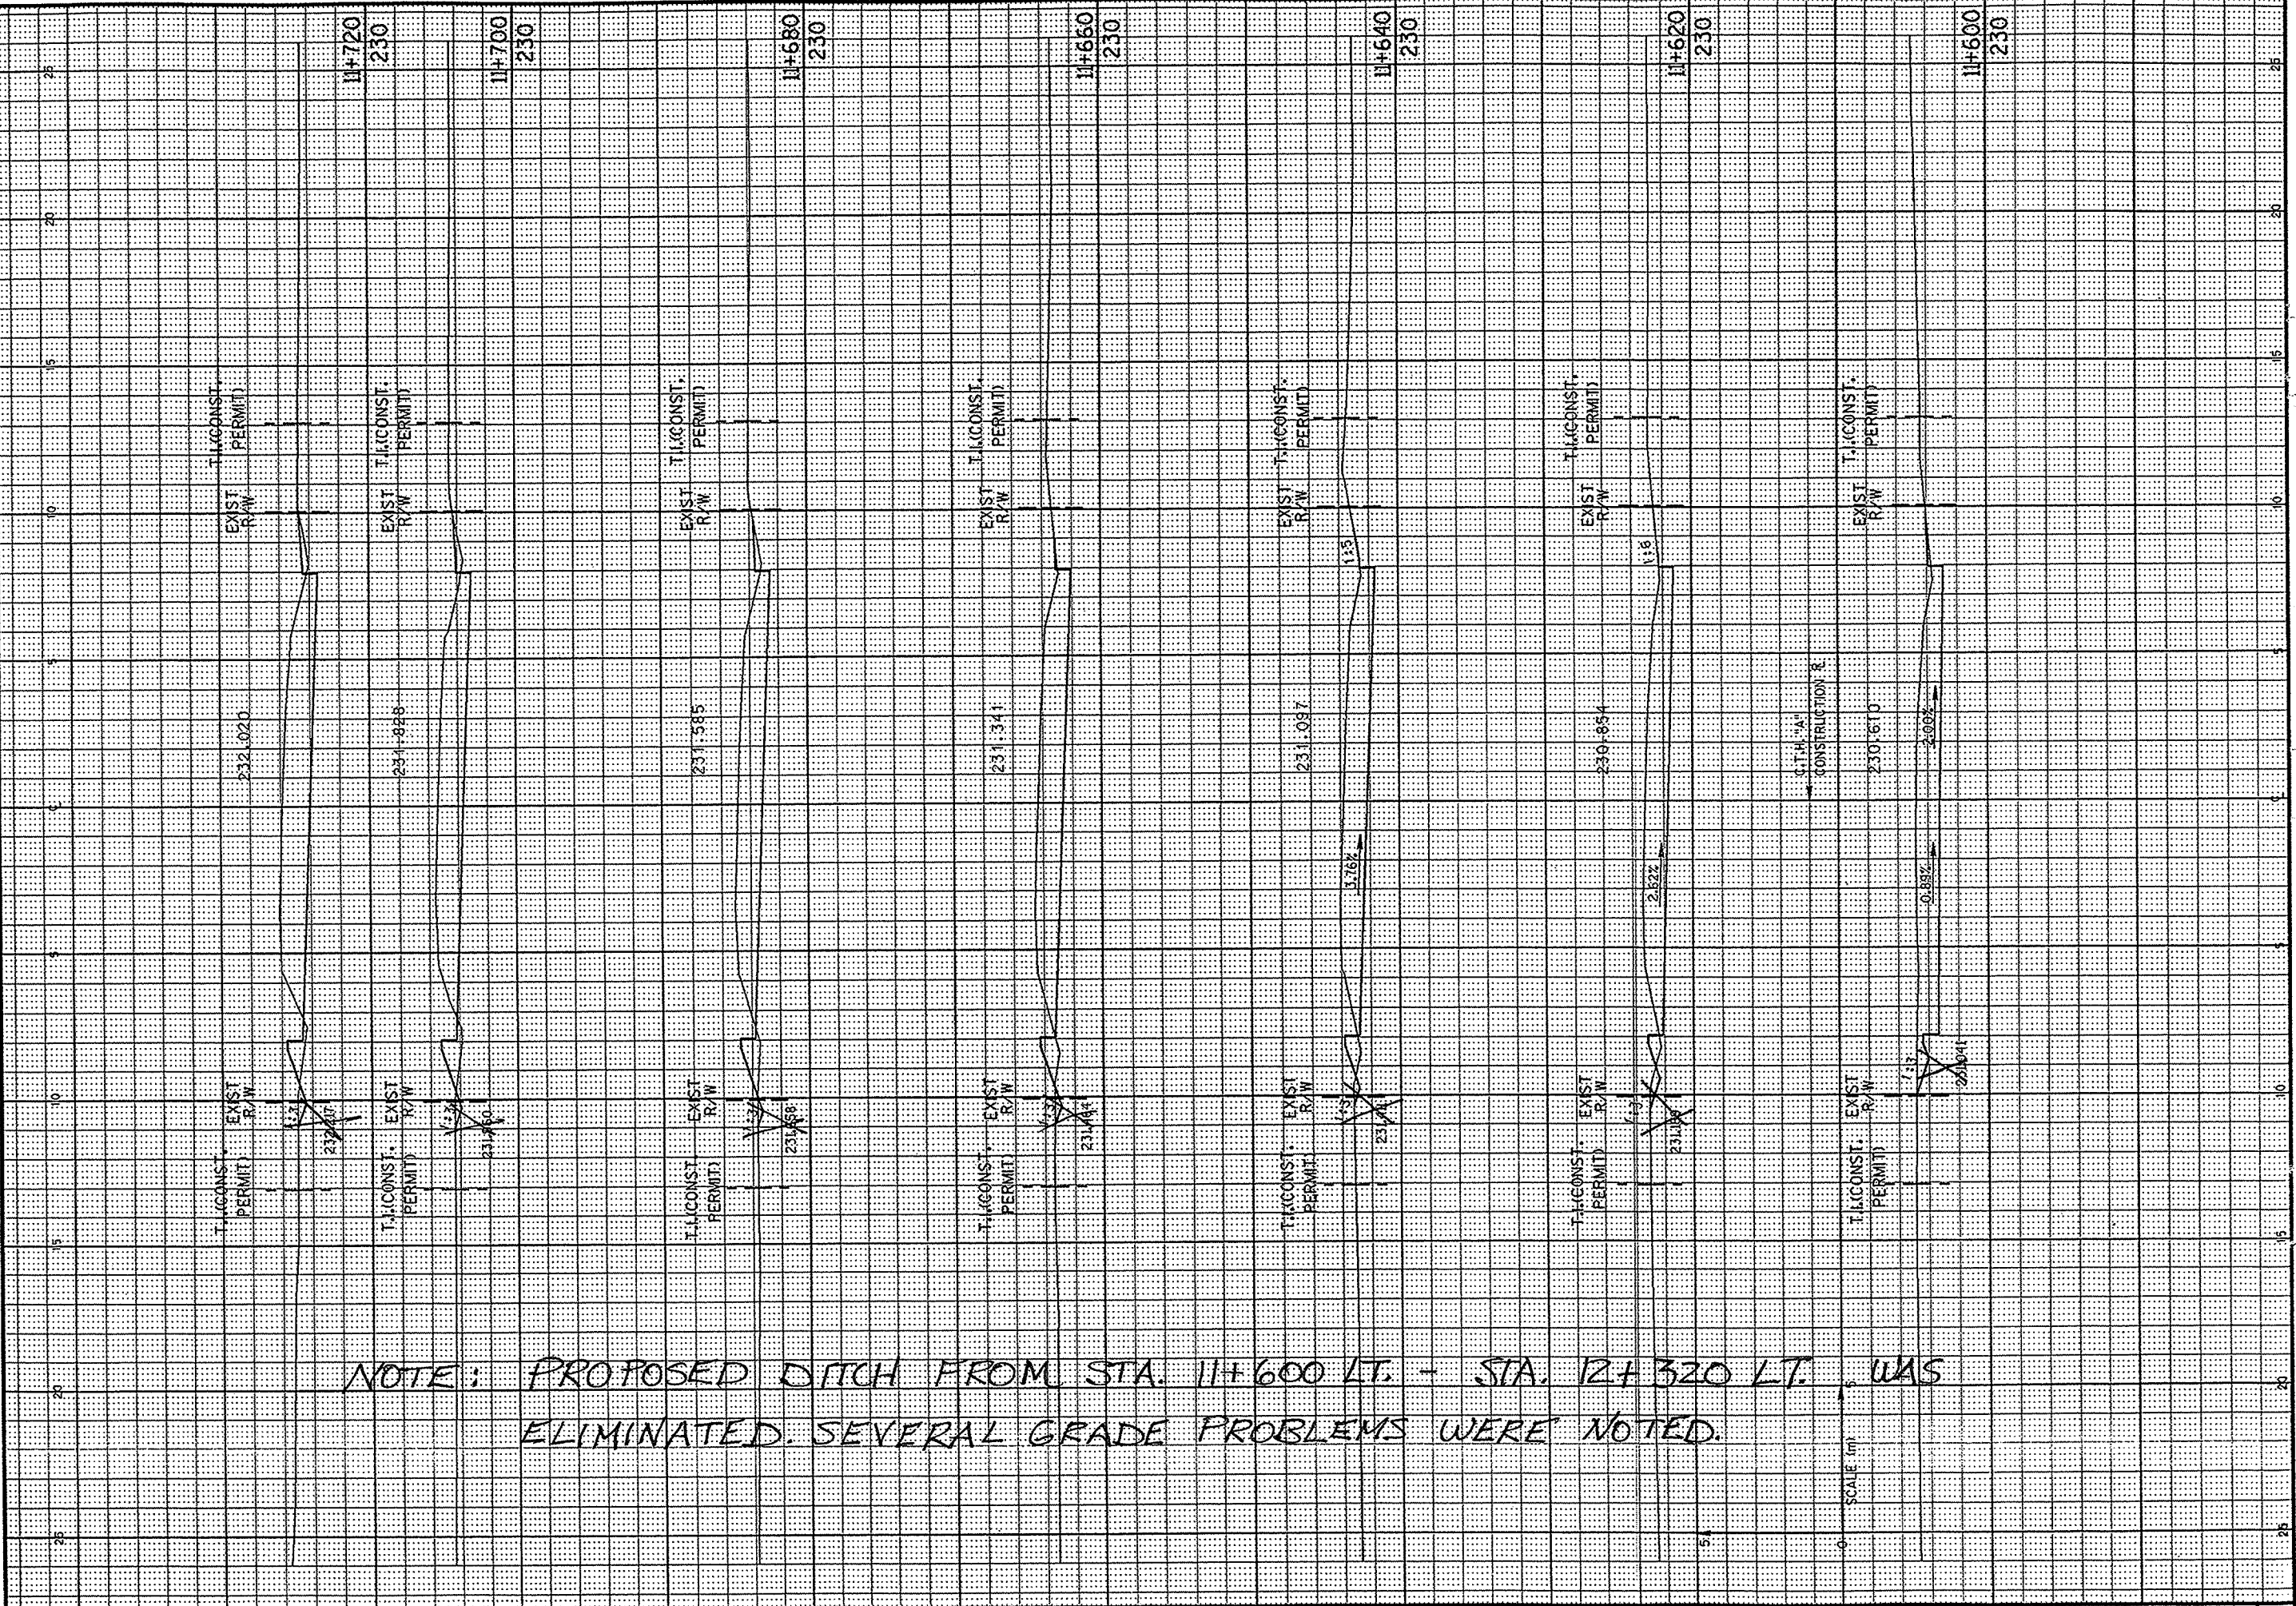

NOTE: PROPOSED DITCH FROM STA. 11+600 LT. - STA. 12+320 LT. WAS ELIMINATED. SEVERAL GRADE PROBLEMS WERE NOTED.

CROSS SECTION

HWY: C.T.H. "A"

COUNTY: WINNEBAGO

STATE PROJECT NO: 4994-00-82


SHEET NO: 9.12 M

FILE NAME:

WI600T: MSHT21

GB2
 PEN TABLE = spic724daser\mhdifxs.tbl
 DATE OF PLOT = 11/24/98
 PLOT NAME = P:\LASERA3\RC010001.PRF
 DGN FILE = I:\440278\dgn\asec\rc010001.dgn

ORIGINATOR:
 LEVELS ON = 1, 2, 3, 61, 62.

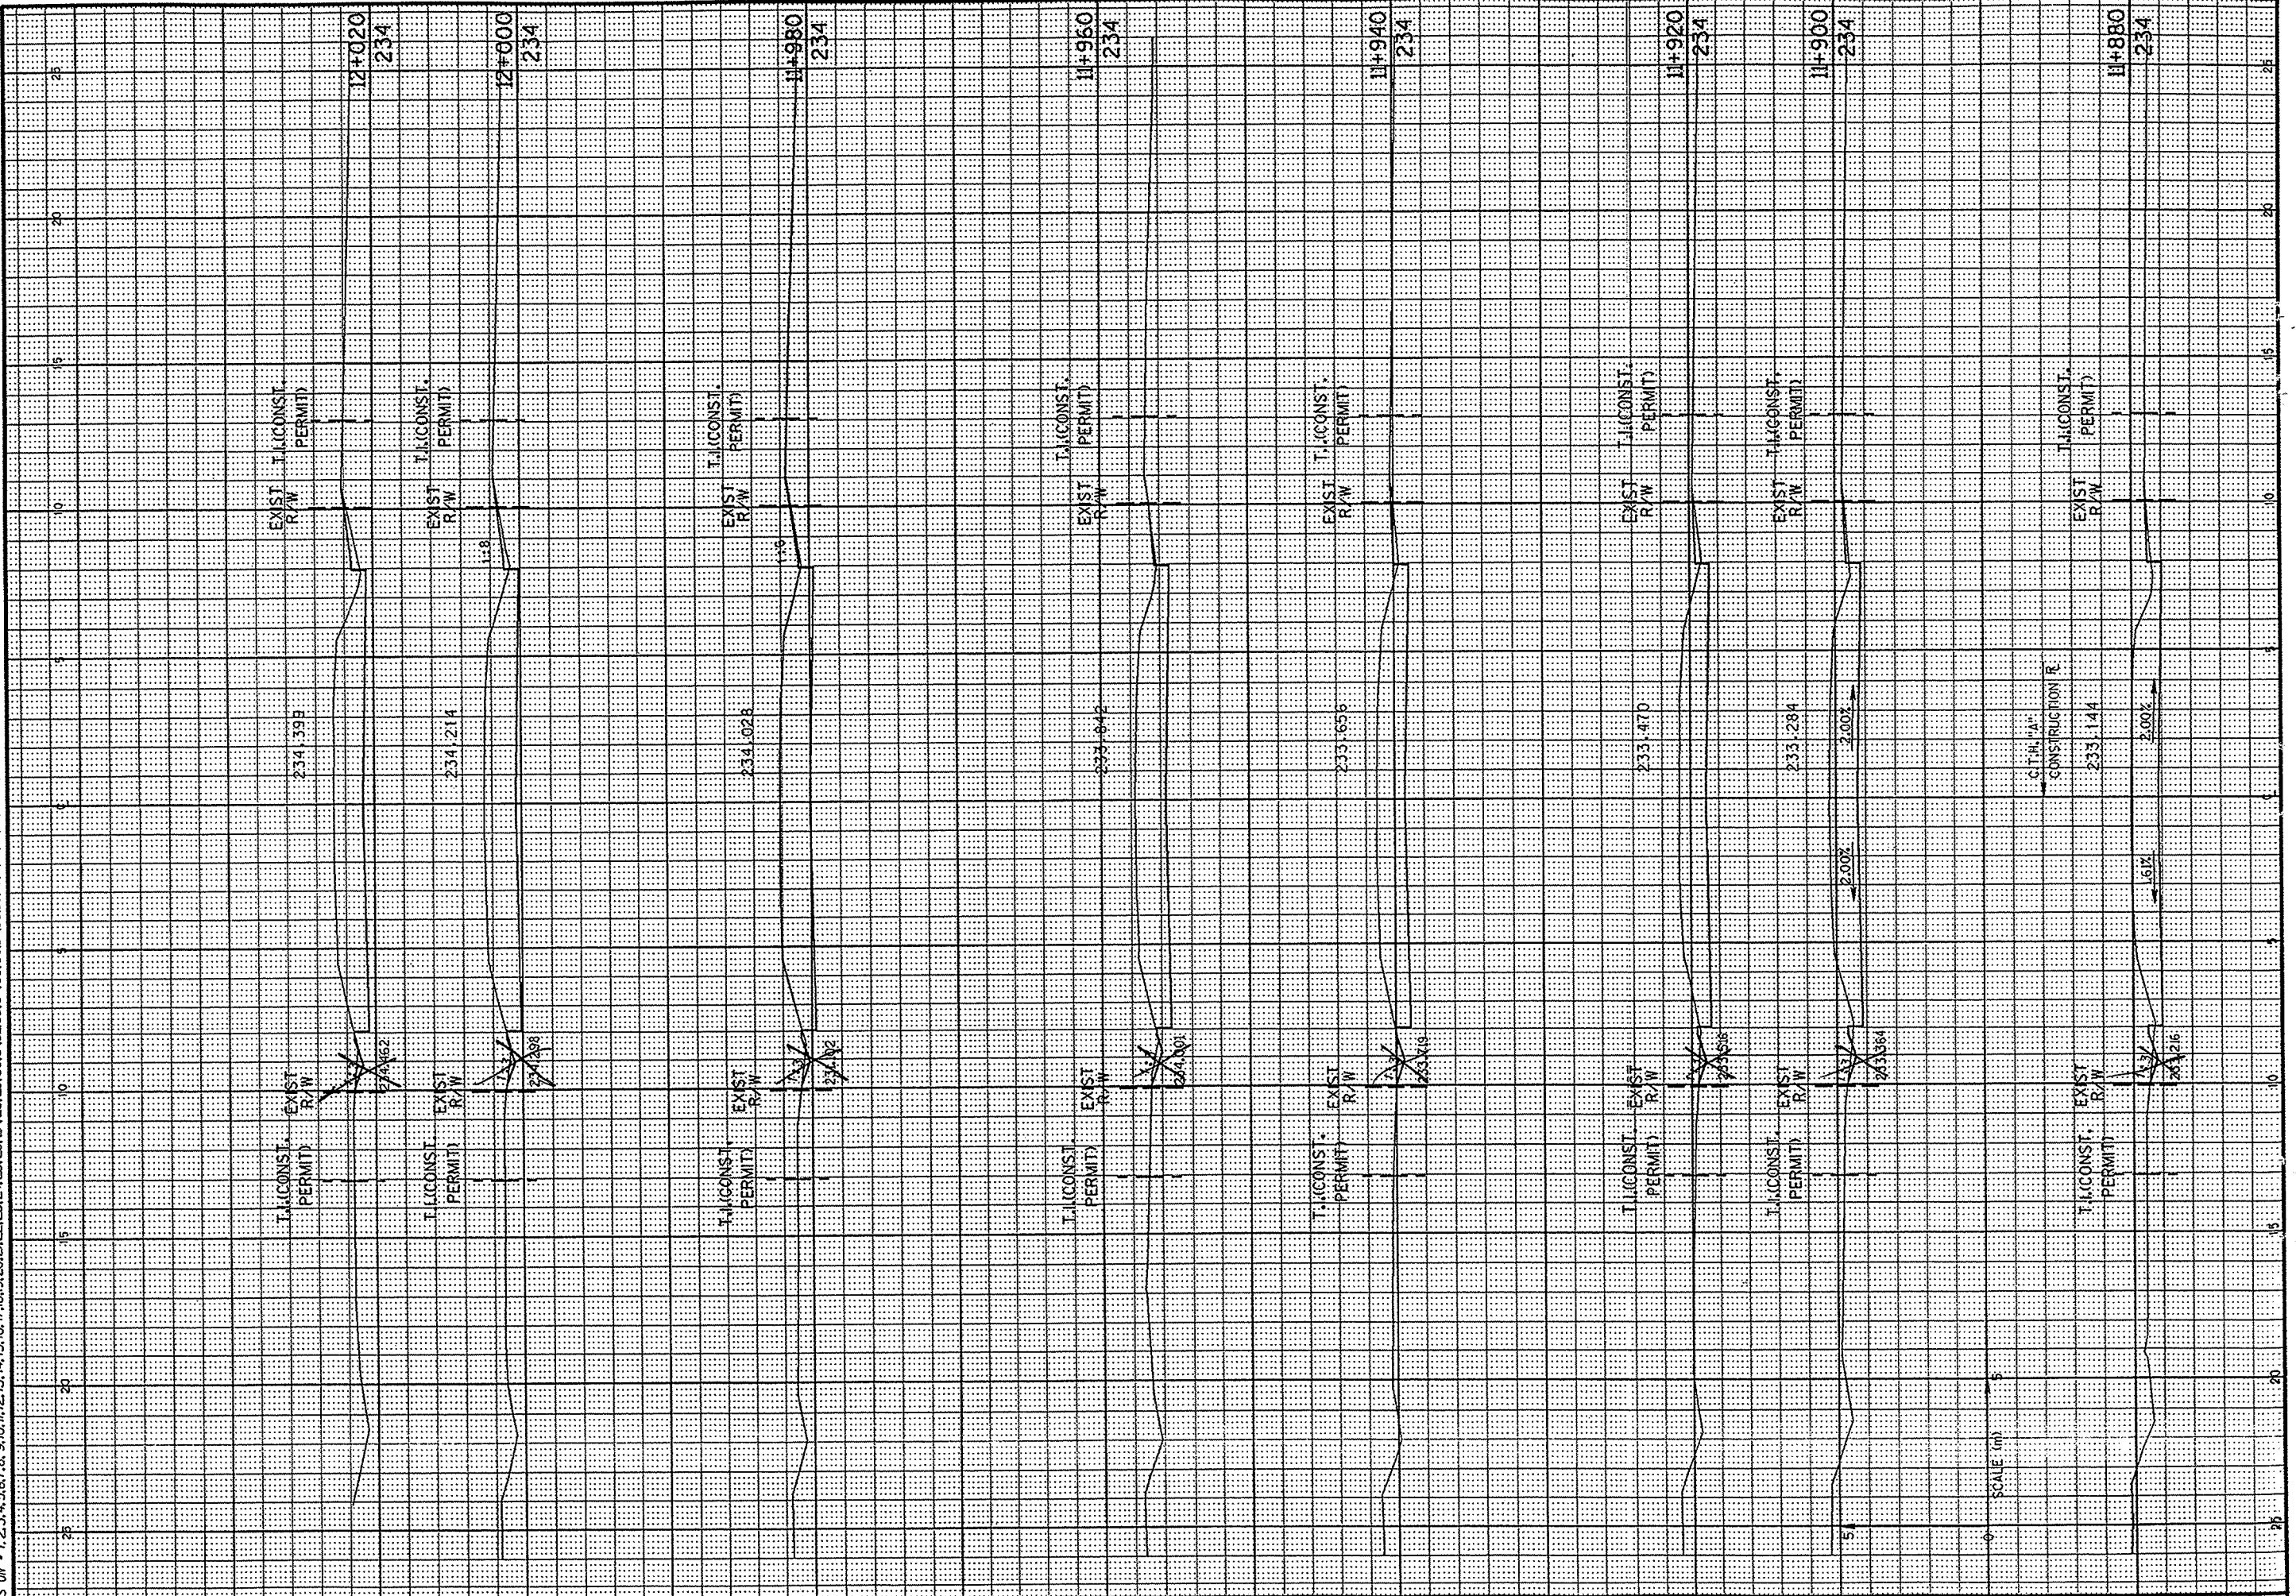

SCALE 1" = 5'

CROSS SECTION

HWY: C.T.H. "A"

COUNTY: WINNEBAGO

STATE PROJECT NO: 4994-00-82


SHEET NO: 9.14 M

FILE NAME:

W:\DOT\MSHT21

CB2
 PEN TABLE = #plot724ioser-ehhdfxs.tbl
 DATE OF PLOT 11/24/98
 PLOT NAME = P:\LASER\34RC012001.PRF
 DGN FILE = I:\40278\dgn\ysec\c012001.dgn

ORIGINATOR:
 LEVELS ON = 1, 2, 3, 61, 62.

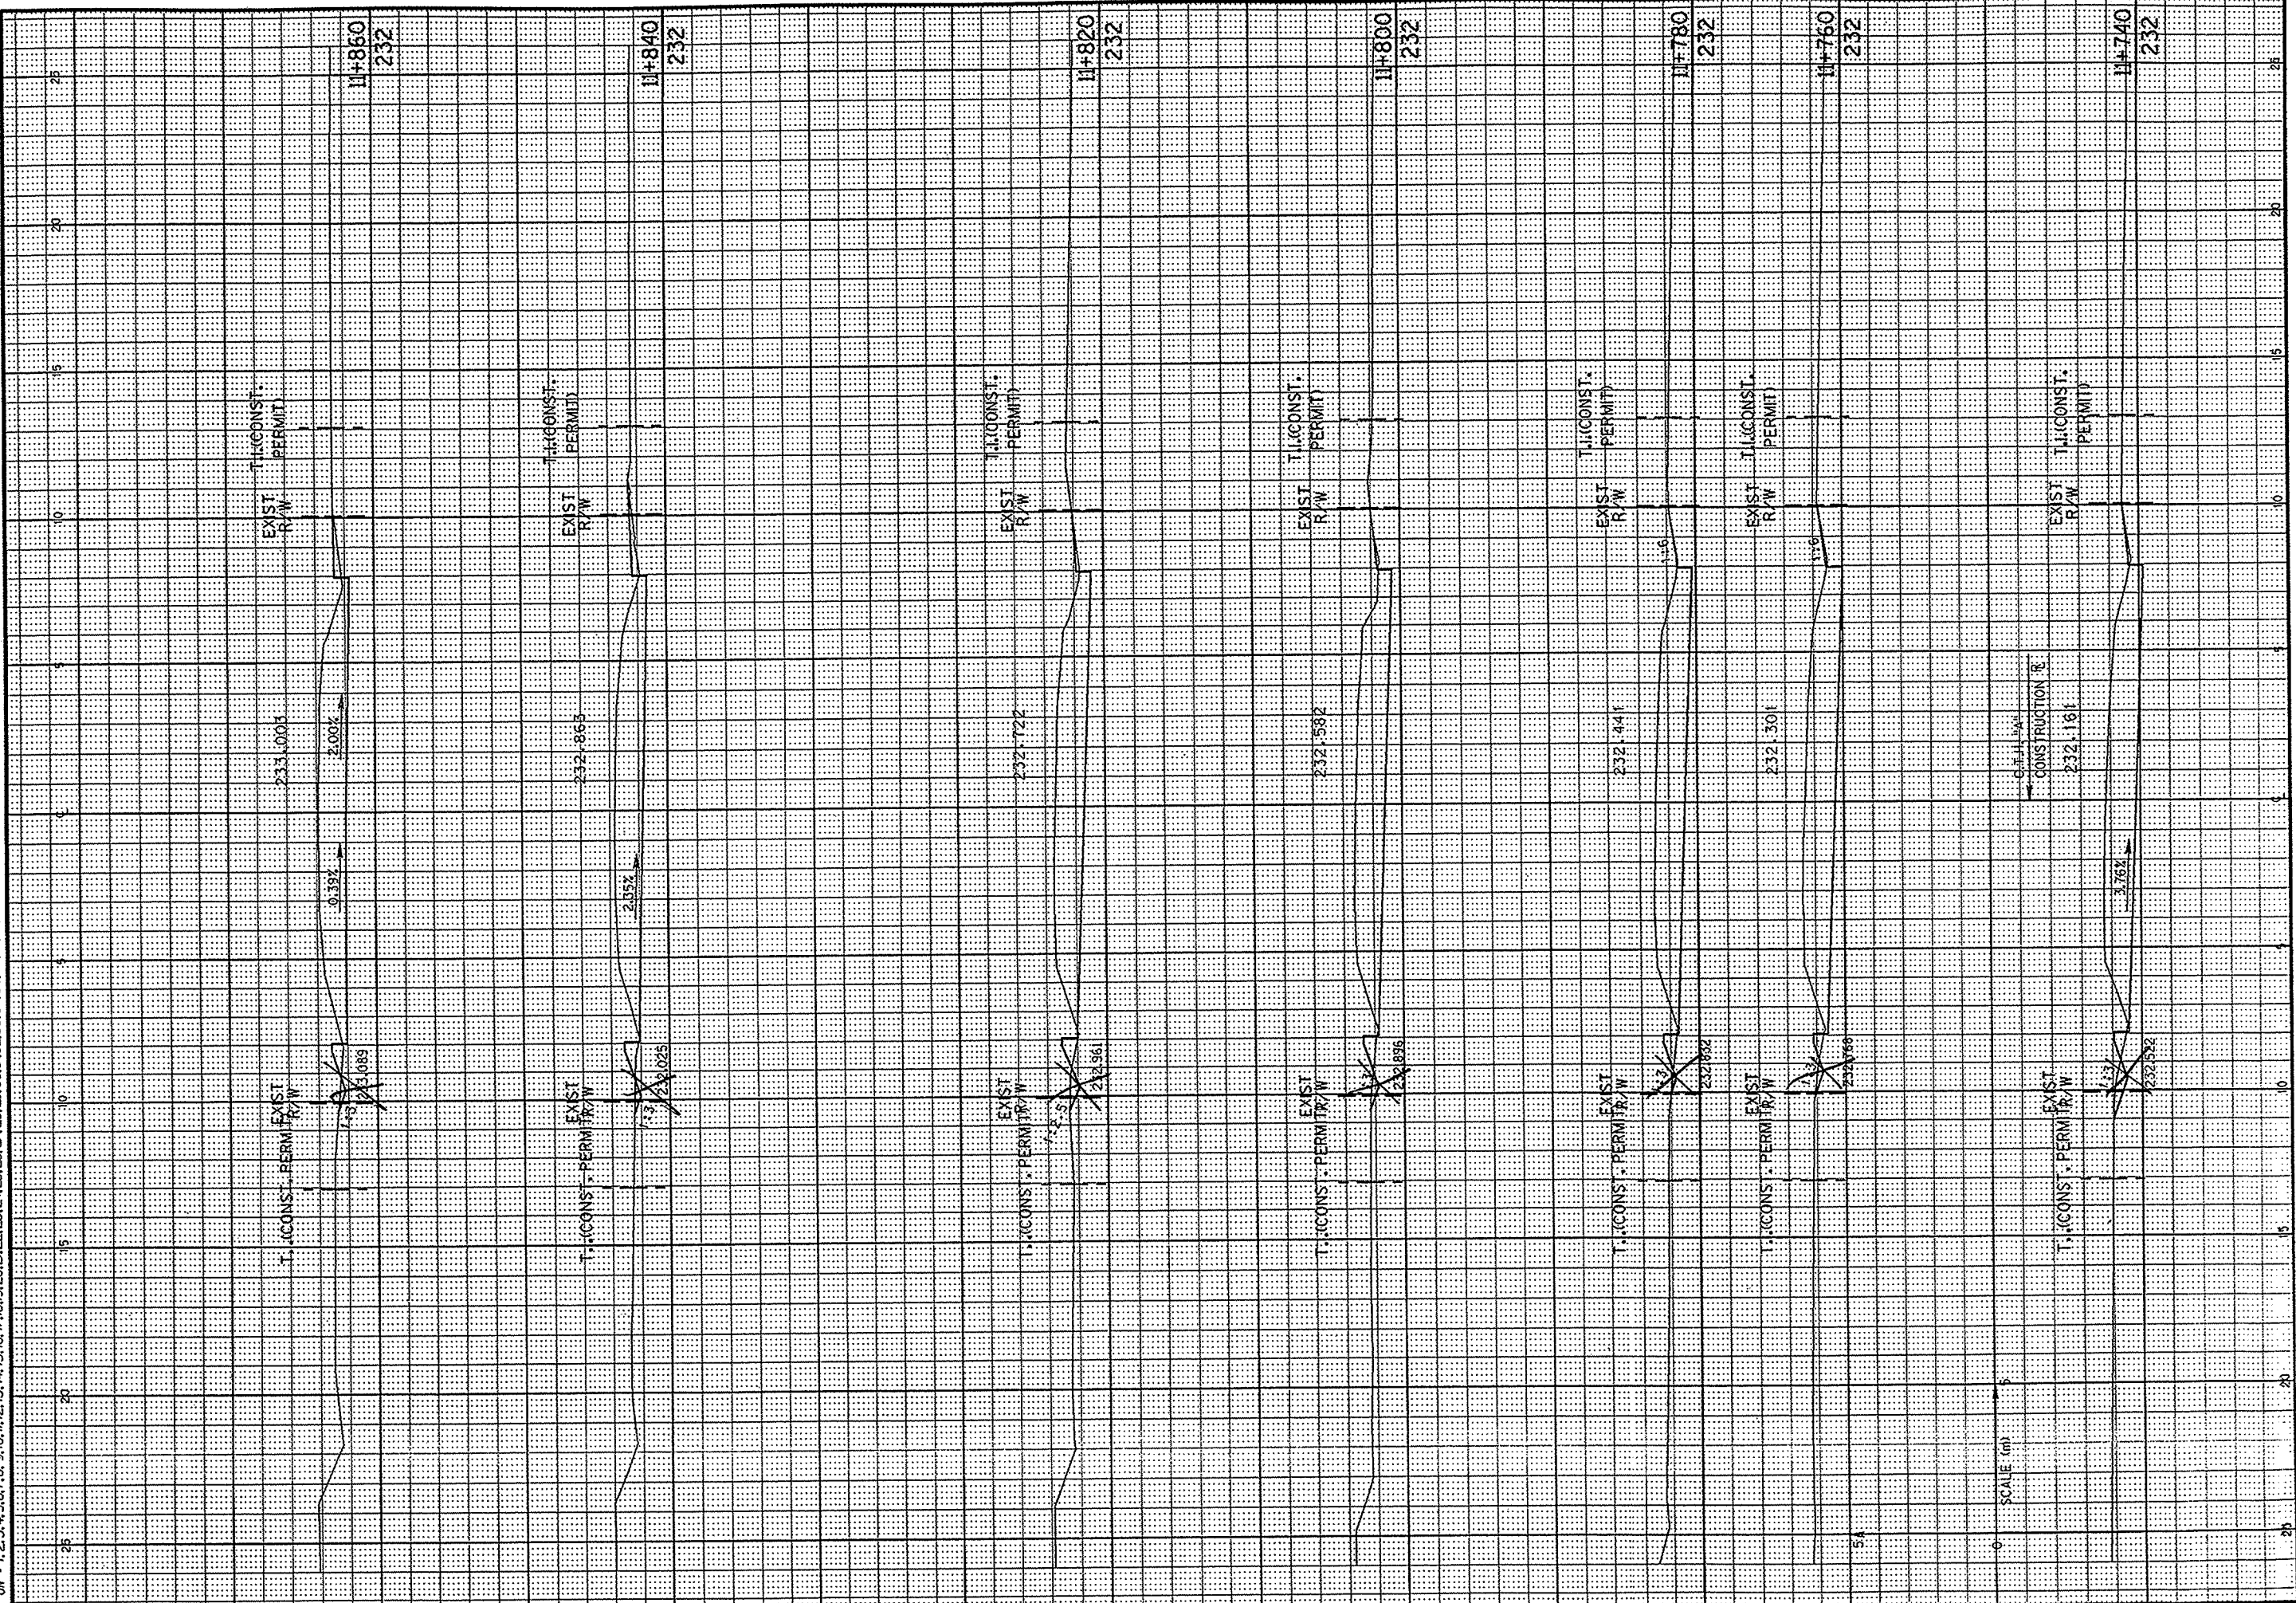

CROSS SECTION

HWY: C.T.H. "A"

COUNTY: WINNEBAGO

STATE PROJECT NO: 4994-00-82

SHEET NO: 9.13


M

FILE NAME:

WIDOT: MSHF2:

CBZ
 PEN TABLE = #plo1724user5mhoifxs.tbl
 DATE OF PLOT 11/24/98
 PLOT NAME = P:\LASER\RA3\RCO14001.PRF
 DGN FILE = P:\440278\dgn\ysec\rc014001.dgn

ORIGINATOR:
 LEVELS ON = 1, 2, 3, 61, 62

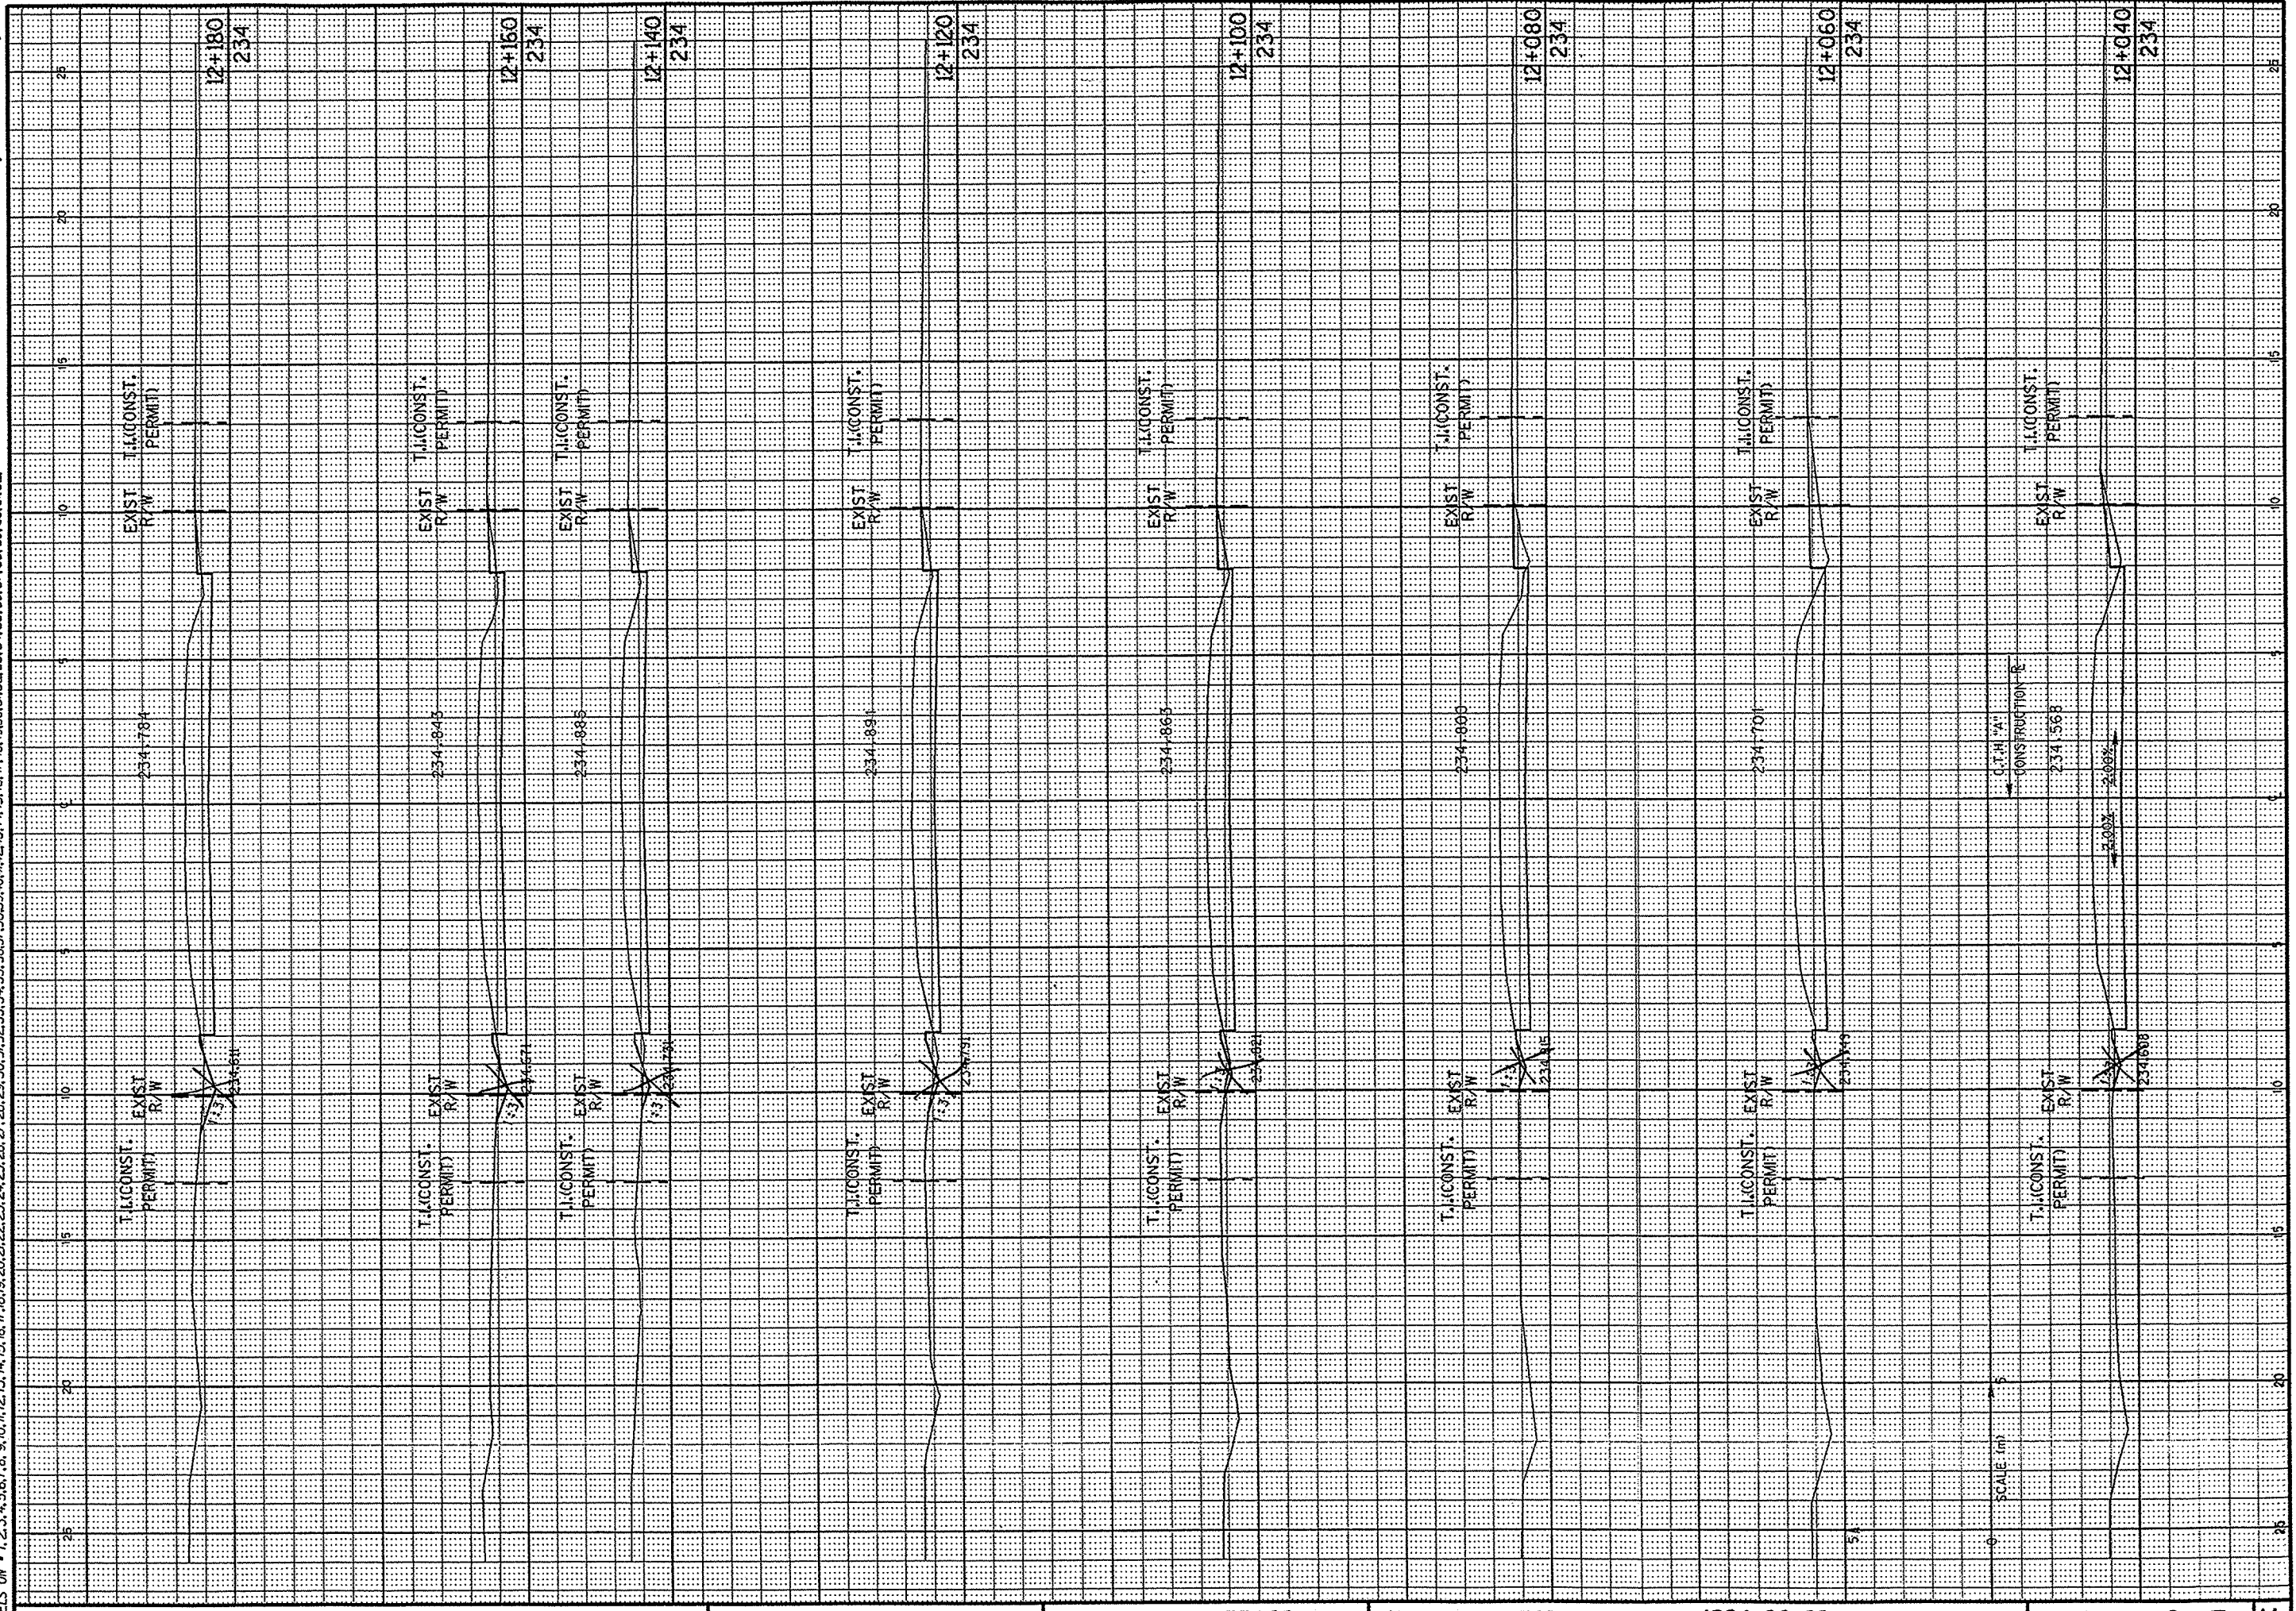

CROSS SECTION

HWY: C.T.H. "A"

COUNTY: WINNEBAGO

STATE PROJECT NO: 4994-00-82


SHEET NO: 9.15 M

FILE NAME:

WISDOT: MSHT21

CB2
 PER TABLE = splot724user-amhdxf.s.tbl
 DATE OF PLOT = 11/24/98
 PLOT NAME = P:\ASSETS\ARC050019RF
 DGN FILE = I:\440278\vgm\asac\rc05001.dgn

ORIGINATOR:
 LEVELS ON = 1, 2, 3, 61, 62

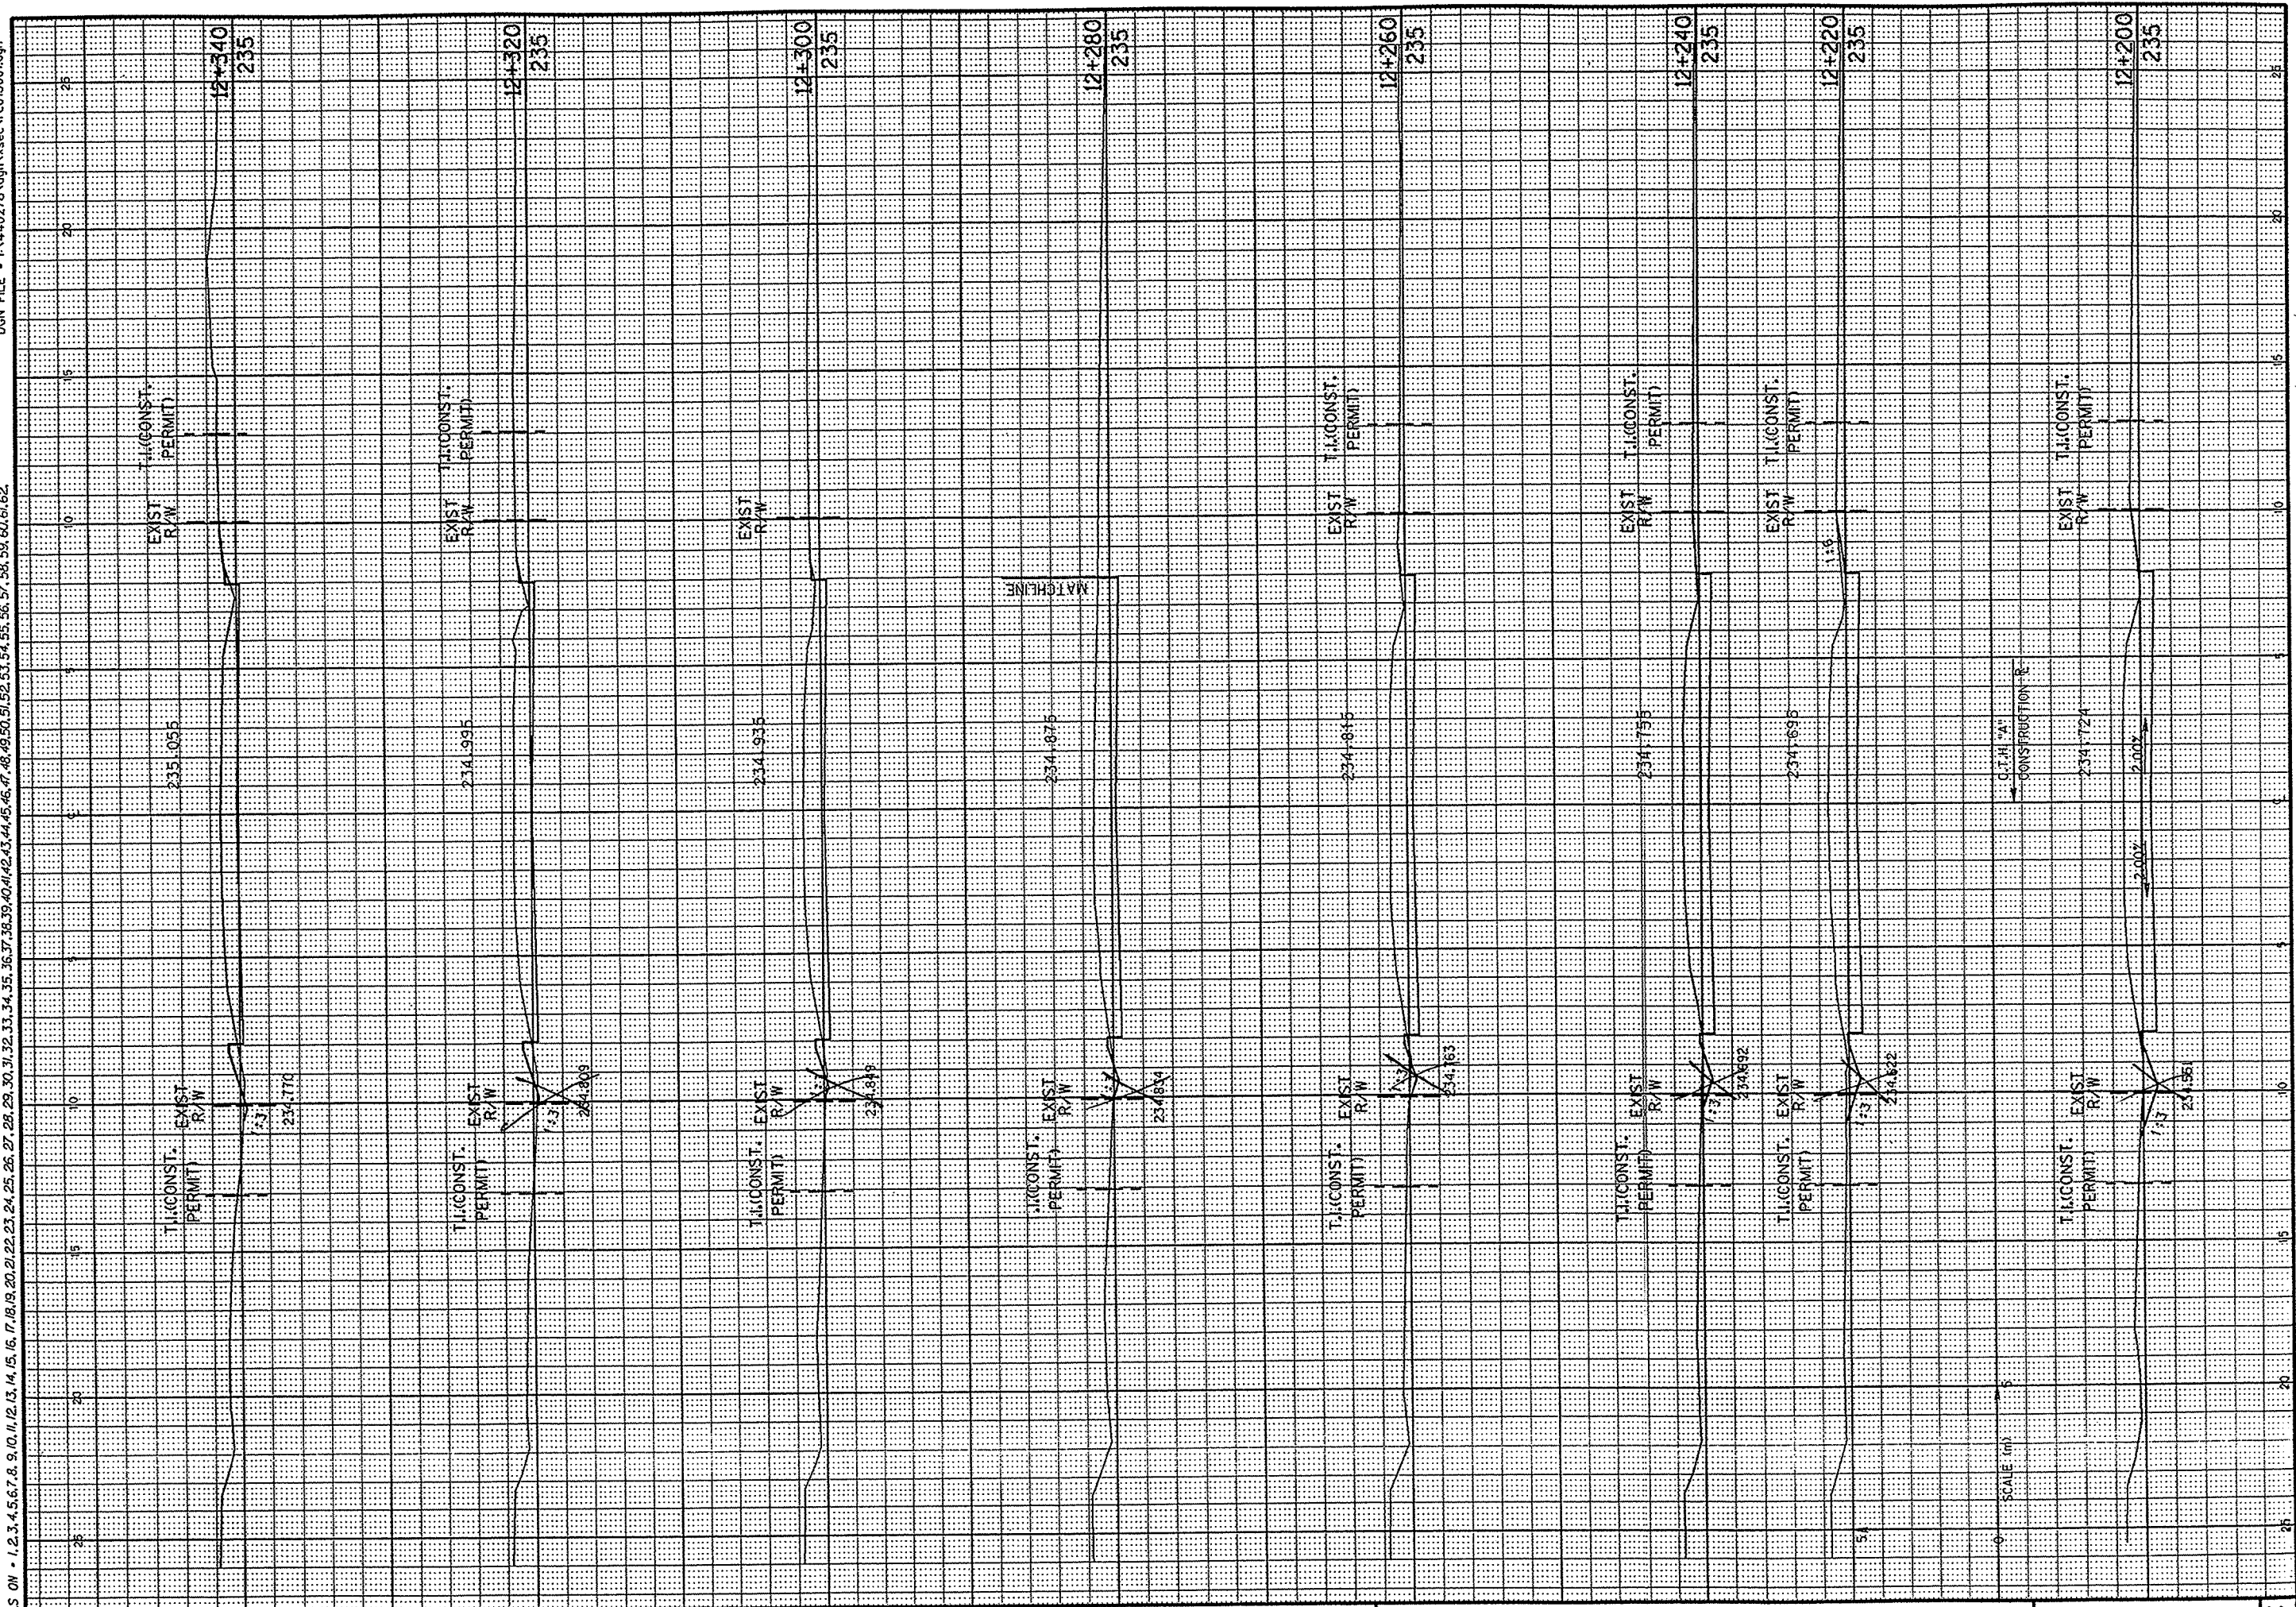

CROSS SECTION

HWY: C.T.H. "A"

COUNTY: WINNEBAGO

STATE PROJECT NO: 4994-00-82

SHEET NO: 9.16


M

FILE NAME:

WISDOT: MSHT21

CB2
 GEN TABLE = #plot721giser-4mhd4xs.tbl
 DATE OF PLOT = 11/24/98
 PLOT NAME = P:\LASERA3\FCC016001PRF
 DGN FILE = I:\440278.dgn\sscc\rc016001.dgn

ORIGINATOR: LEVELS ON = 1, 2, 3, 61, 62

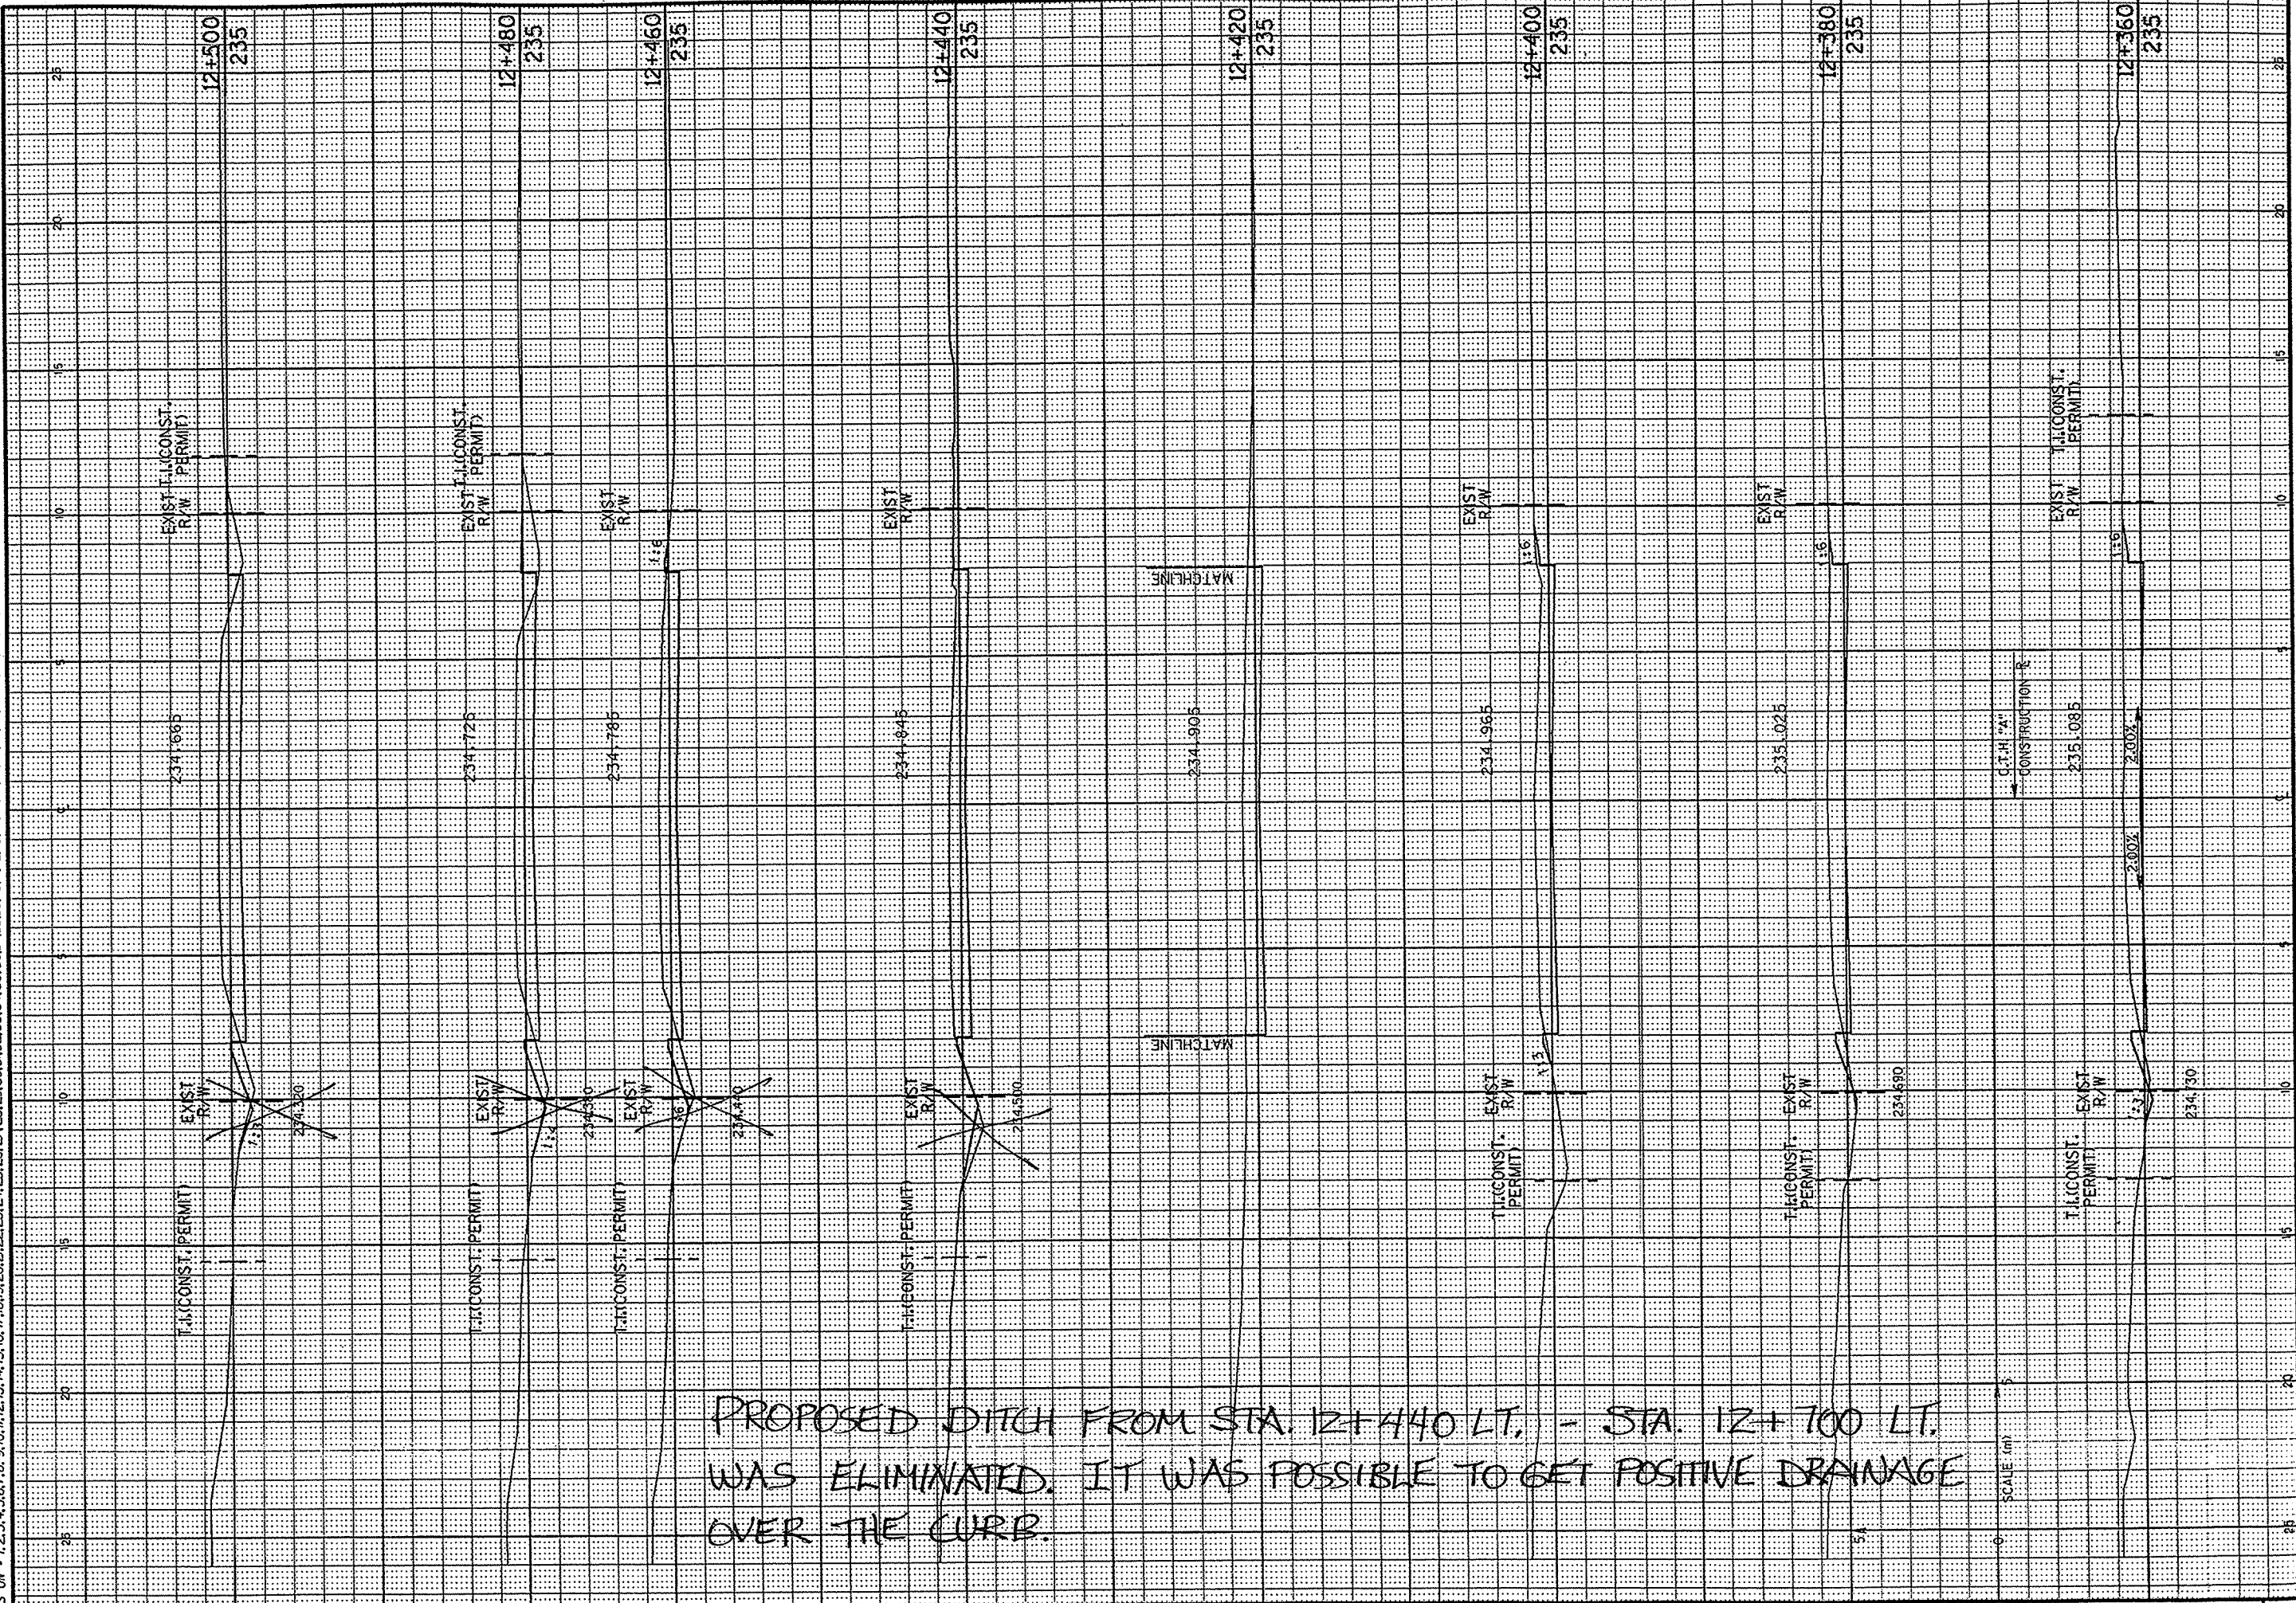

PROPOSED DITCH FROM STA. 12+440 LT. - STA. 12+700 LT.
 WAS ELIMINATED. IT WAS POSSIBLE TO GET POSITIVE DRAINAGE
 OVER THE CURB.

CROSS SECTION

HWY: C.T.H. "A"

COUNTY: WINNEBAGO

STATE PROJECT NO: 4994-00-82

SHEET NO: 9.17

M

FILE NAME:

W:\DOT\MSHT21

GB2
 PEN TABLE = splo1721doser-amhd1fxs.tbl
 DATE OF PLOT = 11/24/98
 PLOT NAME = P:\L4SERV\3\FRCOT7001.PRF
 DGN FILE = P:\440278\vdgn\assecc\rcot7001.dgn

ORIGINATOR:
 LEVELS ON = 1, 2, 3, 61, 62



CROSS SECTION

HWY: C.T.H. "A"

COUNTY: WINNEBAGO

STATE PROJECT NO: 4994-00-82

SHEET NO: 9.18


M

FILE NAME:

WI&DOT: MSH21

GB2
 PEN TABLE = #plot72hoser.emhalf.s.tbl
 DATE OF PLOT = 11/24/98
 PLOT NAME = P:\LASERA3\RCO8001.PRF
 DGN FILE = P:\440278\dgn\sscc\rc08001.dgn

ORIGINATOR:
 LEVELS ON = 1, 2, 3, 61, 62.

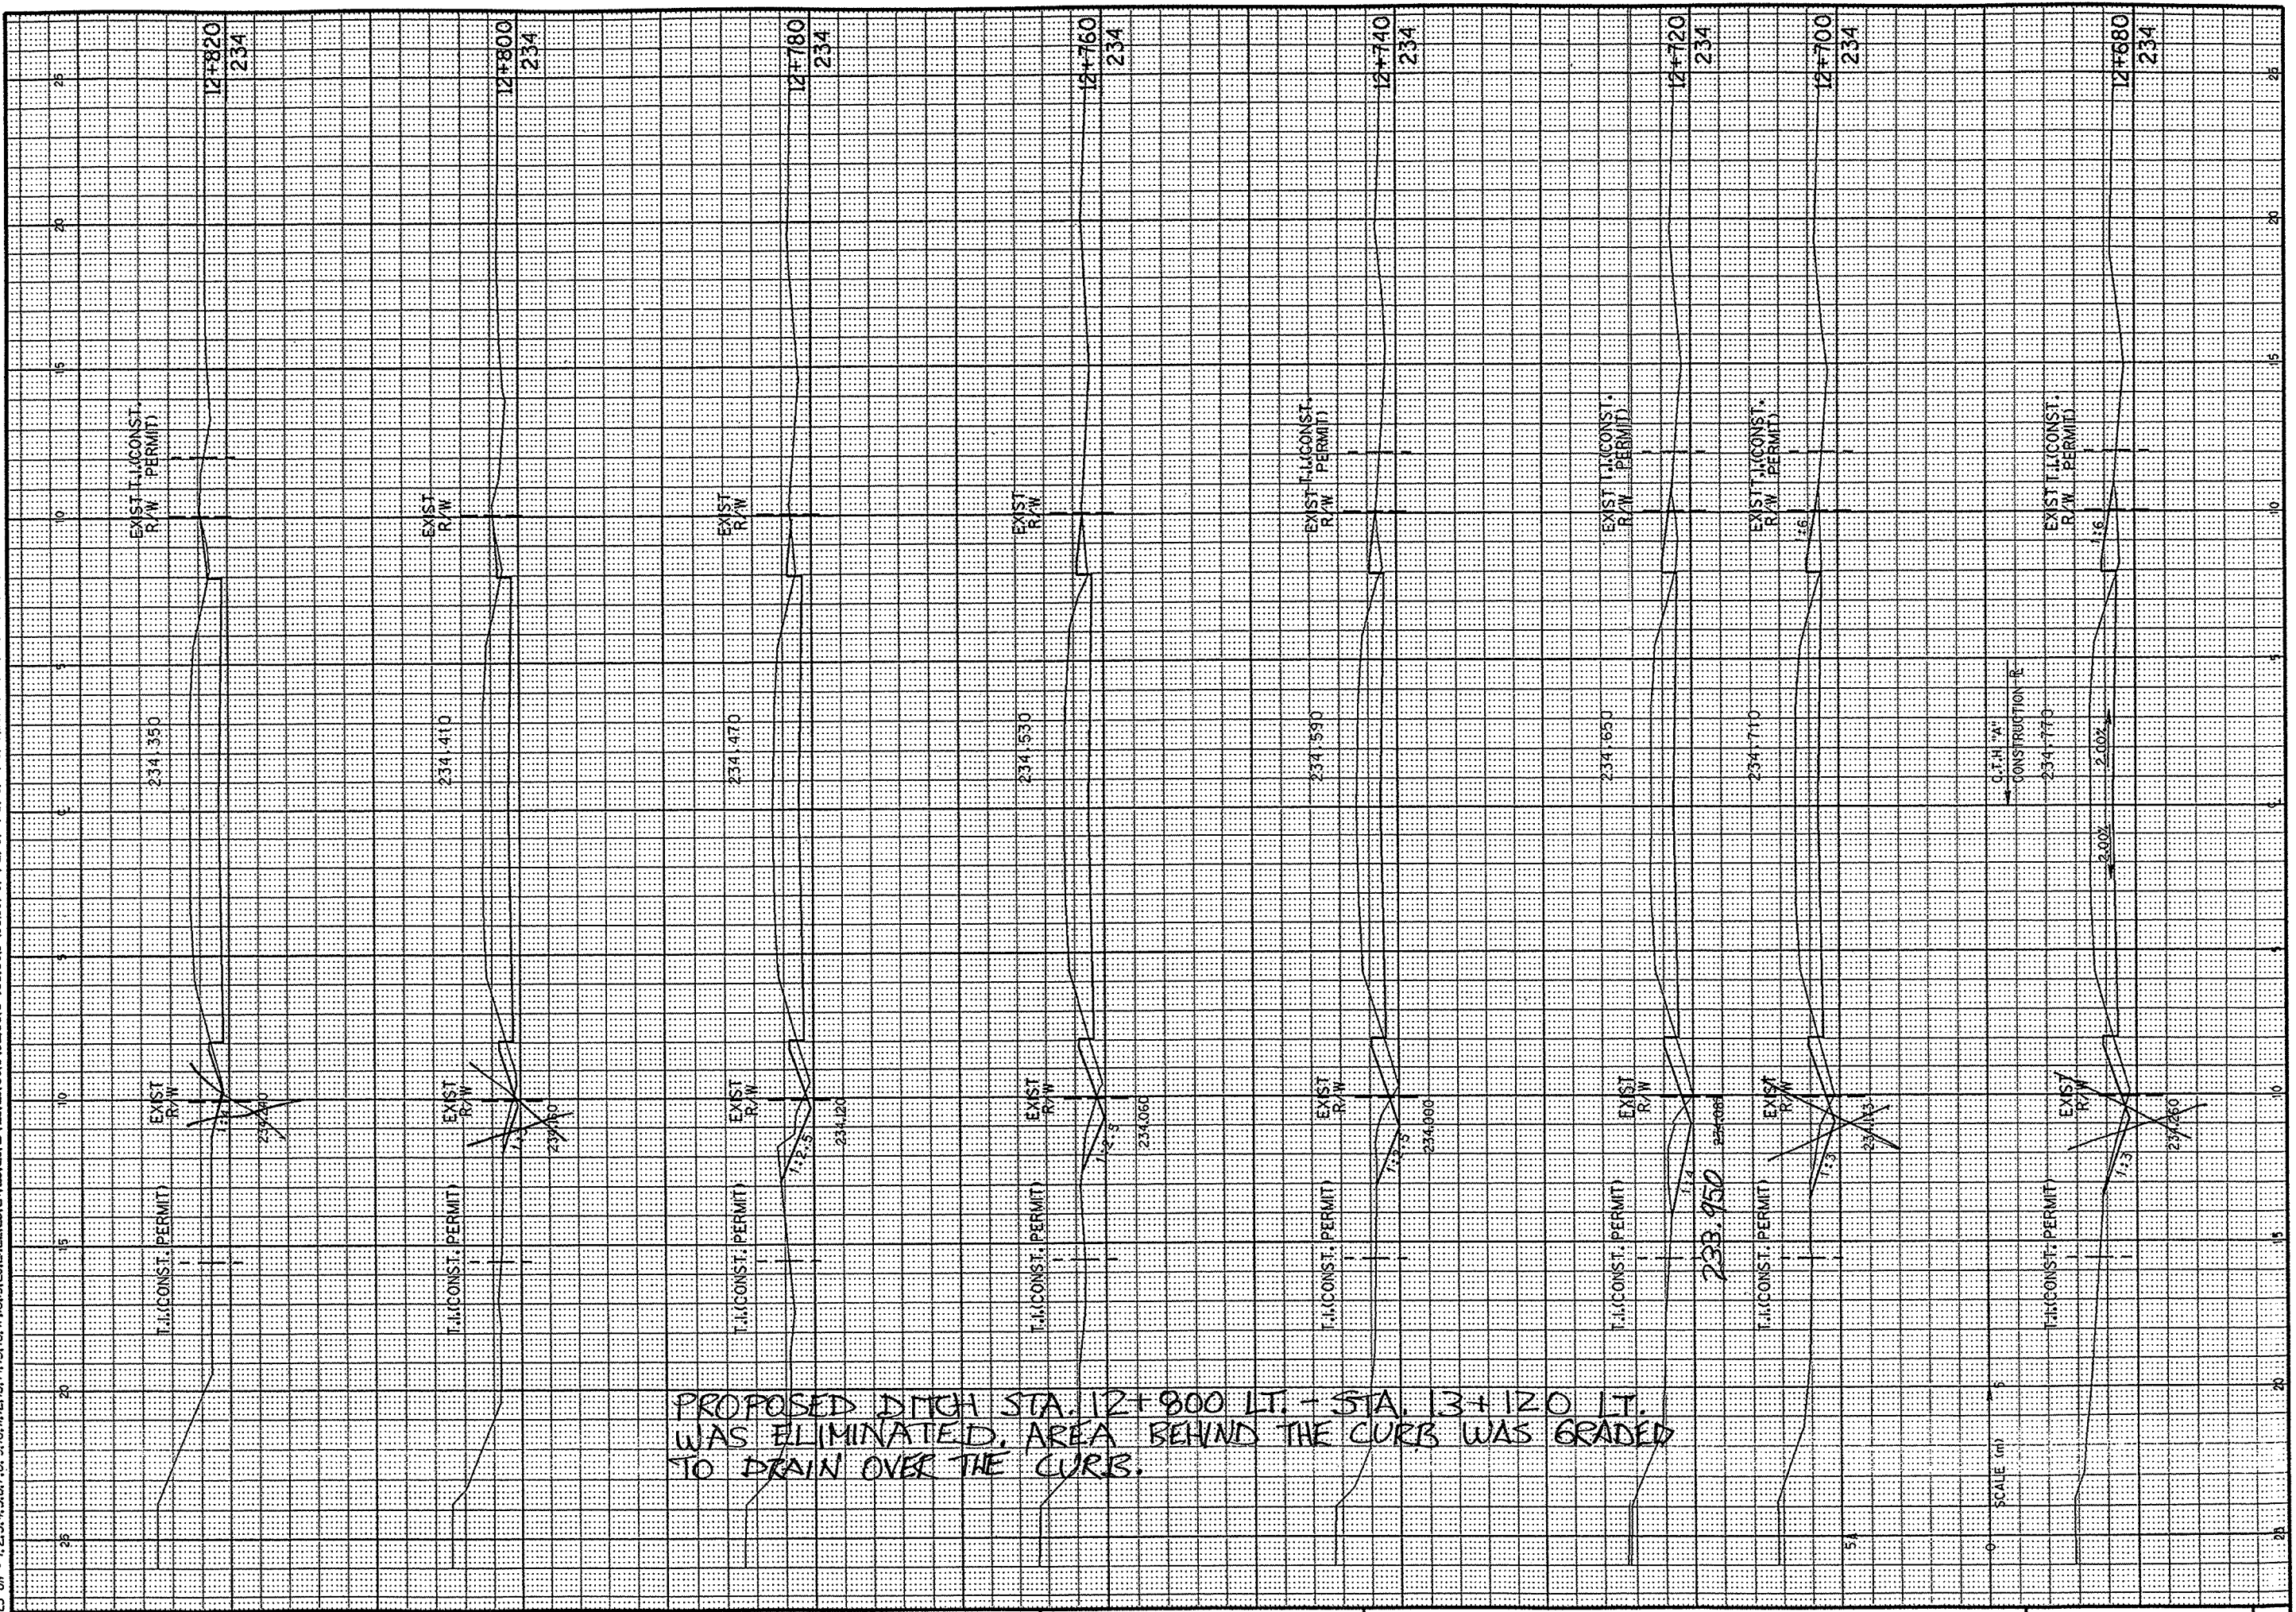

CROSS SECTION

HWY: C.T.H. "A"

COUNTY: WINNEBAGO

STATE PROJECT NO:

4994-00-82

SHEET NO: 9.19


M

FILE NAME:

WI8DOT: MSHT21

GB2
 PEN TABLE = #plot72duser-amhdfxs.tbl
 DATE OF PLOT 11/24/98
 PLOT NAME = P:\LASERA3\HRCO\9001\PRF
 DGN FILE = I:\440278\dgn\ksec\c09001.dgn

ORIGINATOR:
 LEVELS 01 - 1, 2, 3, 61, 62

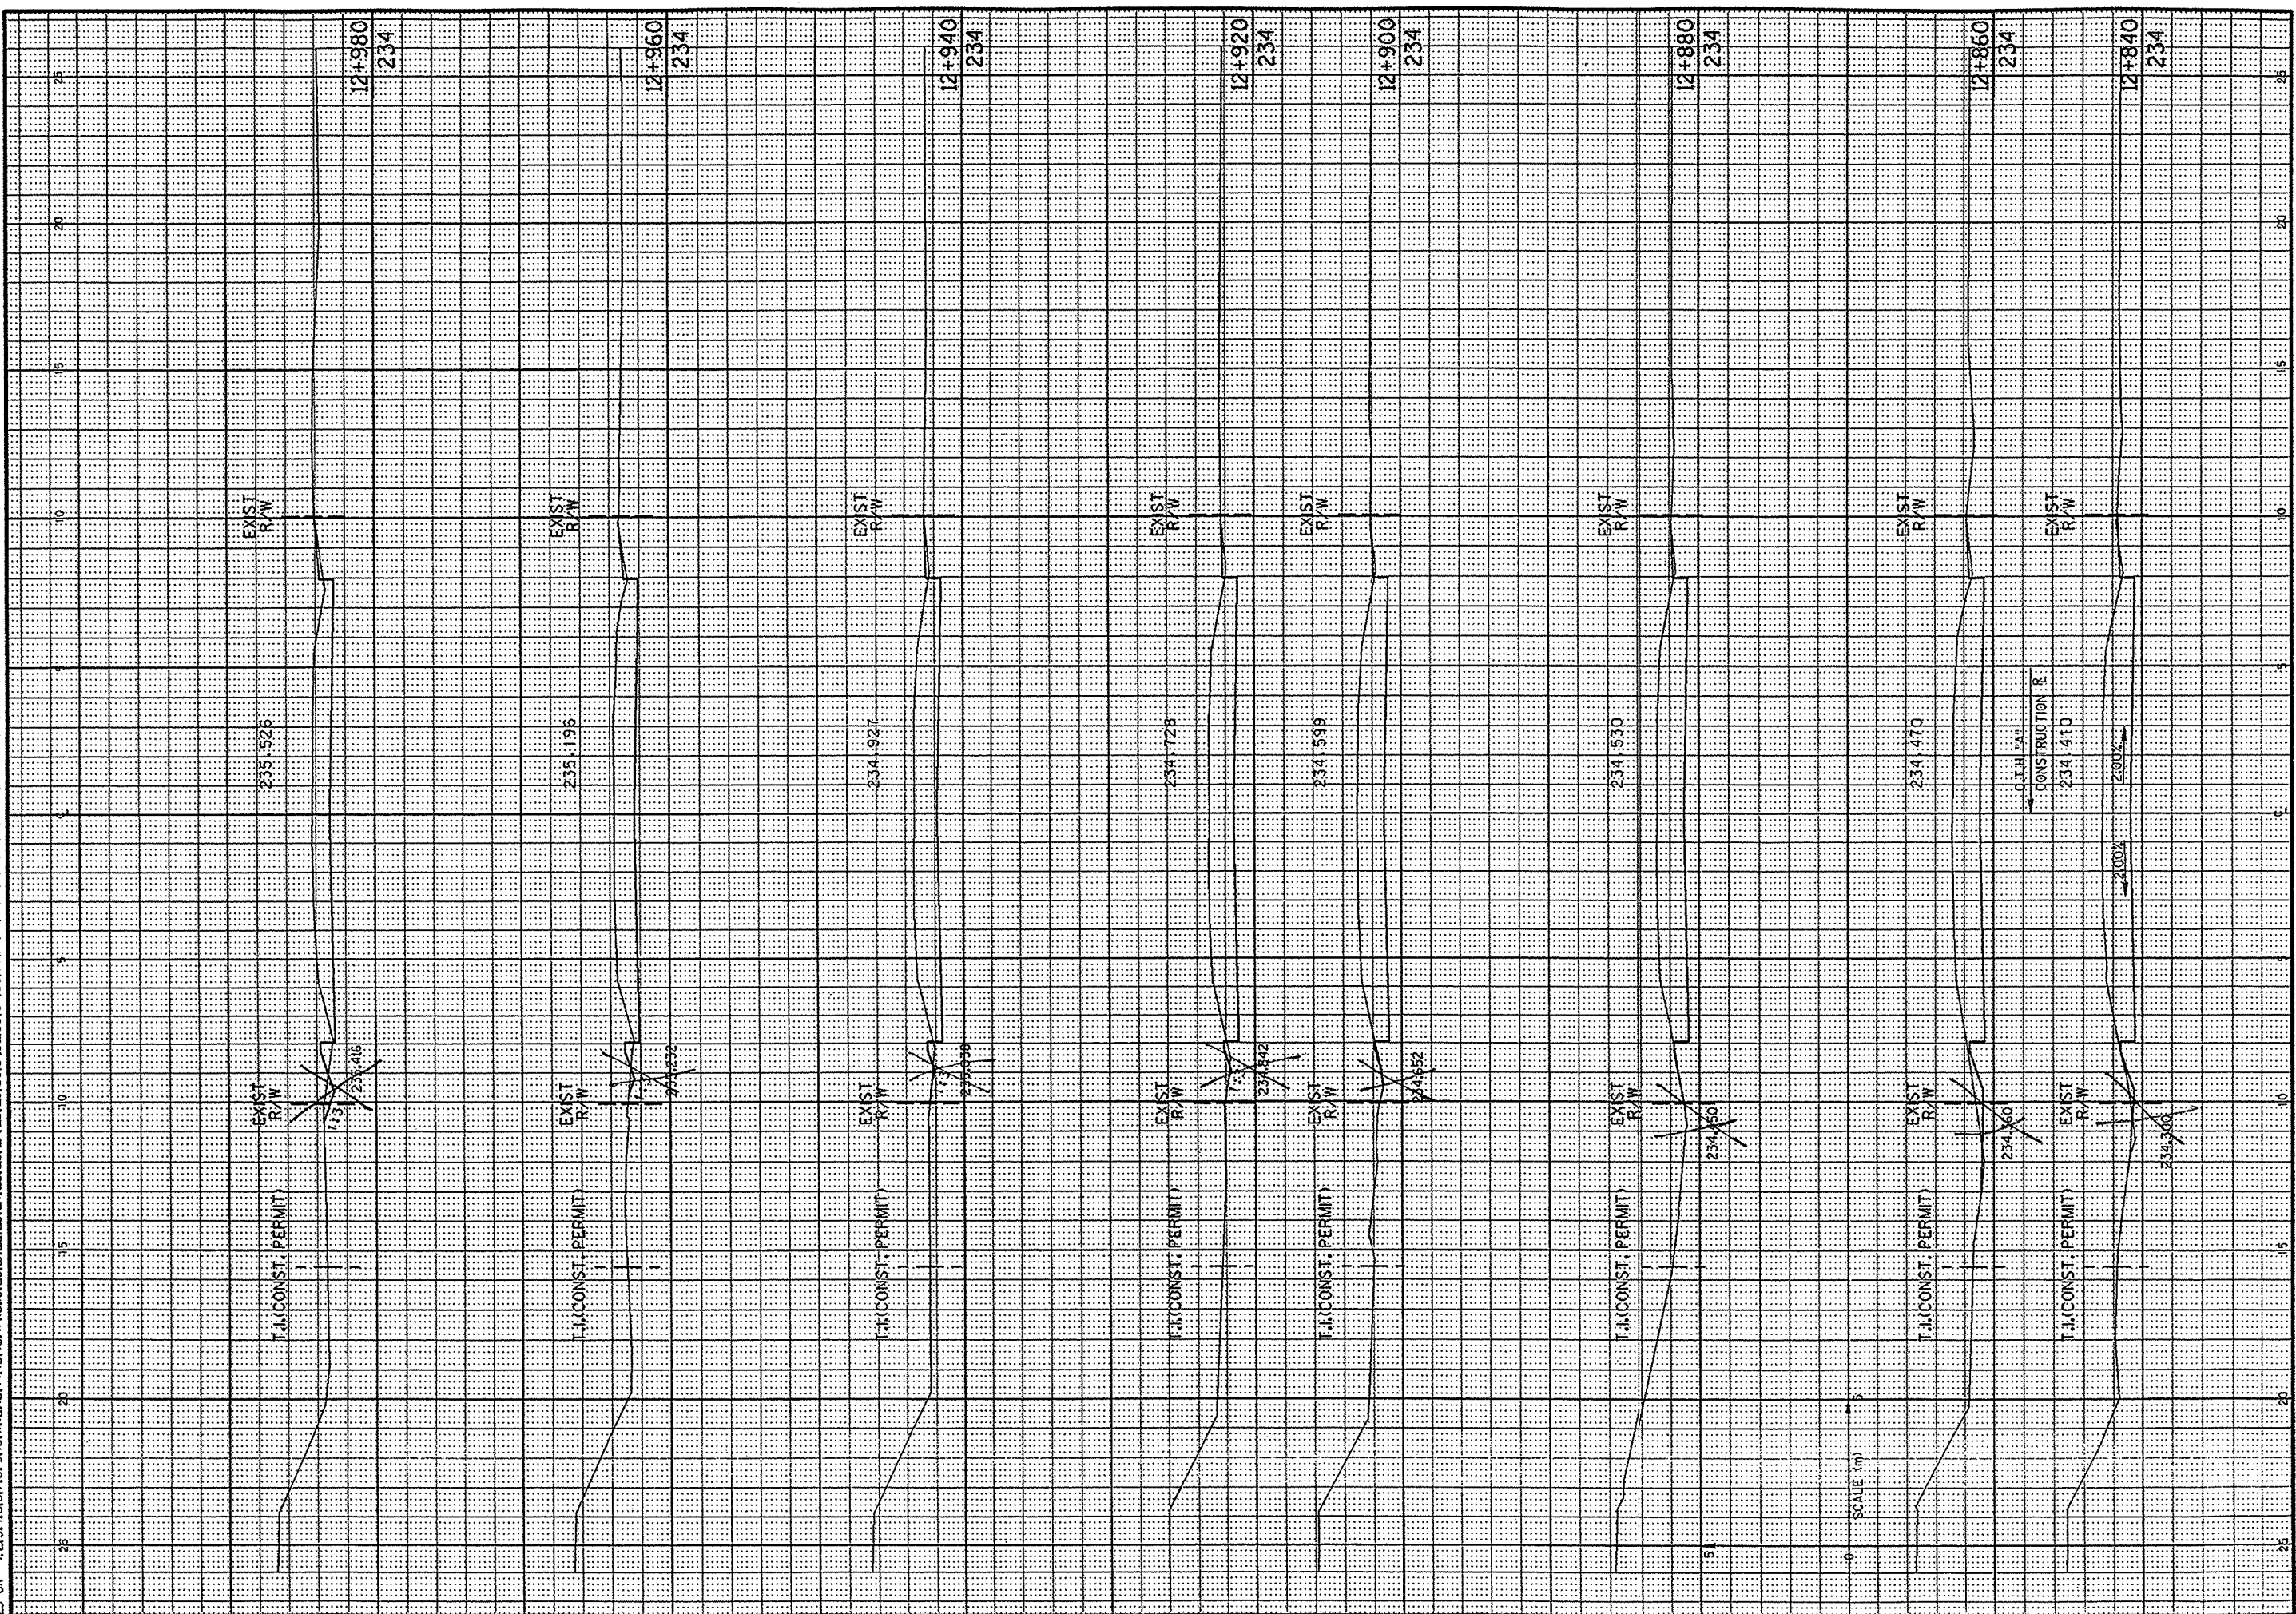

CROSS SECTION

HWY: C.T.H. "A"

COUNTY: WINNEBAGO

STATE PROJECT NO: 4994-00-82


SHEET NO: 9.20 M

FILE NAME:

WIEDOT: MSHT21

GB2
 PEN TABLE = #plot72hoser+mhafxs.tbl
 DATE OF PLOT = 11/24/98
 PLOT NAME = P:\LASERA3\ARCO2000\LPFF
 DGN FILE = I:\440278\dgn\ysec\rc020001.dgn

ORIGINATOR:
 LEVELS ON = 1, 2, 3, 61, 62

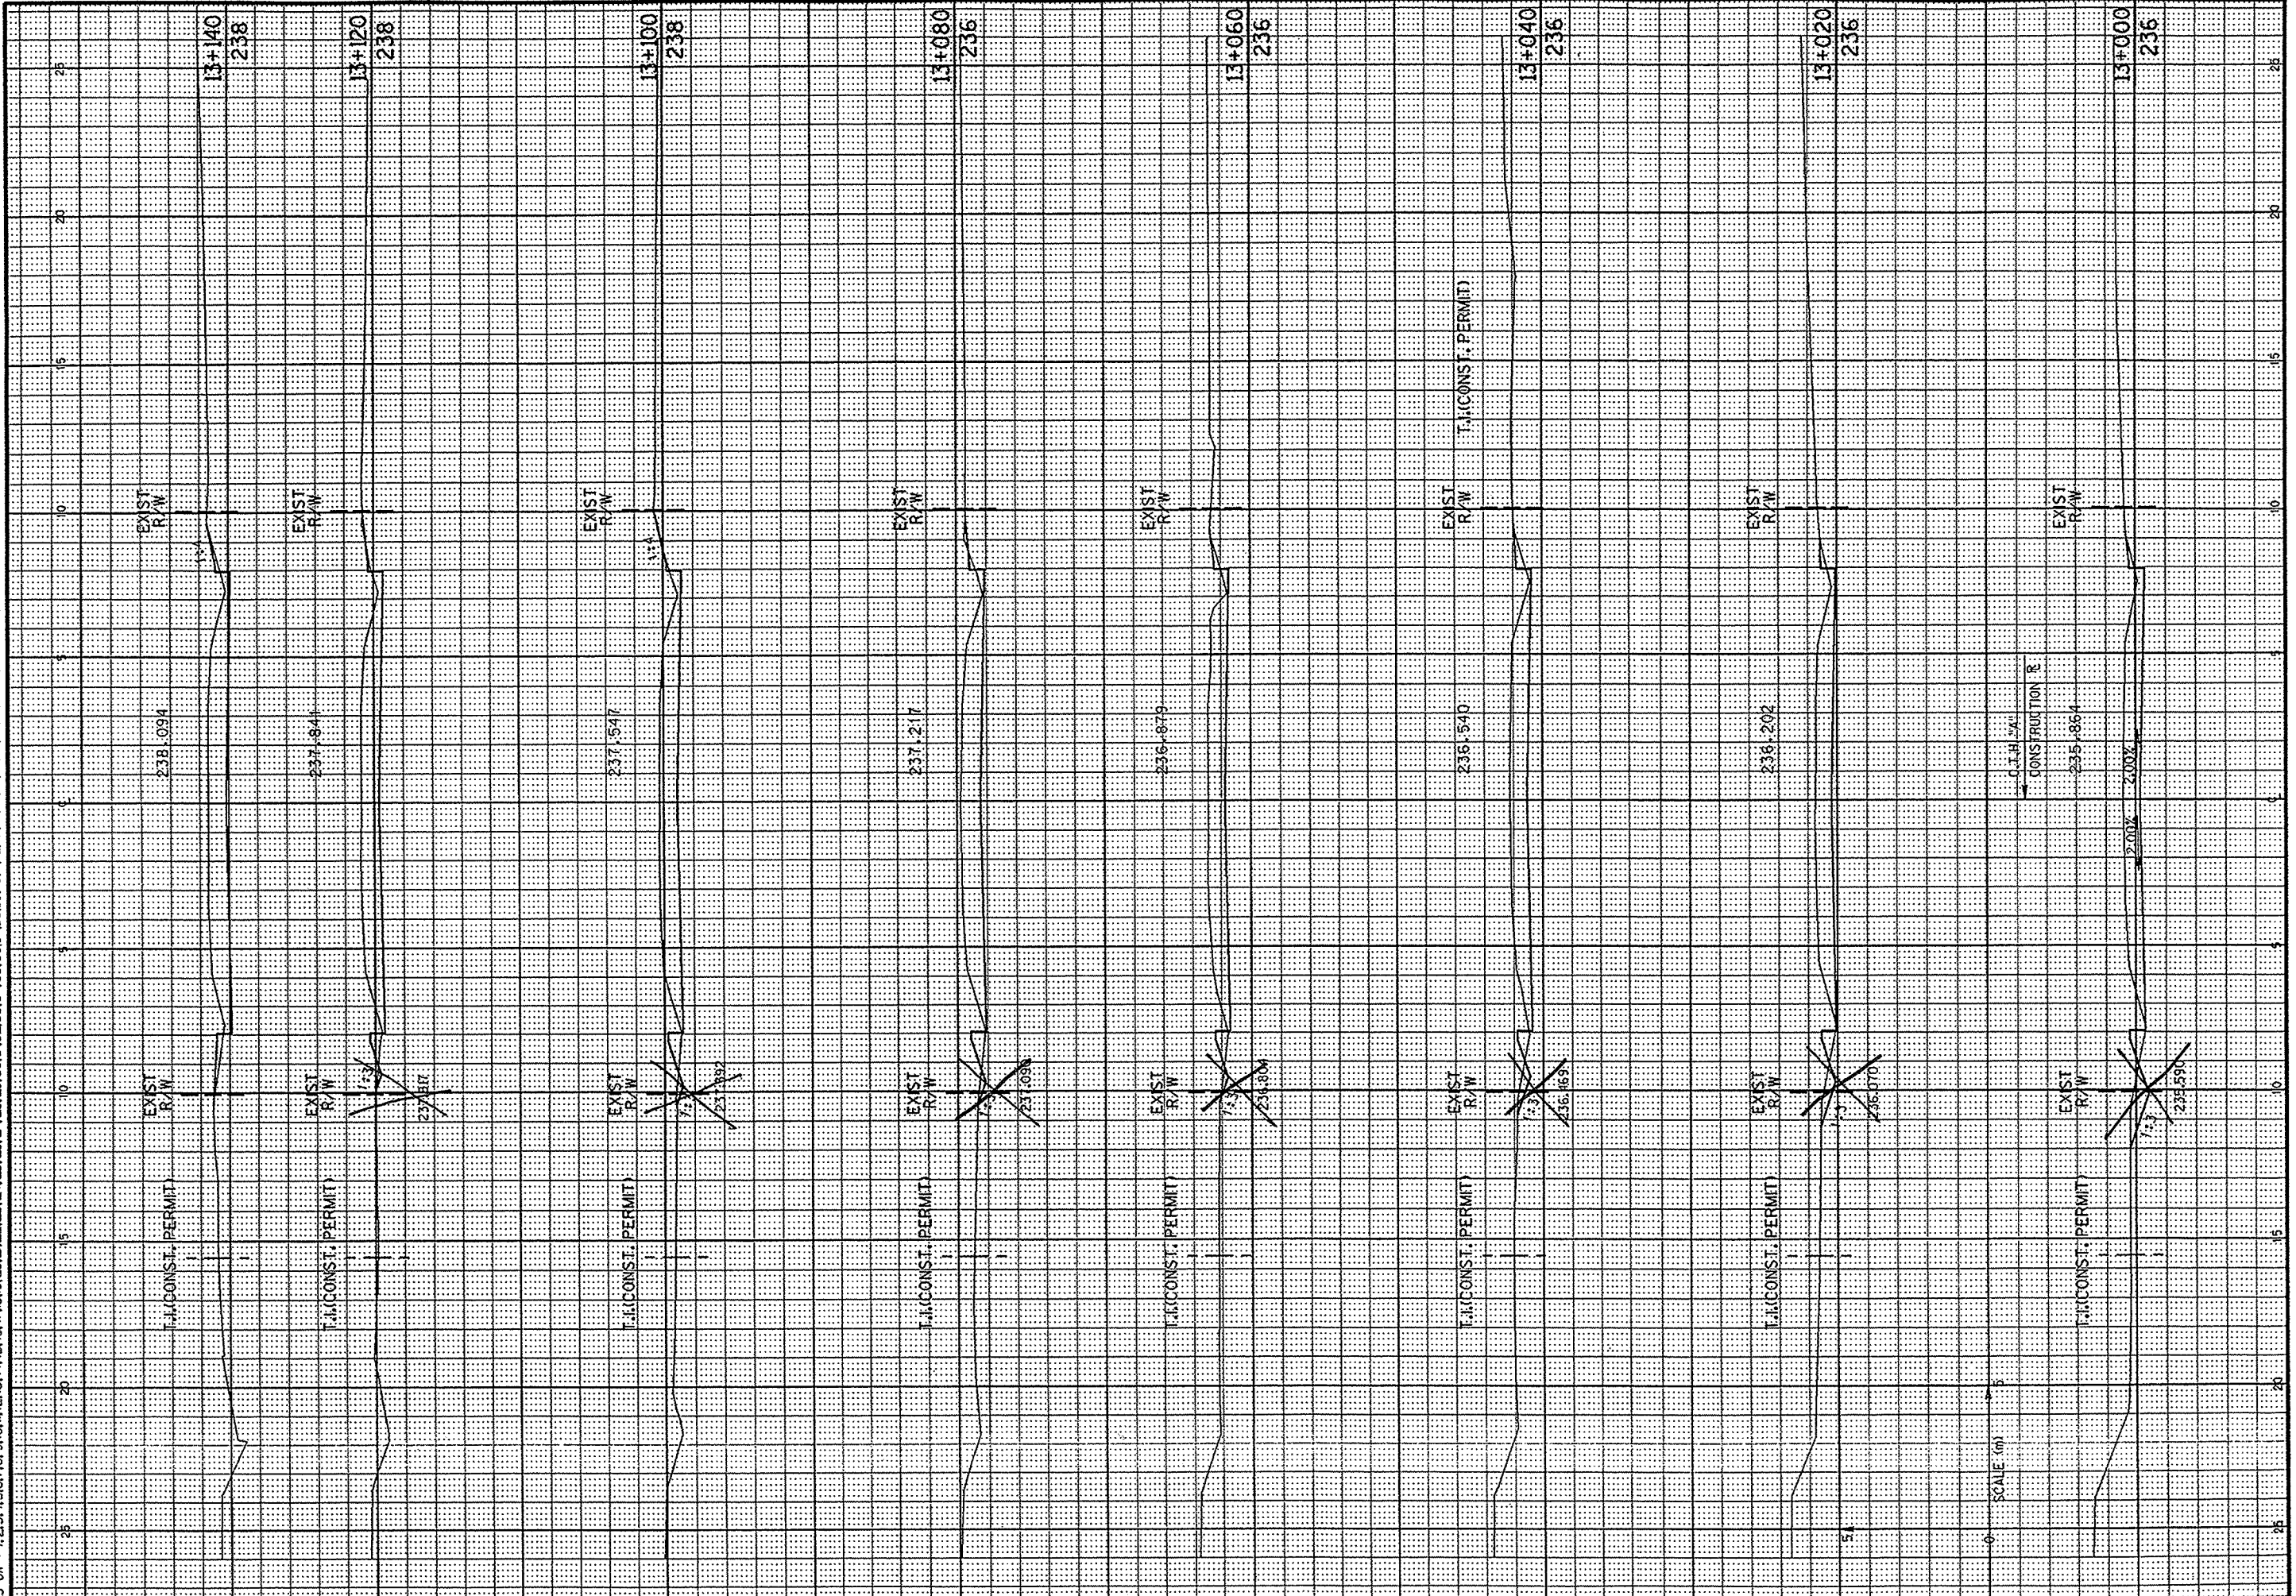

CROSS SECTION

HWY: C.T.H. "A"

COUNTY: WINNEBAGO

STATE PROJECT NO: 4994-00-82

SHEET NO: 9.21 M

FILE NAME:

WISDOT: MSHT.21

GB2
 PEN TABLE = #plot72user\mhd\fxs.tbl
 DATE OF PLOT = 11/24/98
 PLOT NAME = P:\LA\SERA3\RC02\001.PRF
 DGN FILE = P:\440278\dgn\1\ysec\RC02\001.dgn

ORIGINATOR:
 LEVELS ON = 1, 2, 3, 4, 5, 6, 7, 8, 9, 10, 11, 12, 13, 14, 15, 17, 18, 19, 61, 62



CROSS SECTION

HWY: C.T.H. "A"

COUNTY: WINNEBAGO

STATE PROJECT NO: 4994-00-82


SHEET NO: 9.22 M

FILE NAME:

WI&DOT: MSHT21


CB2
 PEN TABLE = splo1721user-amholifxs.tbl
 DATE OF PLOT 11/24/98
 PLOT NAME = P:\LASERA3\RC02200LPRF
 DGN FILE = I:\440278\dgn\ysec\rc022001.dgn

ORIGINATOR:
 LEVELS ON = 1, 2, 3, 4, 5, 6, 7, 8, 9, 10, 11, 12, 13, 14, 15, 17, 18, 19, 61, 62.
 FILE NAME:

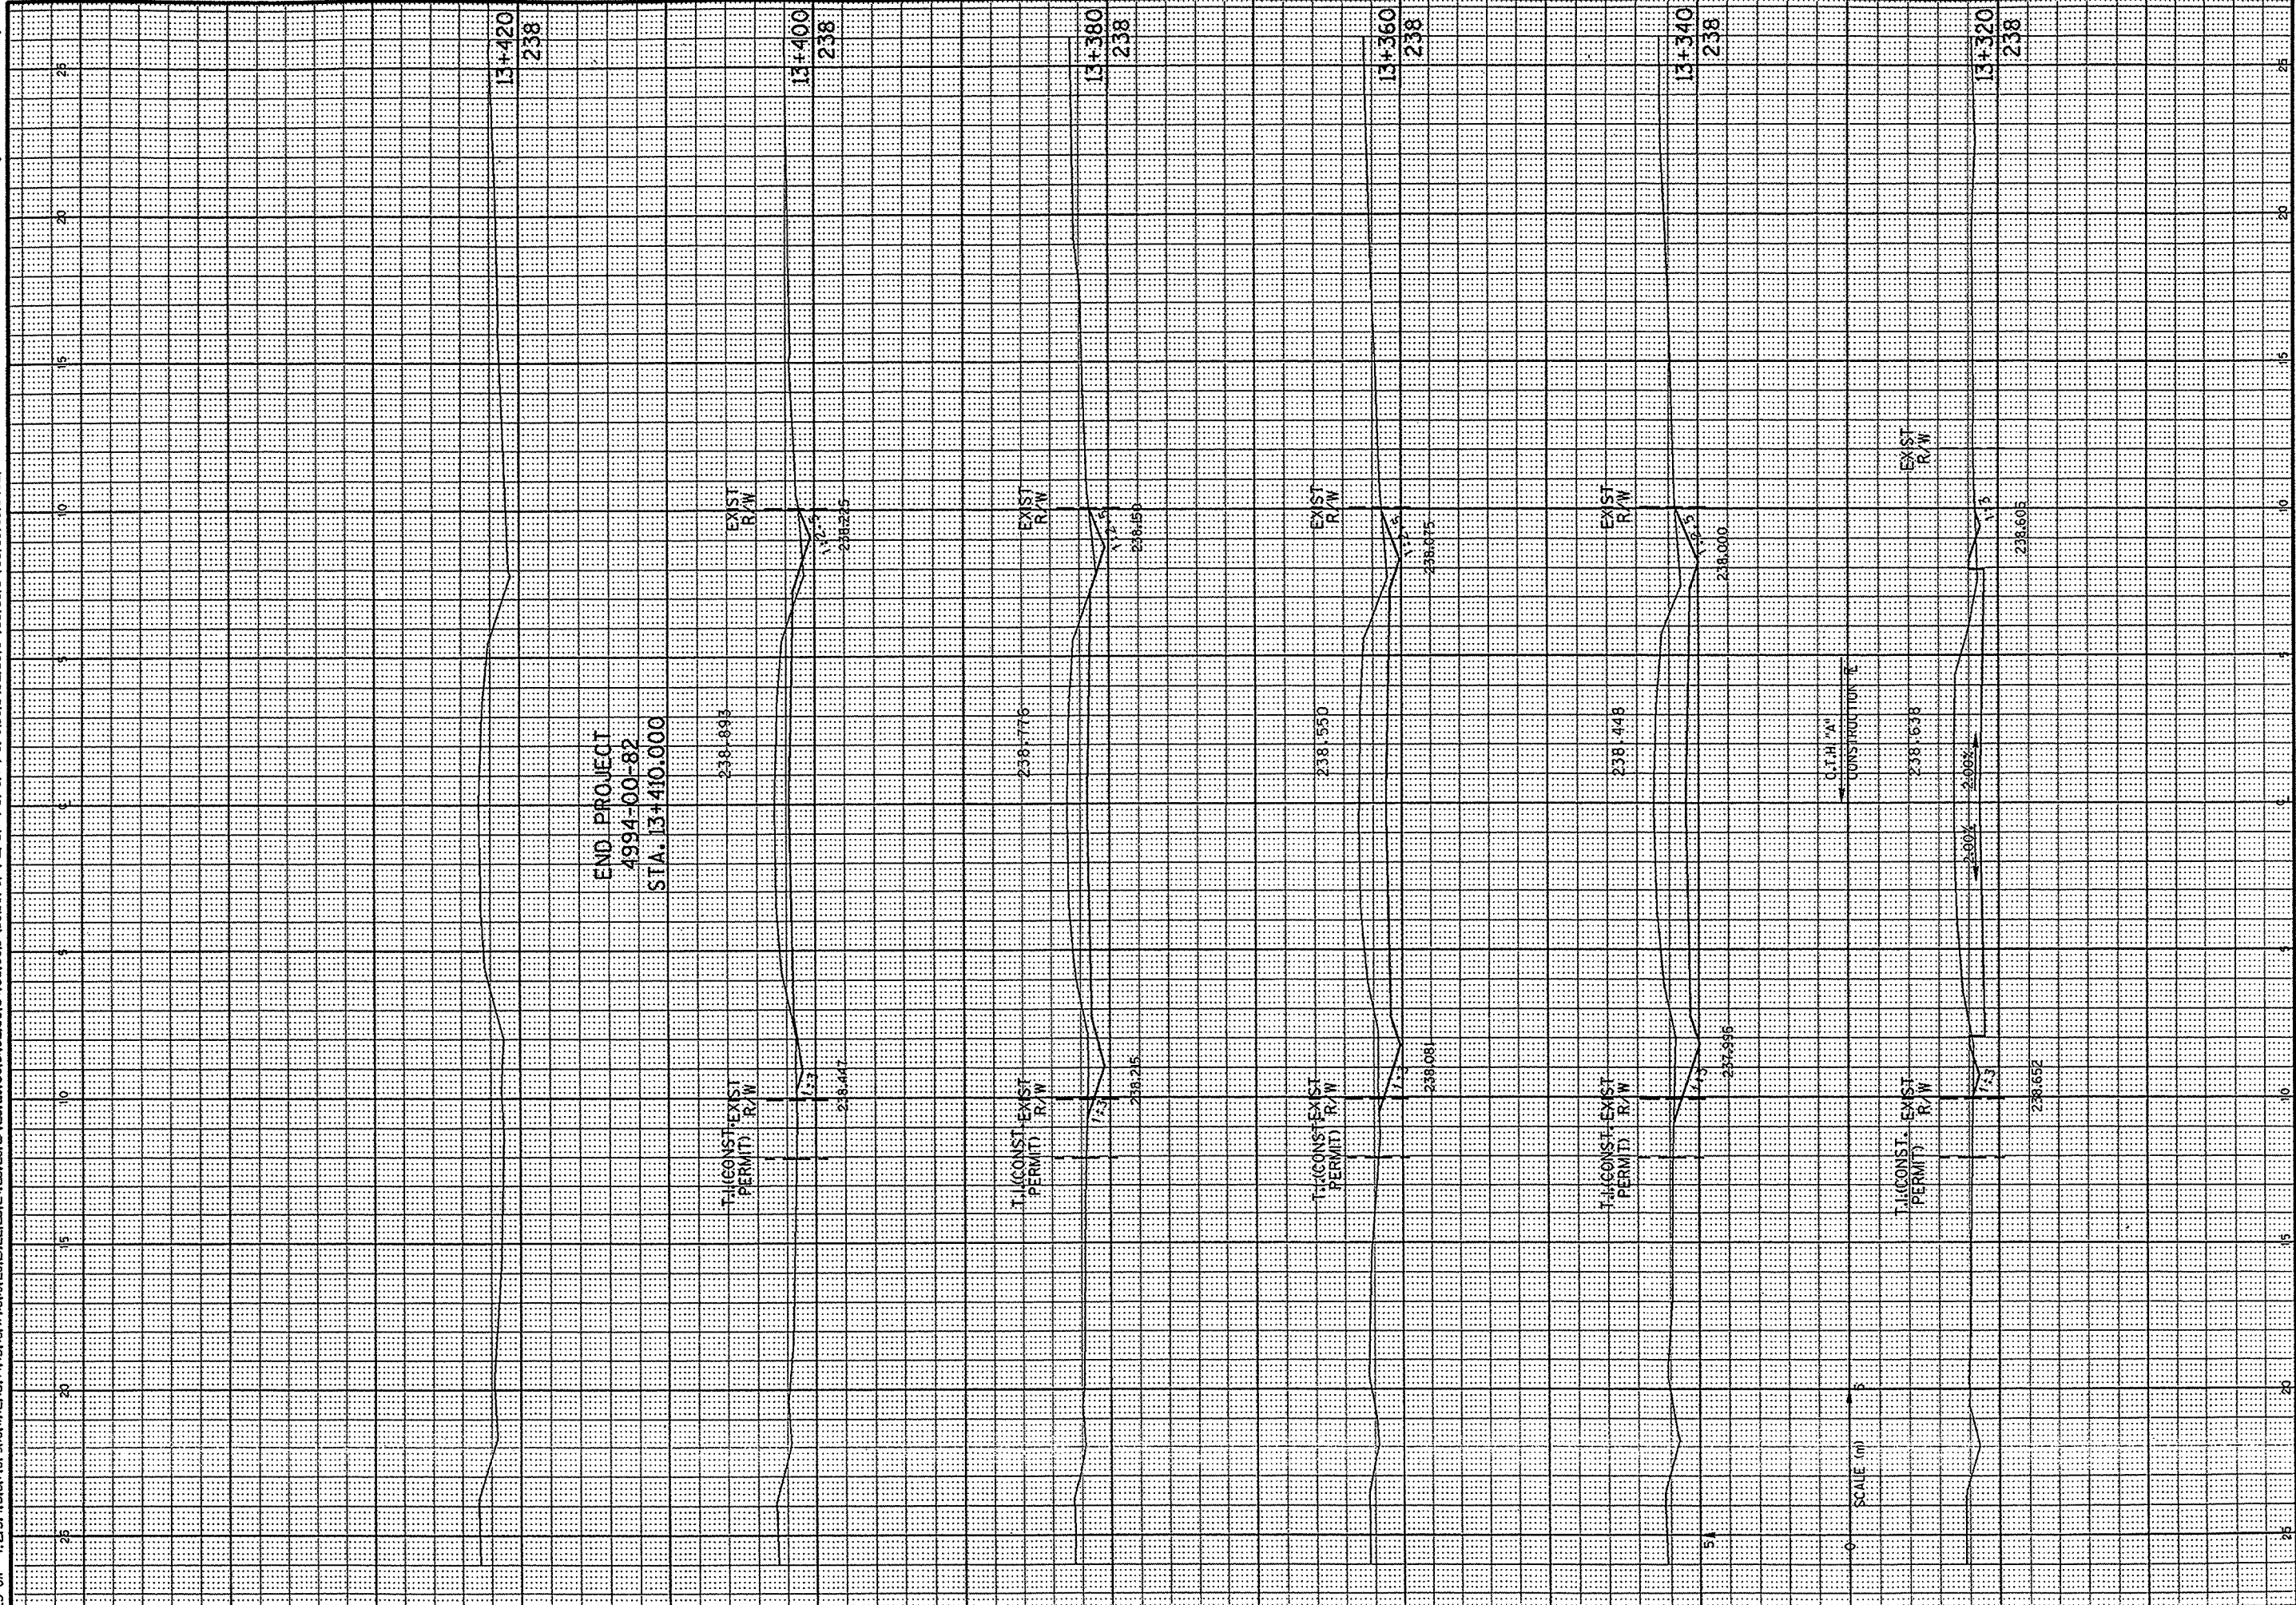

GBZ
PEN TABLE = #plot72\loser=nhof\fxs.tbl
DATE OF PLOT = 11/24/98
PLOT NAME = P:\LA\SERA3\RCC00002.PRF
DGN FILE = P:\440278\dgn\ysec\Y600002.dgn

ORIGINATOR:
LEVELS ON = 1, 2, 3, 60, 61.

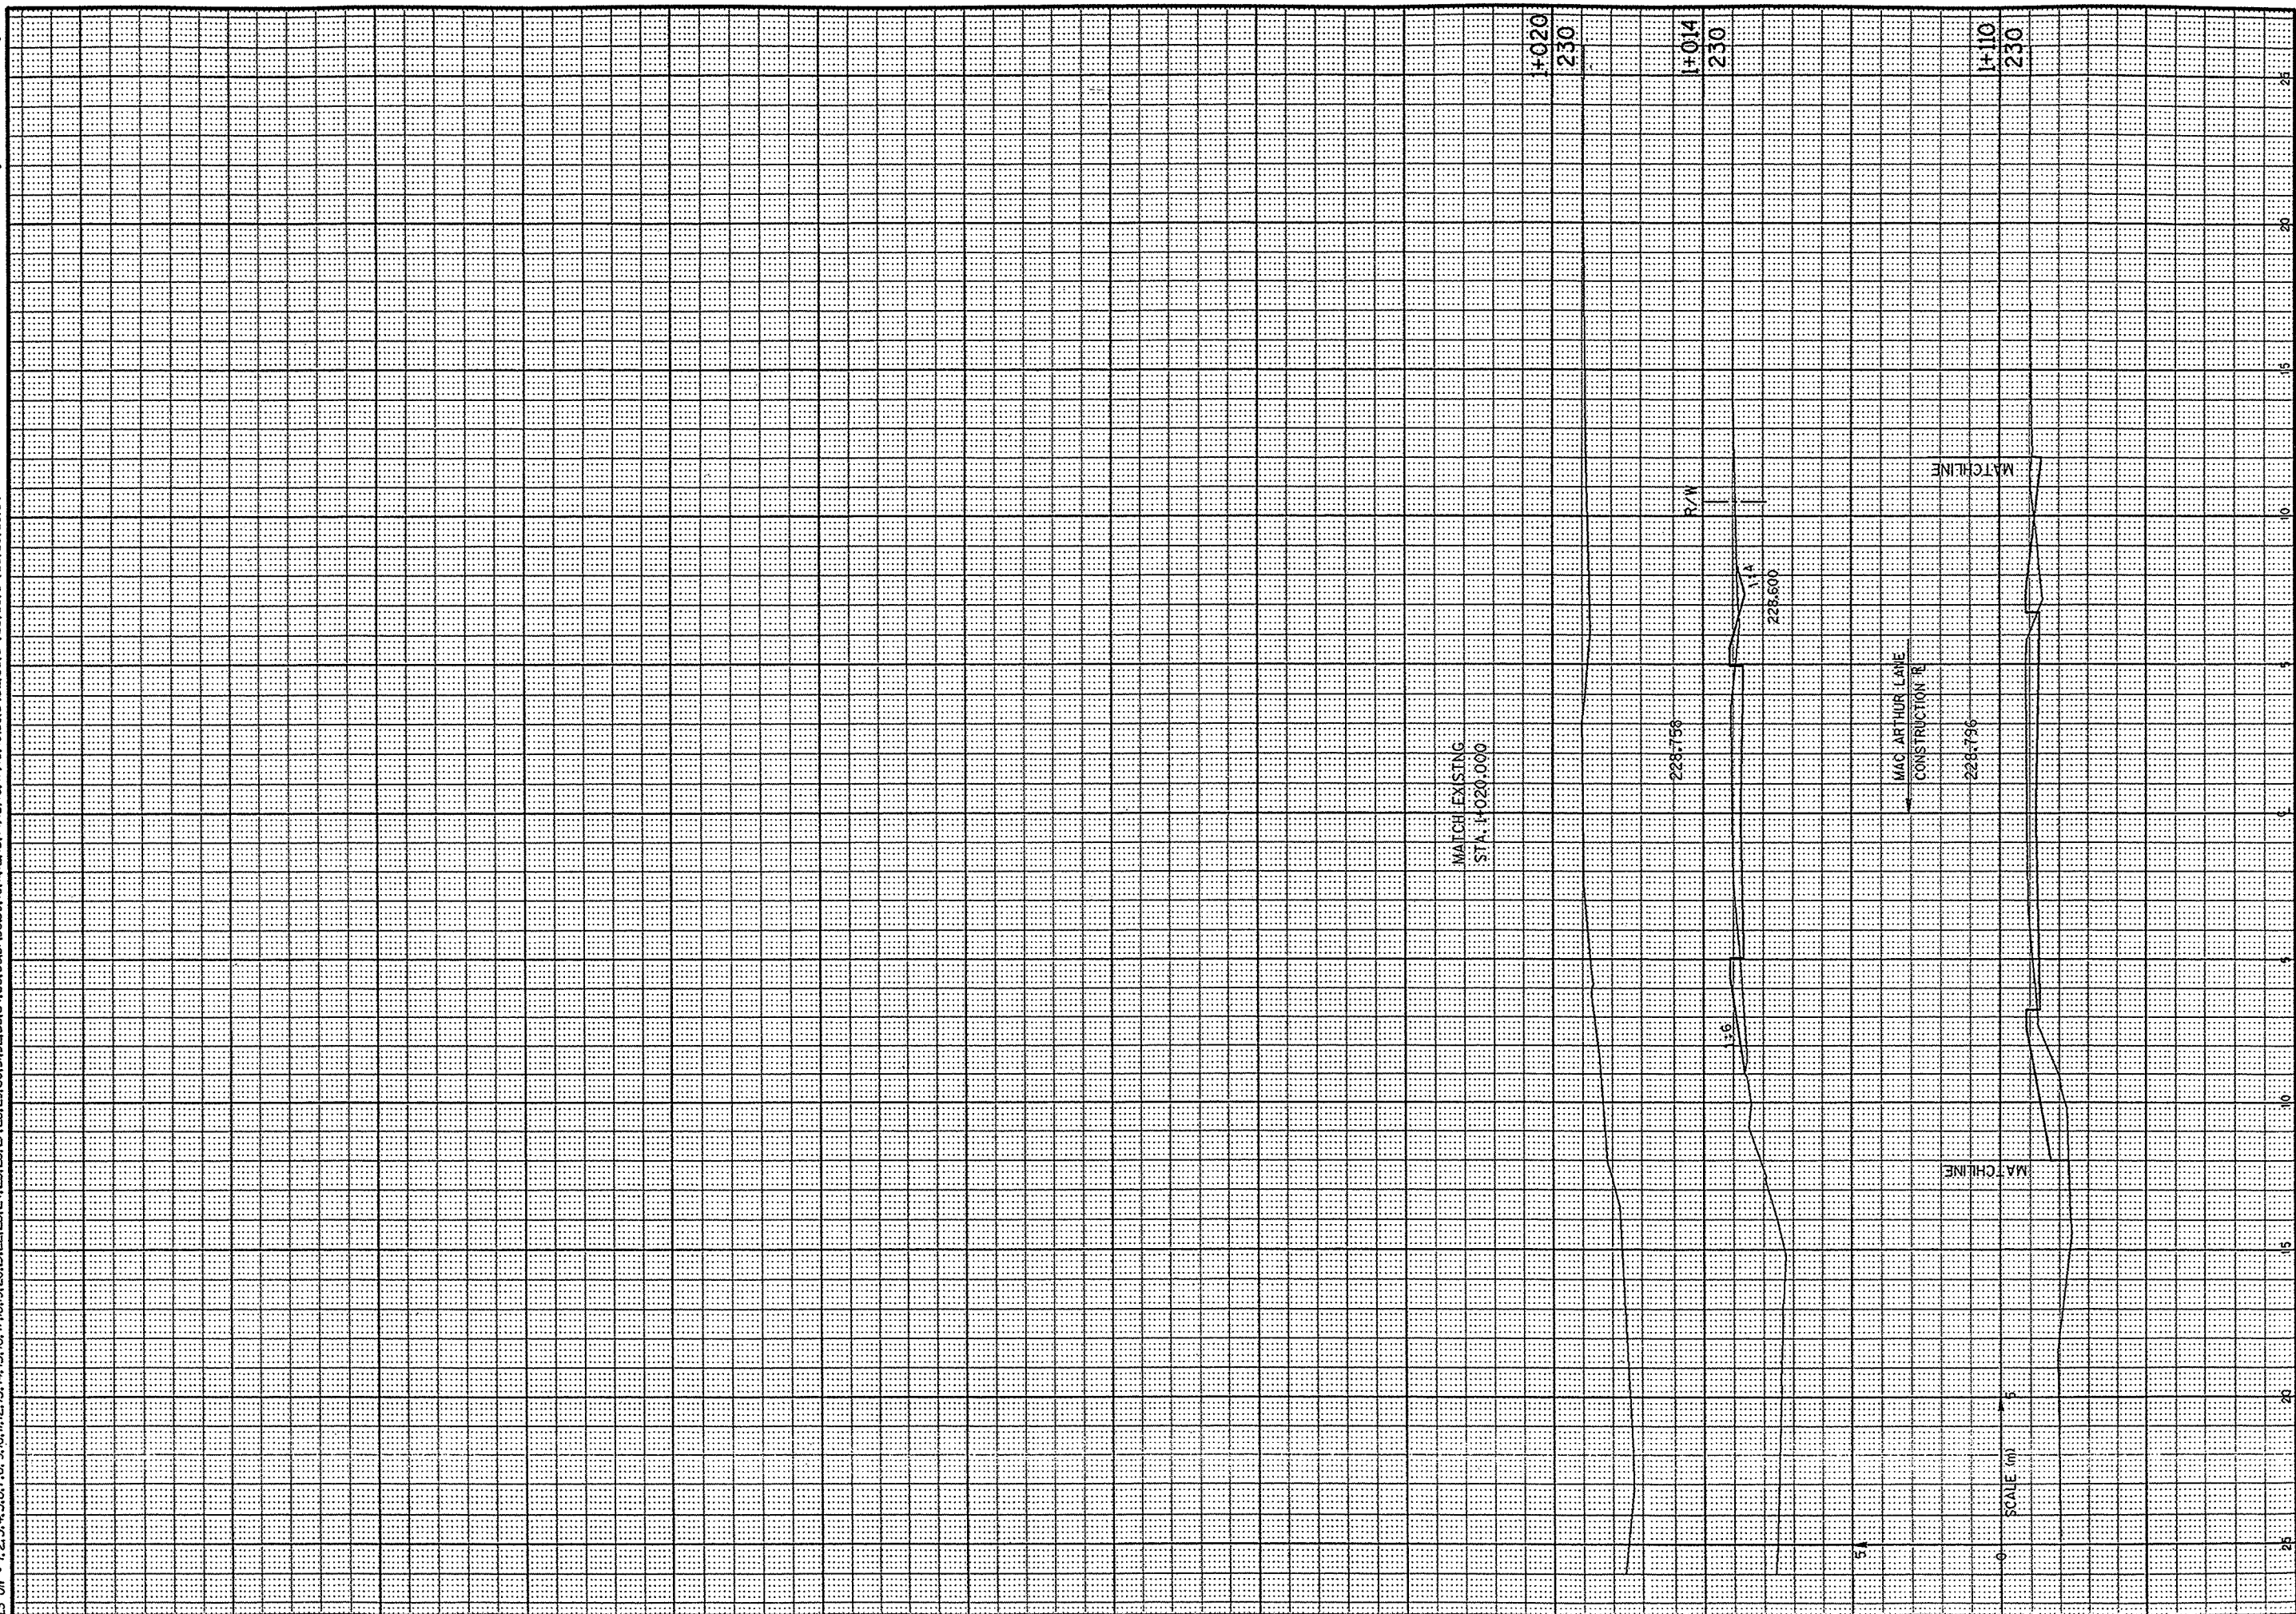

CROSS SECTION

HWY: MAC ARTHUR LANE

COUNTY: WINNEBAGO

STATE PROJECT NO: 4994-00-78


SHEET NO: 9.24 M

FILE NAME:

WI6DOT: MSMT21

CB2
 PEN TABLE = #plot72hoseramhalfxs.tbl
 DATE OF PLOT = 11/24/98
 PLOT NAME = P:\LASERA\HRC000003.PRF
 DGN FILE = I:\440278\gpn\sscc\c000003.dgn

ORIGINATOR:
 LEVELS ON = 1, 2, 3, 61, 62

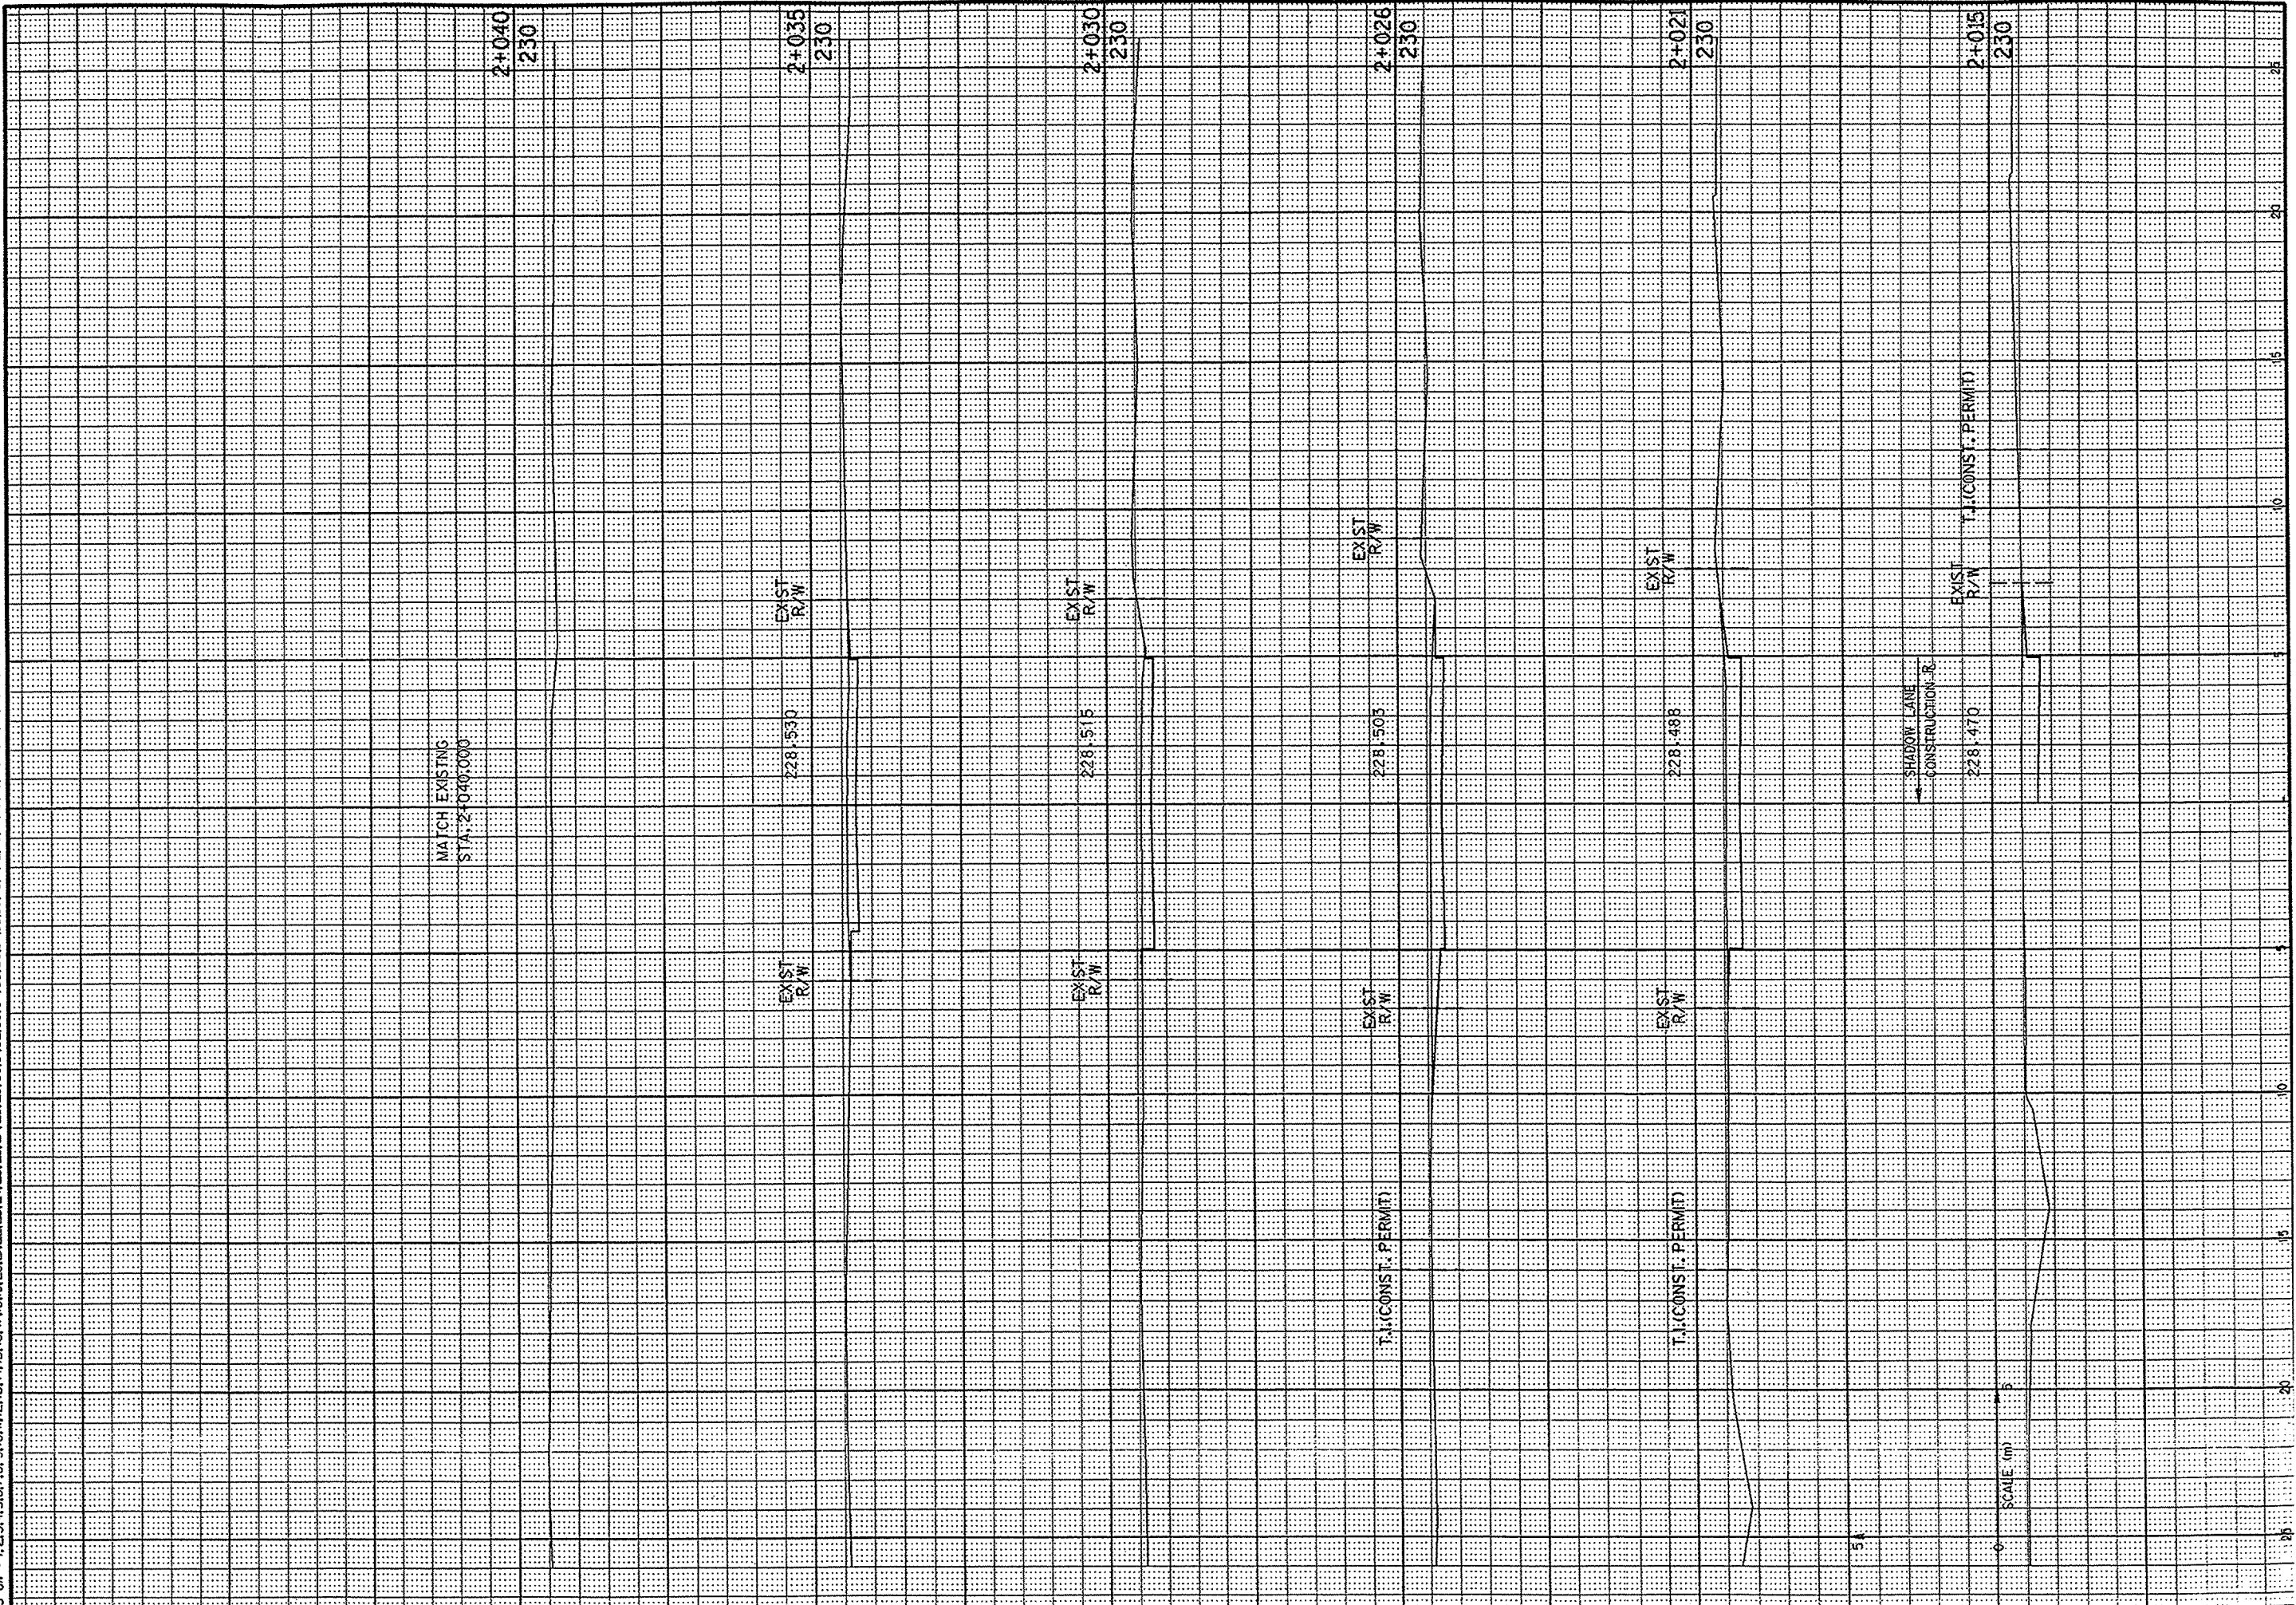

CROSS SECTION

HWY: SHADOW LANE

COUNTY: WINNEBAGO

STATE PROJECT NO: 4994-00-78

SHEET NO: 9, 25 M

WISDOT: MSHT2


GB2
 PEN TABLE = #Plot72\user\mhdf\fs.tbl
 DATE OF PLOT = 11/24/98
 PLOT NAME = P:\LASERA\HRC001004.PRF
 DGN FILE = I:\440278\dgn\ysec\rc001004.dgn

ORIGINATOR:
 LEVELS ON = 1, 2, 3, 61, 62



CB2
 PEN TABLE = #Plot72laser.tbl
 DATE OF PLOT = 11/24/98
 PLOT NAME = P:\LASERA\ARC001005.PRF
 DGN FILE = I:\440278\dgn\ysec\rc001005.dgn

ORIGINAL TOR: LEVELS ON = 1, 2, 3, 61, 62

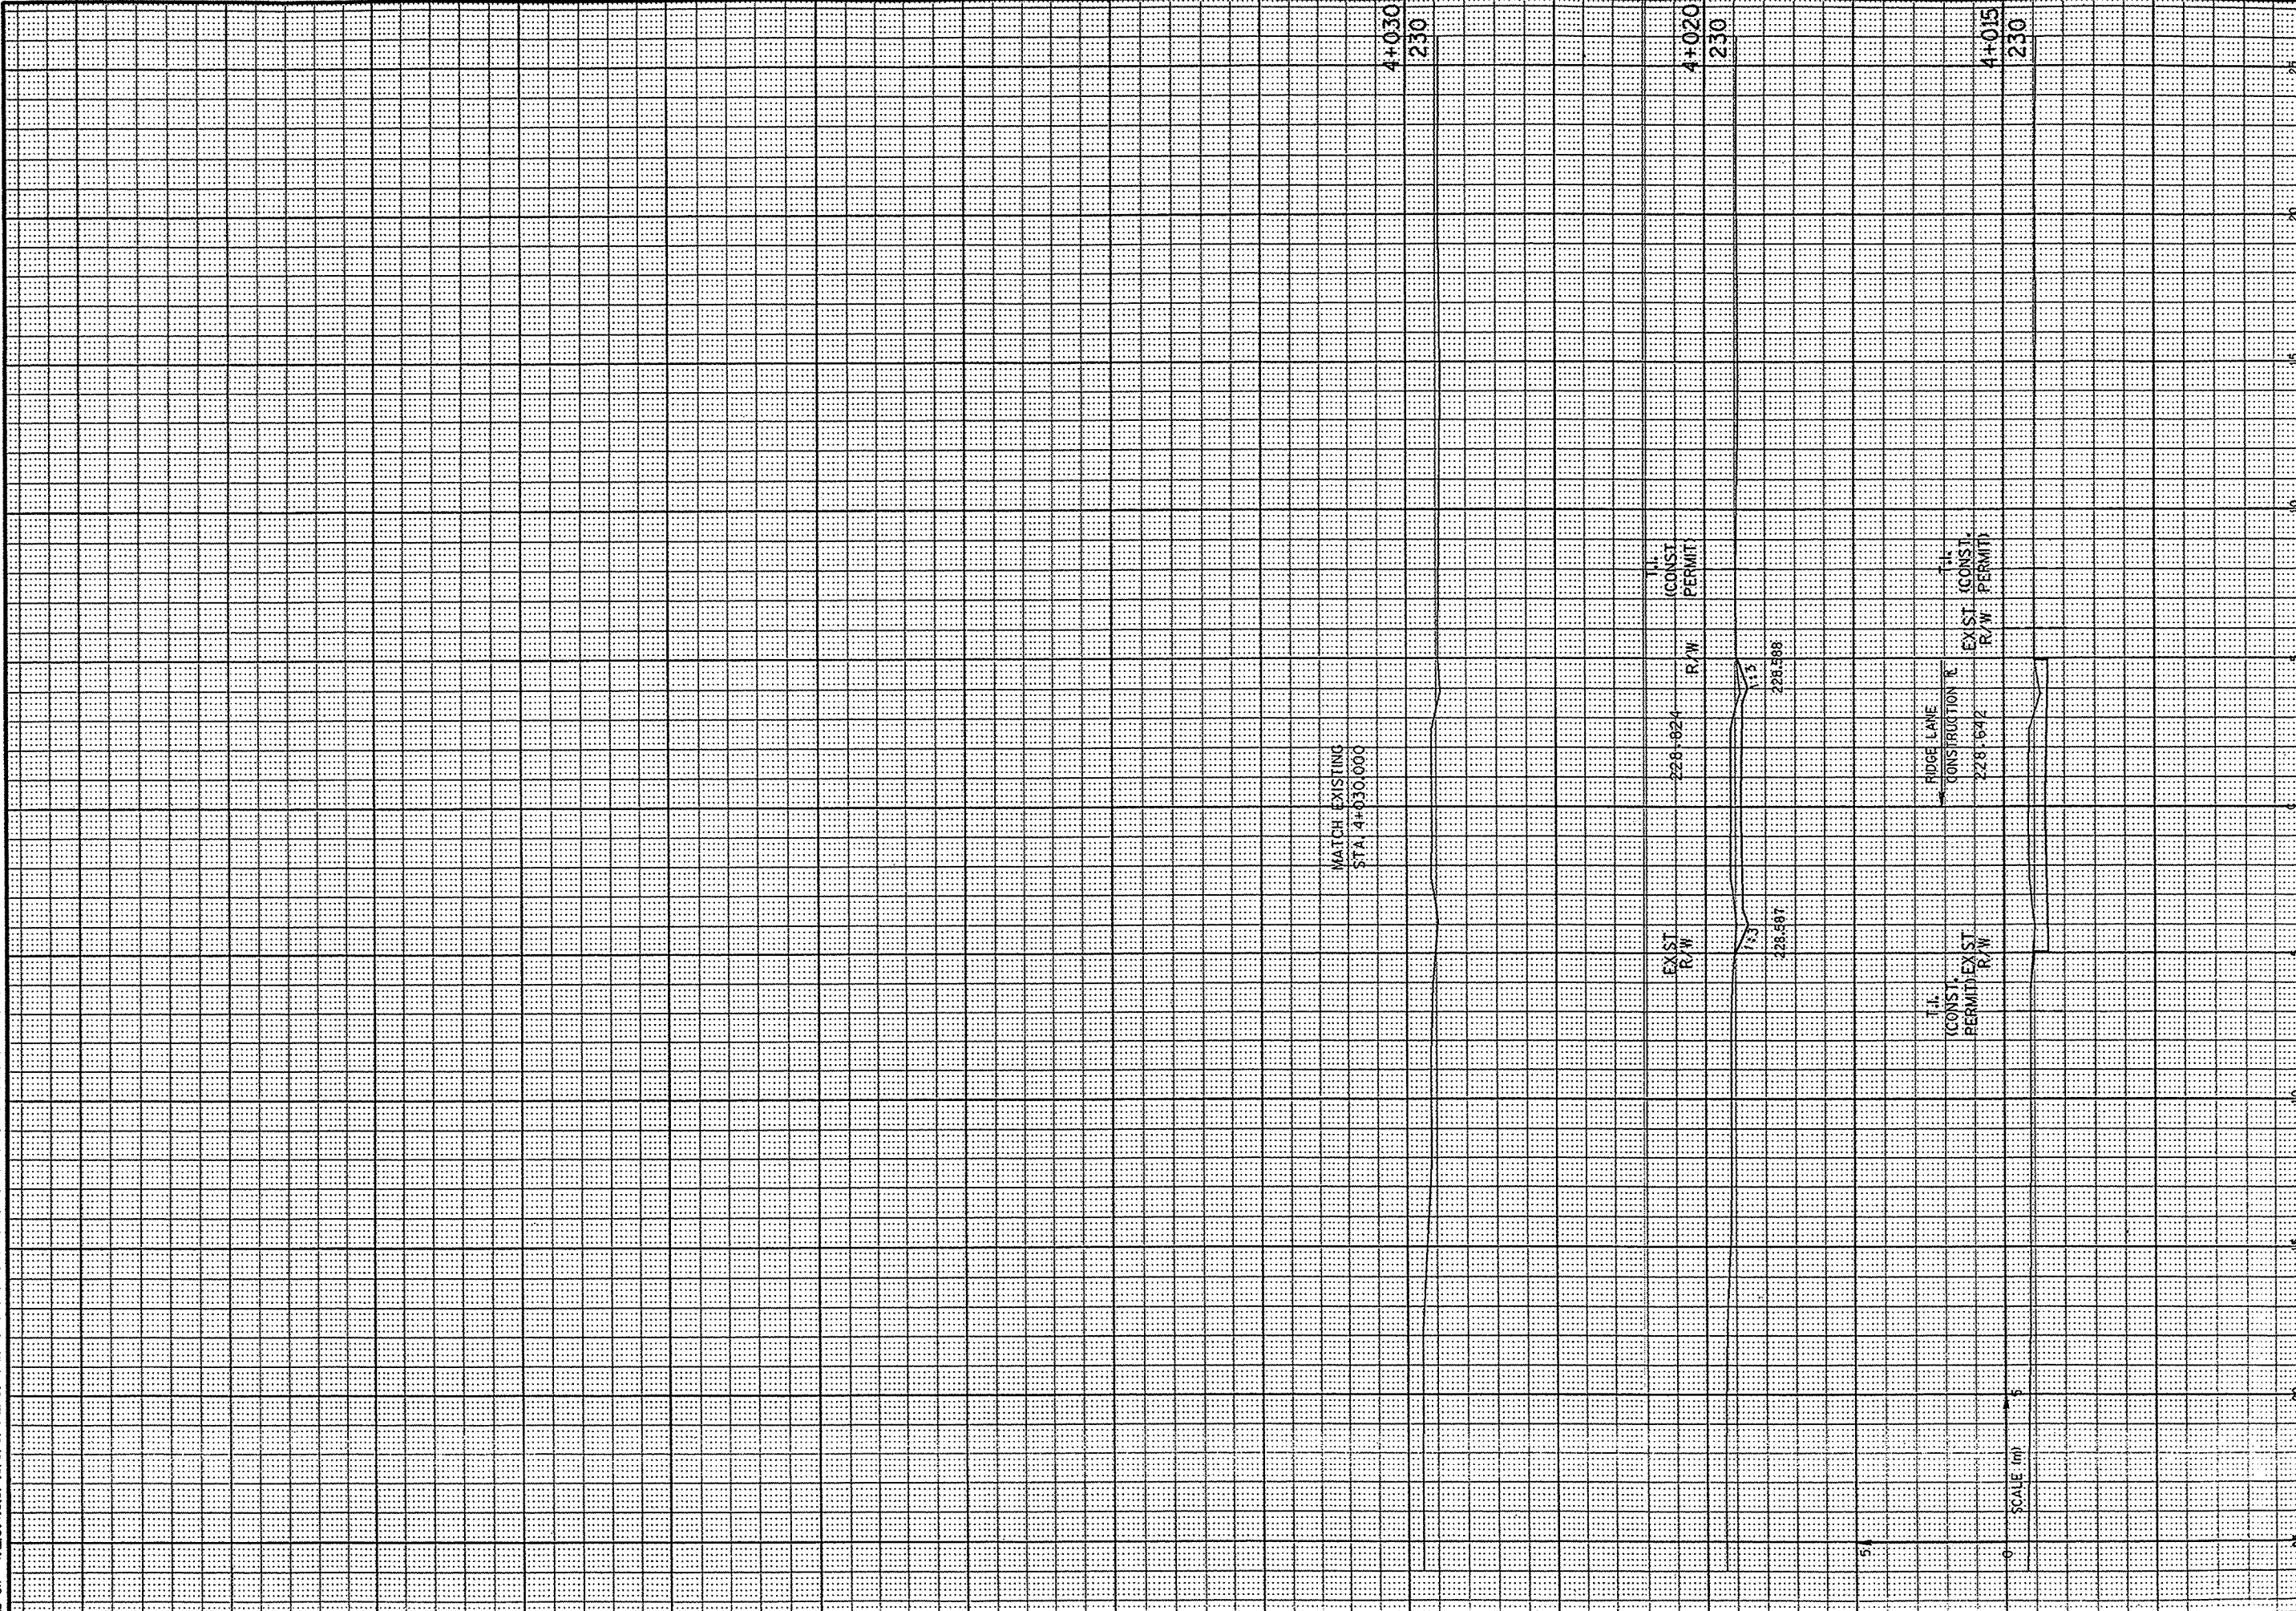

CROSS SECTION

HWY: RIDGE LANE

COUNTY: WINNEBAGO

STATE PROJECT NO: 4994-00-78

SHEET NO: 9.27 M

FILE NAME:

WISDOT: MSHT21

CG2
PEN TABLE = #plot721user-mp-hofx.tbl
DATE OF PLOT = 11/24/98
PLOT NAME = P:\LASERA3\RC000006.PRF
DCN FILE = P:\440278\dgm\ysec\rc000006.dgn

ORIGINATOR:
LEVELS ON = 1, 2, 3, 60, 61.



CROSS SECTION

HWY: KEENVILLE AVENUE

COUNTY: WINNEBAGO

STATE PROJECT NO: 4994-00-78

SHEET NO: 9.28

M

FILE NAME:

WI&DOT: MSHT21

OR2
PEN TABLE = #plot72doser-amhdfxs.tbl
DATE OF PLOT = 11/24/98
PLOT NAME = P:\LA\SERA3\RC000007.PRF
DGN FILE = P:\440278\dgn\ysec\rc000007.dgn

ORIGINATOR:
LEVELS ON = 1, 2, 3, 61, 62



CROSS SECTION

HWY: DRIFTWOOD LANE

COUNTY: WINNEBAGO

STATE PROJECT NO: 4994-00-78


SHEET NO: 9.29 M

FILE NAME:

WisDOT: MSHT21

CB2
 PEN TABLE = \$plot72\user\mhoif\ks.tbl
 DATE OF PLOT = 11/25/98
 PLOT NAME = P:\LASERA3\RC0001008.PRF
 DGN FILE = I:\440278\dgn\ksec\rc0001008.dgn

ORIGINATOR:
 LEVELS ON = 1, 2, 3, 61, 62

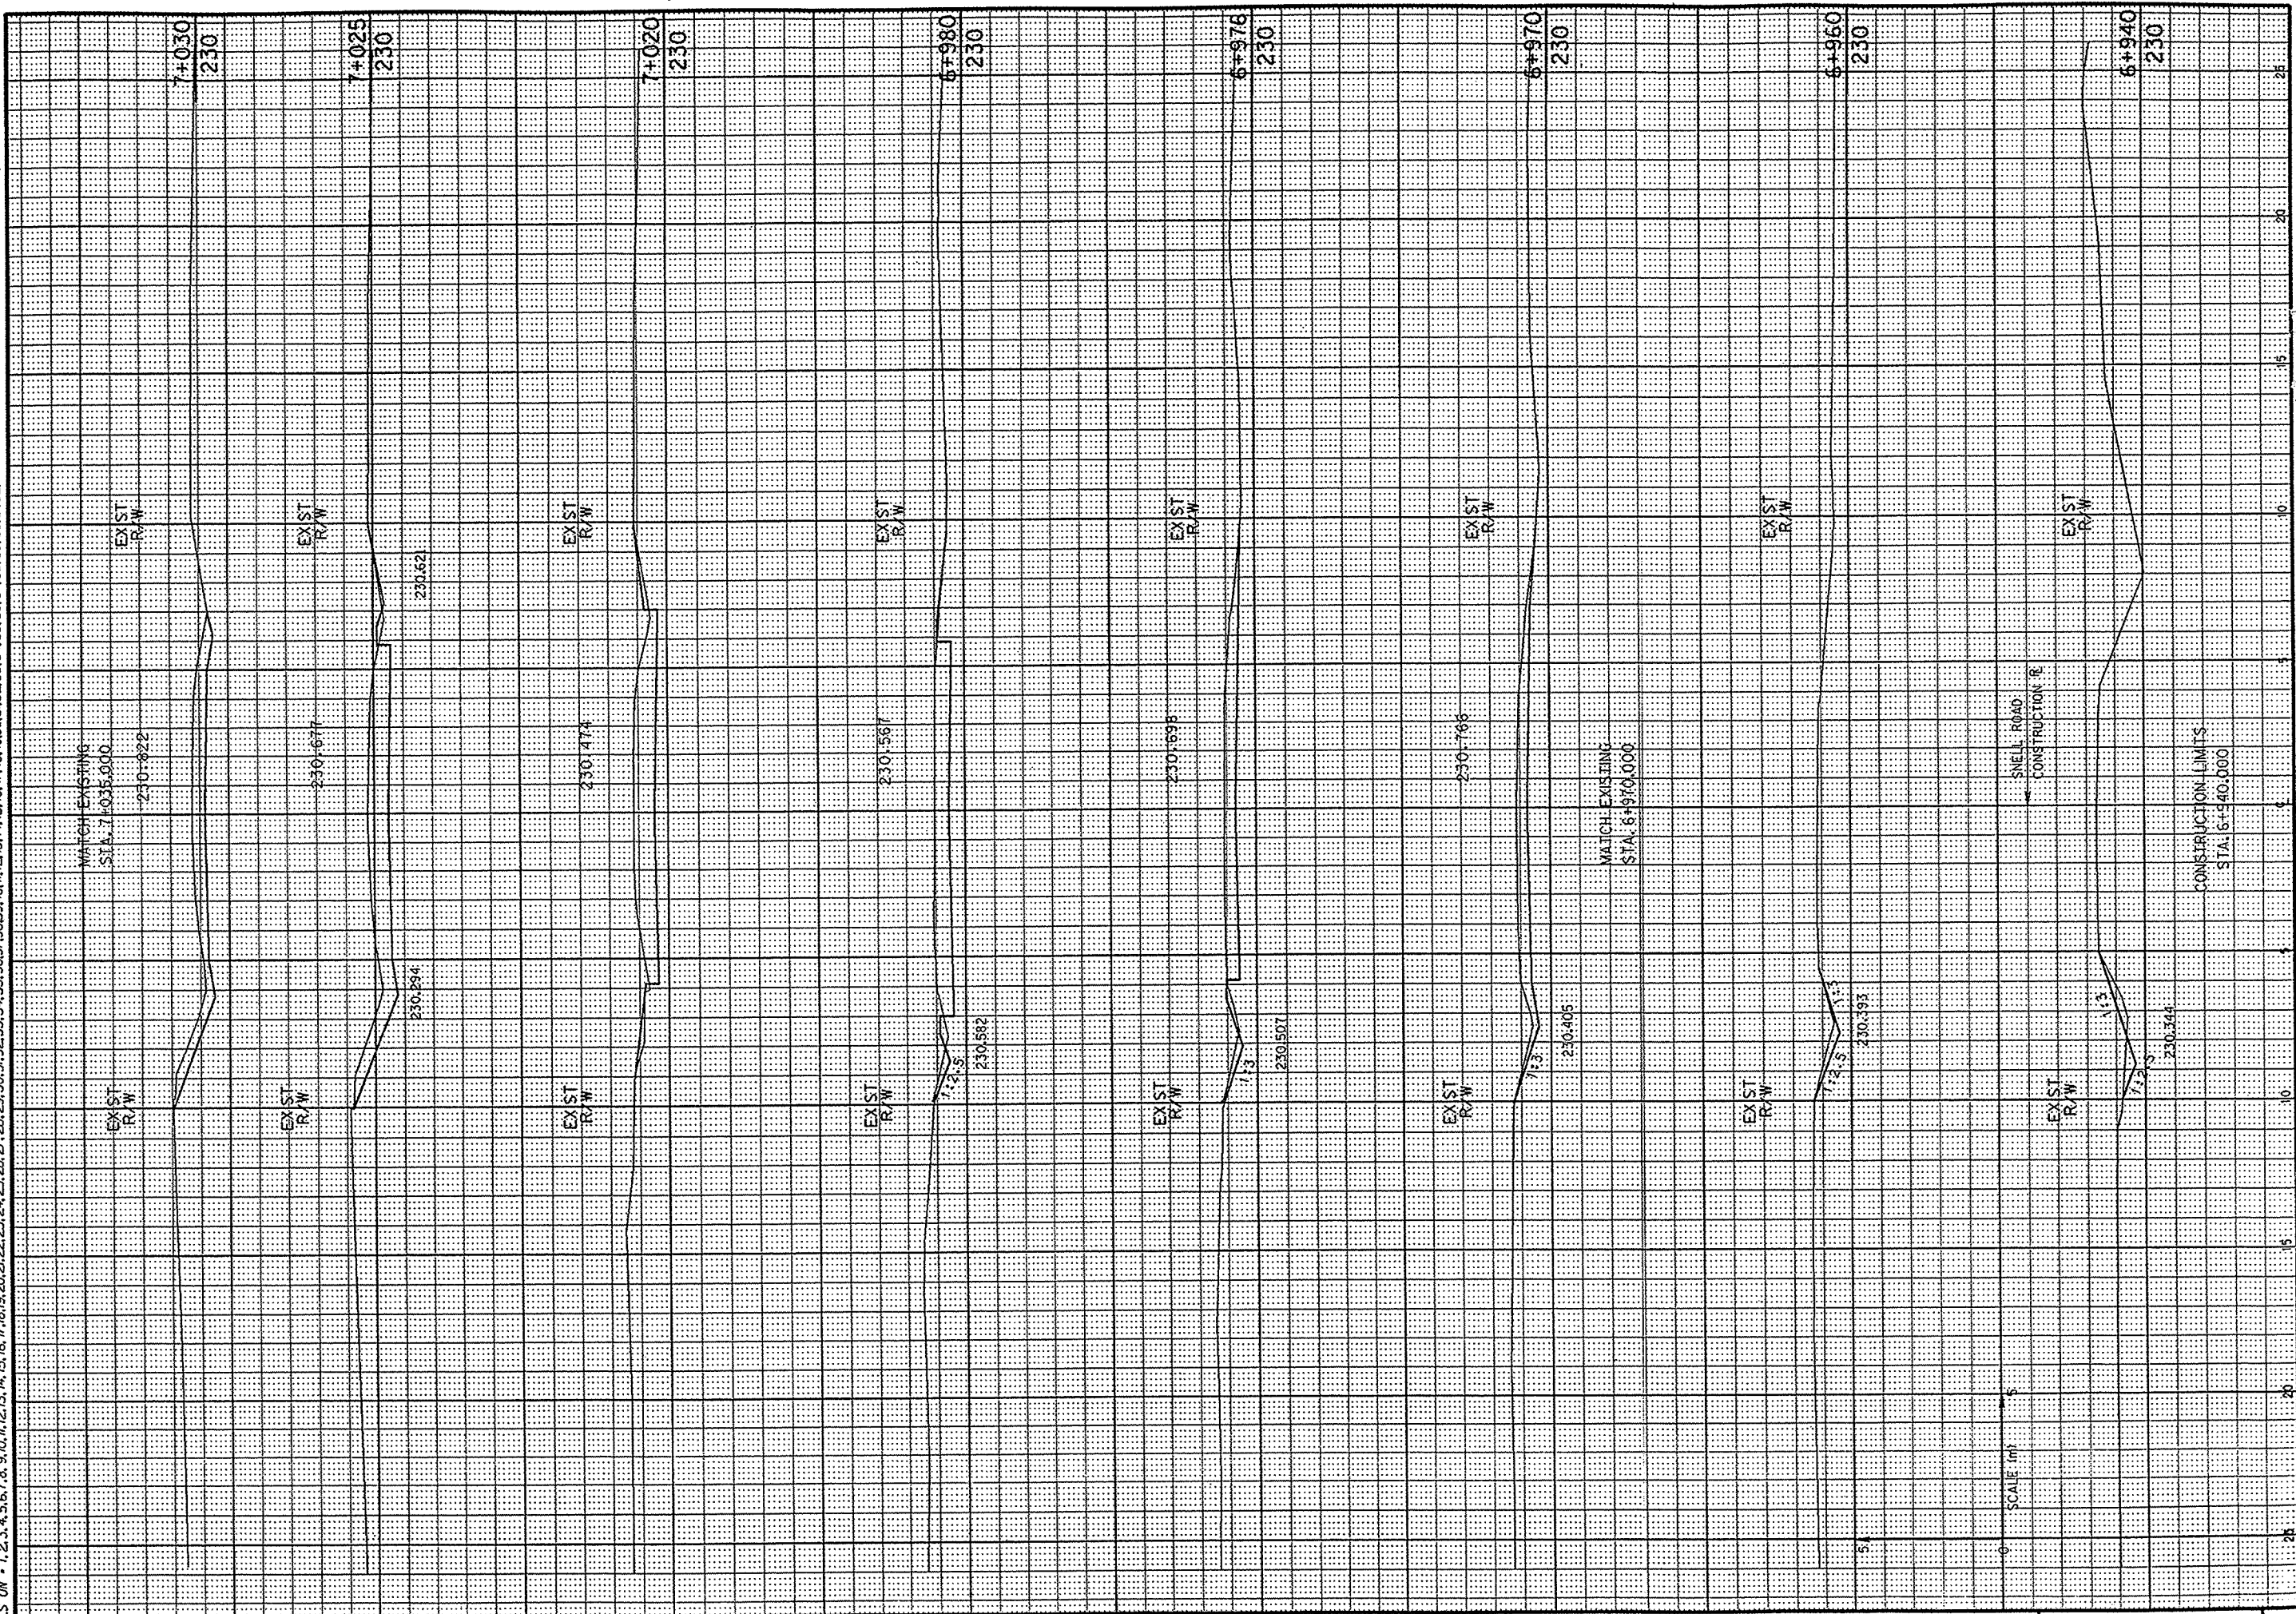

CROSS SECTION

HWY: SNELLE ROAD

COUNTY: WINNEBAGO

STATE PROJECT NO: 4994-00-78/82

SHEET NO: 9.30


M

FILE NAME:

WI&DOT: MSHT21

GB2
 PEN TABLE = #plot72luser-ehalfx.tbl
 DATE OF PLOT 11/24/98
 PLOT NAME = P:\LASERA3\RC000009.PRF
 DGN FILE = I:\440278\dgn\asec\rc000009.dgn

ORIGINATOR:
 LEVELS ON = 1, 2, 3, 61, 62.

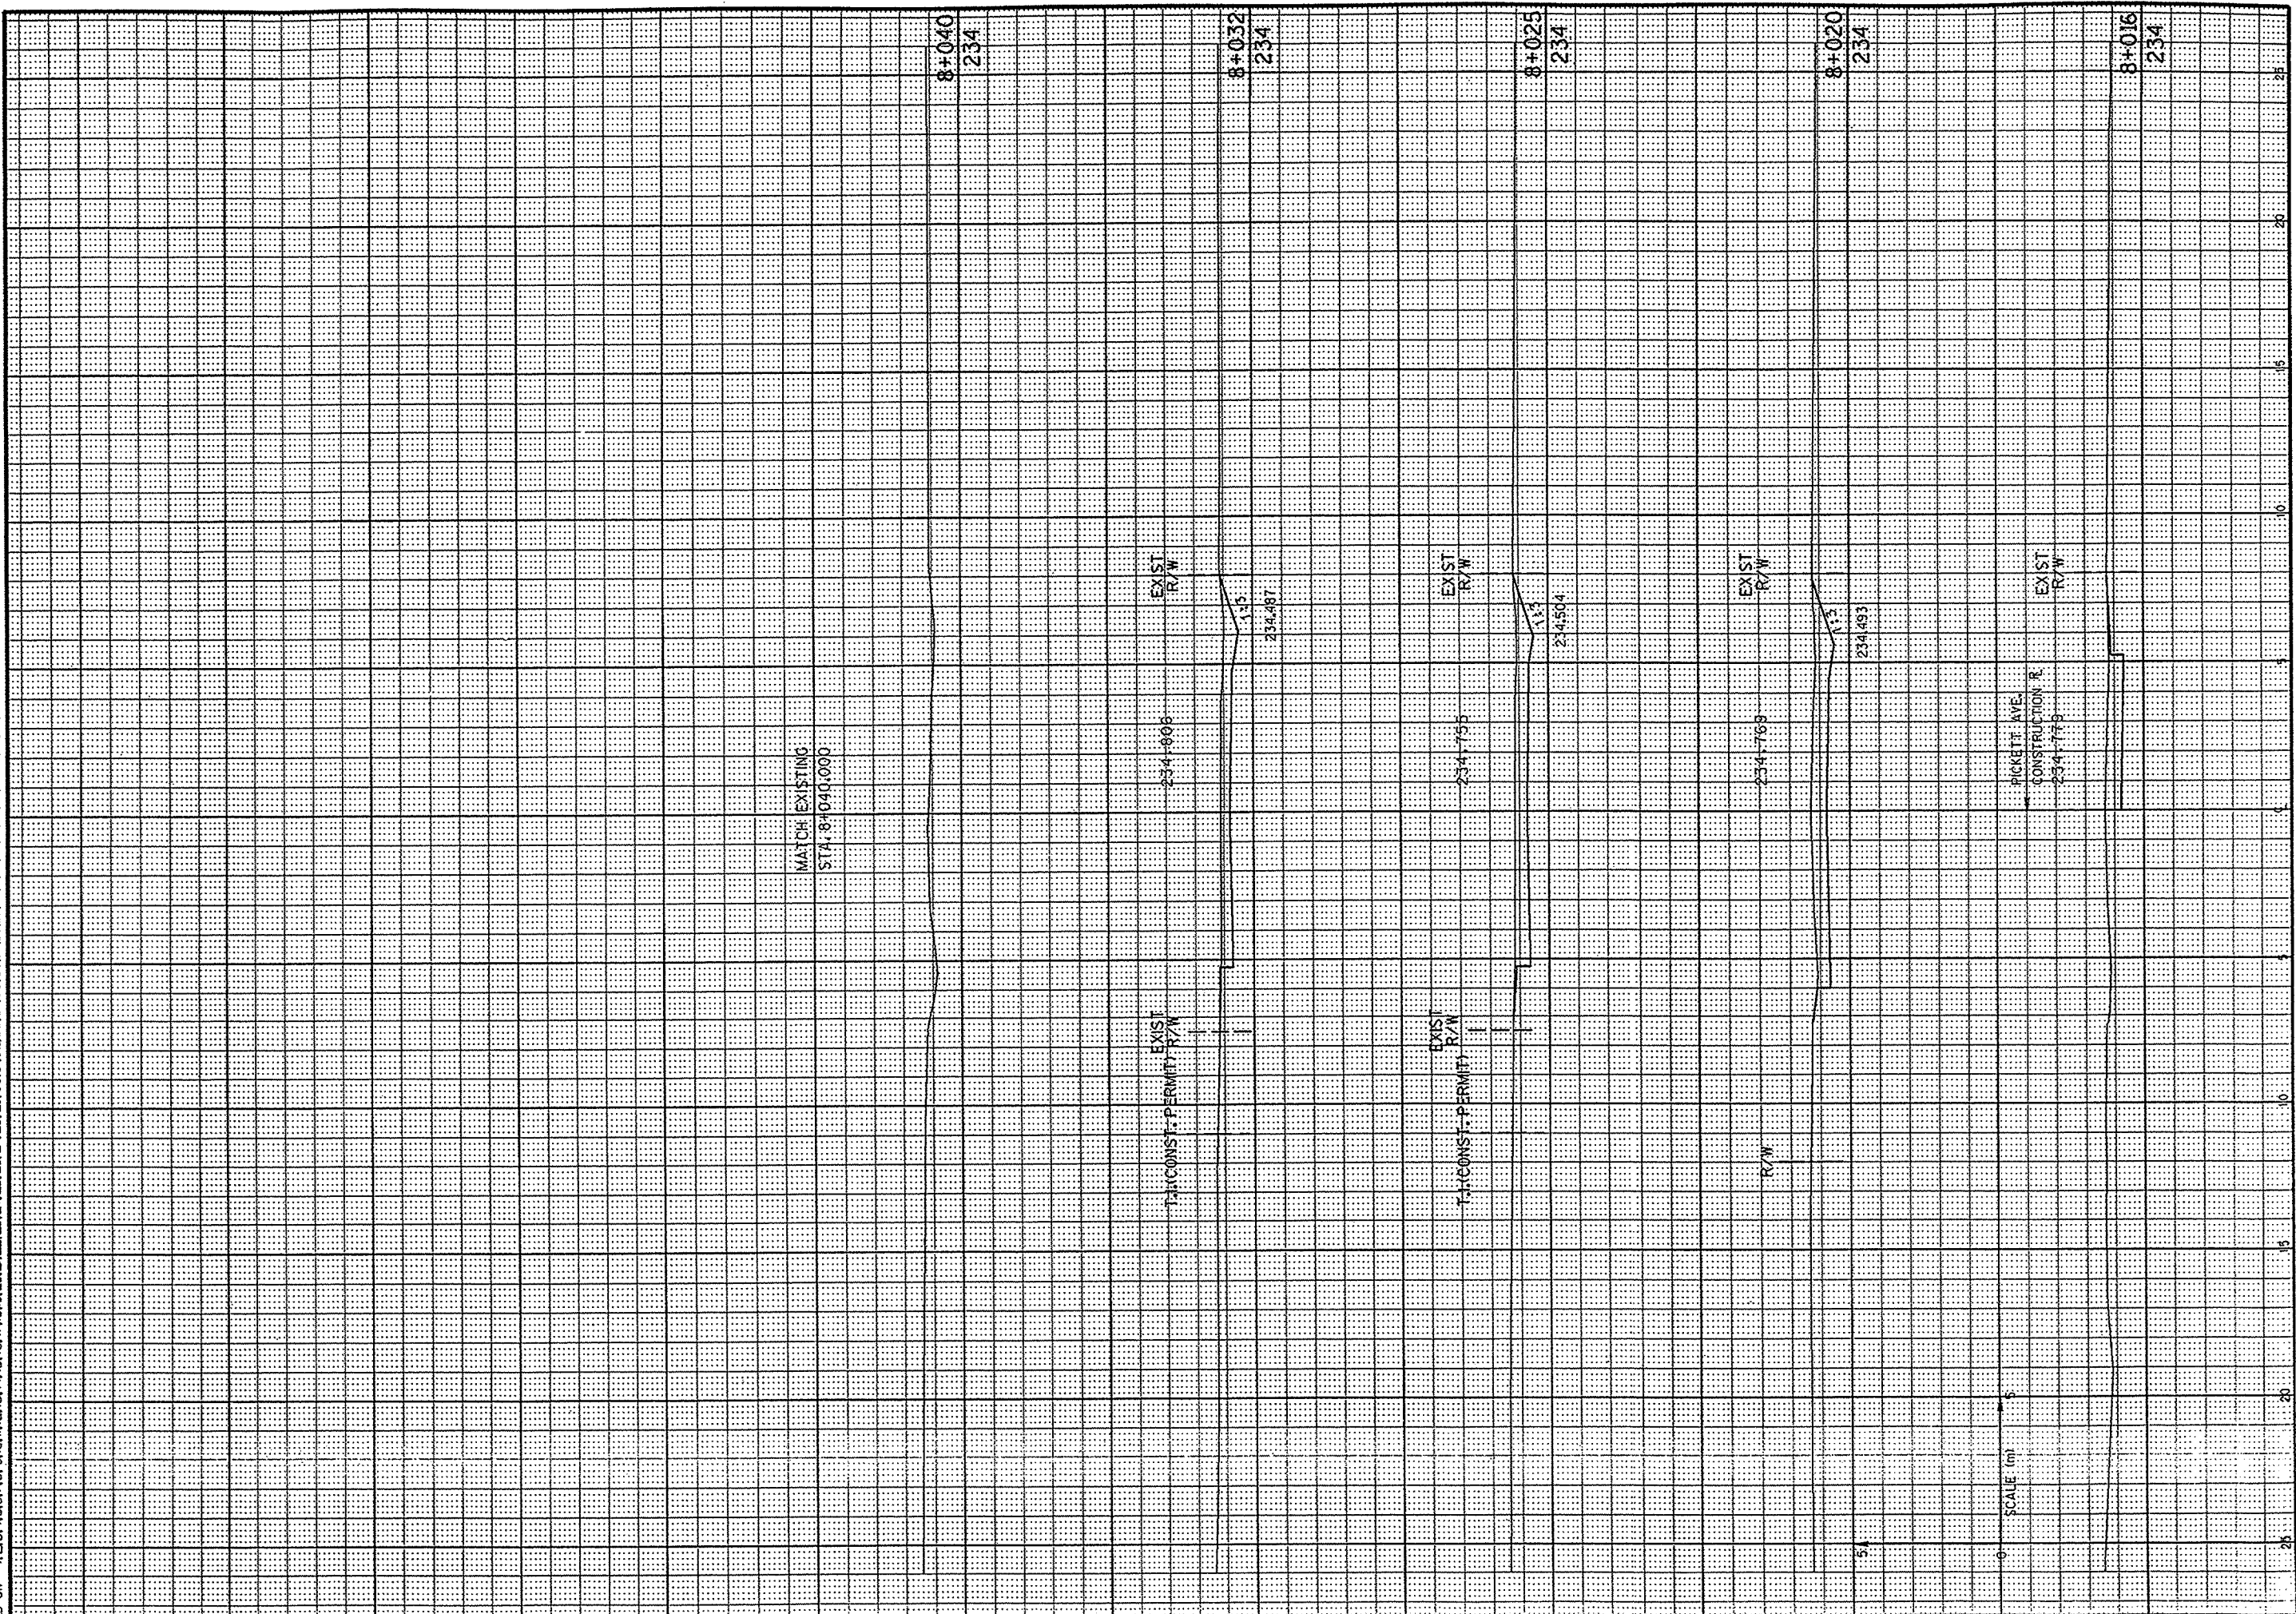

CROSS SECTION

HWY: PICKETT AVENUE

COUNTY: WINNEBAGO

STATE PROJECT NO: 4994-00-82


SHEET NO: 9.31 M

FILE NAME:

WIDOT: MSHT21

OR2
 PEN TABLE = #plot72\user\mholf\xs.tbl
 DATE OF PLOT = 11/24/98
 PLOT NAME = F:\LA\SER3\R0001010.PRF
 DGN FILE = F:\40278\dgn\ysec\16001010.dgn

ORIGINATOR:
 LEVELS ON = 1, 2, 3, 61, 62.

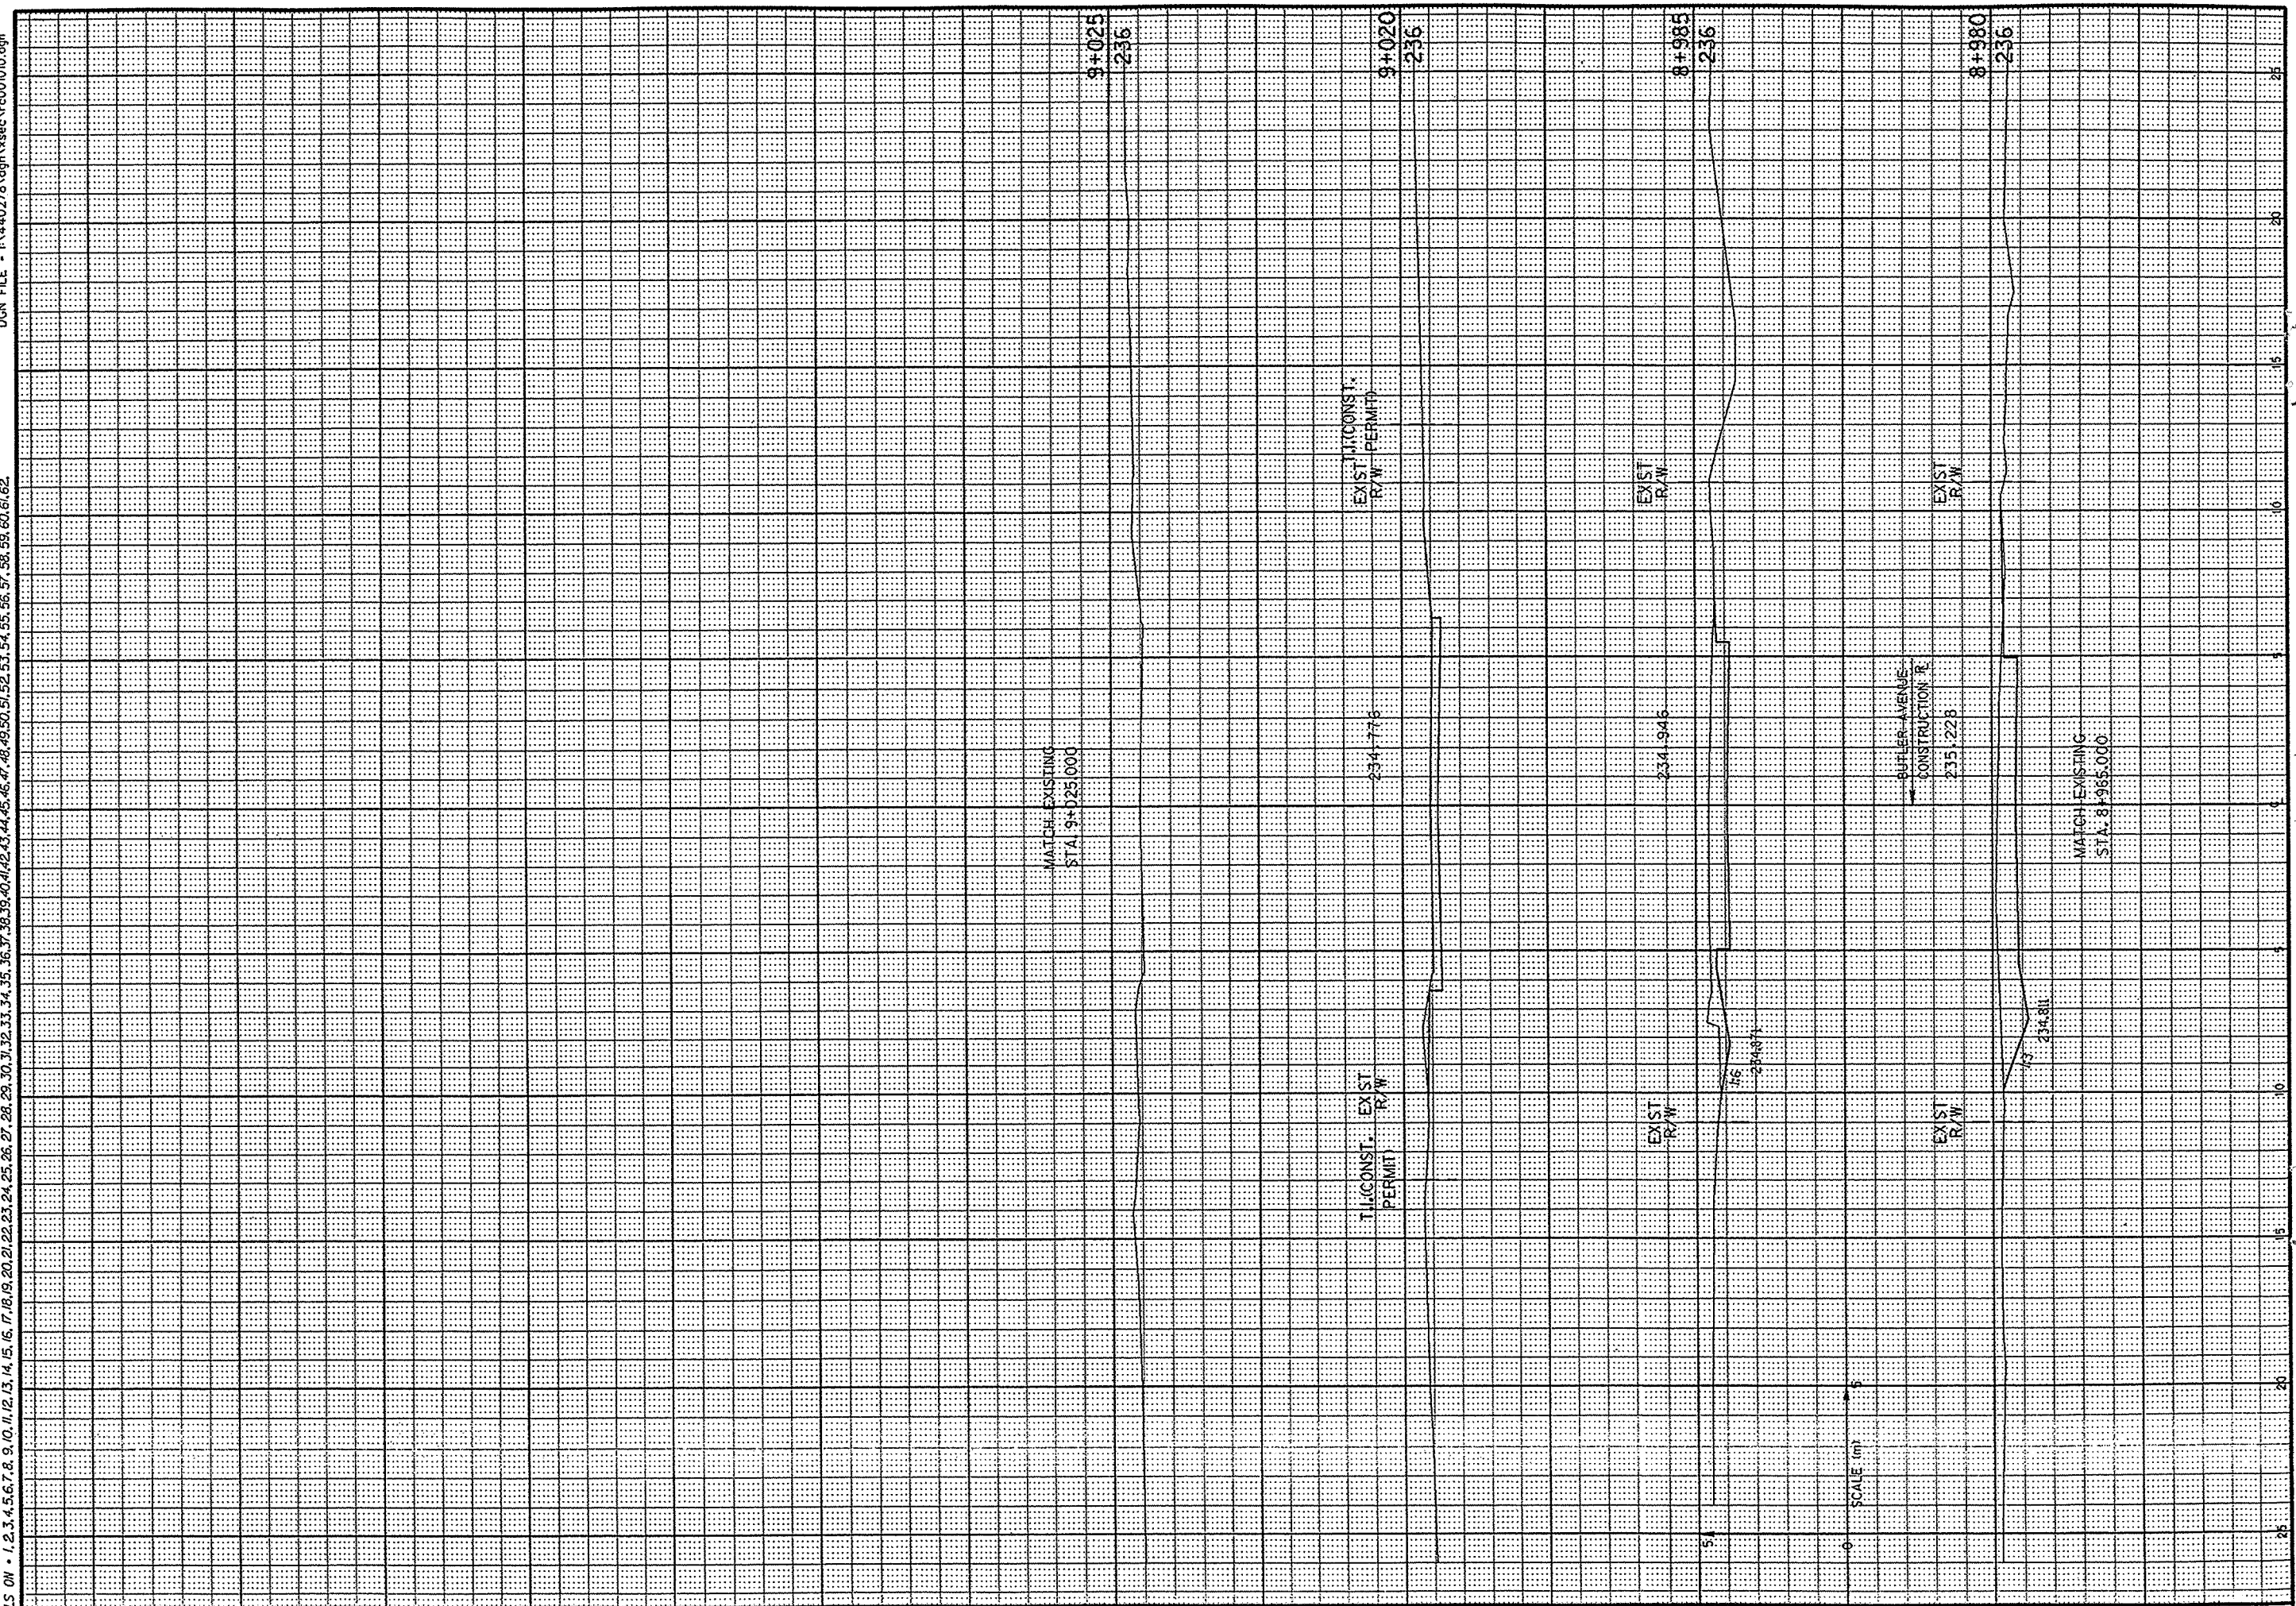

CROSS SECTION

HWY: BUTLER AVENUE

COUNTY: WINNEBAGO

STATE PROJECT NO: 4994-00-82


SHEET NO: 9.32 M

FILE NAME:

WIADOT: MSHT21

CB2
 PEN TABLE = #plot72iplotser=mmhdfxs.tbl
 DATE OF PLOT 11/24/98
 PLOT NAME = P:\LASERA3\RC00101\PRF
 DGN FILE = I:\440278\dgn\ysecr\c00101.dgn

ORIGINATOR:
 LEVELS ON - 1, 2, 3, 61, 62

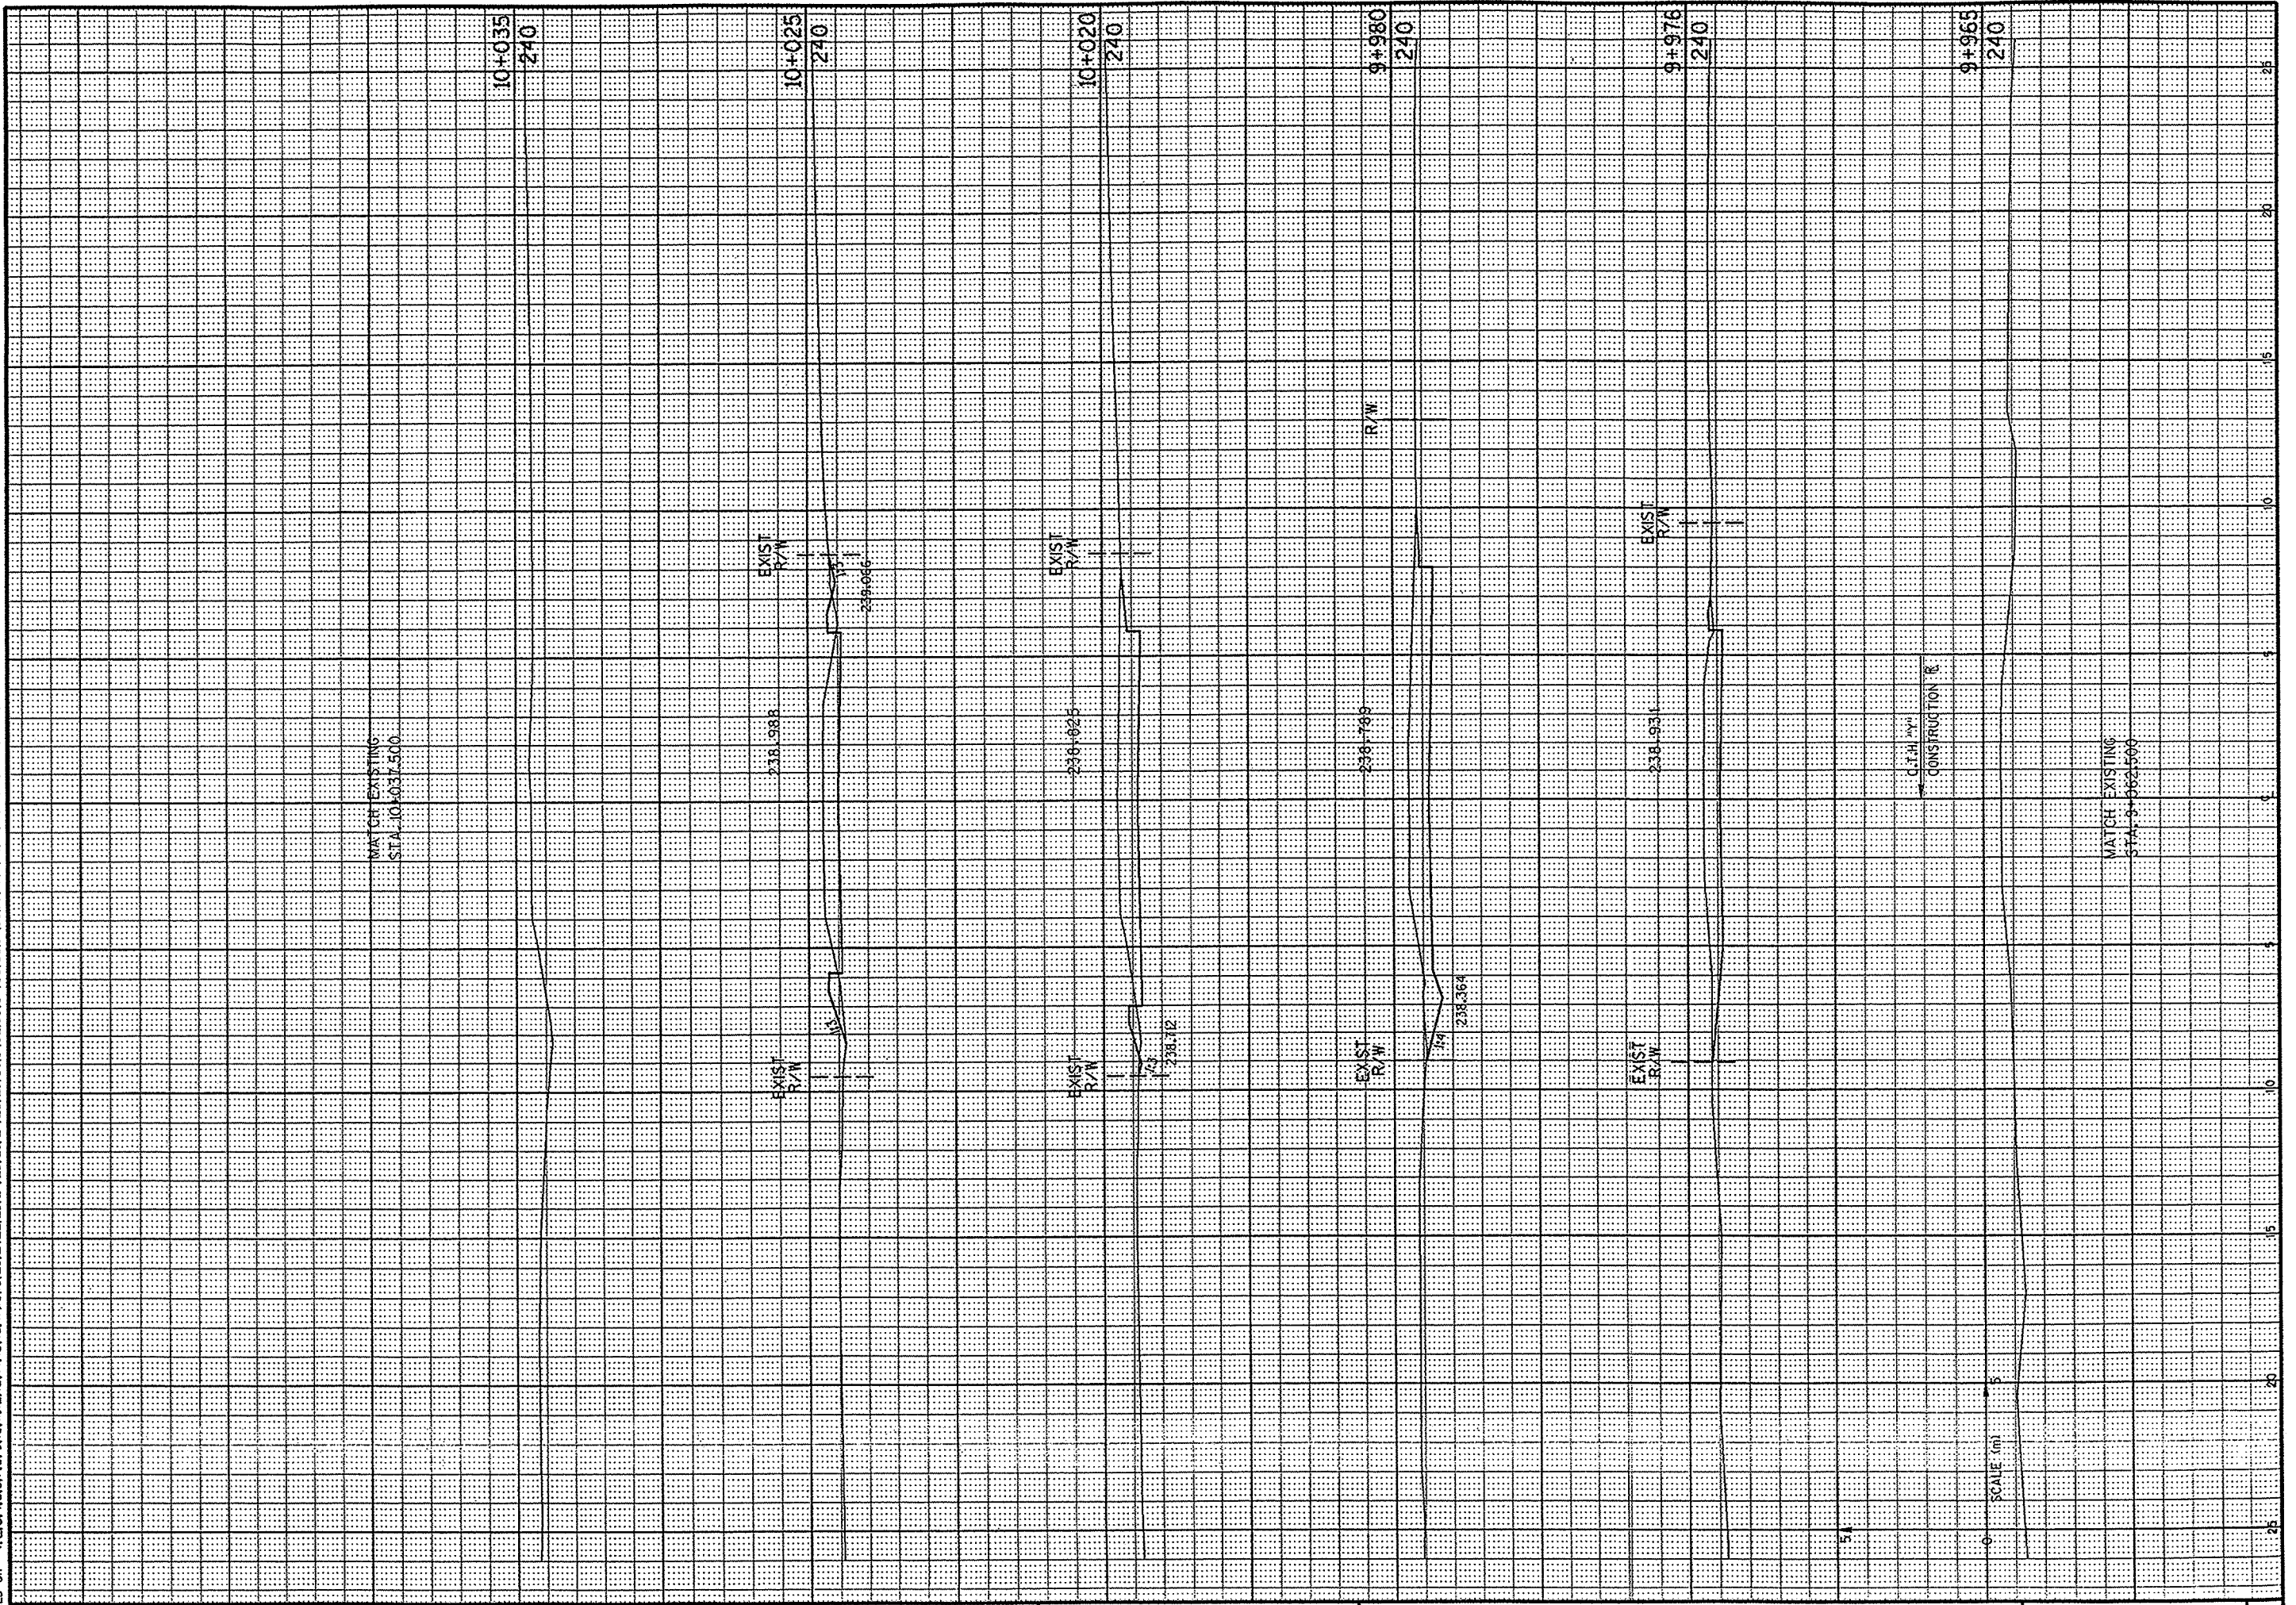

CROSS SECTION

HWY: C.T.H. "Y"

COUNTY: WINNEBAGO

STATE PROJECT NO: 4994-00-82

SHEET NO: 9.33


M

FILE NAME:

W:\DOT\MSHT21

062
 PEN TABLE = #plot72duser+mhofxs.tbl
 DATE OF PLOT = 11/24/98
 PLOT NAME = P:\LA38RA3R00010101.PRF
 DGN FILE = P:\440278\dgn\ysec\600101.dgn

ORIGINATOR:
 LEVELS ON = 1, 2, 3, 61, 62.

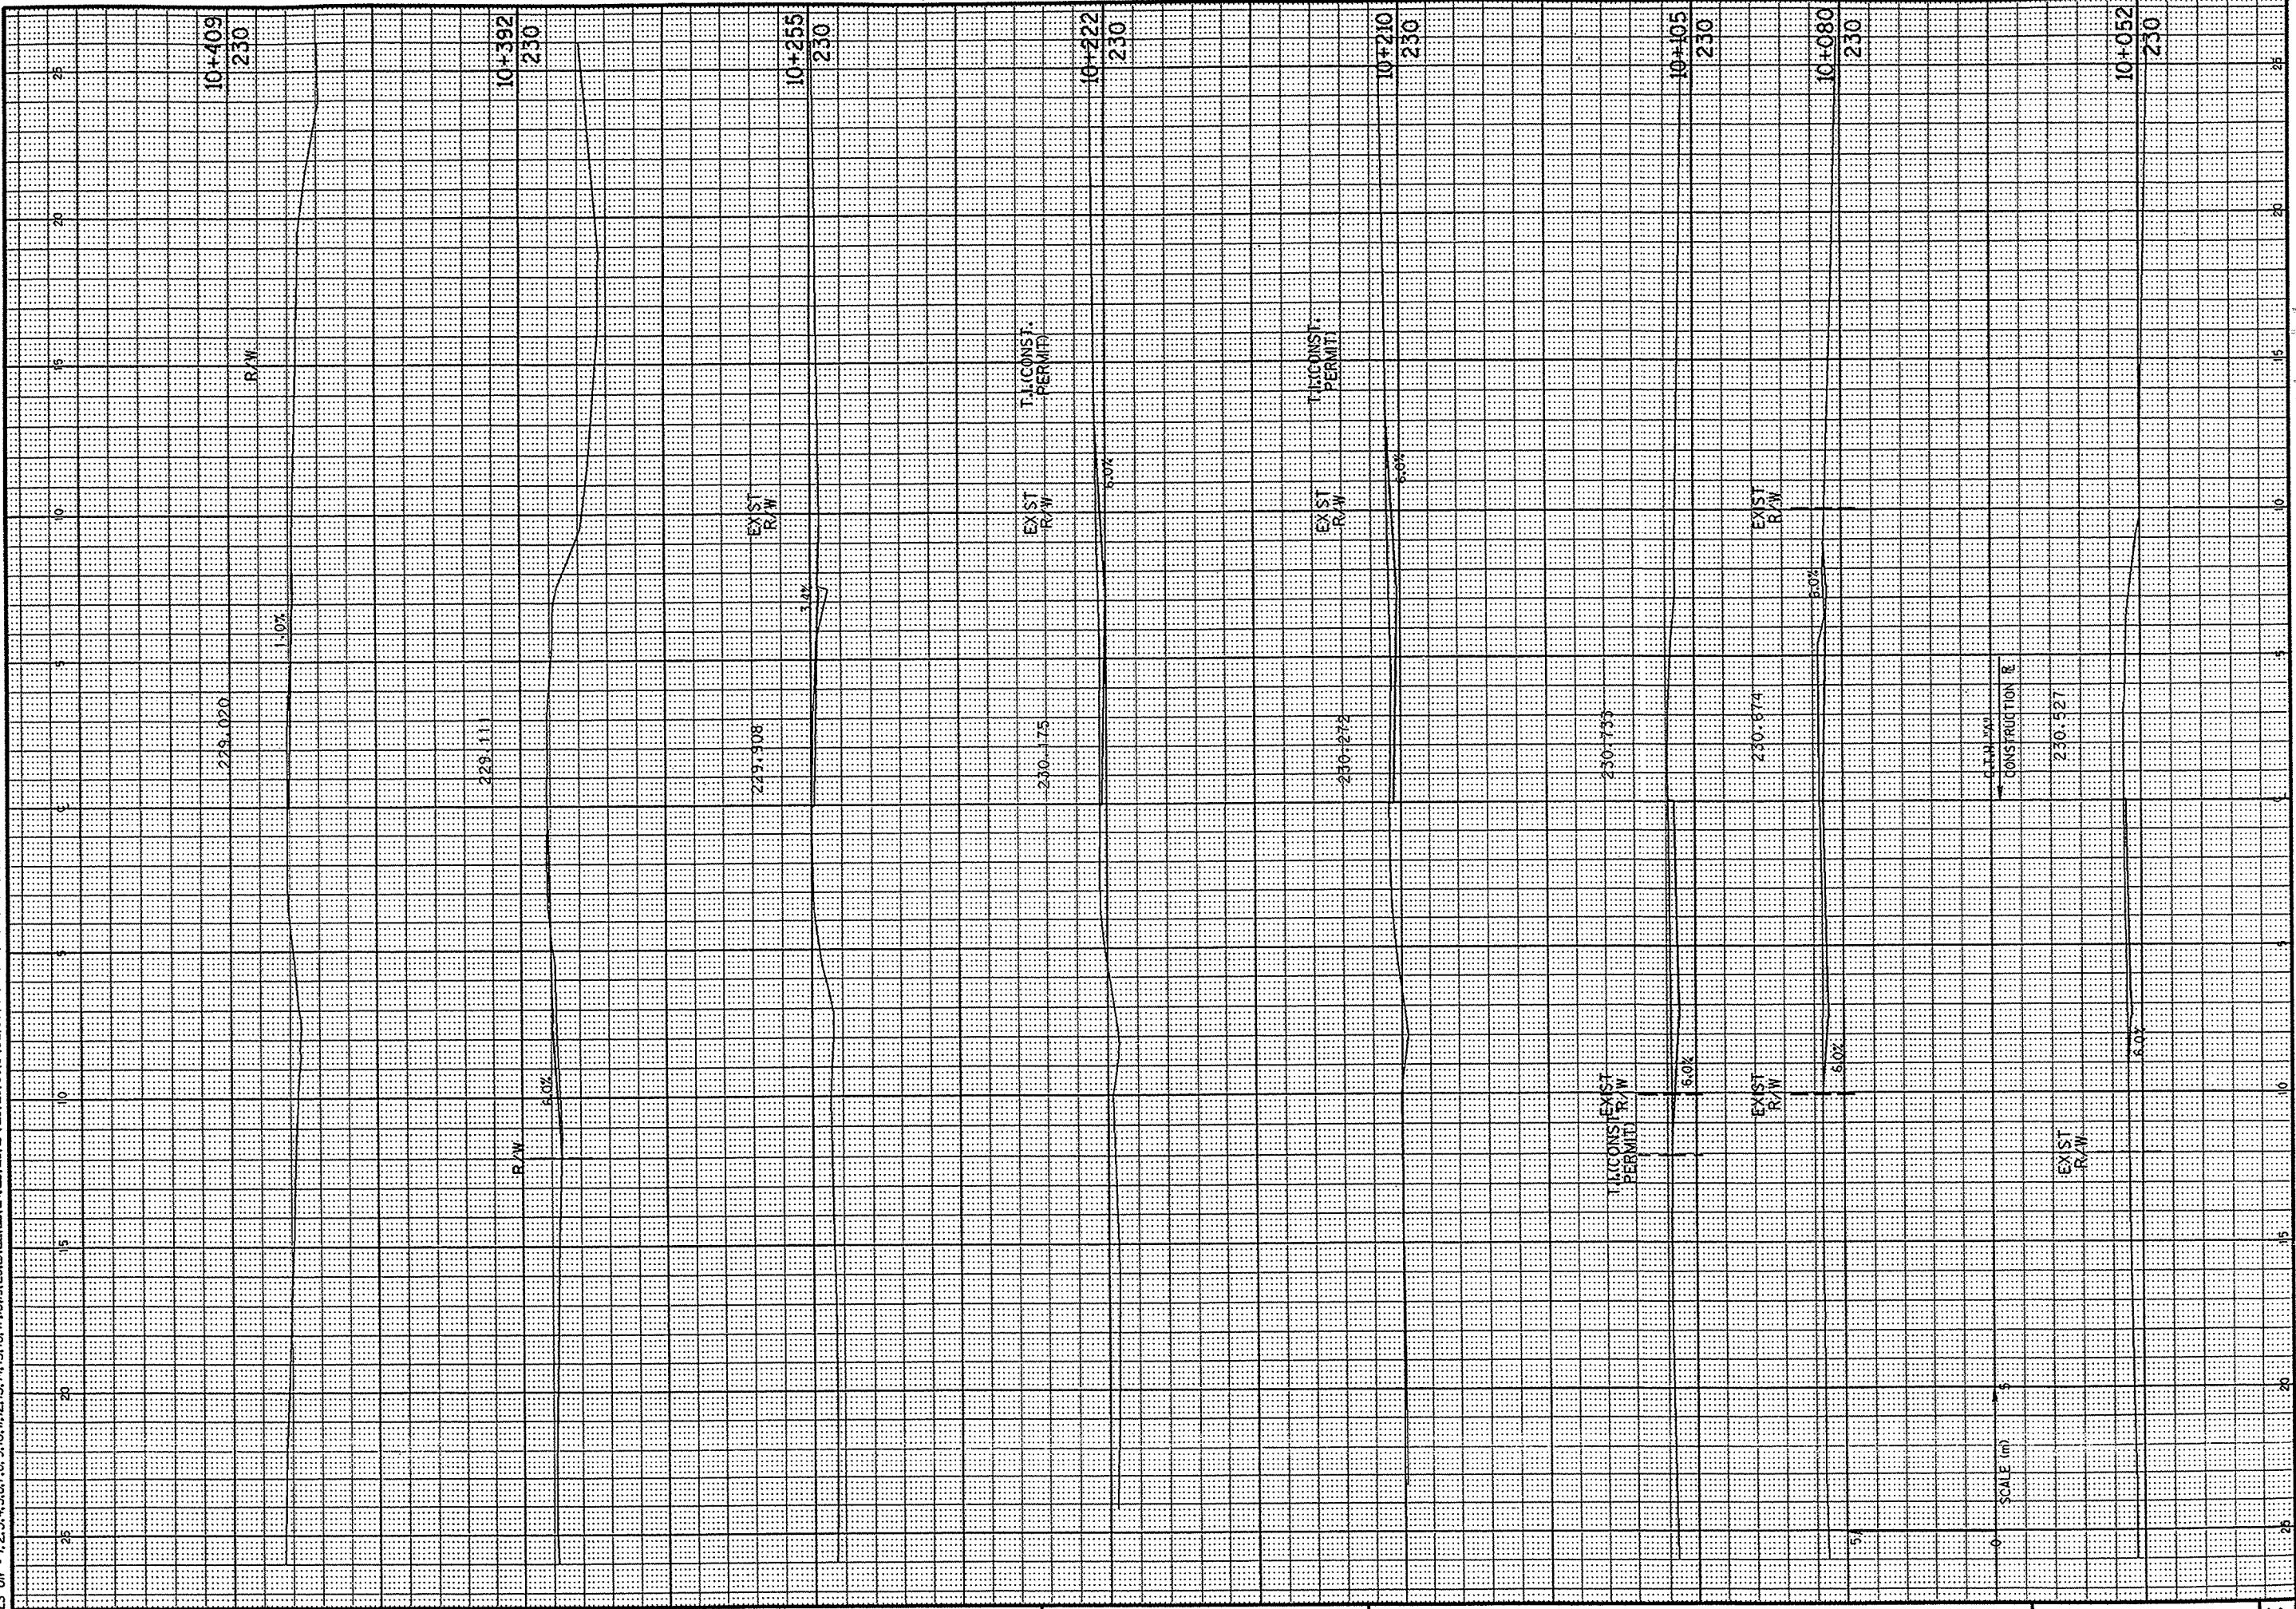

CROSS SECTION (P.E.'S. AND F.E.'S.)

HWY: C.T.H. "A"

COUNTY: WINNEBAGO

STATE PROJECT NO: 4994-00-78

SHEET NO: 9.34


M

FILE NAME:

WISDOT: MSH21

GR2
 PEN TABLE = #plot723loser.fmhdfx.tbl
 DATE OF PLOT = 11/24/98
 PLOT NAME = P:\41ASERA\3R000202.PRF
 DGN FILE = I:\440278\dgn\ysec\c002012.dgn

ORIGINATOR:
 LEVELS ON = 1, 2, 3, 61, 62

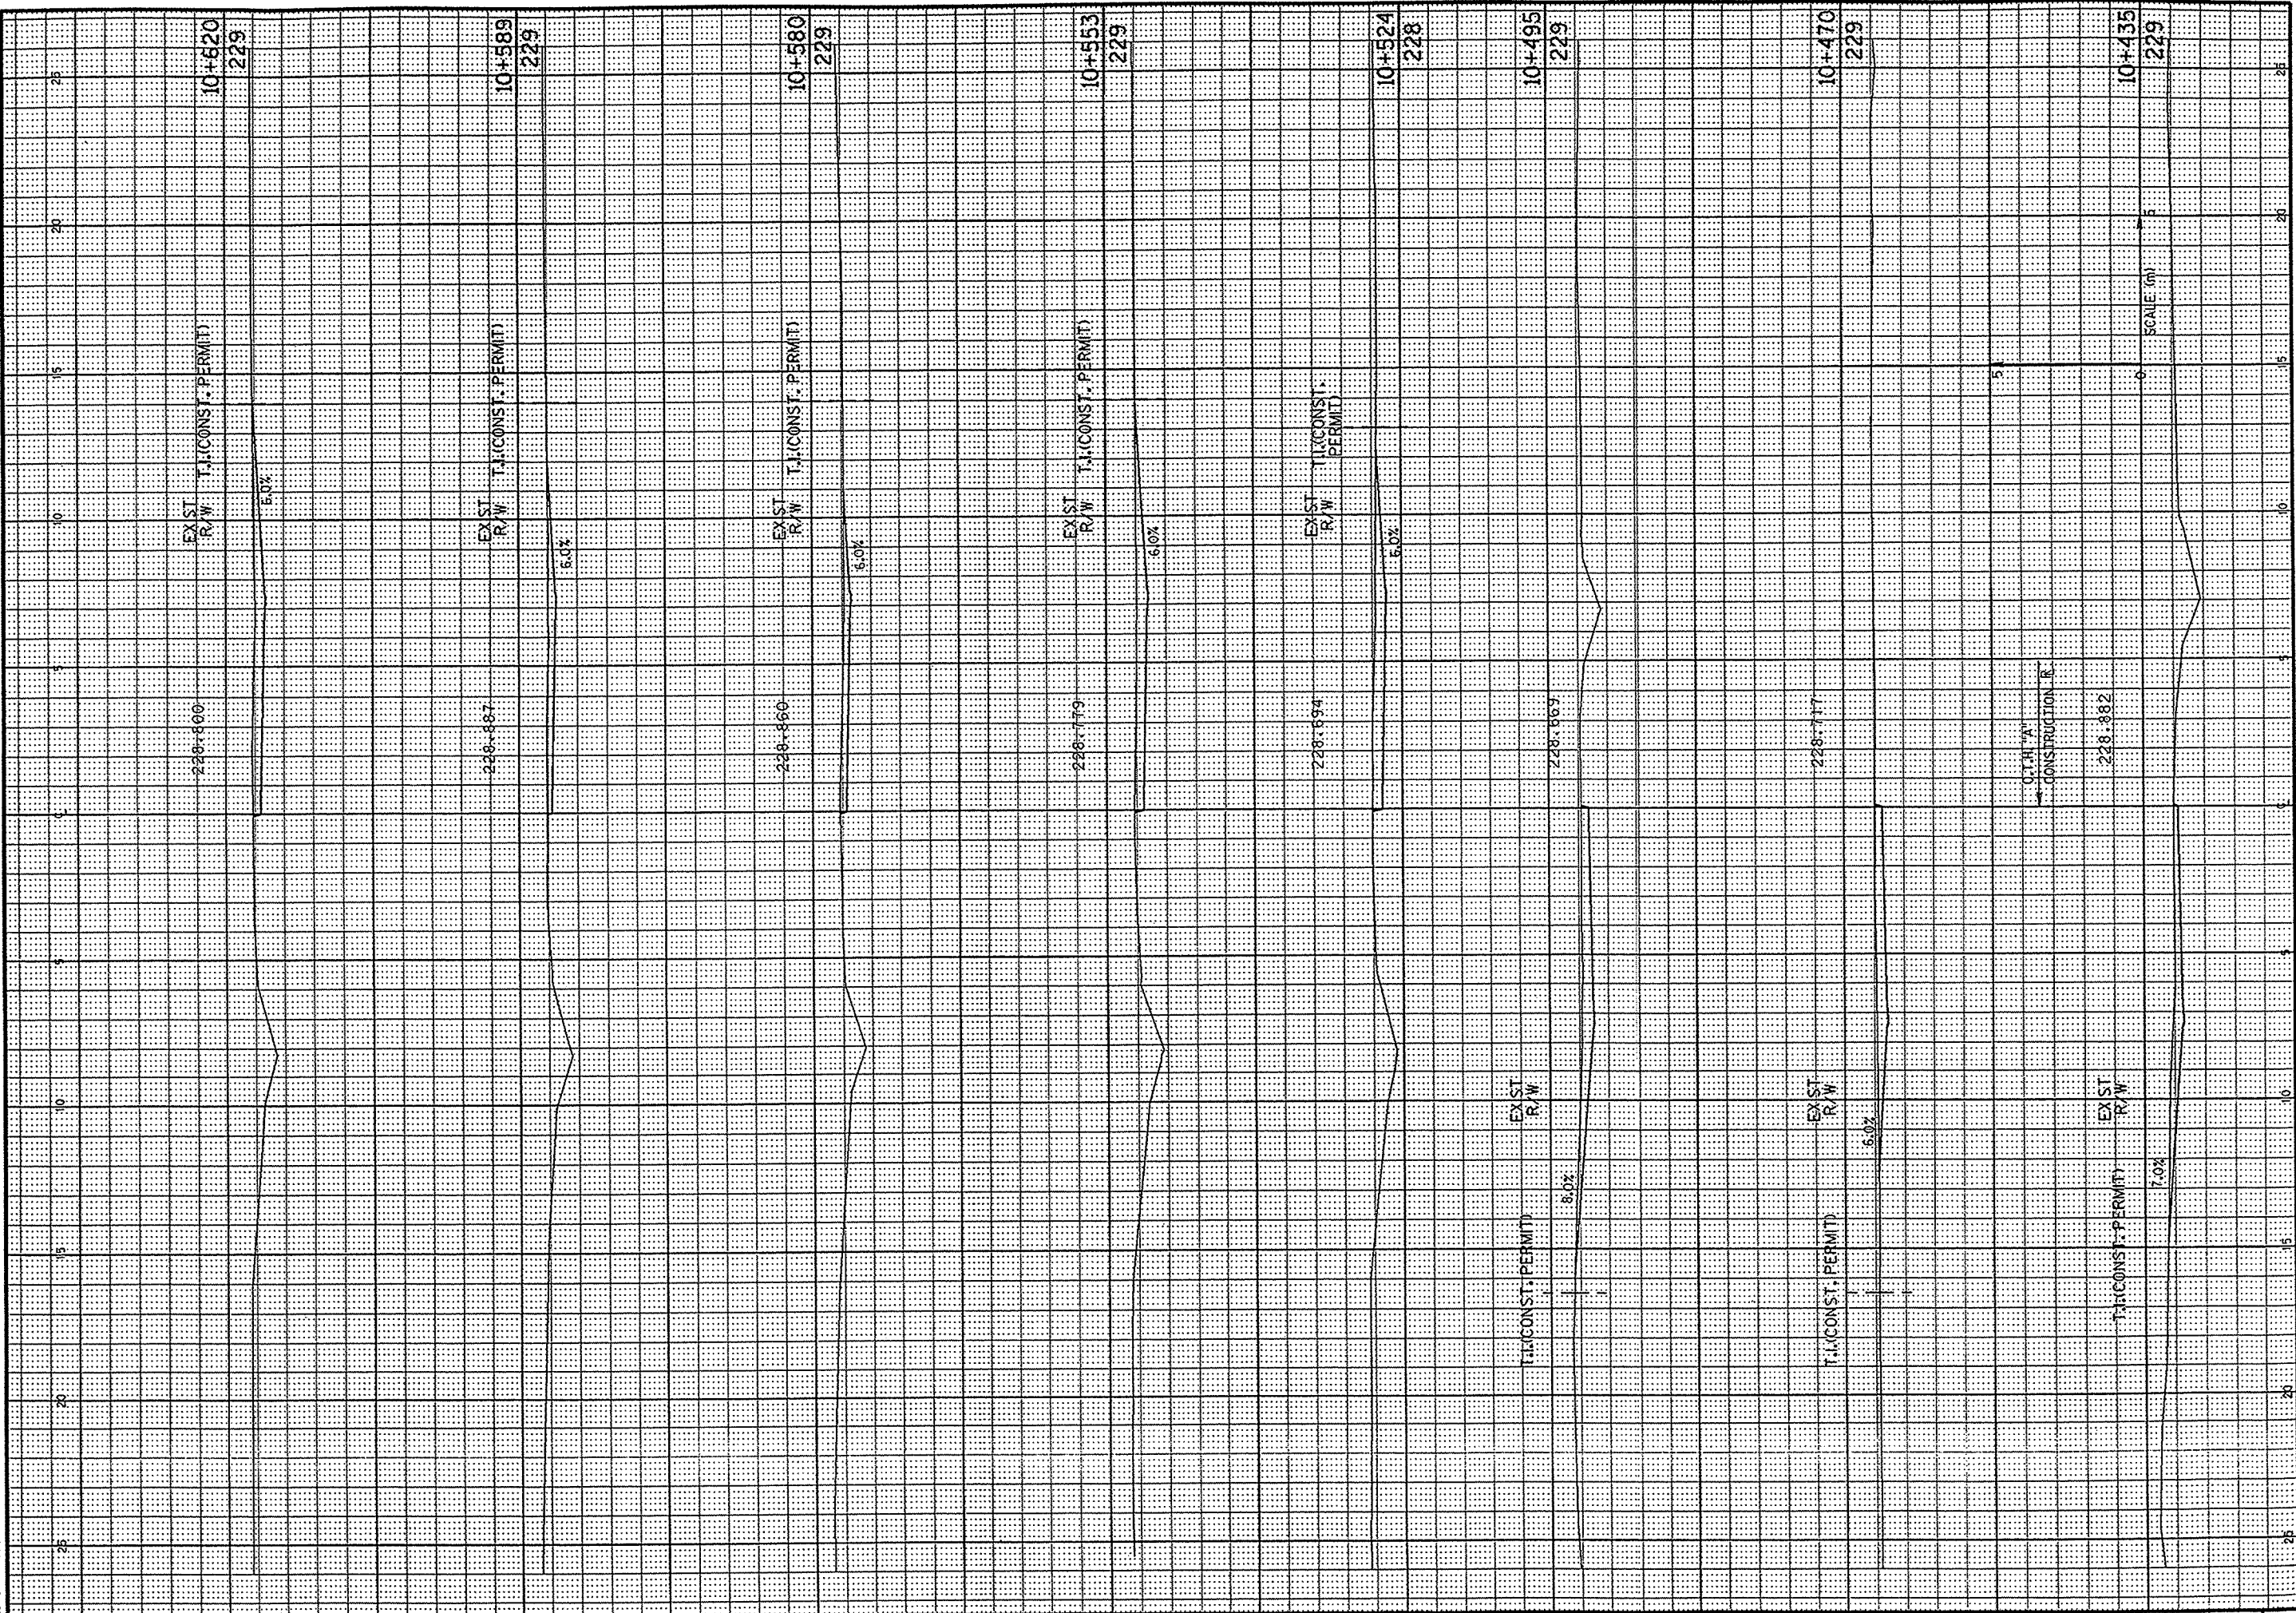

CROSS SECTION (P.E.'S. AND F.E.'S.)

HWY: C.T.H. "A"

COUNTY: WINNEBAGO

STATE PROJECT NO: 4994-00-78


SHEET NO: 9.35 M

FILE NAME:

WISDOT: MSHT21

GB2
 PEN TABLE = #plot724\oserm\mhaf\fxs.tbl
 DATE OF PLOT 11/24/98
 PLOT NAME = P:\LASERA3\RC003012.PRF
 DGN FILE = I:\440278\vgm\ksec\c003012.dgn

ORIGINATOR:
 LEVELS ON = 1, 2, 3, 61, 62.

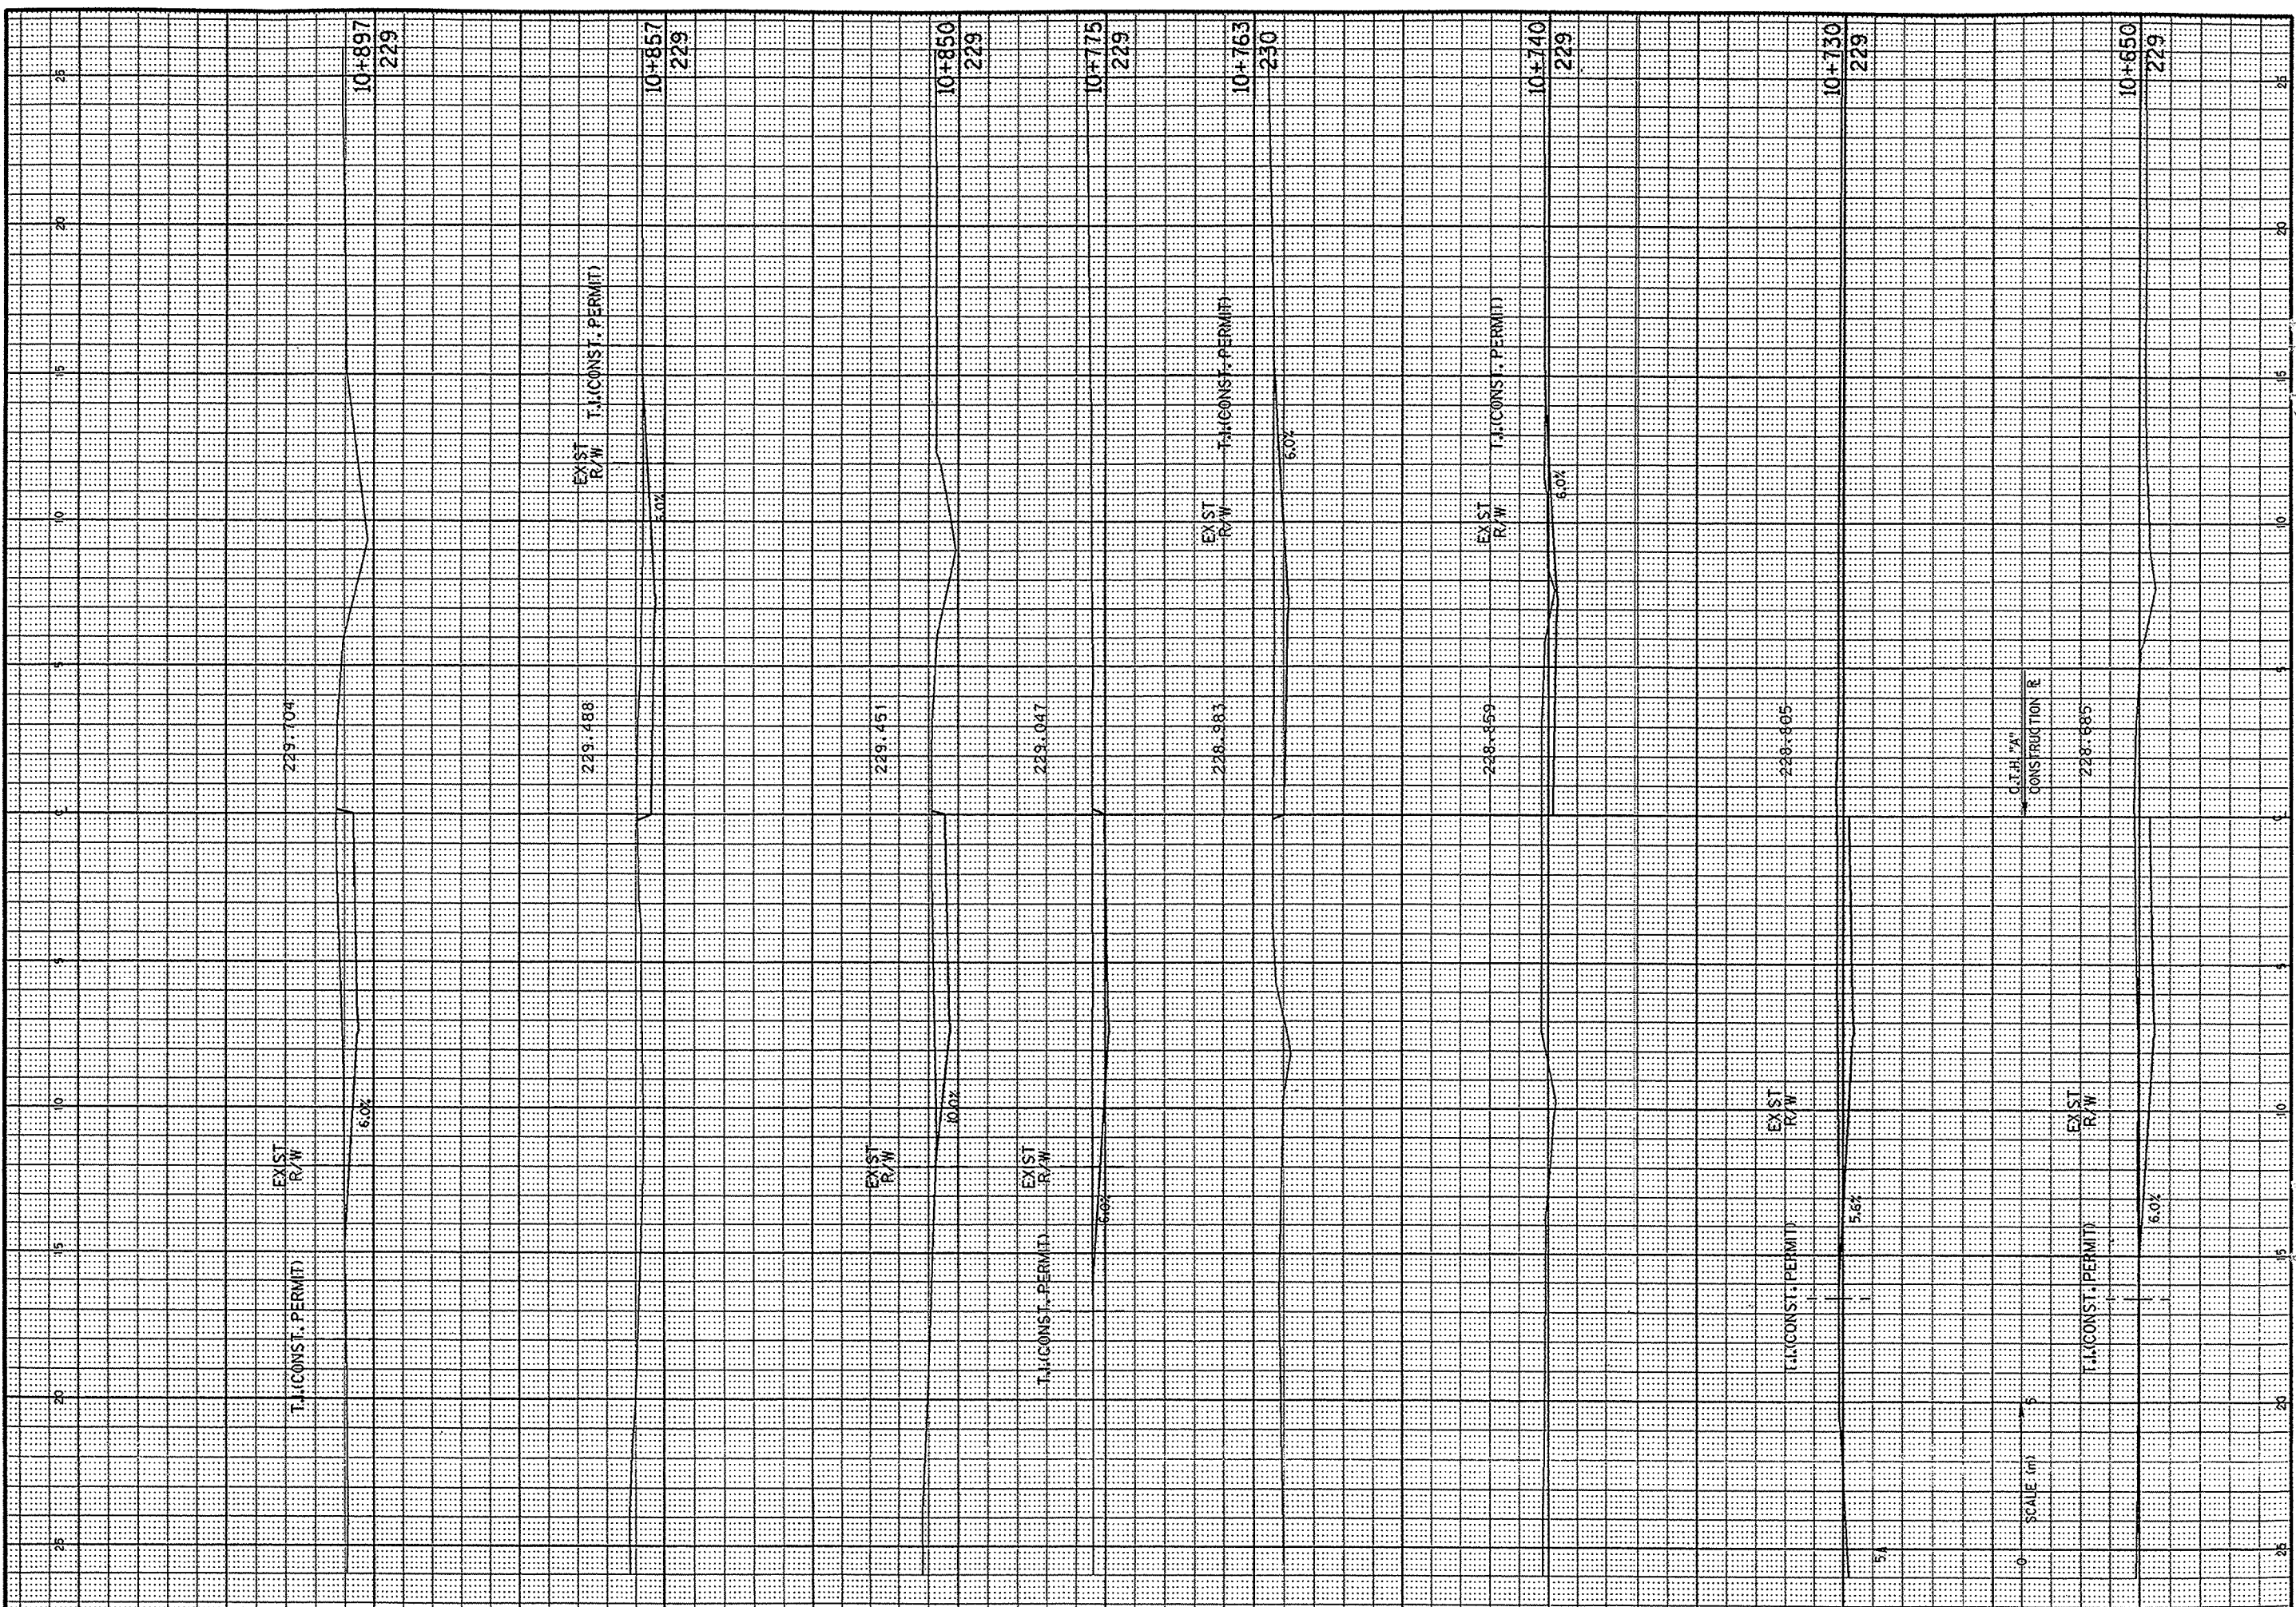

CROSS SECTION (P.E.'S. AND F.E.'S.)

HWY: C.T.H. "A"

COUNTY: WINNEBAGO

STATE PROJECT NO: 4994-00-78

SHEET NO: 9.36 M

FILE NAME:

WISDOT: MSHT21

GB2
 PEN TABLE = #plot72closer.tmhofx.s.tbl
 DATE OF PLOT = 11/24/98
 PLOT NAME = P:\LASERAJ3R0004012.PRF
 DGN FILE = P:\440278\dgn\ysec\rc004012.dgn

ORIGINATOR:
 LEVELS ON = 1, 2, 3, 61, 62




FILE NAME:

WI&DOT: MSHT21

CB2
 PEN TABLE = #plot72#user=mmhofx.s.tbi
 DATE OF PLOT = 11/24/98
 PLOT NAME = P:\LASER3\RCC00502.PRF
 DGN FILE = I:\440278\dgn\wsec\c00502.dgn


ORIGINATOR:
 LEVELS ON = 1, 2, 3, 61, 62

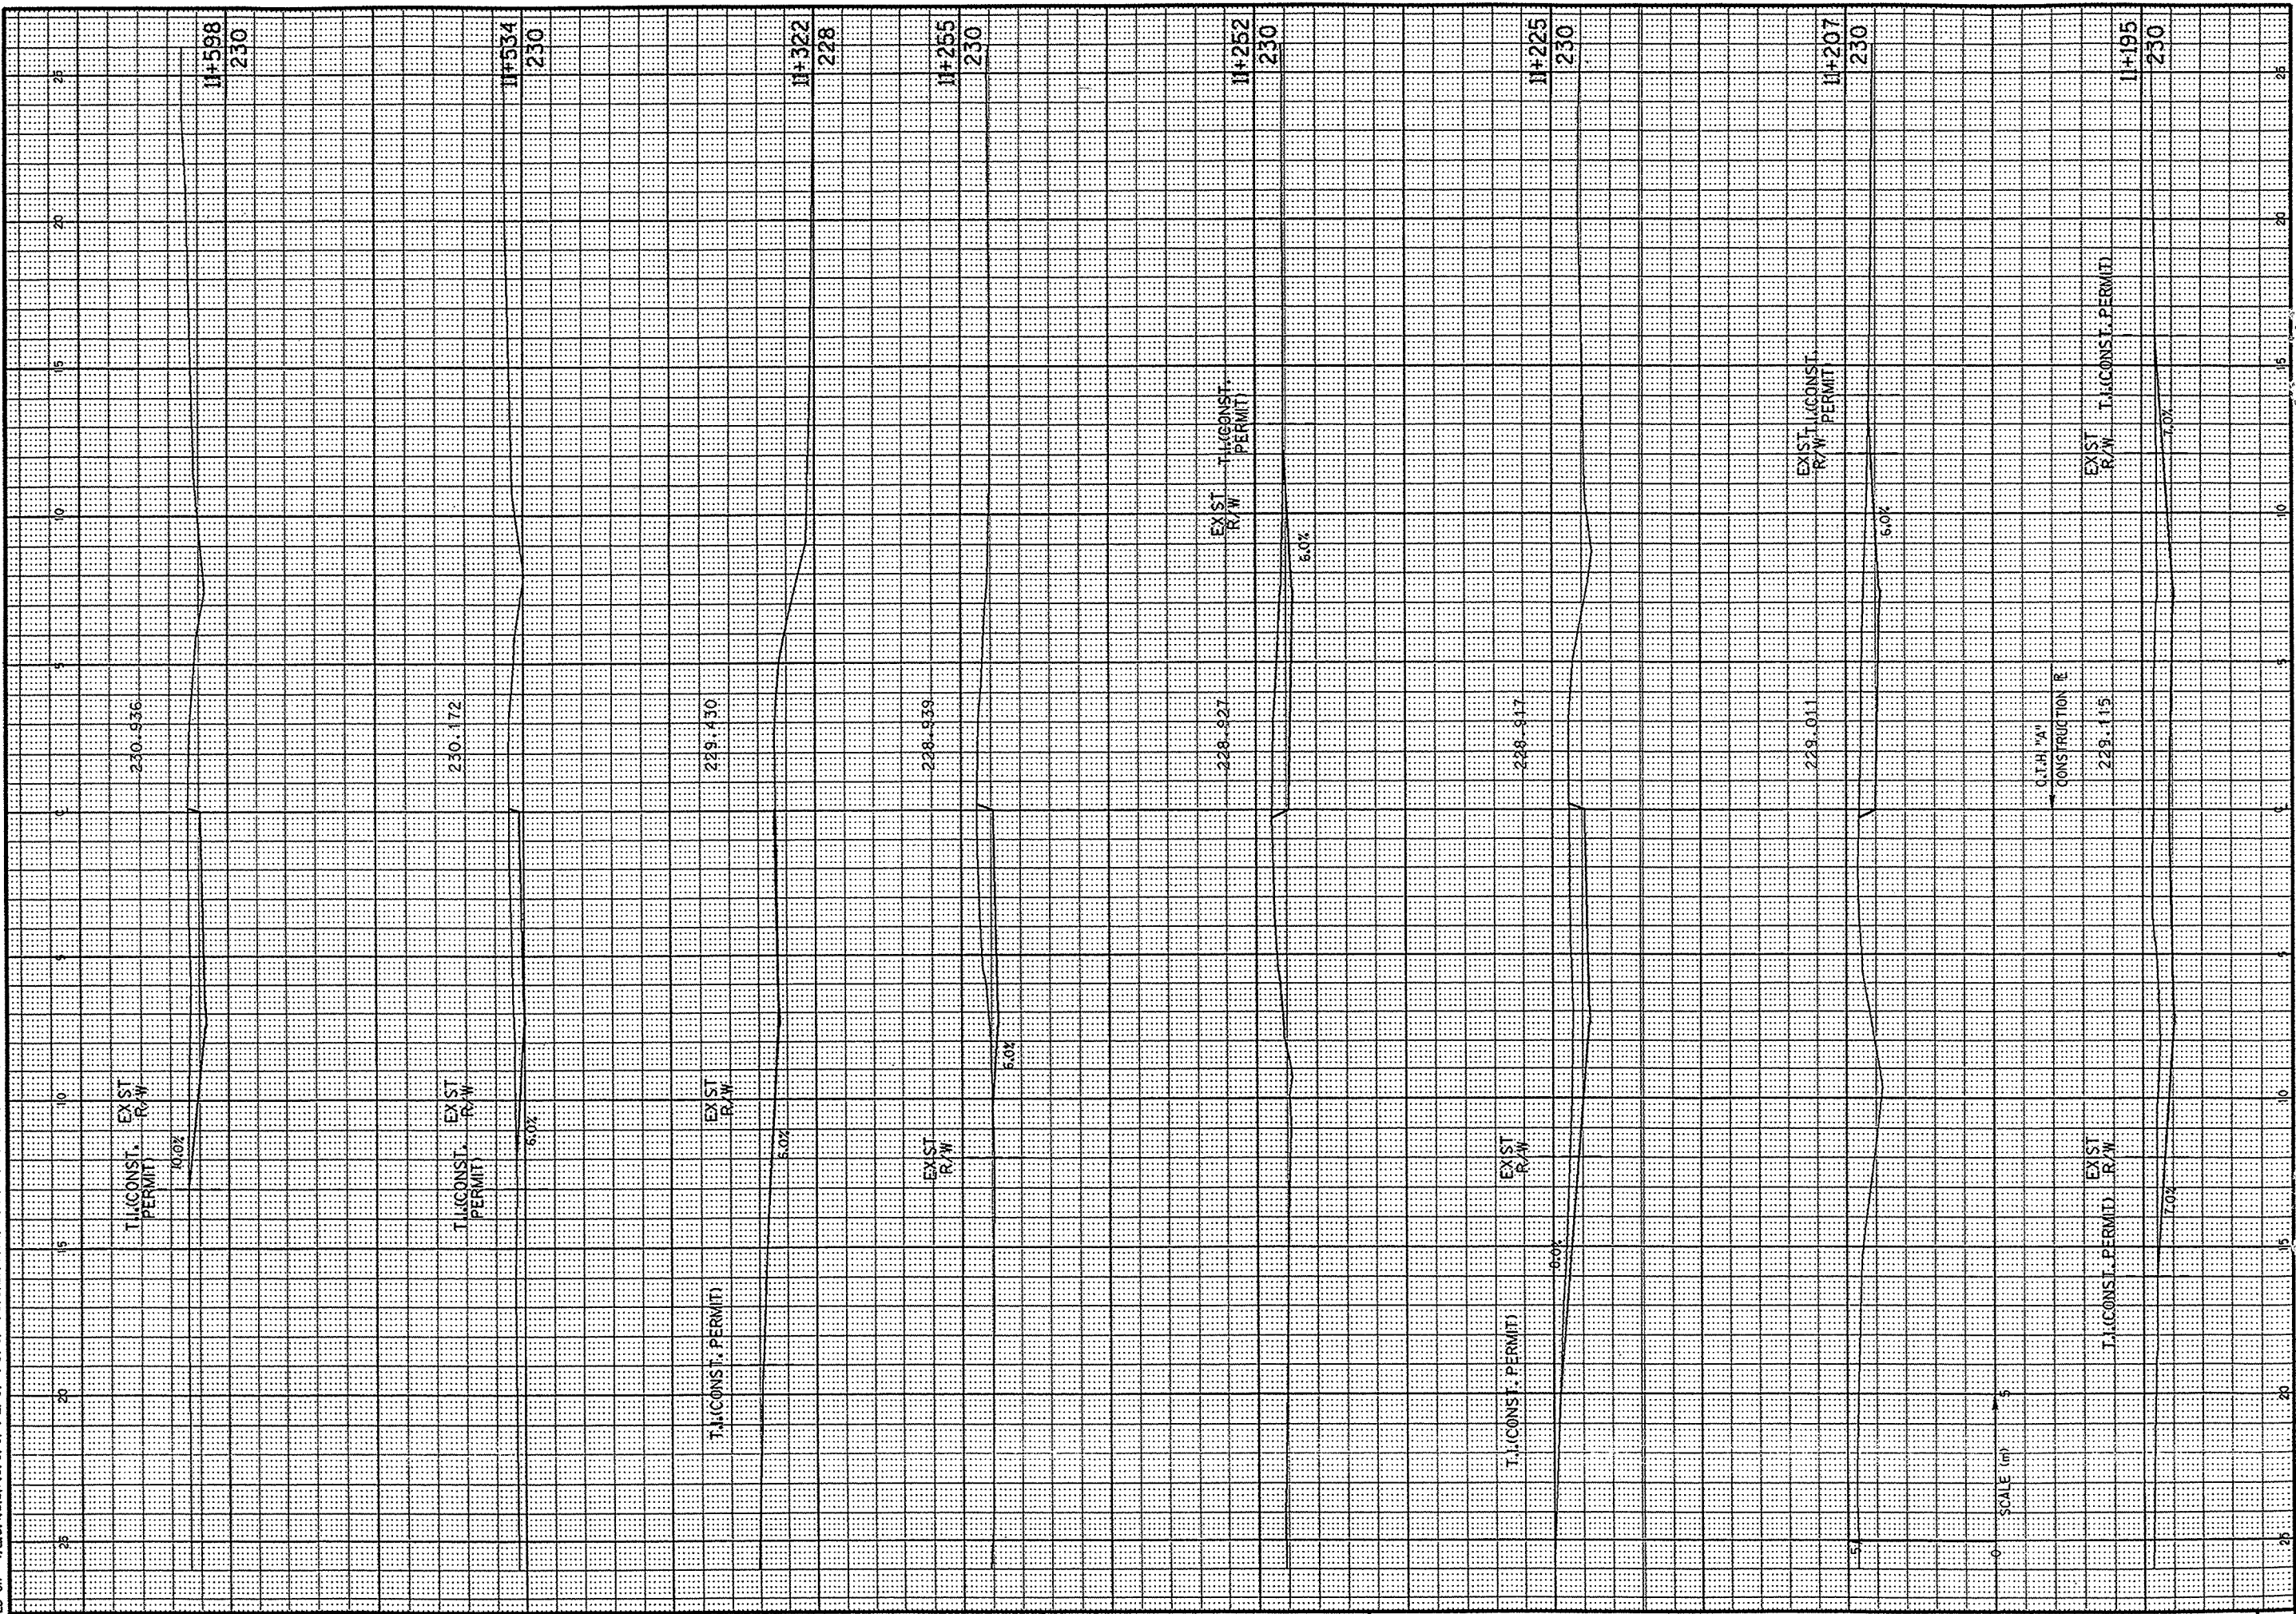

WI DOT: MSHT21

PGZ TABLE = tploft2d\user\mhof\fxs.tbl
 DATE OF PLOT = 11/24/98
 PLOT NAME = P:\LASER\3R\CO06012.PRF
 DGN FILE = P:\440278\vgm\vssec\600802.dgn

ORIGINATOR:
 LEVELS ON = 1, 2, 3, 61, 62.

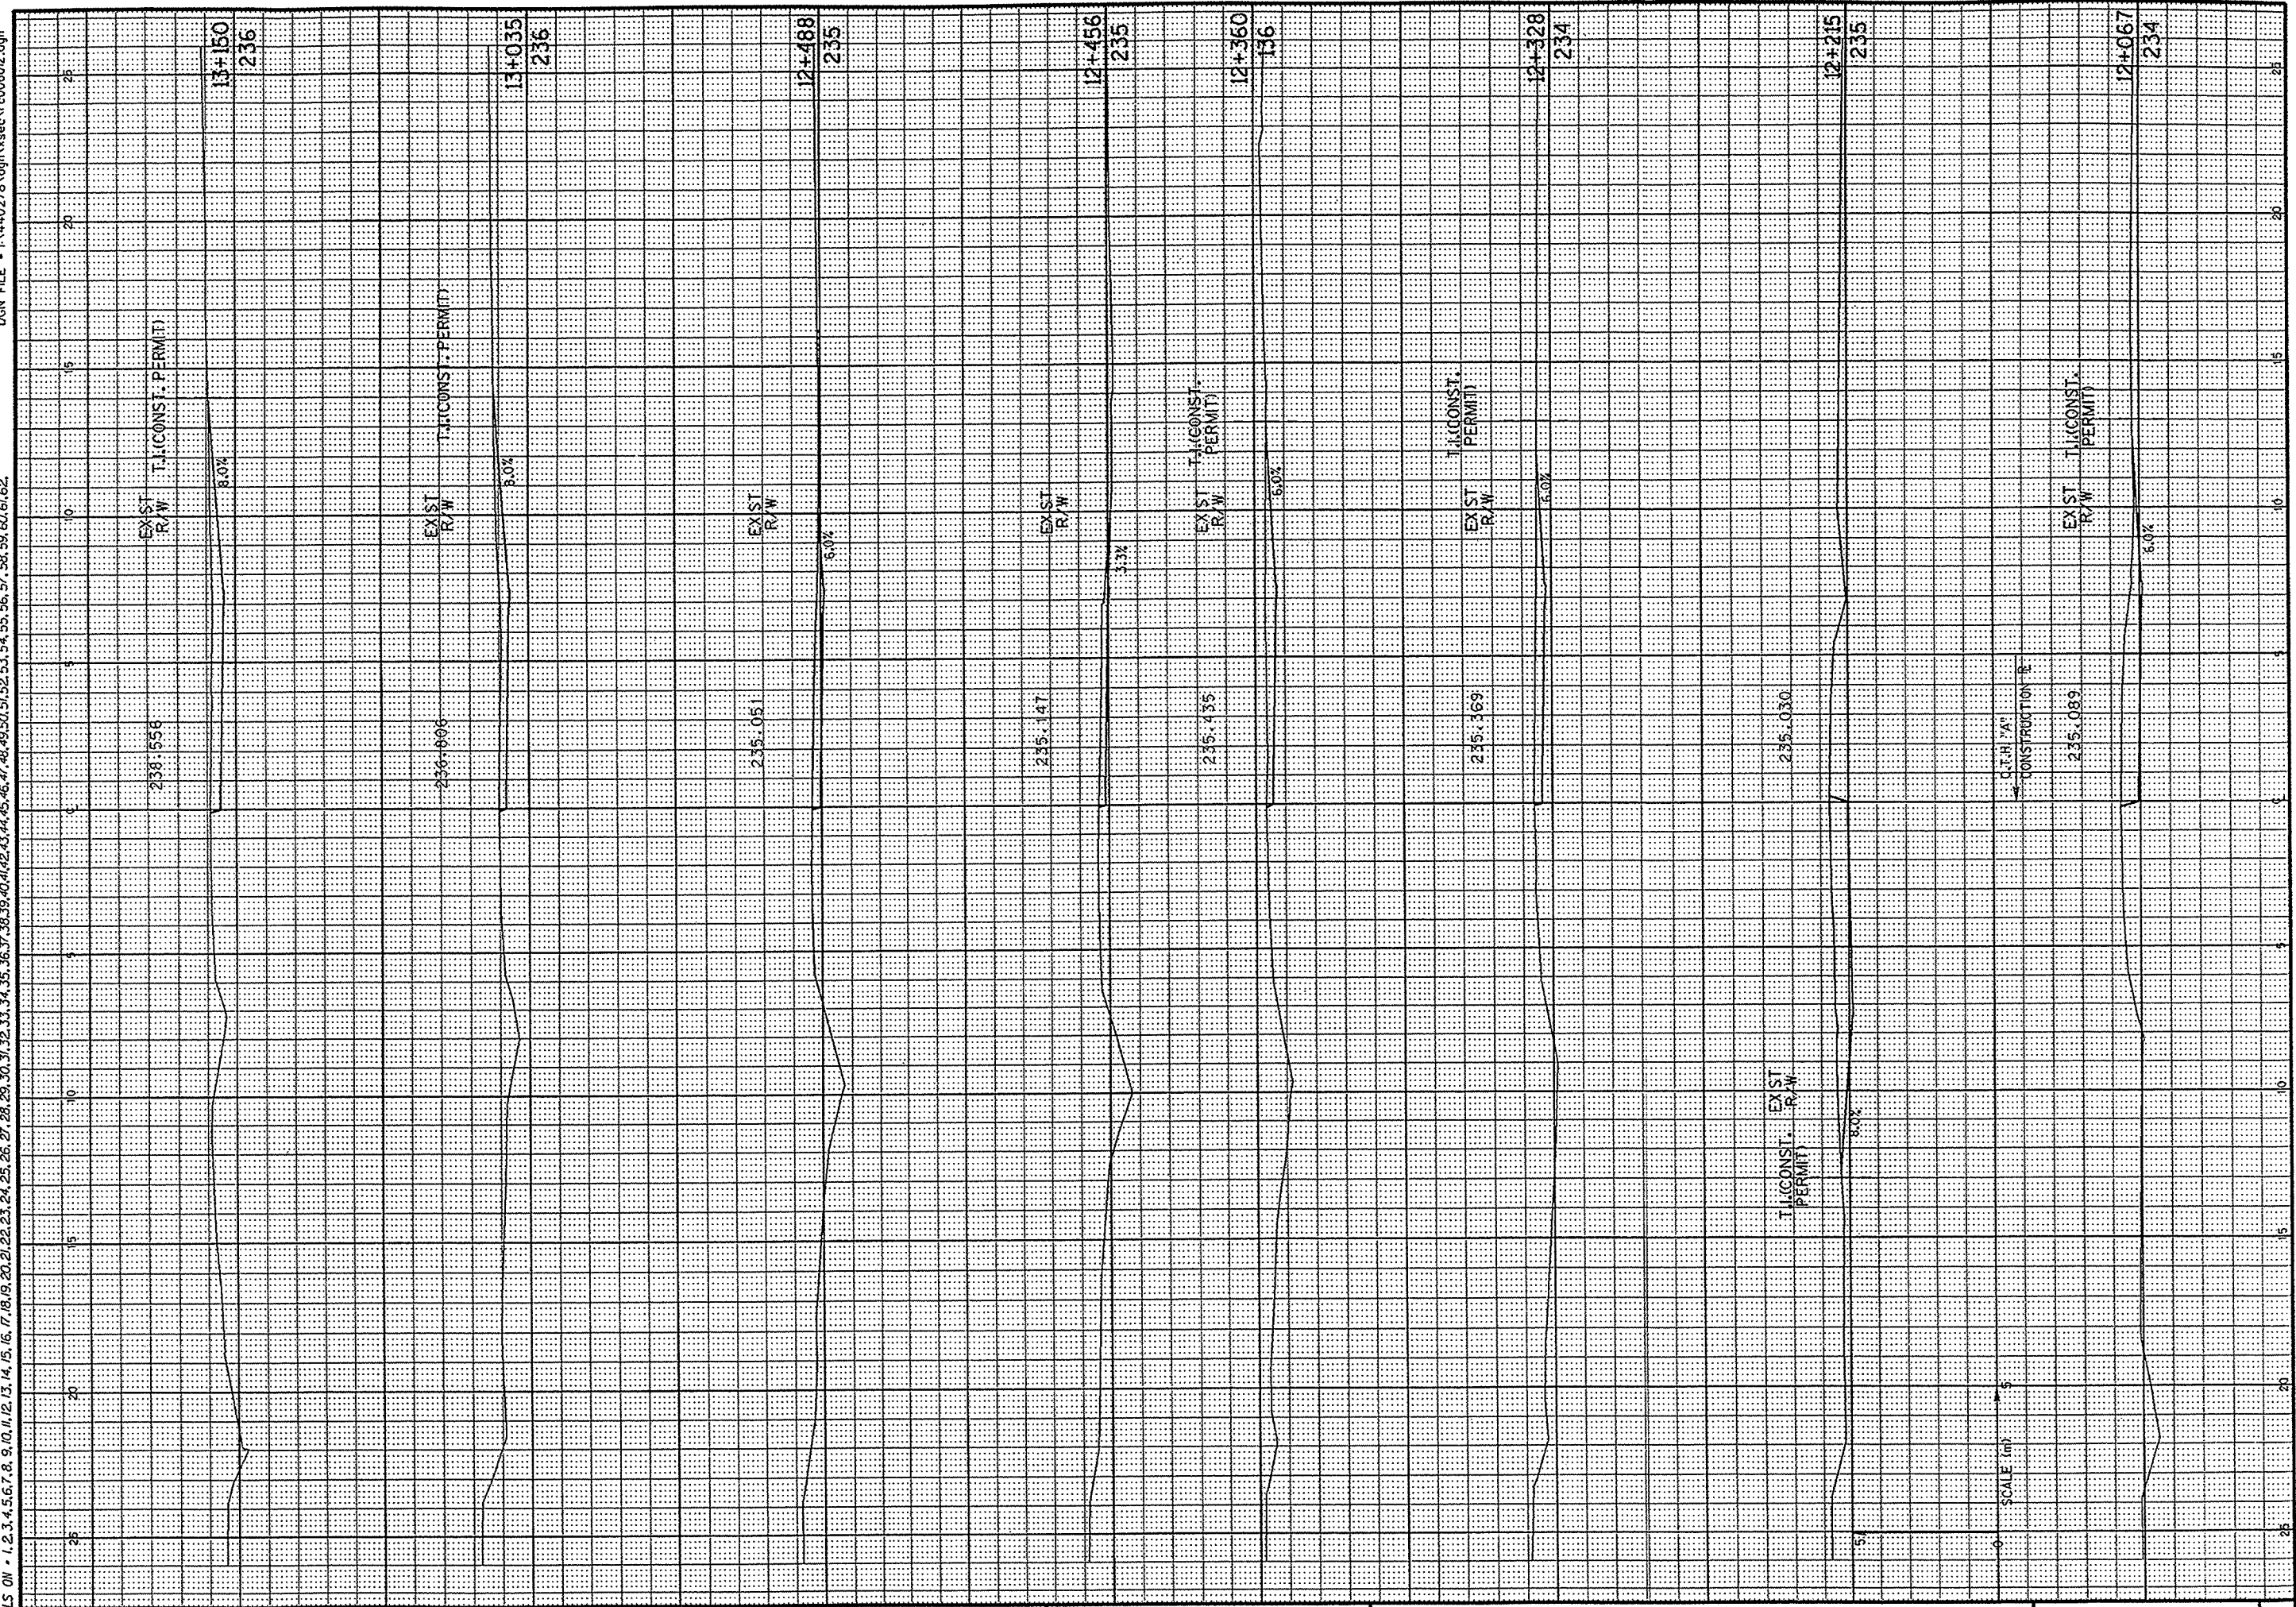

CROSS SECTION (P.E.'S. AND F.E.'S.)

HWY: C.T.H. "A"

COUNTY: WINNEBAGO

STATE PROJECT NO:

4994-00-82

SHEET NO: 9.39


M

FILE NAME:

WISDOT: MSHT21

CB2
 PEN TABLE = \$plot72\$deser\$mhof\$xs.tbl
 DATE OF PLOT 11/24/98
 PLOT NAME = P:\LASERA3\RC00702.PRF
 DGN FILE = I:\440278\dgn\ksec\rc00702.dgn

ORIGINATOR:
 LEVELS ON = 1, 2, 3, 61, 62

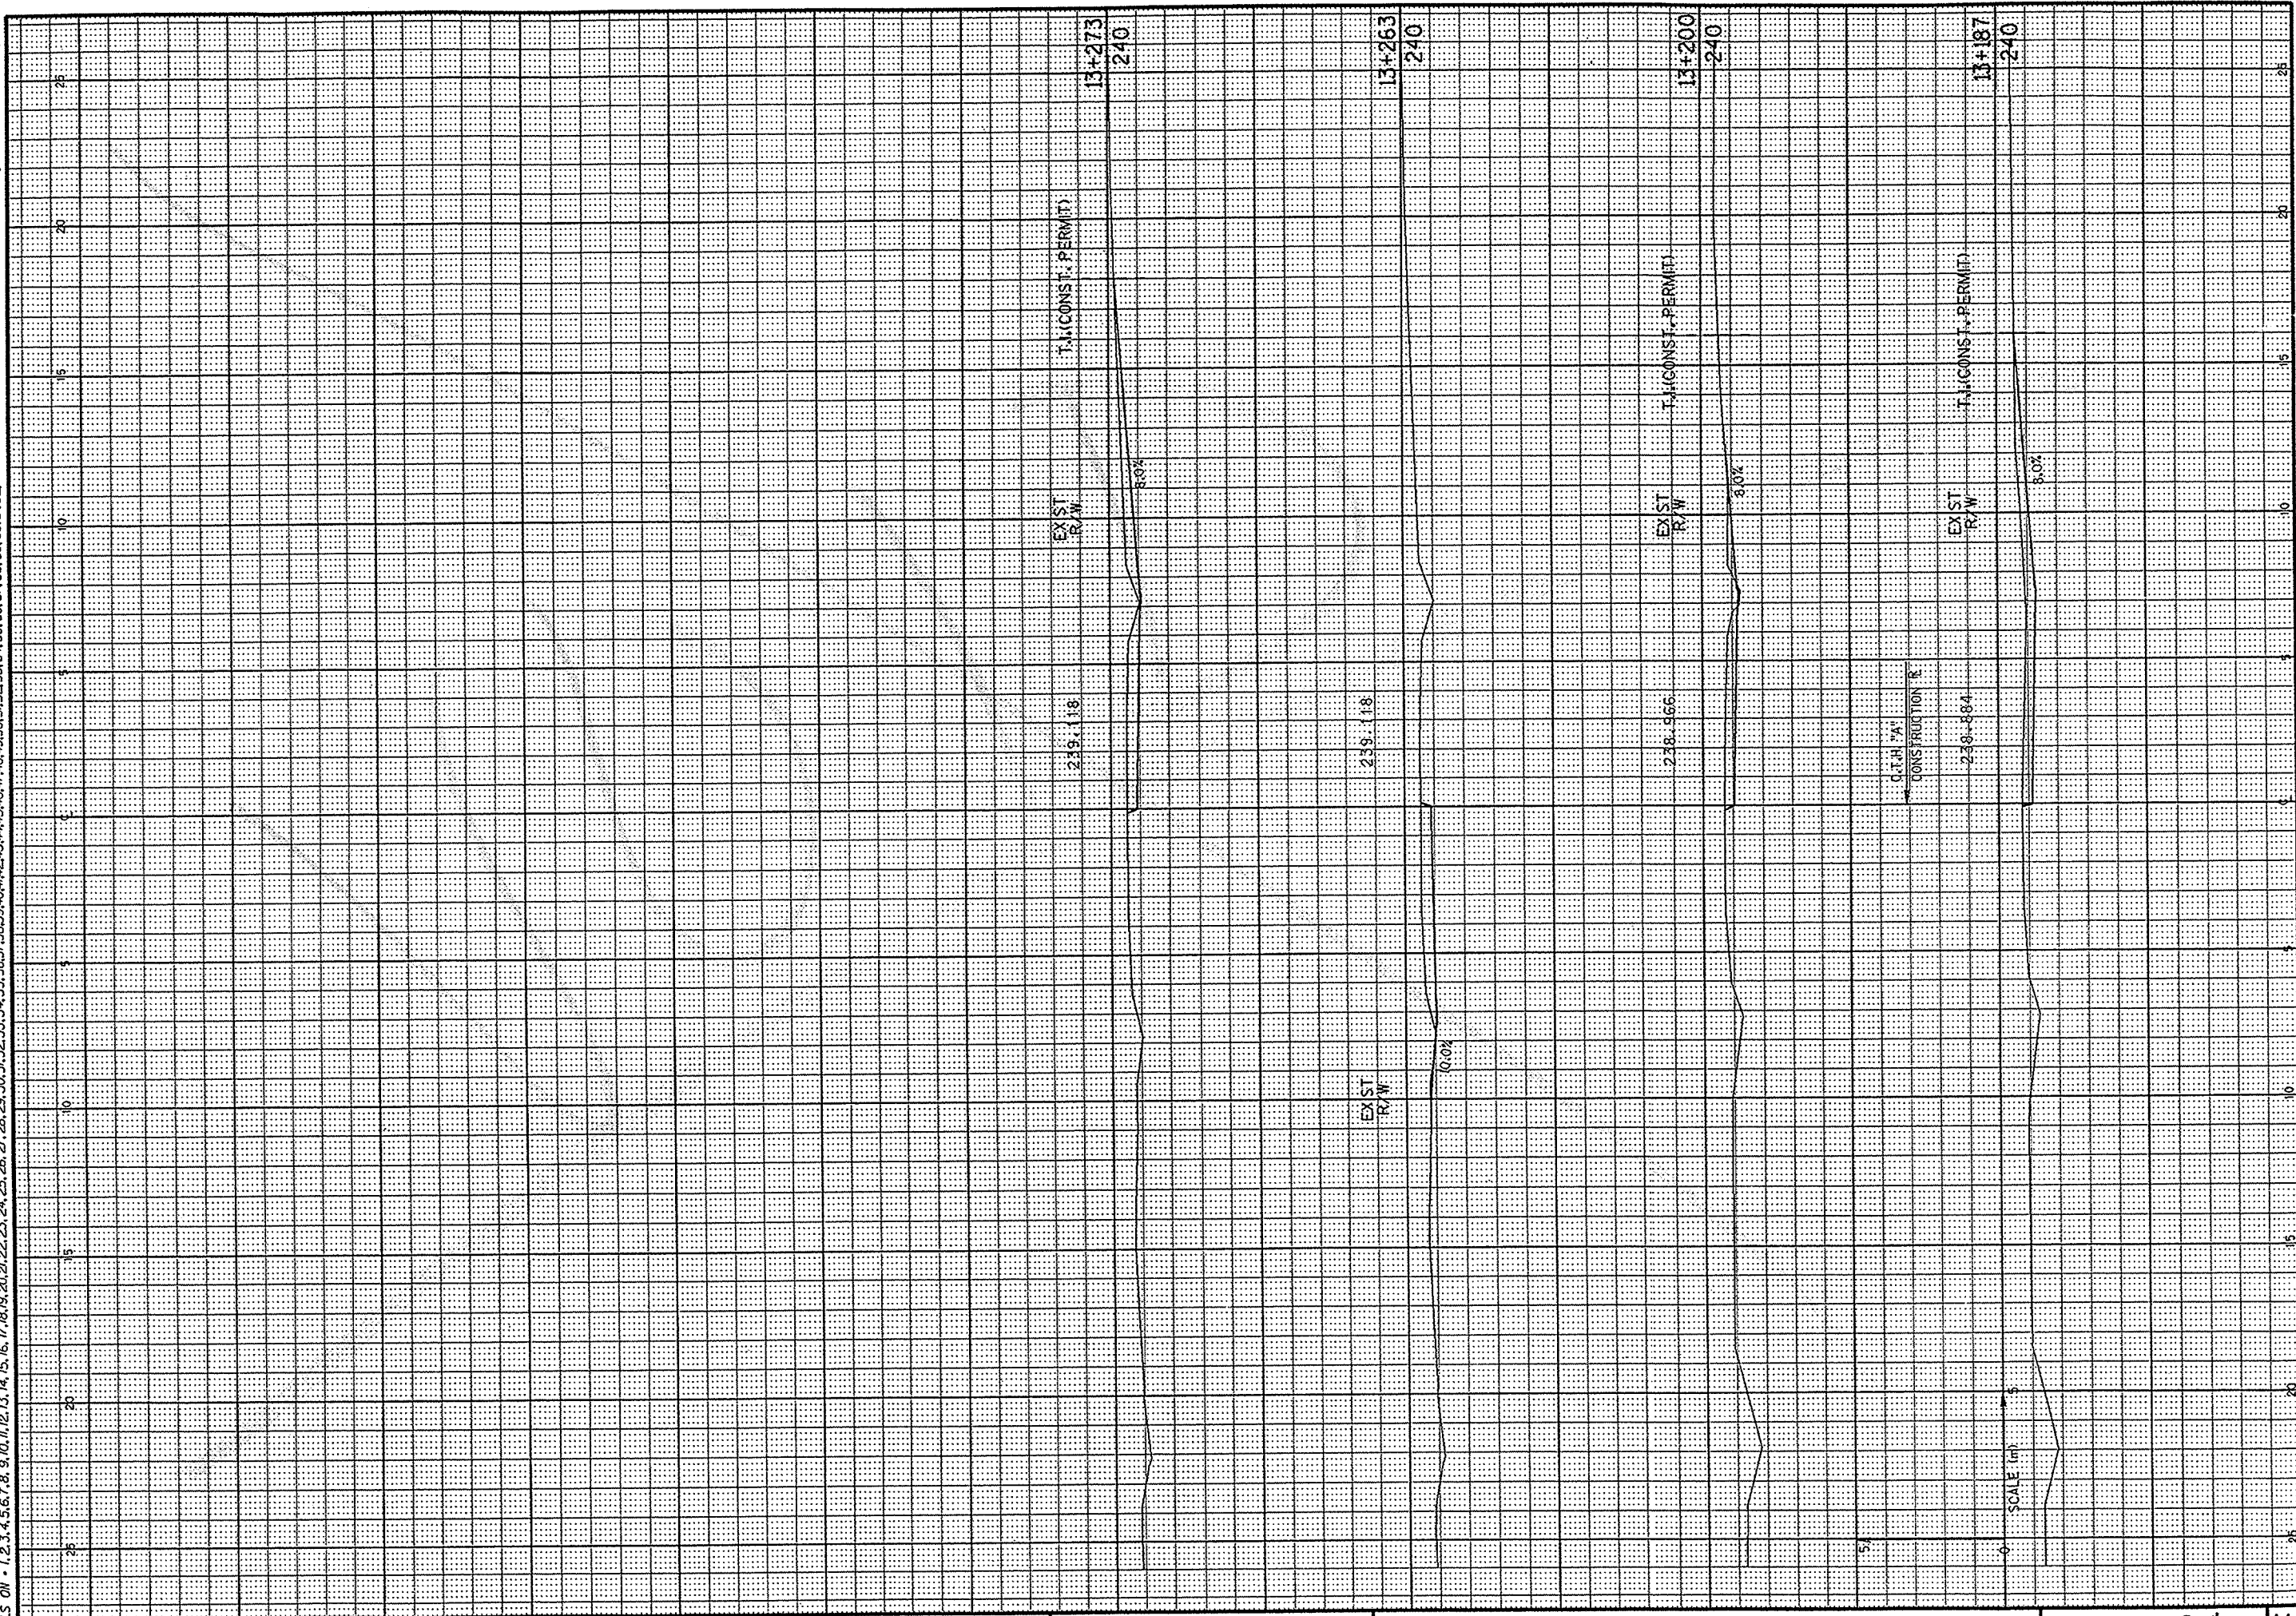

CROSS SECTION (P.E.'S. AND F.E.'S.)

HWY: C.T.H. "A"

COUNTY: WINNEBAGO

STATE PROJECT NO: 4994-00-82


SHEET NO: 9.40 M

FILE NAME:

WISDOT: MSHT21

PIN FILE - 1:1400
 DATE OF PLOT - 4/7/00
 DGN FILE - 1:1400
 DGN LVLL

ORIGINATOR:
 LEVELS ON - 1, 2, 3, 99, 100

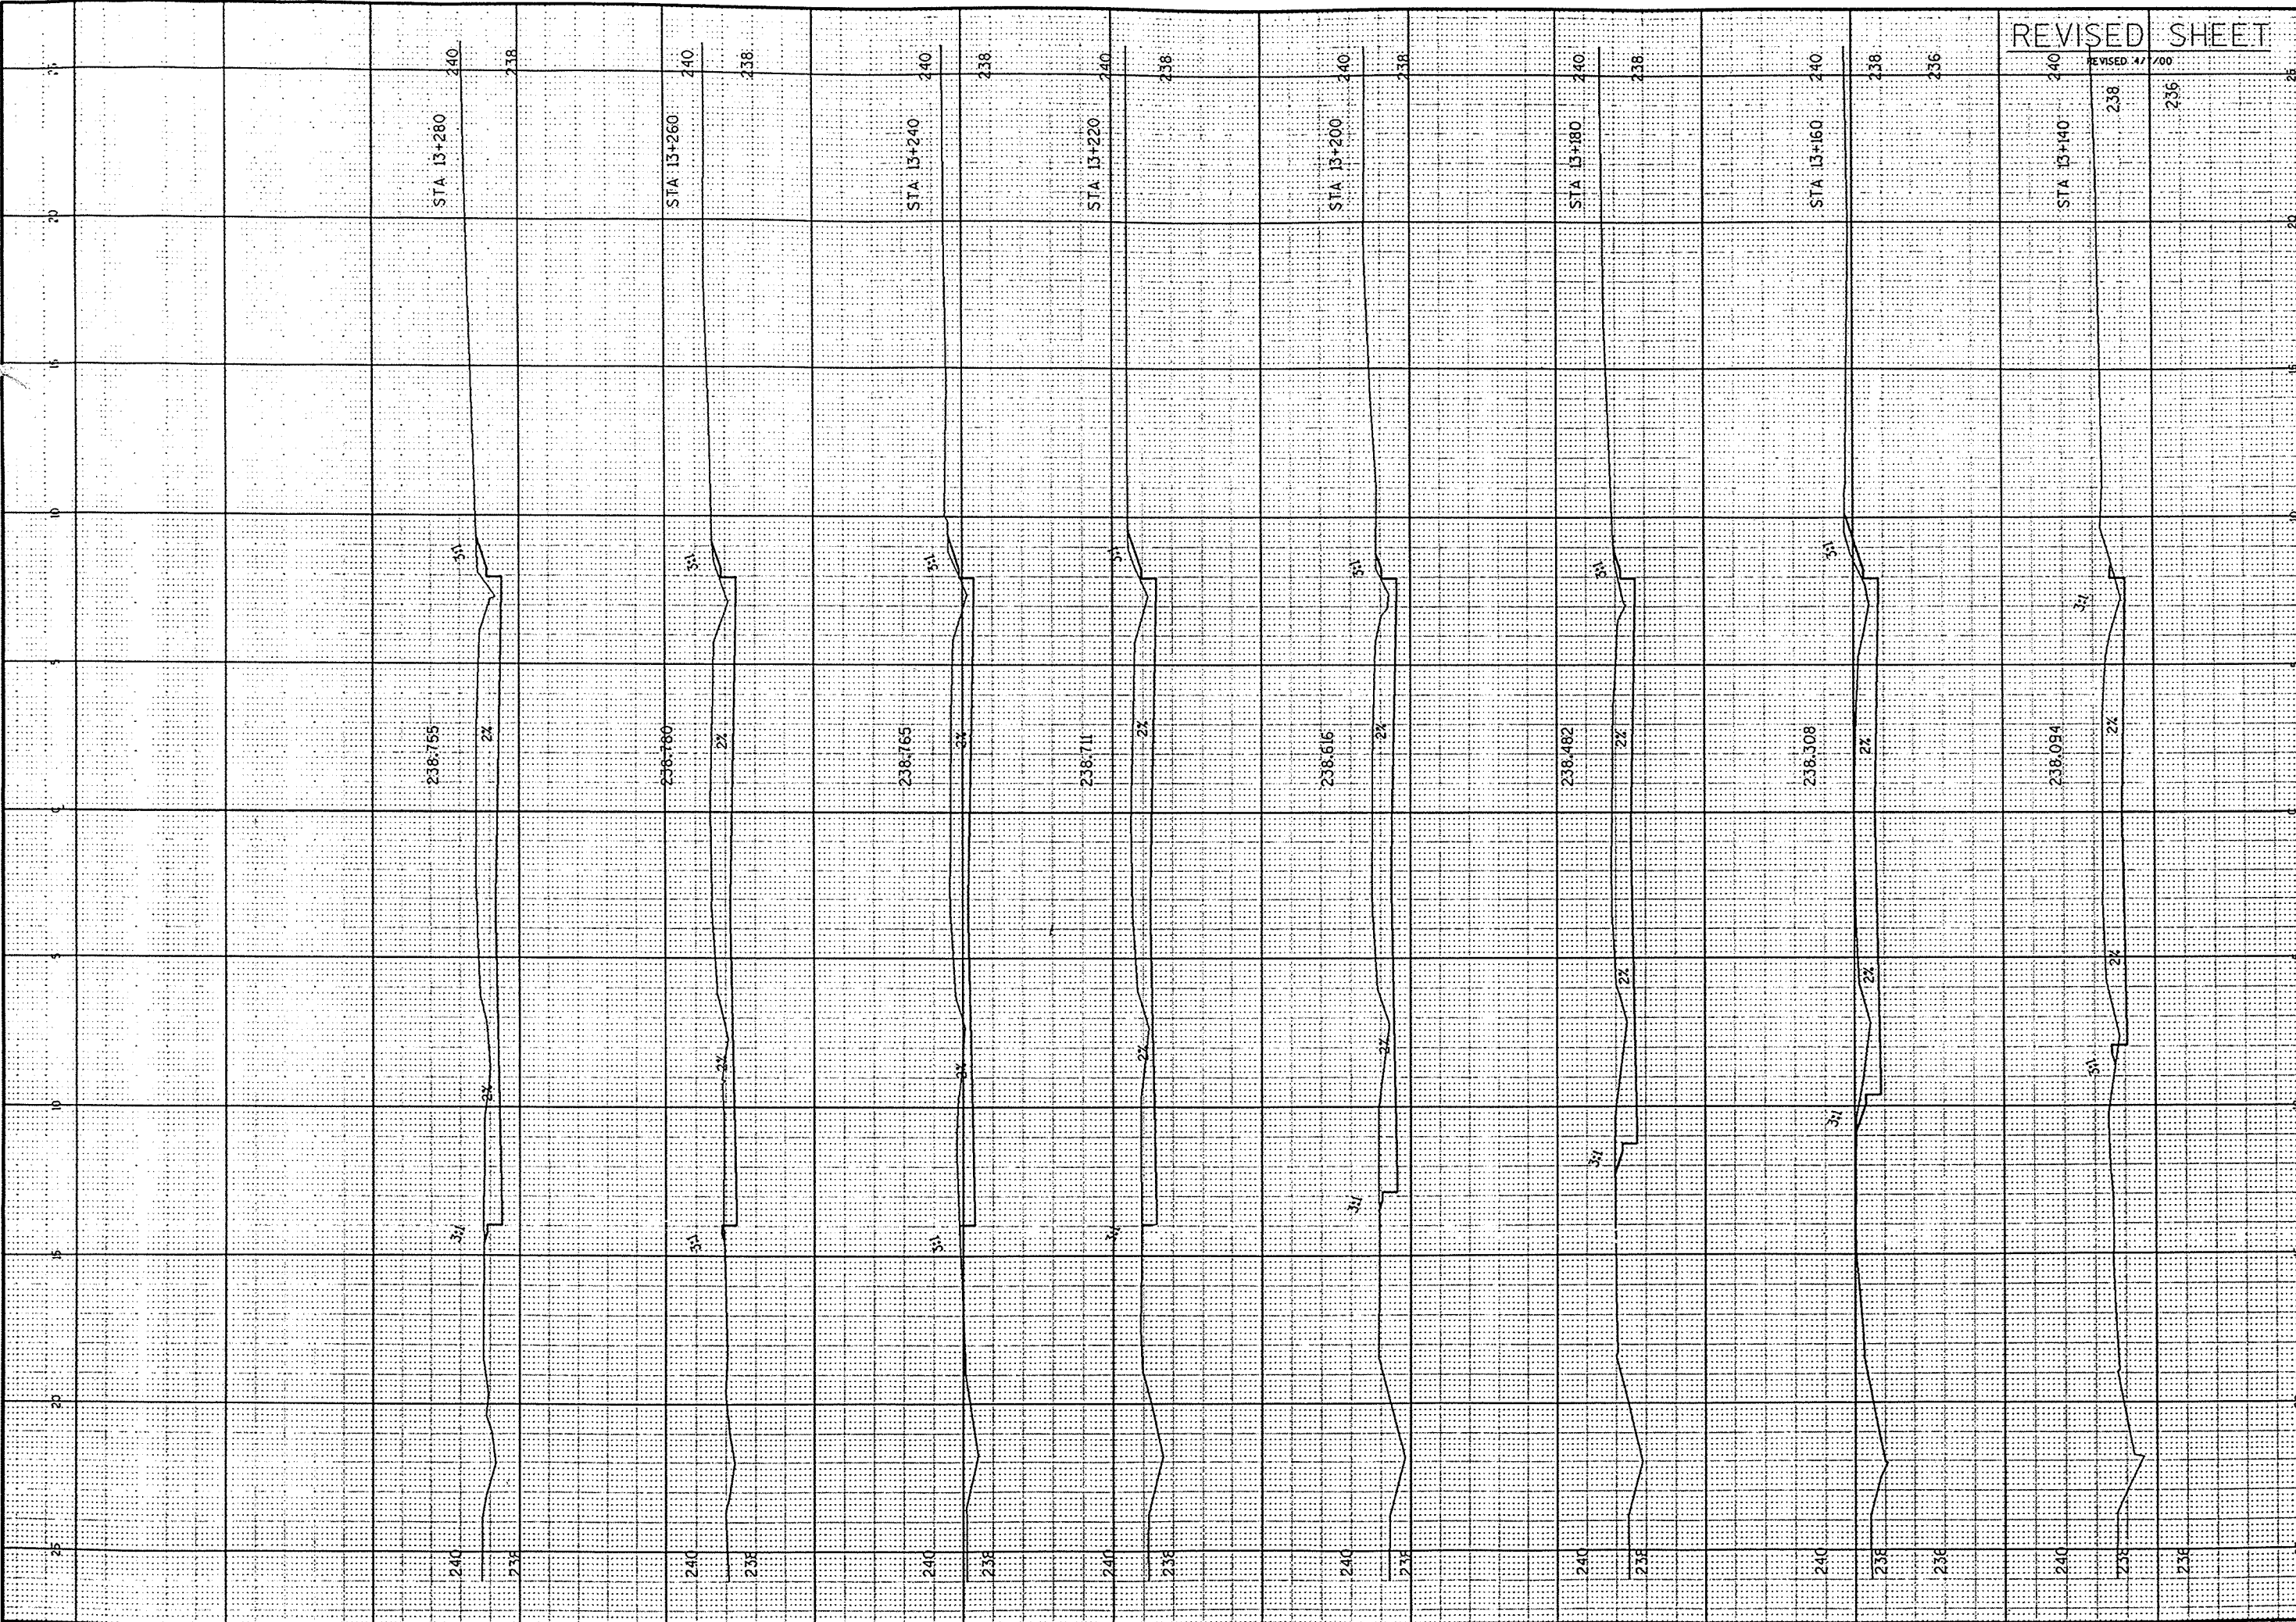

REVISED SHEET

REVISED 4/7/00

CROSS SECTIONS

HWY: C.T.H. "A"

COUNTY: WINNEBAGO

STATE PROJECT NO: 4994-00-82


SHEET NO: 9.40



WISDOT: MSHT21

PLAN TABLE
 DATE OF PLOT 4/7/00
 DRAWN BY: B. J. B.

ORIGINATOR:
 LEVELS ON - 1, 2, 3, 61, 62.

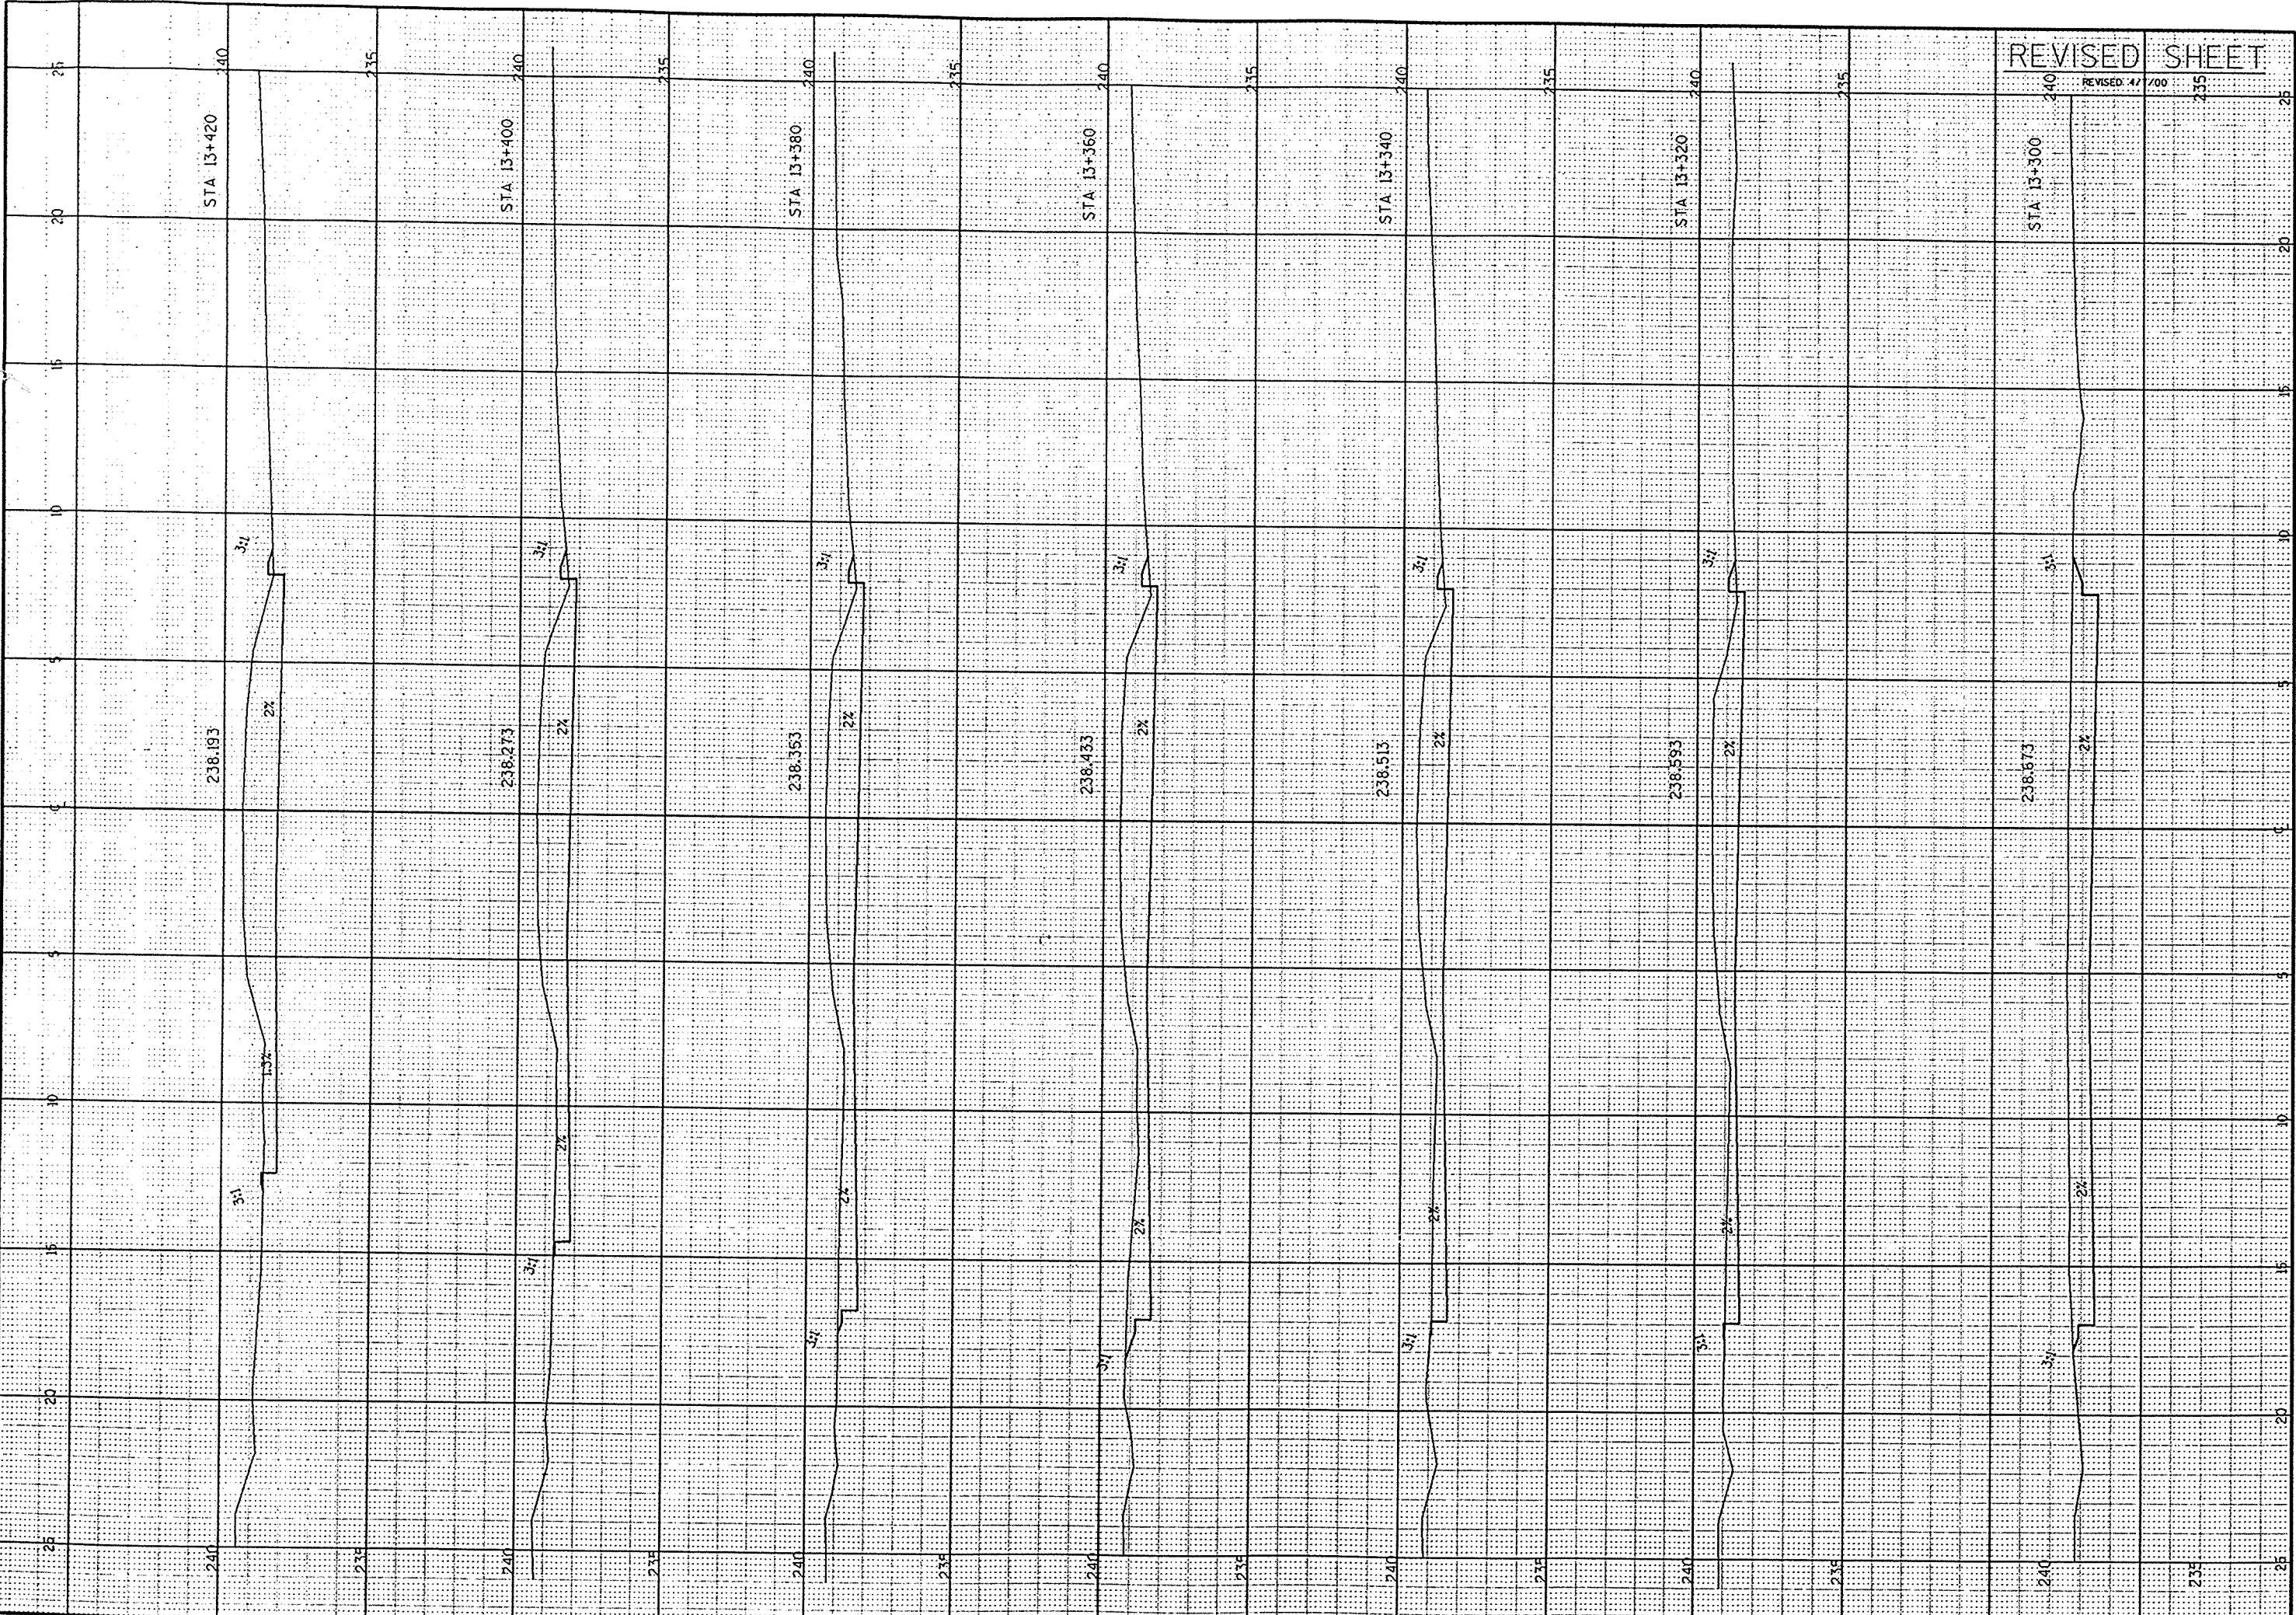

REVISED SHEET

CROSS SECTIONS

HWY: C.T.H. "A"

COUNTY: WINNEBAGO

STATE PROJECT NO: 4994-00-82

SHEET NO: 9/11



WISDOT: MSHT21

