

(B 70-63) And (B 70-64)

Sheet Number	Total Sheets
1	91

STATE OF WISCONSIN

DEPARTMENT OF TRANSPORTATION  
DIVISION OF HIGHWAYS

PLAN AND PROFILE OF PROPOSED  
WEST COUNTY LINE - OSHKOSH

S.T.H. 116 - C.T.H. "FF" SECTION

C.T.H. "E"


WINNEBAGO COUNTY

PROJECT IDENTIFICATION NUMBER	FEDERAL PROJECT DESIGNATION
6460-2-71,72,73	S 1260(3)

Scales  
Plan 1 in. = 100 ft.  
Profile Hor. 1 in. = 100 ft. Vert. 1 in. = 10 ft.  
Cross Sections Hor. 1 in. = 5 ft. Vert. 1 in. = 5 ft.

Index of Sheets

Sheet No. 1	Title
Sheet No. 2	Typical Cross Sections
Sheet No. 3	Estimate of Quantities
Sheet No. 3A	Miscellaneous Quantities
Sheet No. 4-4.5	Right of Way Plat
Sheet No. 5-14	Plan and Profile Sta. 10+00 to Sta. 458+42.37
Sheet No. 15-15.11	Standard Details
Sheet No. 16-29	Structure Plans
Sheet No. 30-91	Cross Sections

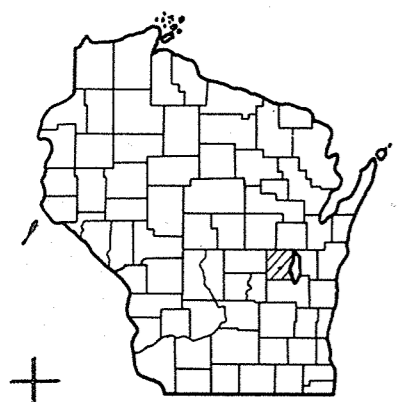

Design Designation

A. D. T. 1973	= 800
A. D. T. 1993	= 1,200
D. H. V.	= 168
D.	= 60%
T.	= 8%
V.	= 60 M.P.H.


BEGINNING OF PROJECT S 1260 (3) / 6460-2-(71,72,73)  
STA. 10 + 00  
365.78' S. 89°-56' W. OF CENTER  
SEC. 19 T. 18 N. R. 15 E.

STA. 26 + 98.60 TO STA. 27 + 11.31  
EXCEPTION TO NET & LENGTH

STRUCTURE B-70-64

END OF PROJECT S 1260 (3) / 6460-2-(71,72,73)  
STA. 458 + 42.37  
1,771.94' S. 89°-53' E. OF CENTER OF  
SEC. 21 T. 18 N. R. 16 E.

STA. 235 + 00 TO STA. 447 + 87.17  
EXCEPTION TO NET & LENGTH

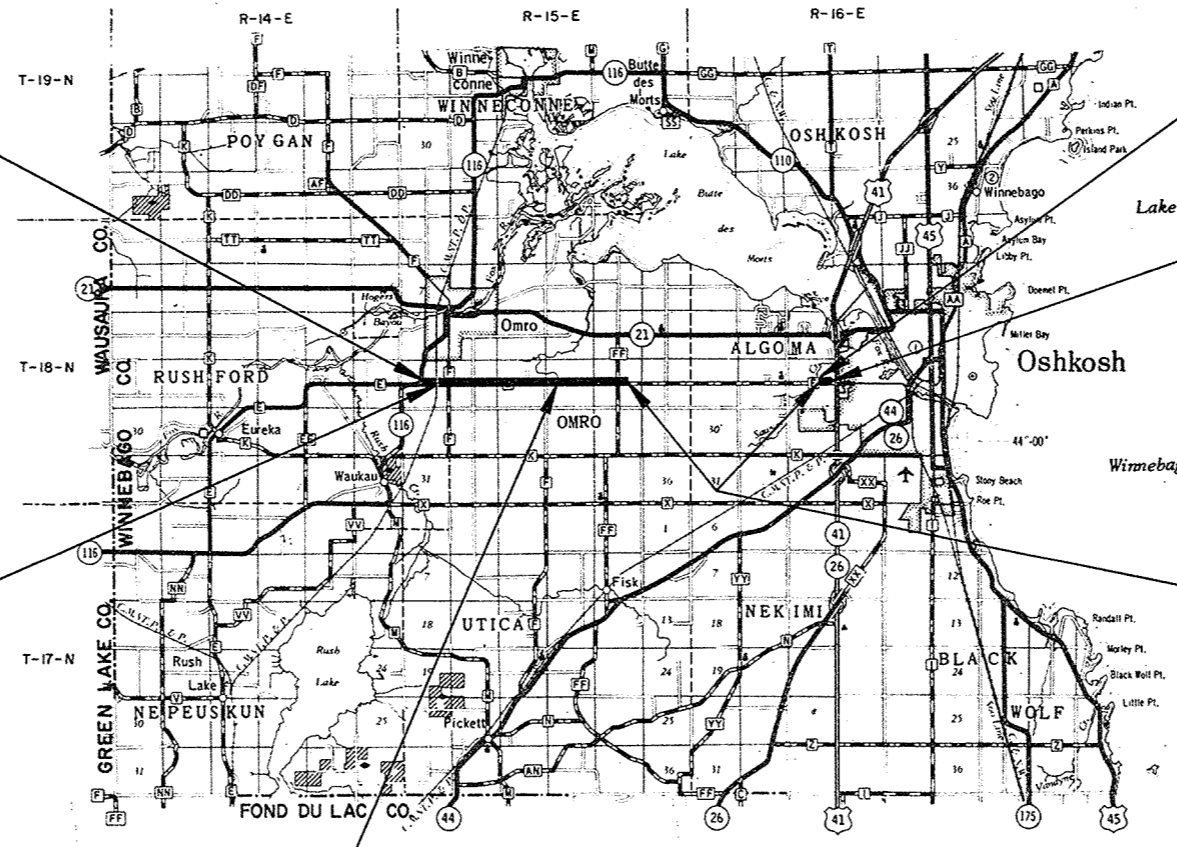

Conventional Signs


State Line	.....	Culverts in Place	.....
County Line	.....	Culverts Required	.....
Township or Range Line	.....	Drop Inlet	.....
Section Line	.....	Power Pole	.....
New Right of Way Line	.....	Telephone or Telegraph Pole	.....
Present Right of Way Line	.....	Right of Way Markers	.....
Wire Fence { Woven	.....	Reference Stake for Hubs Only	.....
{ Barbed	.....	Marsh	.....
Lot Line	.....	Hedge	.....
Corporate or City Limits	.....	Trees	.....
Property Line	.....	Ground Elevation	Datum Line 73.9
Traveled Way or P. E.	.....	Grade Elevation	Datum Line 76.16
Railroads	.....		
Base or Survey Line	.....		

Layout  
Scale 0 1 2 Mi.


Total Net Length of Centerline = 4.459 Mi.

STATE OF WISCONSIN DEPARTMENT OF TRANSPORTATION DIVISION OF HIGHWAYS	
Surveyor <u>R.D.N.</u>	District Checker <u>M.L. D.R.C.</u>
Designer <u>C.W.M., C.M.G.</u>	C.O. Checker <u>J.L.J.</u>
Correct:	
Date <u>4-27-72</u>	<u>F.H. Jullow</u> District Engineer
Recommended for Approval:	
Date <u>5/30/72</u>	<u>C. Harried</u> Chief Design Engineer
Approved:	
Date <u>5/31/72</u>	<u>S. Ethicks</u> State Highway Engineer
U.S. DEPARTMENT OF TRANSPORTATION FEDERAL HIGHWAY ADMINISTRATION	
REGION 4 WISCONSIN DIVISION	
Approved:	
Date _____ Division Engineer	

PROJECT I.D. 6460 - 2 - 71, 72, 73	SHEET NUMBER <b>2</b>	TOTAL SHEETS <b>91</b>
FEDERAL PROJECT DESIGNATION S 1260(3)		
TYPICAL CROSS SECTIONS FOR C.T.H. "E" WINNEBAGO CO.		

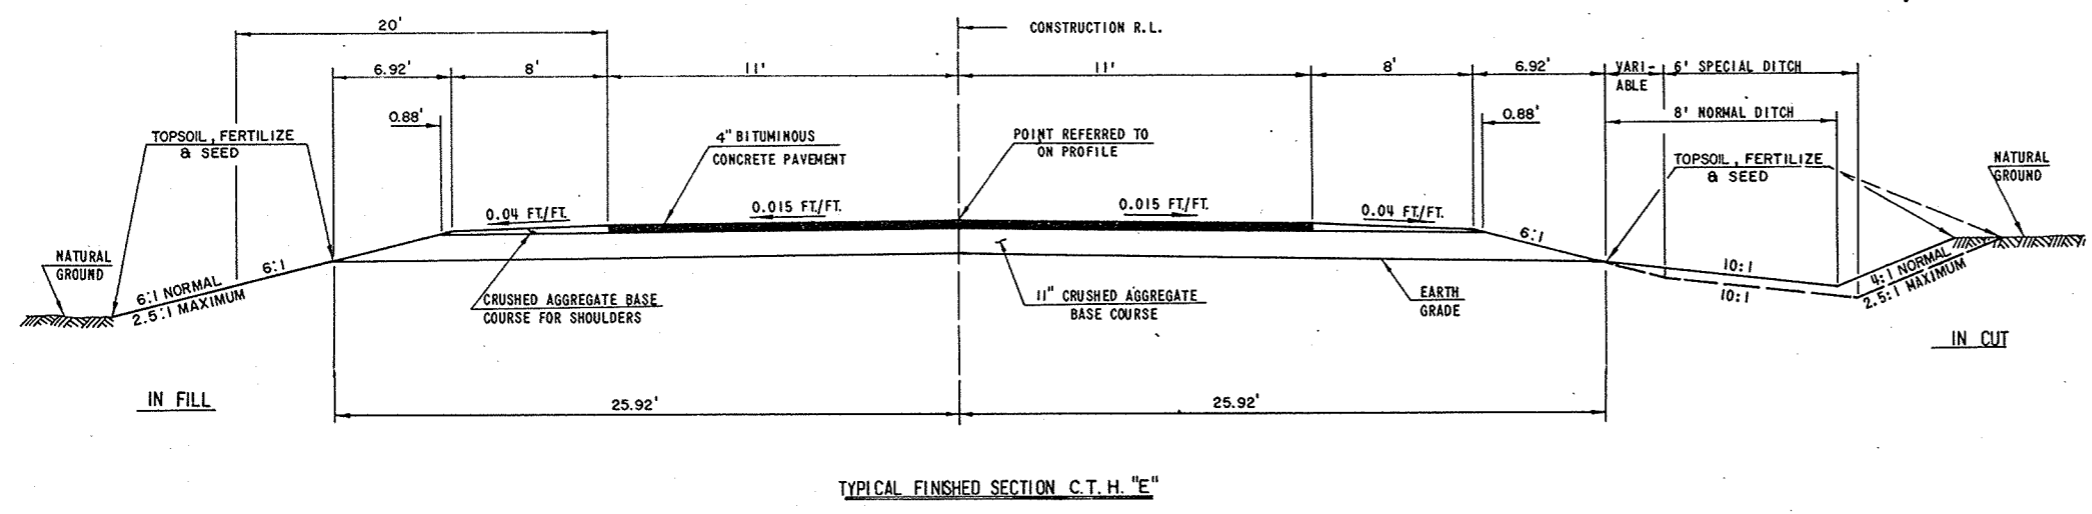

TYPICAL FINISHED SECTION C.T.H. "E"

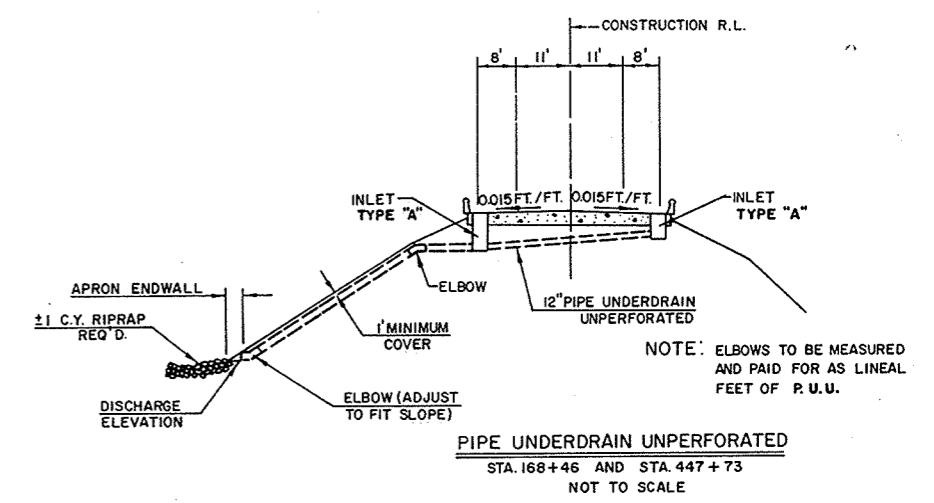

PIPE UNDERDRAIN UNPERFORATED  
STA. 168+46 AND STA. 447+73  
NOT TO SCALE

GENERAL NOTES


SALVAGED TOPSOIL SHALL BE PLACED TO AN APPROXIMATE DEPTH OF 3 INCHES  
CERTAIN UNDERGROUND UTILITY STRUCTURES HAVE BEEN LOCATED ON THESE PLANS. THESE LOCATIONS SHALL NOT BE TAKEN AS CONCLUSIVE. VERIFICATION AS TO THE LOCATION TO THE SATISFACTION OF THE CONTRACTOR OF ALL UNDERGROUND UTILITY STRUCTURES, WHETHER SHOWN ON THE PLANS OR NOT, SHALL BE ASSUMED AS A CONDITION OF THE CONTRACT.  
THE EXACT LOCATION OF CULVERT PIPE, PRIVATE ENTRANCES AND FIELD ENTRANCES SHALL BE DETERMINED BY THE ENGINEER IN THE FIELD.  
CUBIC YARDS OF FILL AS SHOWN ON THE PLAN SHEETS PERTAINS TO EMBANKMENT CONSTRUCTED FROM UNCLASSIFIED AND BORROW EXCAVATION AND WAS COMPUTED WITH A SHRINKAGE ALLOWANCE OF 25% - 30% FOR UNCLASSIFIED EXCAVATION AND 15% FOR BORROW EXCAVATION BASED ON THE VOLUME OF THE FILL.  
BITUMINOUS SURFACING AND SHOULDERS IS NOT PART OF THESE CONTRACTS.  
WHEN THE QUANTITY OF THE ITEMS OF SUBBASE, AND BASE COURSE ARE MEASURED FOR PAYMENT BY THE TON OR CUBIC YARD, THE DEPTH OR THICKNESS OF THE COURSE SHOWN ON THE PLANS IS APPROXIMATE AND THE ACTUAL THICKNESS WILL DEPEND ON THE DISTRIBUTION OF THE MATERIAL AS DIRECTED BY THE ENGINEER.

UTILITIES LOCATED WITHIN THIS PROJECT


CHICAGO, MILWAUKEE, ST. PAUL & PACIFIC RAILROAD (MILWAUKEE ROAD)  
WISCONSIN TELEPHONE COMPANY  
WISCONSIN POWER AND LIGHT COMPANY  
WISCONSIN PUBLIC SERVICE CORP.

STANDARD DETAIL DRAWINGS


INLETS TYPE 1 & 2 & INLET COVERS	8C1-1
SURFACE DRAIN DROP INLET TYPE	8D3-1
APRON ENDWALLS	8F1-2
CORRUGATED METAL PIPE ARCH	8F2-1
SIDE ROAD INTERSECTIONS	9A1-1
CONCRETE PAVEMENT REINFORCEMENT	13A1-1
PAVEMENT DETAILS FOR RAILROAD APPROACH	13B1-1
CLASS "A" STEEL PLATE BEAM GUARD	14B2-2 A&B
MARKER POSTS	15A1-1
CONSTRUCTION BARRICADE	15C1-1
LANDMARK REFERENCE MONUMENTS	16A1-1

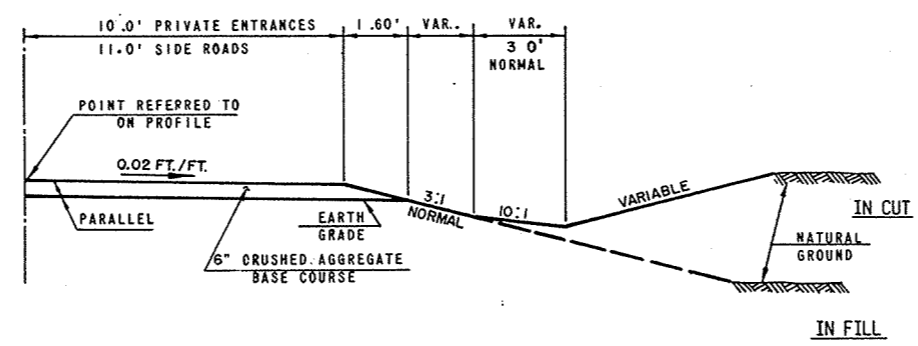


1/2 TYPICAL SECTION GRAVEL SURFACE SIDE ROADS AND PRIVATE ENTRANCES

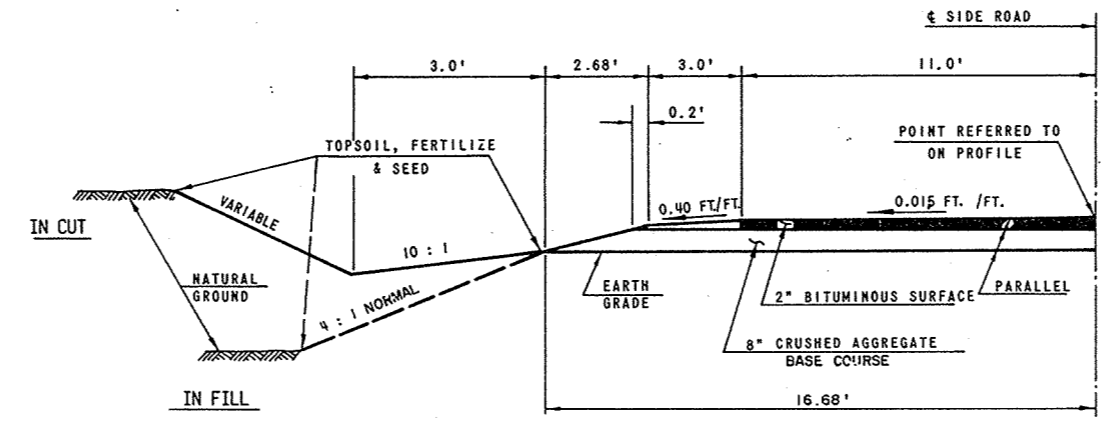


1/2 TYPICAL SECTION BITUMINOUS SURFACE FOR SIDE ROADS

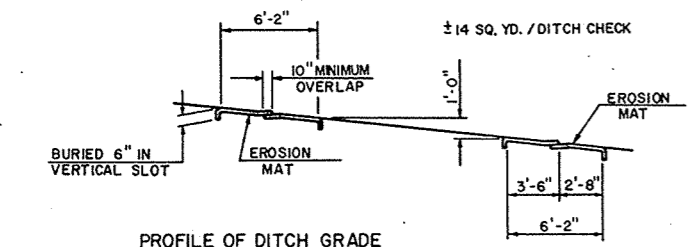

PROFILE OF DITCH GRADE

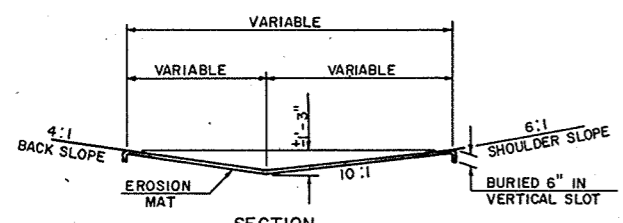

DETAILS OF EROSION MAT DITCH CHECKS

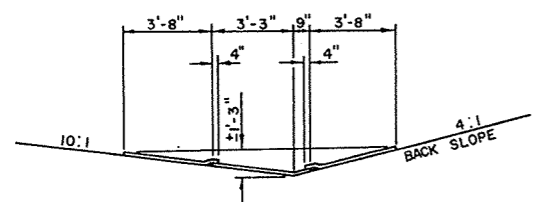

EROSION MAT DITCH PROTECTION

# ESTIMATE OF QUANTITIES

CONTRACT NO. 1 (6460-2-71)  
STRUCTURES B-70-63,64  
CONTRACT NO. 2 (6460-2-72)  
BASE COURSE  
CONTRACT NO. 3 (6460-2-73)  
GRADING

PROJECT I.D. 6460-2-71, 72, 73	SHEET NUMBER	TOTAL SHEETS
FEDERAL PROJECT DESIGNATION S 1260(3)	<b>3</b>	<b>91</b>

THIS PROJECT IS TO BE EXECUTED UNDER THE STANDARD SPECIFICATIONS FOR ROAD AND BRIDGE CONSTRUCTION OF THE WISCONSIN DIVISION OF HIGHWAYS - EDITION OF 1969.  
APPROVED MARCH 3, 1969, FEDERAL AID REQUIRED CONTRACT PROVISIONS APPROVED NOVEMBER 15, 1968, AND SPECIAL PROVISIONS AS ATTACHED TO PROPOSALS.

CONTRACT NO.	STATION TO STATION	NET LENGTH OF CENTER-LINE	CLEARING	CLEARING	GRUBBING	GRUBBING	UNCLASSIFIED EXCAVATION	BORROW EXCAVATION	FINISHING ROADWAY	CRUSHED AGGREGATE BASE COURSE	CULVERT PIPE CLASS III				APRON ENDWALLS FOR CULVERT PIPE				CORRUGATED METAL PIPE ARCH					
											18 - INCH	24 - INCH	30 - INCH	36 - INCH	18 - INCH	24 - INCH	30 - INCH	36 - INCH	22"X 13"	29"X 18"	36"X 22"	43"X 27"	58"X 36"	65"X 40"
											52003	52005	52007	52009	52061	52063	52065	52067	52136	52138	52139	52140	52142	52143
UNIT	LIN. FT.	STATION	IN. DIA.	STATION	IN. DIA.	CU. YD.	CU. YD.	L.S.	TON	LIN. FT.	LIN. FT.	LIN. FT.	LIN. FT.	EACH	EACH	EACH	EACH	LIN. FT.	LIN. FT.	LIN. FT.	LIN. FT.	LIN. FT.	LIN. FT.	
1	B-70-63,64	130.78																						
2	STA. 10 + 00 - STA 458+42.37	23,411.71								76,300														
3	STA. 10 + 00 - STA. 458 + 42.37	23,411.71	8	2,102	8	2,116	51,860	28,561	1		1,414	556	108	32	94	26	2	2	96	344	178	32	148	74
<b>PROJECT TOTALS</b>		<b>23,542.49</b>	<b>8</b>	<b>2,102</b>	<b>8</b>	<b>2,116</b>	<b>51,860</b>	<b>28,561</b>	<b>1</b>	<b>76,300</b>	<b>1,414</b>	<b>556</b>	<b>108</b>	<b>32</b>	<b>94</b>	<b>26</b>	<b>2</b>	<b>2</b>	<b>96</b>	<b>344</b>	<b>178</b>	<b>32</b>	<b>148</b>	<b>74</b>

## BRIDGES (STRUCTURES OVER 20FT. SPAN)

CONTRACT NO.	REMOVING OLD BRIDGE, STA. 169 + 00	REMOVING OLD BRIDGE, STA. 448 + 18	EXCAVATION FOR STRUCTURES	GRANULAR BACKFILL	CONCRETE SURFACE DRAINS	CONCRETE MASONRY	PRESTRESSED GIRDER, I TYPE, 36 - INCH	PRESTRESSED GIRDER, I TYPE, 45 - INCH	BAR STEEL REINFORCEMENT	STRUCTURAL CARBON STEEL	BEARING PADS ELASTOMERIC	CAST-IN-PLACE CONCRETE PILING DELIVERED AND DRIVEN 10 3/4 - INCH	STEEL PILING DELIVERED AND DRIVEN 10 - INCH X 42 POUND	TUBULAR RAILING, TYPE "J"	RIPRAP	HEAVY RIPRAP	INLETS, TYPE I	INLET COVERS, TYPE "A"	METAL APRON ENDWALLS FOR CULVERT PIPE, 12 - INCH	PIPE UNDERDRAIN UNPERFORATED 12 - INCH	FIELD OFFICE TYPE "A"
	L.S.	L.S.	CU. YD.	CU. YD.	CU. YD.	CU. YD.	LIN. FT.	LIN. FT.	LBS.	LBS.	SQ. FT.	LIN. FT.	LIN. FT.	LIN. FT.	CU. YD.	CU. YD.	EACH	EACH	EACH	LIN. FT.	L.S.
1	B-70-63	1	20	10	5	170.4	476		23,890	460	14	720		162	1	170	2	2	1	72	
1	B-70-64		82	48	5	181	246	27,840	430	10		640	157	1	210	2	2	1	76		
<b>PROJECT TOTALS</b>		<b>1</b>	<b>1</b>	<b>102</b>	<b>58</b>	<b>10</b>	<b>351.4</b>	<b>476</b>	<b>51,730</b>	<b>890</b>	<b>24</b>	<b>720</b>	<b>640</b>	<b>319</b>	<b>2</b>	<b>380</b>	<b>4</b>	<b>4</b>	<b>2</b>	<b>148</b>	<b>1</b>

## METAL APRON ENDWALLS FOR PIPE ARCH

CONTRACT NO.	22"X 13"	29"X 18"	36"X 22"	43"X 27"	58"X 36"	65"X 40"	ANCHORAGES FOR STEEL PLATE BEAM GUARD	STEEL PLATE BEAM GUARD, CLASS "A"	MARKER POSTS	LANDMARK REFERENCE MONUMENTS	CALCIUM CHLORIDE SURFACE TREATMENT	SALVAGED TOPSOIL	EROSION MAT	FERTILIZER	SEEDING	FIELD OFFICE, TYPE "A"	FIELD OFFICE TYPE "A"	ON THE JOB TRAINING
	EACH	EACH	EACH	EACH	EACH	EACH	EACH	LIN. FT.	EACH	EACH	TON	SQ. YD.	SQ. YD.	C W T	LB.	L.S.	L.S.	HRS.
1																		1,000
2																		
3	4	10	6	2	4	2	10	993	40	3	44	132,360	3,000	60	1,790		1	
<b>TOT</b>	<b>4</b>	<b>10</b>	<b>6</b>	<b>2</b>	<b>4</b>	<b>2</b>	<b>10</b>	<b>993</b>	<b>40</b>	<b>3</b>	<b>44</b>	<b>132,360</b>	<b>3,000</b>	<b>60</b>	<b>1,790</b>	<b>1</b>	<b>1</b>	<b>1,000</b>

DETAIL SUMMARY SHEET OF MISCELLANEOUS QUANTITIES

PROJECT I.D. 6460-2-(71.72.73)	SHEET NUMBER 3A	TOTAL SHEETS 91
FEDERAL PROJECT DESIGNATION S 1260 (3)		

CLEARING & GRUBBING

CONTRACT	STATION TO STATION	CLEARING		GRUBBING	
		STATION	IN. DIA.	STATION	IN. DIA.
3	STA. 10 + 00 - STA. 161 + 00	-	1.034	-	1.048
3	STA. 161 + 00 - STA. 163 + 00	2	-	2	-
3	STA. 163 + 00 - STA. 209 + 00	-	243	-	243
3	STA. 209 + 00 - STA. 211 + 00	2	-	2	-
3	STA. 211 + 00 - STA. 235 + 00	-	290	-	290
3	STA. 416 + 00 - STA. 420 + 00	4	-	4	-
3	STA. 420 + 00 - STA. 458 + 42	-	535	-	535

EXCAVATION

CONTRACT NO.	LOCATION	UNCLASSIFIED CU. YD.	BORROW CU. YD.
3	STA. 10 + 00 - STA. 235 + 00	42.381	27.621
3	STA. 414 + 00 - STA. 448 + 02	6.270	-
3	STA. 448 + 02 - STA. 458 + 42.37	3.209	940

CRUSHED AGGREGATE BASE COURSE

CONTRACT NO.	STATION TO STATION	TON		
		MAINLINE	SIDE ROADS	P. E. 'S
2	STA. 10 + 00 - STA. 235 + 00	70.000	1.420	575
2	STA. 446 + 00 - STA. 447 + 87	420	-	625
2	STA. 448 + 83 - STA. 458 + 42.37	3.110	-	150

PIPE CULVERTS

CONTRACT NO.	STATION	LOCATION	DIAMETER IN. DIA.	LENGTH LIN. FT.	TYPE	APRON ENDWALLS	MARKER POSTS
3	STA. 26 + 90	¢	36"X 22"	62'	C.M.P.A.	2	2
3	STA. 27 + 26	¢	36"X 22"	62'	C.M.P.A.	2	2
3	STA. 40 + 00	¢	29"X 18"	76'	C.M.P.A.	2	2
3	STA. 40 + 36	SIDE ROAD LEFT	36"X 22"	54'	C.M.P.A.	2	-
3	STA. 53 + 80	F. E. LEFT	18"	32'	CULVERT PIPE CLASS III	2	-
3	STA. 55 + 75	¢	65"X 40"	74'	C.M.P.A.	2	2
3	STA. 56 + 70	P. E. RIGHT	18"	30'	CULVERT PIPE CLASS III	2	-
3	STA. 67 + 15	SIDE ROAD LEFT	22"X 13"	58'	C.M.P.A.	2	-
3	STA. 67 + 15	SIDE ROAD RIGHT	18"	58'	CULVERT PIPE CLASS III	2	-
3	STA. 83 + 02	¢	24"	68'	CULVERT PIPE CLASS III	2	2
3	STA. 92 + 45	P. E. RIGHT	18"	30'	CULVERT PIPE CLASS III	2	-
3	STA. 95 + 25	F. E. RIGHT	18"	36'	CULVERT PIPE CLASS III	2	-
3	STA. 97 + 05	P. E. LEFT	18"	34'	CULVERT PIPE CLASS III	2	-
3	STA. 120 + 50	¢	29"X 18"	66'	C.M.P.A.	2	2
3	STA. 120 + 50	¢	29"X 18"	66'	C.M.P.A.	2	-
3	STA. 120 + 80	P. E. RIGHT	43"X 27"	32'	C.M.P.A.	2	-
3	STA. 122 + 95	P. E. RIGHT	36"	32'	CULVERT PIPE CLASS III	2	-
3	STA. 127 + 06	SIDE ROAD LEFT	24"	54'	CULVERT PIPE CLASS III	2	-
3	STA. 137 + 45	¢	58"X 36"	74'	C.M.P.A.	2	2
3	STA. 137 + 45	¢	58"X 36"	74'	C.M.P.A.	2	-
3	STA. 140 + 30	P. E. LEFT	18"	30'	CULVERT PIPE CLASS III	2	-
3	STA. 147 + 04	SIDE ROAD RIGHT	18"	46'	CULVERT PIPE CLASS III	2	-
3	STA. 147 + 33	¢	29"X 18"	72'	C.M.P.A.	2	2
3	STA. 160 + 77	¢	24"	68'	CULVERT PIPE CLASS III	2	2
3	STA. 166 + 50	¢	30"	108'	CULVERT PIPE CLASS III	2	2
1	STA. 168 + 53	¢	12"	38'	C.M.P. UNDERDRAIN UNPERFORATED	-	-
1	STA. 168 + 46	19.5' LEFT	12"	34'	C.M.P. UNDERDRAIN UNPERFORATED	1	1
3	STA. 170 + 00	P. E. LEFT	24"	34'	CULVERT PIPE CLASS III	2	-
3	STA. 173 + 85	P. E. RIGHT	24"	32'	CULVERT PIPE CLASS III	2	-
3	STA. 205 + 27	¢	29"X 18"	64'	C.M.P.A.	2	2
3	STA. 222 + 81	¢	24"	64'	CULVERT PIPE CLASS III	2	2
3	STA. 226 + 96	SIDE ROAD LEFT	22"X 13"	38'	C.M.P.A.	2	-
3	STA. 417 + 89	SIDE ROAD RIGHT	18"	36'	CULVERT PIPE CLASS III	2	-
3	STA. 422 + 20	P. E. LEFT	24"	36'	CULVERT PIPE CLASS III	2	-
3	STA. 422 + 60	F. E. RIGHT	18"	30'	CULVERT PIPE CLASS III	2	-
3	STA. 424 + 71	SIDE ROAD LEFT	24"	36'	CULVERT PIPE CLASS III	2	-
3	STA. 425 + 67	P. E. LEFT	24"	36'	CULVERT PIPE CLASS III	2	-
3	STA. 426 + 85	P. E. LEFT	24"	36'	CULVERT PIPE CLASS III	2	-
3	STA. 427 + 65	P. E. RIGHT	24"	32'	CULVERT PIPE CLASS III	2	-
3	STA. 429 + 18	P. E. RIGHT	24"	30'	CULVERT PIPE CLASS III	2	-
3	STA. 430 + 15	P. E. LEFT	24"	30'	CULVERT PIPE CLASS III	2	-
3	STA. 446 + 90	F. E. LEFT	18"	44'	CULVERT PIPE CLASS III	2	-
1	STA. 447 + 73	¢	12"	35'	C.M.P. UNDERDRAIN UNPERFORATED	-	-
1	STA. 447 + 73	19.5' LEFT	12"	41'	C.M.P. UNDERDRAIN UNPERFORATED	1	1
3		( 36 P.E.'S @ 18"X 28' EACH )			CULVERT PIPE CLASS III	72	-

STEEL PLATE BEAM GUARD




CONTRACT NO.	LOCATION	LIN. FT.	ANCHORAGES
3	B-70-63 WEST END LEFT	128.8	1
3	B-70-63 WEST END RIGHT	128.8	1
3	B-70-63 EAST END LEFT	91.3	1
3	B-70-63 EAST END RIGHT	128.8	1
3	STA. 101 + 53.8 - STA. 102 + 82.6 LEFT	128.8	2
3	STA. 101 + 41.2 - STA. 102 + 70.2 RIGHT	128.8	2
3	B-70-64 EAST END LEFT	128.8	1
3	B-70-64 EAST END RIGHT	128.8	1

RIPRAP

CONTRACT NO.	LOCATION	CU. YD.
1	STA. 168 + 46 LEFT	1
1	STA. 447 + 73 LEFT	1

BENCH MARKS			
NO.	STATION	DESCRIPTION	ELEV.
26	146+90	SPIKE IN POWER POLE 178' RT.	757.82
27	159+04	SPIKE IN 22" MAPLE 50' LT.	759.23
28	167+60	SPIKE IN 24" OAK STUB 225' RT.	757.35

PROJECT I.D. 6460-2-71,72,73	SHEET NUMBER 10	TOTAL SHEETS 91
FEDERAL PROJECT DESIGNATION S 1260 (3)		

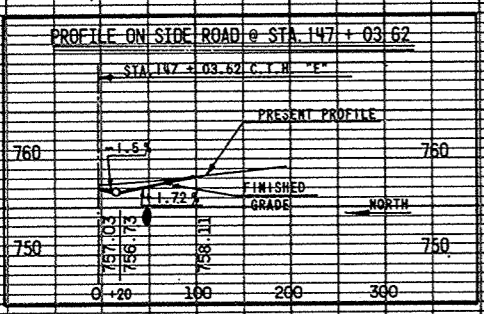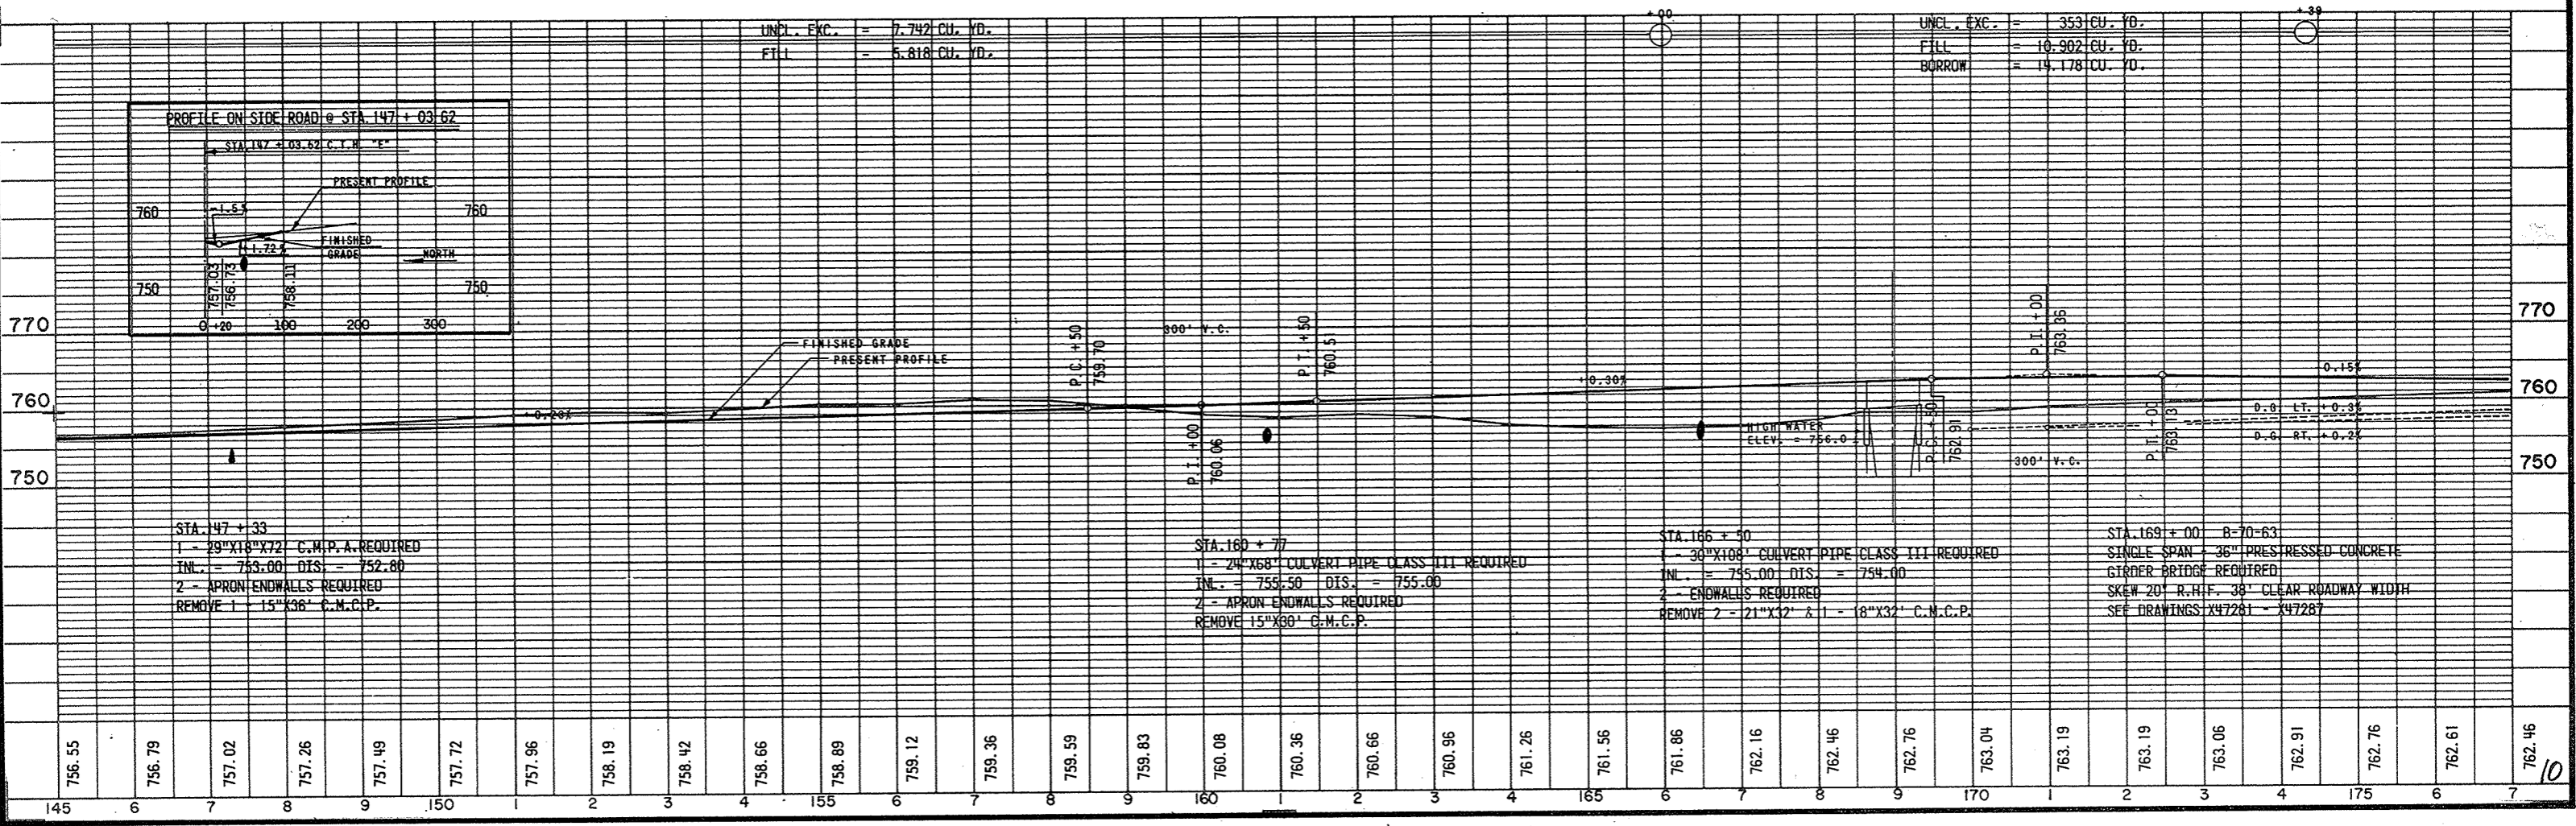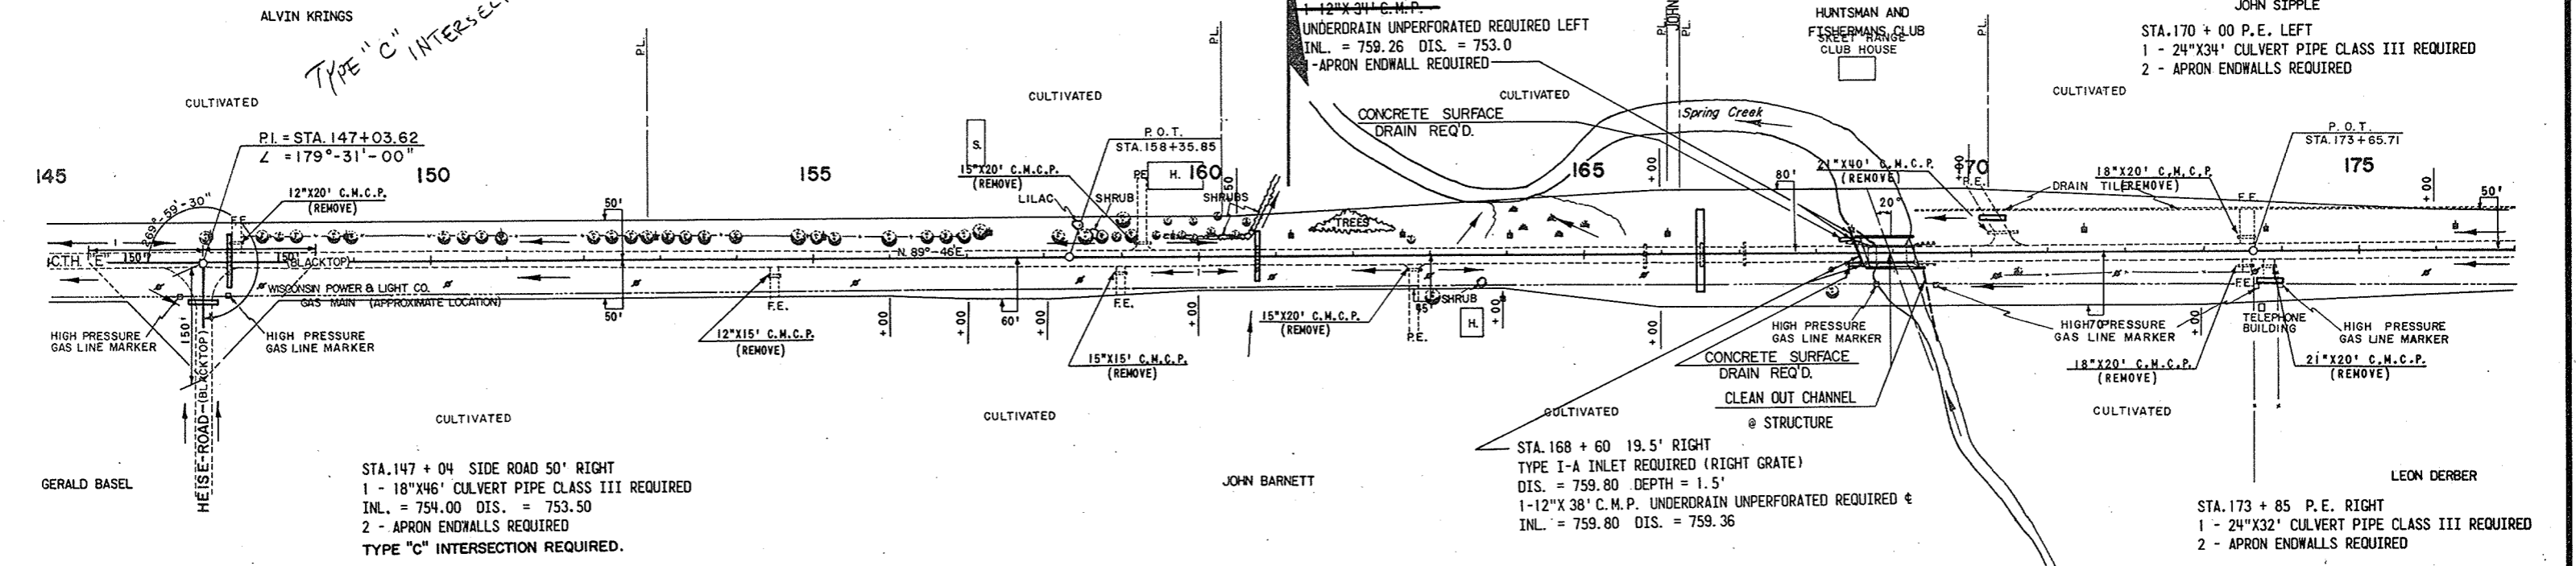

STA. 147 + 33  
1 - 29"X18"X72' C.M.C.P. A. REQUIRED  
INL. = 753.00 DIS. = 752.80  
2 - APRON ENDWALLS REQUIRED  
REMOVE 1 - 15"X36' C.M.C.P.

STA. 160 + 77  
1 - 24"X68' CULVERT PIPE CLASS III REQUIRED  
INL. = 755.50 DIS. = 755.00  
2 - APRON ENDWALLS REQUIRED  
REMOVE 15"X30' C.M.C.P.

STA. 166 + 50  
1 - 36"X108' CULVERT PIPE CLASS III REQUIRED  
INL. = 755.00 DIS. = 754.00  
2 - APRON ENDWALLS REQUIRED  
REMOVE 2 - 21"X12' & 1 - 18"X32' C.M.C.P.


STA. 169 + 00 B=70-63  
SINGLE SPAN - 36" PRESTRESSED CONCRETE GIRDER BRIDGE REQUIRED  
SKEN 20' R.H.F. 38' CLEAR ROADWAY WIDTH  
SEE DRAWINGS X47281 - X47287



PROJECT I.D. 6460-2-71,72,73	SHEET NUMBER 14	TOTAL SHEETS 91
FEDERAL PROJECT DESIGNATION S 1260(3)		


BENCH MARKS			
NO.	STATION	DESCRIPTION	ELEV.
59	448+40	PT. MK. TOP N.E. WINGWALL	20' LT. 767.20
60	454+22	SPIKE IN 14" OAK	45' RT. 779.17
61	457+58	S.E. CORNER OF ENTRY SLAB OF HOUSE (FRONT DOOR)	82' LT. 779.58
171	499+18	SPIKE IN POWER POLE	115' RT. R/W RL. 763.43


STA. 447 + 73 18.5' LEFT  
 TYPE I-A INLET REQUIRED (LEFT GRATE)  
 INL. = 768.56 DIS. = 768.56 DEPTH = 2.0'  
 1-12" X 41" C.M.P. UNDERDRAIN UNPERFORATED REQ'D LT.  
 INL. = 768.56 DIS. = 760.50  
 1-APRON ENDWALL REQUIRED

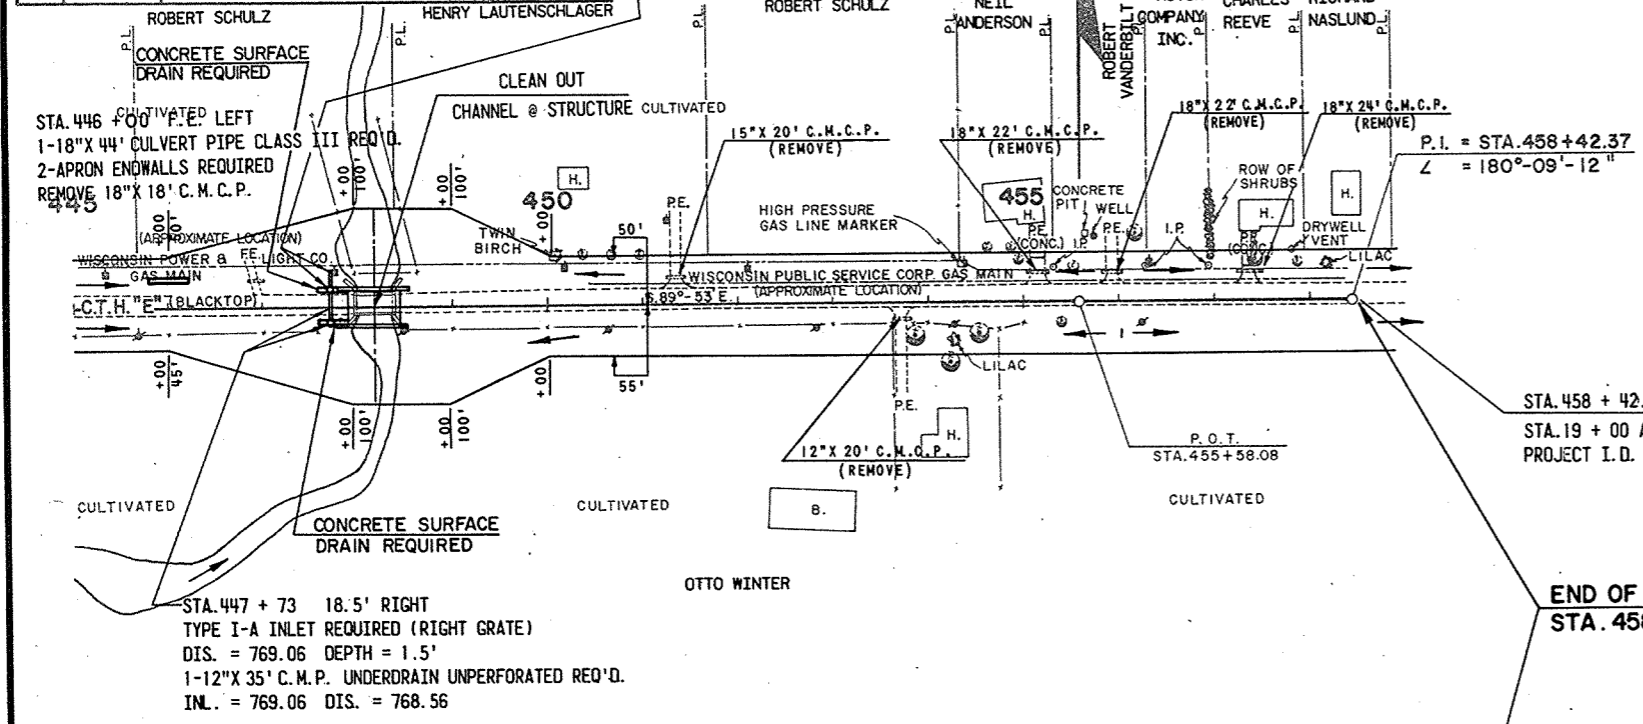


STA. 458 + 42.37 BACK =  
 STA. 19 + 00 AHEAD  
 PROJECT I.D. 1121-5-71

END OF PROJECT S1260(3) / 6460-2-71,72,73  
 STA. 458 + 42.37


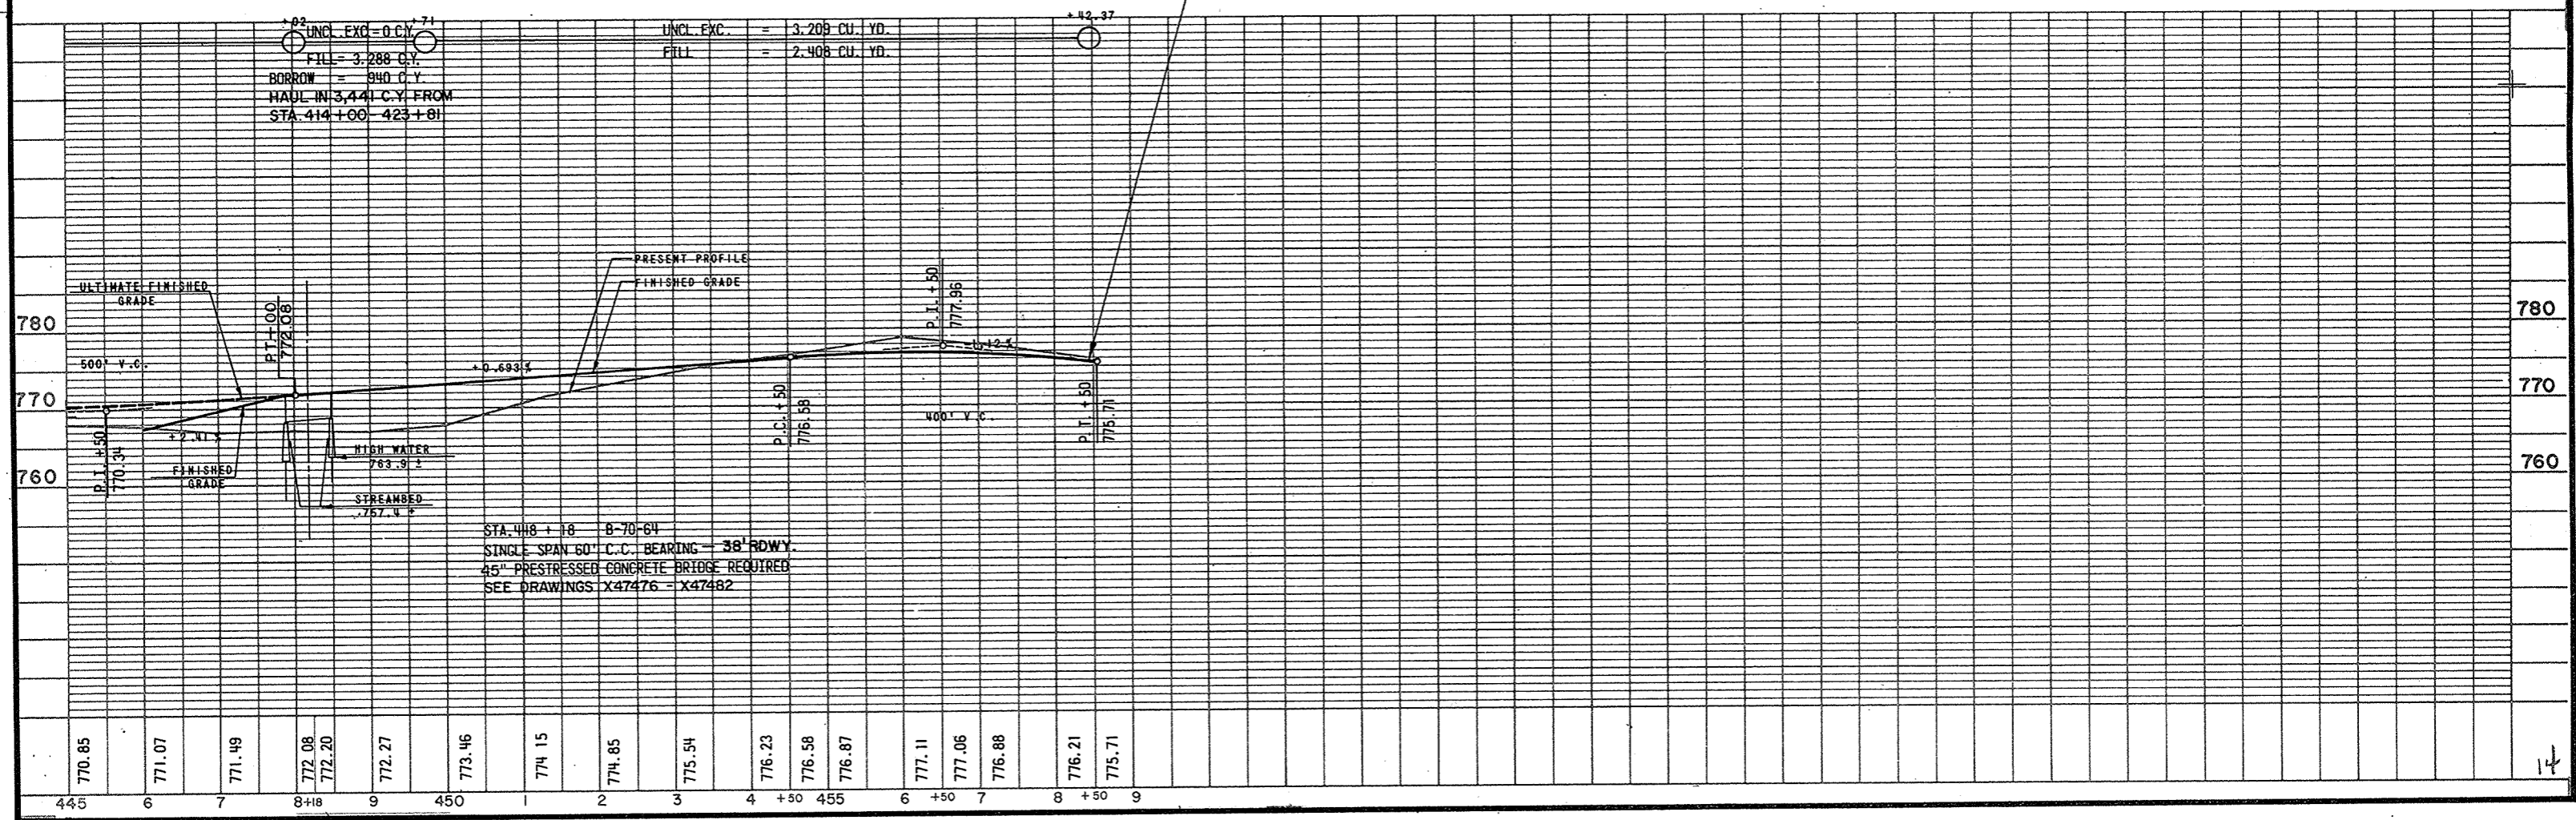


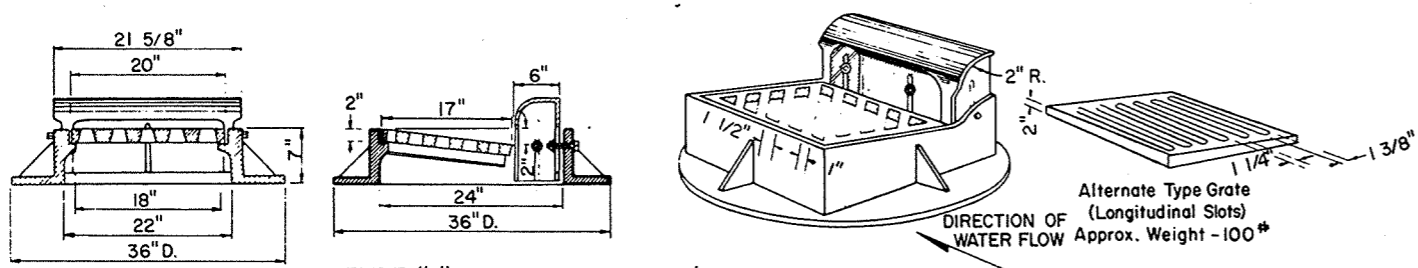


**TYPE "A"** - (Approx. Weight 390 Lbs.)  
 Frame Weight - 250 #  
 Grate " - 90 #  
 Box " - 50 #

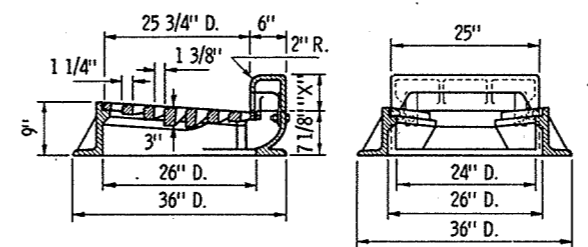


**TYPE "G"** (Approx. Weight 425 - 465 Lbs.)  
 Frame Weight - 235 #  
 Grate " - 130 #  
 Box - See Table

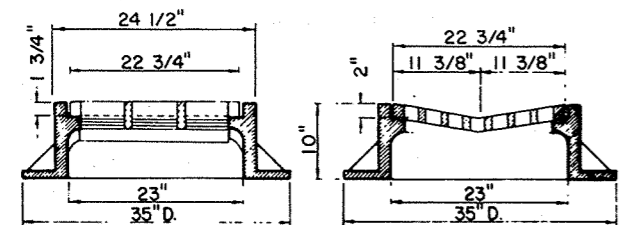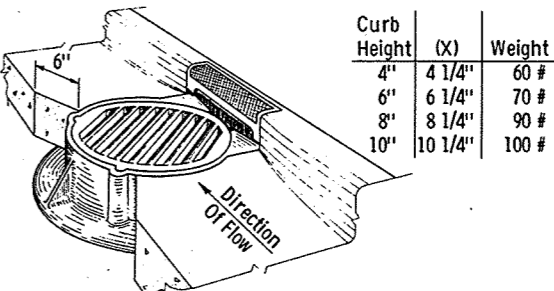

**TYPE "B"** - (Approx. Weight 414 Lbs.)  
 Frame Weight - 275 #  
 Grate " - 139 #

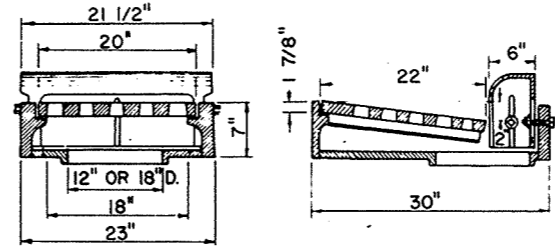


**TYPE "R"** - (Approx. Weight 450 Lbs.)

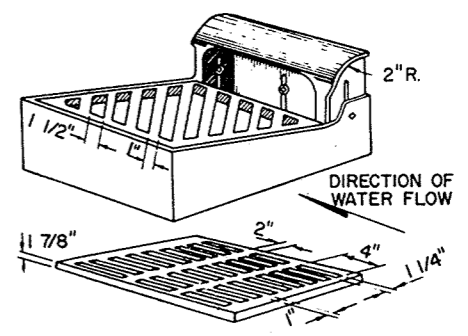


**SPECIAL NOTE**  
 Diagonal Slots shall be oriented to the direction of flow as shown hereon. Hence RIGHT and LEFT Grates shall be furnished depending on direction of flow. (See Sketch Below)  
 Longitudinal slot type grates may be used ONLY where bicycles are prohibited.

Direction of Flow  
 RIGHT GRATE  
 LEFT GRATE

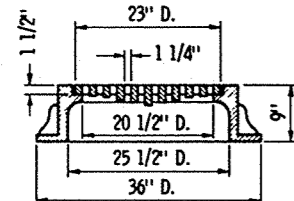


**TYPE "C"** - (Approx. Weight 370 Lbs.)  
 Frame Weight Type "C" & Type "D" - 255 #  
 Slotted Grate Weight - 115 #  
 Solid Cover Weight - 150 #  
 (Note: Frame for Type "C" same as for Type "D")

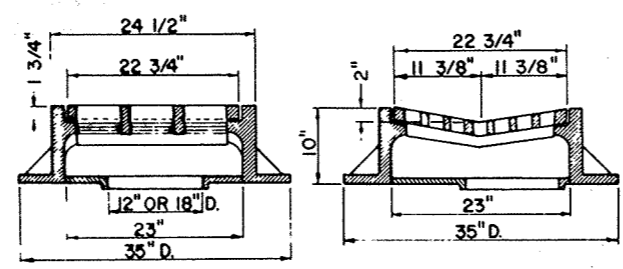


**TYPE "S"** - (Approx. Weight 450 Lbs.)

**INLET COVERS**

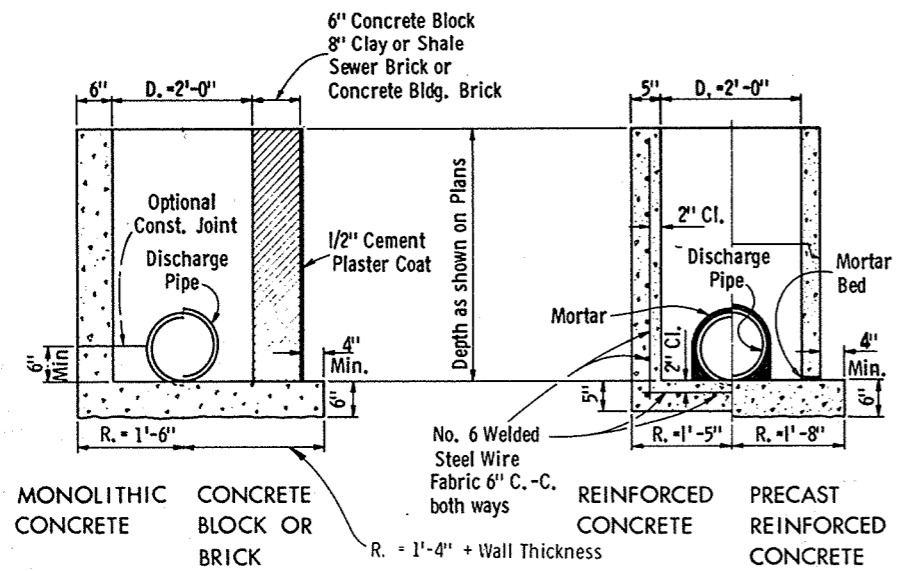

**INLET TYPE 1**

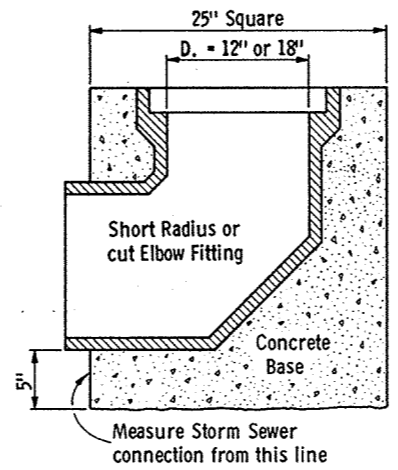

**INLET TYPE 2**

- GENERAL NOTES**
1. Details of construction, materials and workmanship not shown on this drawing shall conform to the pertinent requirements of the Standard Specifications and the applicable Special Provisions.
  2. Detailed drawings for proposed alternate designs for Inlets shall be submitted to the Engineer for approval providing that such alternate designs make provision for equivalent capacity and strength.
  3. All Inlets are designated on the Plans as "Inlets, 1-A", 2-R, etc. This designation is interpreted to mean that the number, or first digit, designates the masonry portion of the structure, and the following letter, designates the type of cover or iron casting to be used therewith to comprise the complete unit "Inlet" in place.
  4. All bar steel reinforcement shall be embedded 2 inches clear unless otherwise shown or noted.
  5. Precast Reinforced Bases may be used in lieu of cast-in-place bases. When Precast Bases are used, they shall be placed on a bed of material at least 6 inches in depth, which meets the requirements for Granular Backfill. This bedding material shall be compacted and provide uniform support for the entire area of the base.
  6. All Precast Reinforced Concrete Risers, Grade Rings, and Flat Slab Tops shall conform to AASHO Designation M 199. Precast Reinforced Concrete Bases shall conform to the Flat Slab Top requirements of AASHO Designation M 199.
  7. Adjustment of the cover to grade may be accomplished by the use of mortar and brick. Maximum adjustment shall be 8 inches.
  8. Precast Reinforced Concrete Risers may be placed with tongue or "D" joint ends either up or down.
  9. Strike all joints for brick or block construction.


**INLETS TYPE 1 & 2 AND INLET COVERS**

State of Wisconsin  
 Department of Transportation  
 Division of Highways


RECOMMENDED FOR APPROVAL:  
 DATE 5/7/69  
 E. J. Byrkit  
 CHIEF DESIGN ENGINEER

APPROVED:  
 DATE 5/12/69  
 H. J. Samic  
 STATE HIGHWAY ENGINEER

S. D. D. 8C1-1

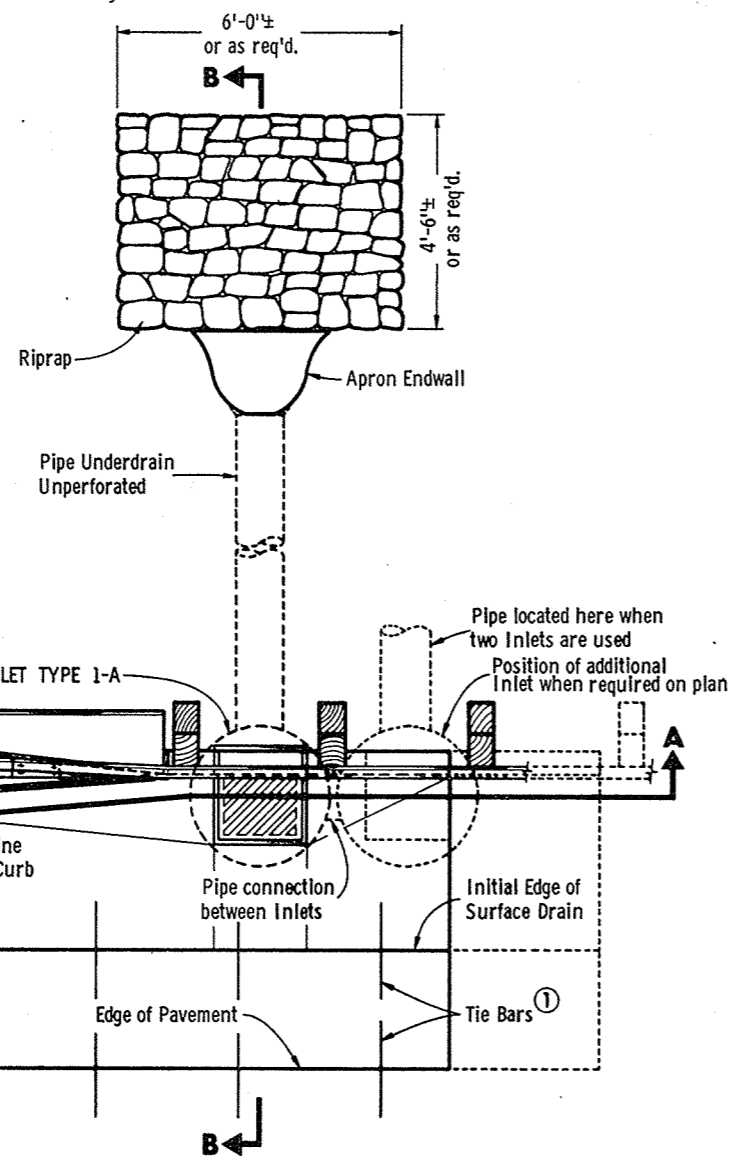

PLAN VIEW

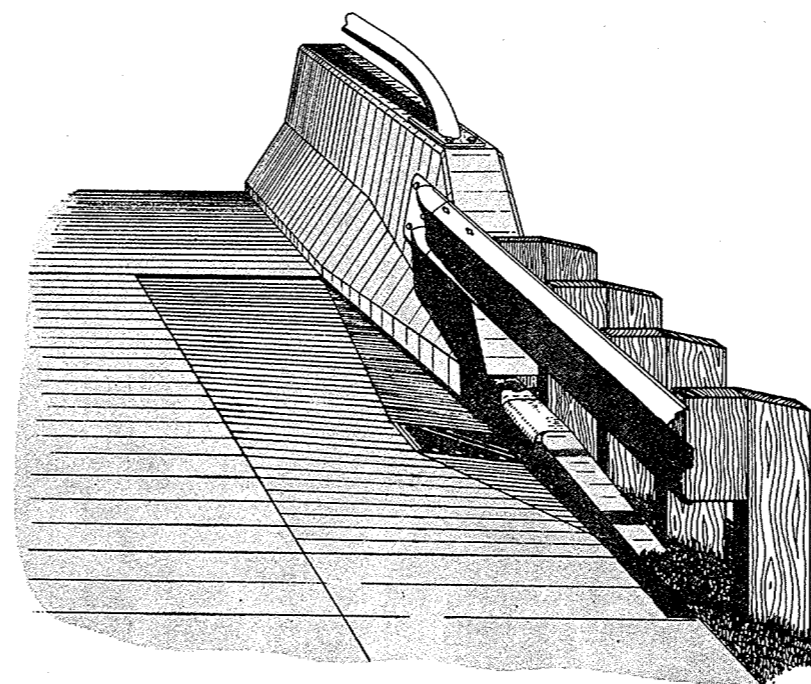

TYPICAL INSTALLATION

- ① Tie Bars  
# 4 x 2'-0" tie bars spaced at 3'-0" centers to be used only when adjacent to P. C. concrete
- ② Based on drainage requirements

**GENERAL NOTES**

Details of construction, materials and workmanship not shown on this drawing shall conform to the pertinent requirements of the Standard Specifications and the applicable Special Provisions.

Detailed drawings for proposed alternate designs for Surface Drains shall be submitted to the Engineer for approval providing that such alternate designs make provision for equivalent capacity and strength.

See Standard Detail Drawing "INLETS TYPE 1" for construction details of Inlet.


See Standard Detail Drawing "Class "A" STEEL PLATE BEAM GUARD & STEEL PLATE BEAM MEDIAN GUARD" for construction and layout details not shown on this sheet.

**REINFORCEMENT**


Welded Steel Wire Fabric shall conform to the Standard Specifications for Welded Steel Wire Fabric for concrete pavement.

**BASIS OF PAYMENT**

The curb and initial portion of the Concrete Surface Drain shall be paid for as provided in the Standard Specifications for Concrete Surface Drains. The Unperforated Pipe Underdrain, Metal Apron Endwall, Inlet, Inlet Cover and Riprap shall be paid for under the pertinent Contract items.

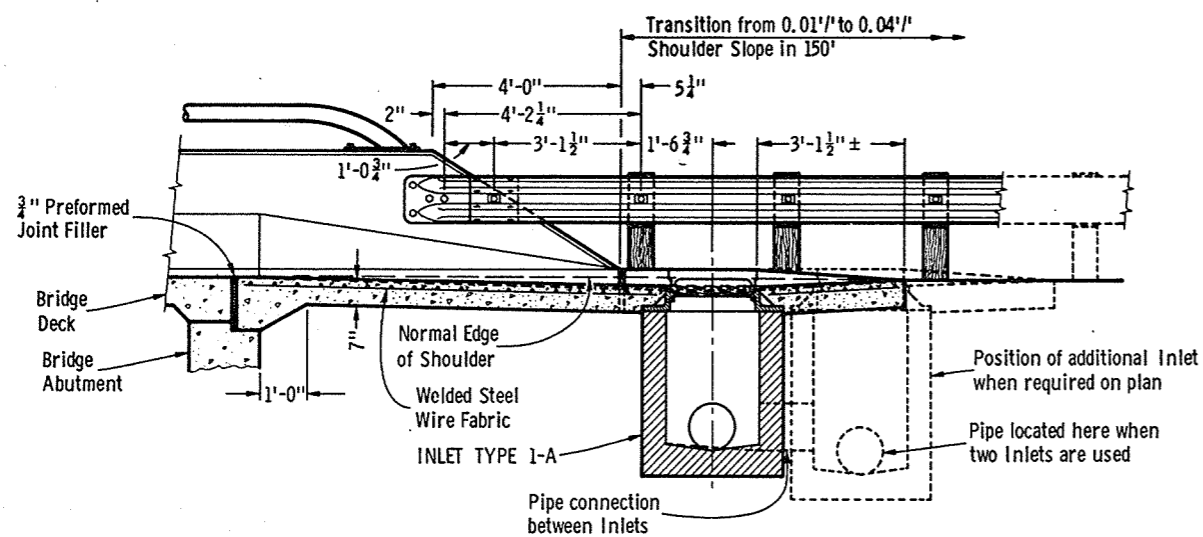

SECTION A-A

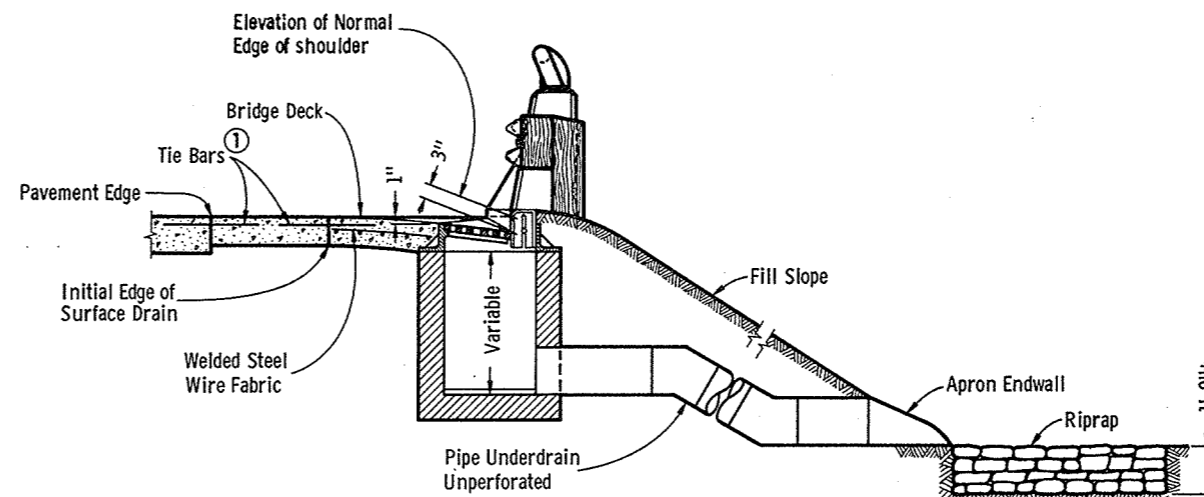













SECTION B-B

<b>SURFACE DRAIN DROP INLET TYPE</b>	
State of Wisconsin Department of Transportation Division of Highways	
RECOMMENDED FOR APPROVAL: DATE 5/13/71	<i>L. C. Hennel</i> ACTING CHIEF DESIGN ENGINEER
APPROVED: DATE 5/13/71	<i>H. J. Summister</i> STATE HIGHWAY ENGINEER

S. D. D. 8D3-1

S. D. D. 8D3-1



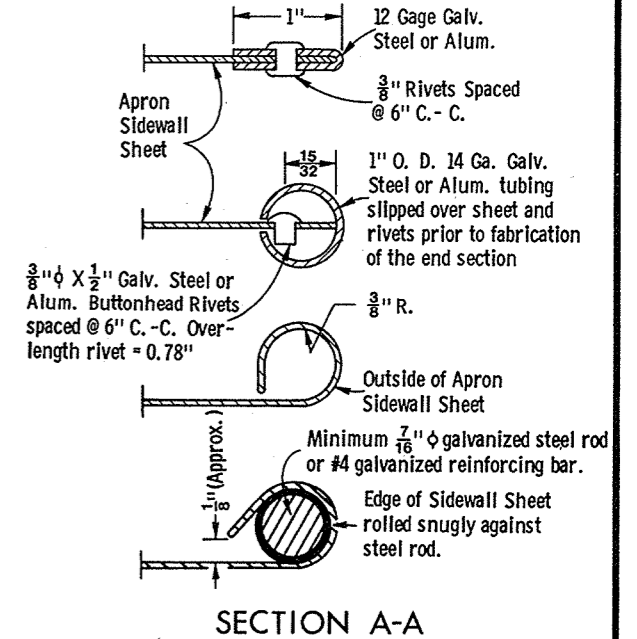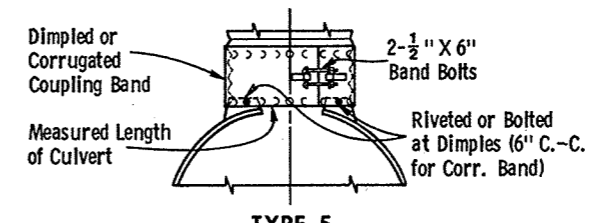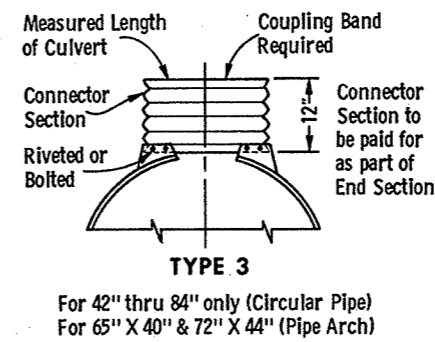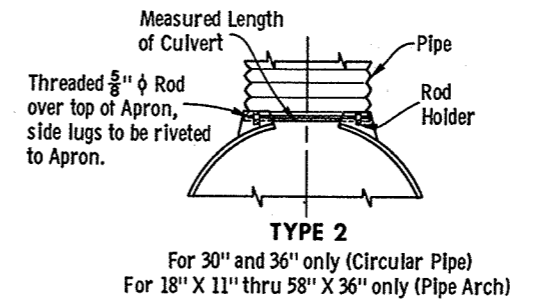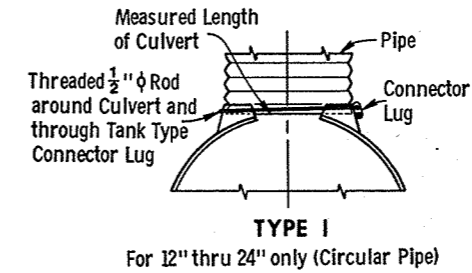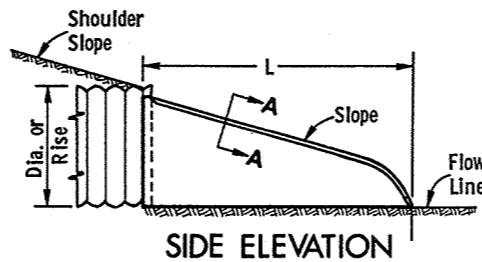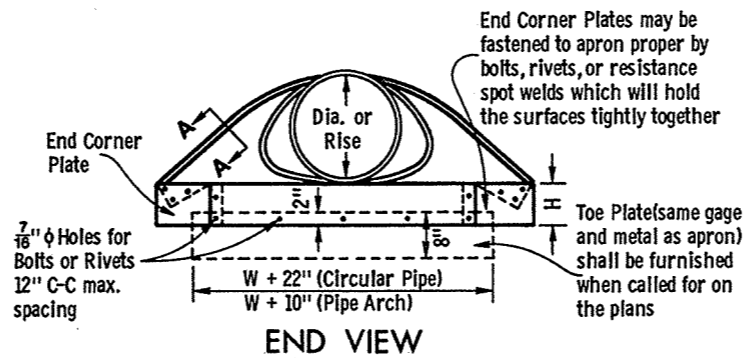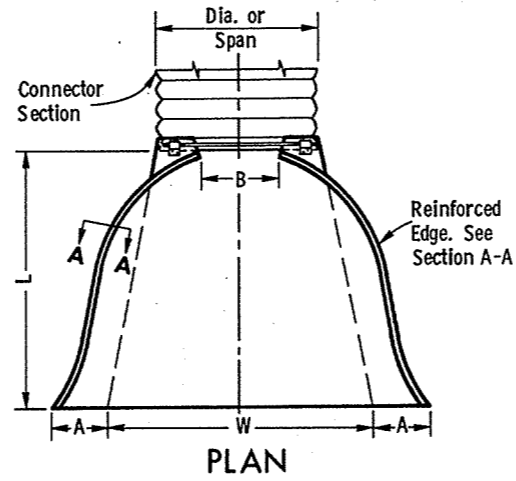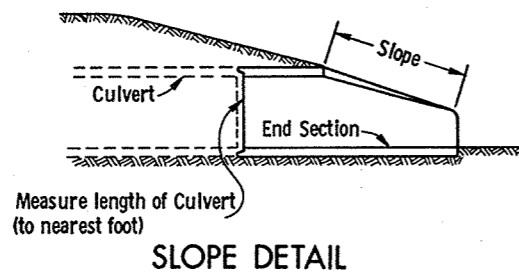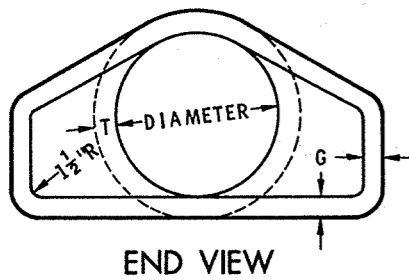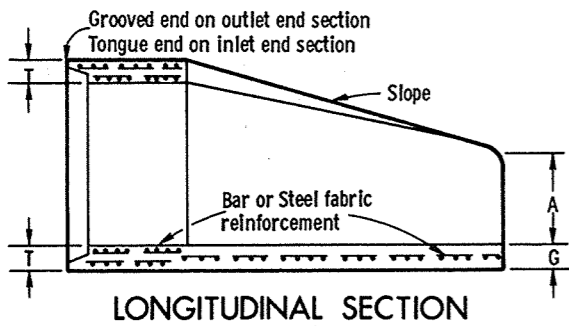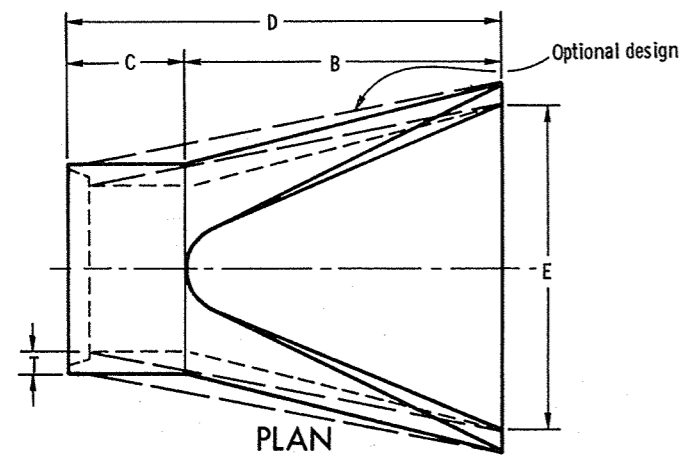

**GENERAL NOTES**

Details of construction, materials, and workmanship not shown on this drawing shall conform to the pertinent requirements of the Standard Specifications and the applicable Special Provisions.

Variations of the dimensions and designs shown hereon will be permitted providing equivalent capacity and structural integrity are attained, and prior approval of the Engineer is obtained.

Concrete culvert endwalls may not be used with metal or aluminum culvert pipe, nor may metal or aluminum culvert endwalls be used with concrete culvert pipe.

When two or more pipes or pipe arches with apron endwalls are to be laid adjacent to each other, they shall be separated by the following amount:

- Pipes: Total width of apron endwall less the diameter of pipe plus 6 inches.
- Pipe Arches: Total width of apron endwall less the span dimension of the pipe arch plus 6 inches.

DIA.	APPROX. WEIGHT/SECTION	APPROX. SLOPE	T	A	B	C	D	E	G
12"	530	3 to 1	2"	4"	24"	48 7/8"	72 7/8"	24"	2"
15"	740	3 to 1	2 1/4"	6"	27"	46"	73"	30"	2 1/4"
18"	990	3 to 1	2 1/2"	9"	27"	46"	73"	36"	2 1/2"
21"	1,280	3 to 1	2 3/4"	9"	36"	37 1/2"	73 1/2"	42"	2 3/4"
24"	1,520	3 to 1	3"	9 1/2"	43 1/2"	30"	73 1/2"	48"	3"
27"	1,930	3 to 1	3 1/4"	10 1/2"	49 1/2"	24"	73 1/2"	54"	3 1/4"
30"	2,190	3 to 1	3 1/2"	12"	54"	19 3/4"	73 3/4"	60"	3 1/2"
36"	4,100	3 to 1	4"	15"	63"	34 3/4"	97 3/4"	72"	4"
42"	5,380	3 to 1	4 1/2"	21"	63"	35"	98"	78"	4 1/2"
48"	6,550	3 to 1	5"	24"	72"	26"	98"	84"	5"
54"	8,040	2 3/8 to 1	5 1/2"	27"	65"	33 1/2" - 35"	98 1/2" - 100"	90"	5"
60"	8,730	2 to 1	6"	30"	60"	39"	99"	96"	5"
66"	10,630	2 to 1	6 1/2"	30"	72"	42"	99"	102"	5 1/2"
72"	12,520	2 to 1	7"	36"	78"	21"	99"	108"	6"
78"	14,430	2 to 1	7 1/2"	36"	78"	21"	99"	114"	6 1/2"
84"	18,160	1 1/2 to 1	8"	36"	90 1/2"	21"	111 1/2"	120"	6 1/2"

\*\* Minimum  
\* Maximum

**REINFORCED CONCRETE APRON ENDWALLS**

D PIPE DIAM.	MIN. METAL GAGE	MIN. ALUM. GAGE	DIMENSIONS					APPROX. SLOPE
			A ± 1"	B MAX.	H ± 1"	L ± 1/2"	W ± 2"	
12"	16	16	6"	6"	6"	21"	24"	2 1/2 to 1
15"	16	16	7"	8"	6"	26"	30"	"
18"	16	16	8"	10"	6"	31"	36"	"
21"	16	16	9"	12"	6"	36"	42"	"
24"	16	14	10"	13"	6"	41"	48"	"
30"	14	14	12"	16"	8"	51"	60"	"
36"	14	12	14"	19"	9"	60"	72"	"
42"	12	12	16"	22"	11"	69"	84"	"
48"	12	12	18"	27"	12"	78"	90"	2 1/4 to 1
54"	12	12	18"	30"	12"	84"	102"	2 to 1
60"	10	8	18"	33"	12"	87"	114"	1 3/4 to 1
66"	10	8	18"	36"	12"	87"	120"	1 1/2 to 1
72"	10	8	18"	39"	12"	87"	126"	1 1/3 to 1
78"	8	NA	18"	42"	12"	87"	132"	1 1/4 to 1
84"	8	NA	18"	45"	12"	87"	138"	1 1/8 to 1

NOTE: All splices to be lap riveted or bolted

**METAL OR ALUMINUM APRON  
ENDWALLS FOR CIRCULAR PIPES**

PIPE - ARCH DIMENSIONS SPAN RISE	GAGE MIN.	DIMENSIONS					APPROX. SLOPE	
		A ± 1"	B MAX.	H ± 1"	L ± 1/2"	W ± 2"		
18"	11"	16	7"	9"	6"	19"	30"	2 1/2 to 1
22"	13"	16	7"	10"	6"	23"	36"	"
25"	16"	16	8"	12"	6"	28"	42"	"
29"	18"	16	9"	14"	6"	32"	48"	"
36"	22"	14	10"	16"	6"	39"	60"	"
43"	27"	14	12"	18"	8"	46"	75"	"
50"	31"	12	13"	21"	9"	53"	85"	"
58"	36"	12	18"	26"	12"	63"	90"	"
65"	40"	12	18"	30"	12"	70"	102"	2 1/4 to 1
72"	44"	12	18"	33"	12"	77"	114"	"

NOTE: All splices to be lap riveted or bolted

**METAL APRON ENDWALLS  
FOR PIPE ARCHES**

**CONNECTION DETAILS**

**CIRCULAR PIPE**

For Circumferentially Corrugated Pipe use Endwall Connection Details 1, 2, 3, or 5 as applicable.

For Helically Corrugated Pipe use Endwall Connection Details 1, 2 or 5.

For Helically Corrugated Pipes with two Circumferential Corrugations at each end use Endwall Connection Details 1, 2, or 3


**PIPE ARCH**

Use Endwall Connection Details 2, 3, or 5 as applicable.


**APRON ENDWALLS FOR  
CULVERT PIPE AND  
PIPE ARCH**

State of Wisconsin  
Department of Transportation  
Division of Highways

RECOMMENDED FOR APPROVAL:  
4-11-72  
DATE  
S. C. Hennrich  
CHIEF DESIGN ENGINEER  
APPROVED  
4-11-72  
DATE  
S. L. Hicks  
STATE HIGHWAY ENGINEER

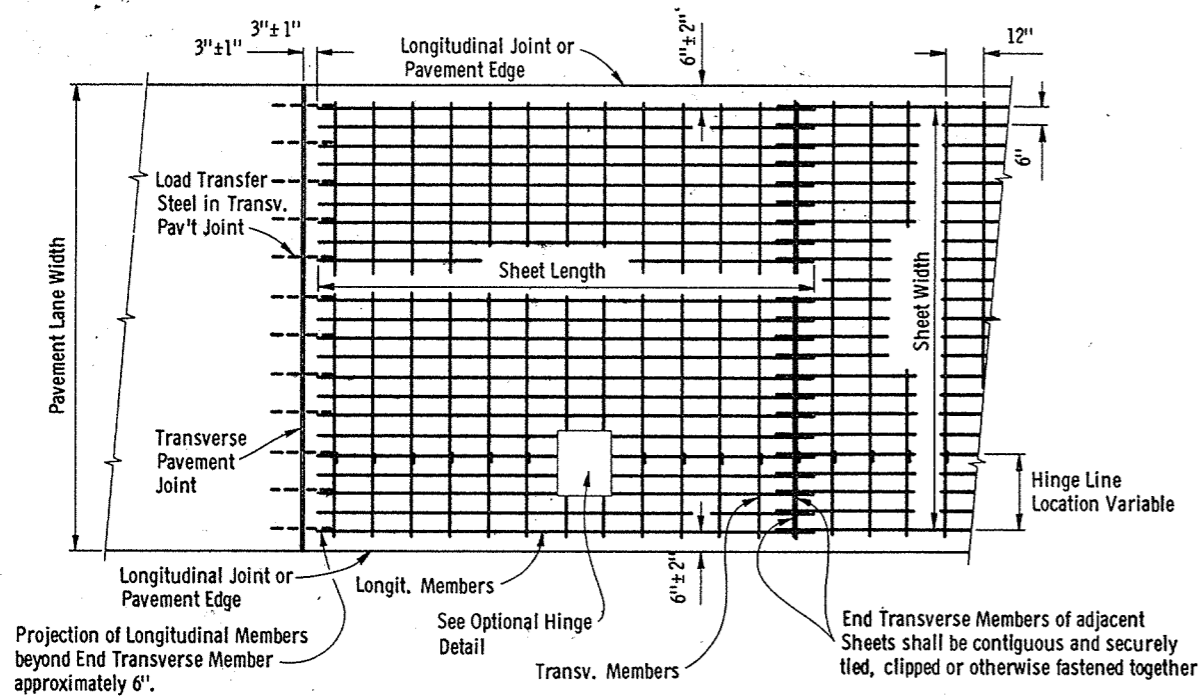


**PLAN VIEW**

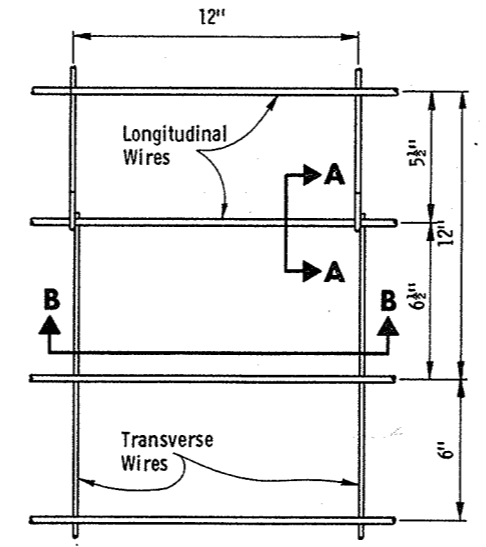


**PLAN VIEW**

**OPTIONAL HINGE DETAIL**

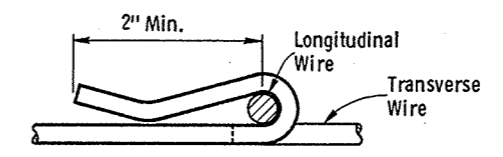

**SECTION A-A**

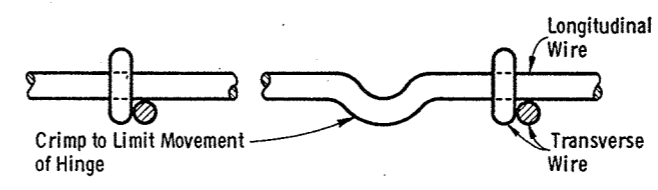

**SECTION B-B**

**GENERAL NOTES**


Details of construction and materials not shown herein shall conform to the pertinent requirements of the Standard Specifications and the applicable Special Provisions. Alternate hinge designs may be used upon approval of the engineer.

**WELDED STEEL WIRE FABRIC**

Welded Steel Wire Fabric shall conform to the requirements of the Standard Specifications for Welded Steel Fabric for Concrete Reinforcement A. A. S. H. O. Designation M55 except as shown hereon.

Welded Steel Wire Fabric Specifications:  
 Approximate Weight per 100 sq. ft. = 69.0 lbs.  
 Longitudinal Steel - Gage No. 0 = 0.3065" D. at 6" C-C.  
 Transverse Steel - Gage No. 4 = 0.2253" D. at 12" C-C.

Side lap of adjacent sheets shall be approximately 6".

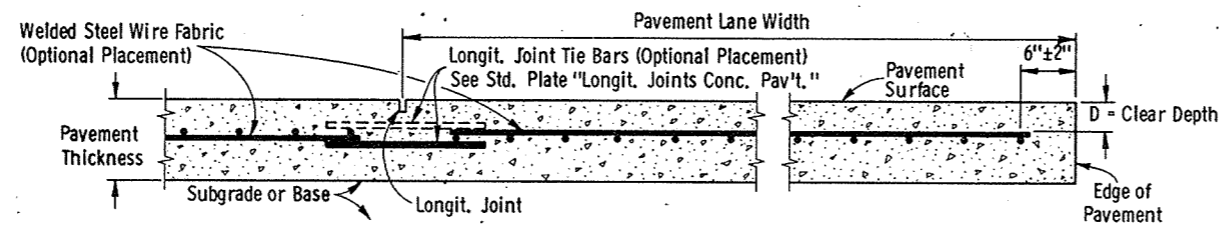

**CROSS SECTION**

**WELDED STEEL WIRE FABRIC**

Pavement Thickness	"D"
8"	2'-4"
9"	2'-4 1/2"
10"	2'-5"

**EXPANDED METAL MESH**


Weight per 100 sq. ft. = 76.0 lbs min. Expanded Metal Mesh shall be manufactured from open hearth steel, having a phosphorus content of not more than 0.05 percent, and a yield point of not less than 55,000 p. s. i. The steel shall be sufficiently ductile to permit any strand to be bent through an angle of 180 degrees over one diam. without fracture. The diamond shaped mesh shall be fabricated by a cold drawn process which will cut and draw the steel forming uniform dimensioned strands conforming to shape and weight as shown elsewhere hereon.

Side lap of adjacent sheets shall be approximately 6".

**SPECIAL REQUIREMENTS**


Welded Steel Wire Fabric or Expanded Metal Mesh Concrete Pavement Reinforcement shall be shipped to the job site in flat sheets.

One longitudinal hinge line will be permitted in each Welded Steel Wire Fabric sheet for convenience in shipping. This hinge shall encircle the longitudinal wire such that no more than one (1) inch of transverse movement of the hinge exists. The longitudinal wire around which the hinge rotates shall be crimped adjacent to the hinge such that no more than one (1) inch of longitudinal movement of the hinge exists.

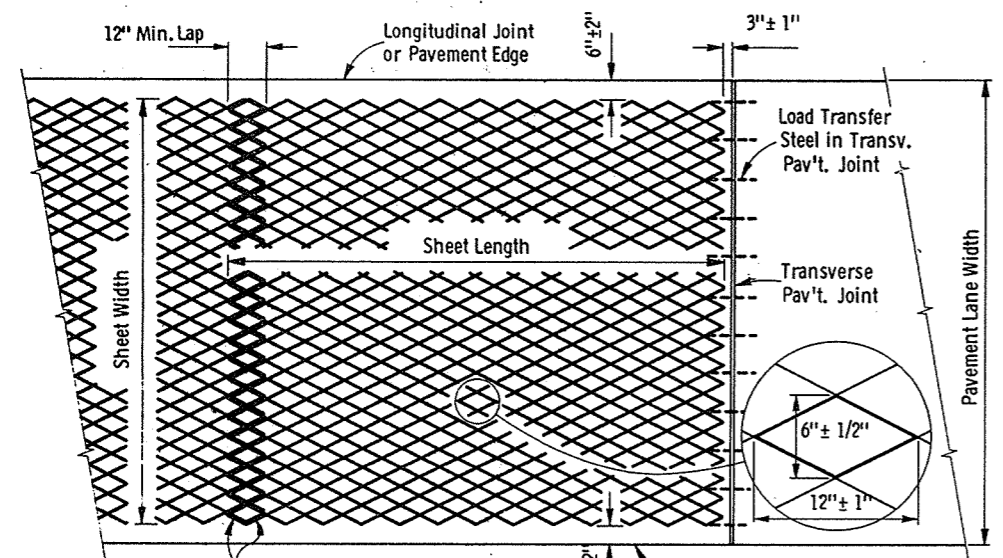

**PLAN VIEW**

**EXPANDED METAL MESH**

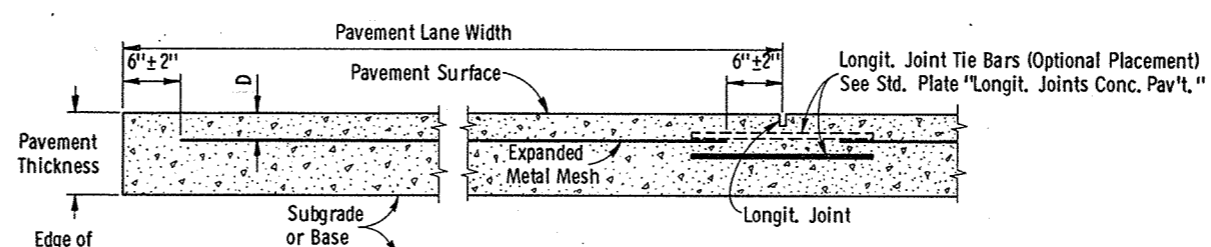


**CROSS SECTION**

**CONCRETE PAVEMENT REINFORCEMENT**

State of Wisconsin  
 Department of Transportation  
 Division of Highways

RECOMMENDED FOR APPROVAL:  
 DATE: 3/13/69  
 APPROVED: 3/27/69  
 DATE: 3/27/69

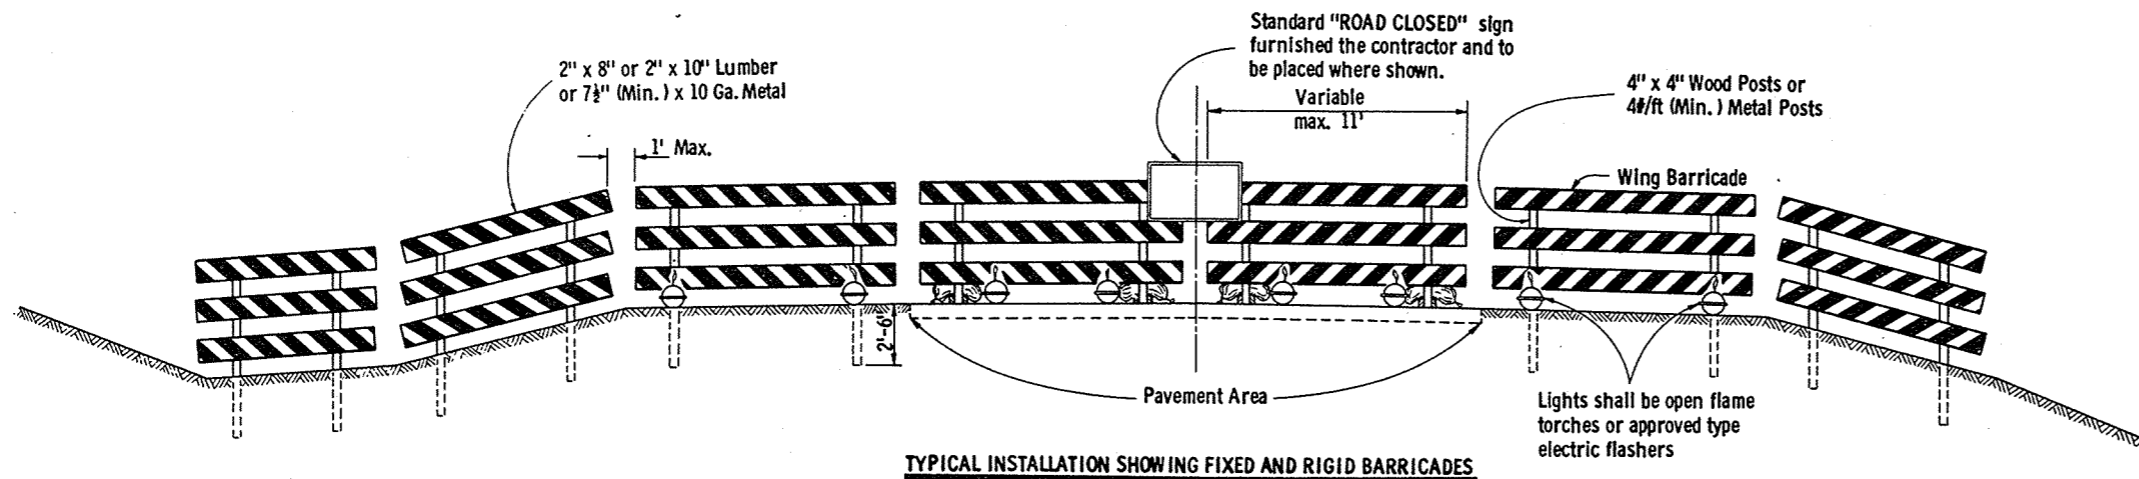

**TYPICAL INSTALLATION SHOWING FIXED AND RIGID BARRICADES**

**GENERAL NOTES**

The contractor shall construct, place and maintain barricades as shown on the drawing and as required by the Standard Specifications or applicable Special Provisions.

**CLASS I BARRICADE:**

Class I Barricades shall be of variable length as indicated, and long barricades shall be assembled from these units. The Class I Barricade is the type normally required for major operations, where the barricade will remain in place for extended periods. Class I Barricades shall be used at points where the road is closed to traffic. Gates or movable sections of a barricade shall be provided when necessary, for access of equipment or other authorized vehicles. Wing Barricades are Class I Barricades erected on the shoulder on one or both sides of the pavement to give Traffic the perceptive effect of a narrowing or restricted roadway. The ends closest to traffic of all three members of a wing barricade shall be in a vertical line. If used in a series, they should start at the outer edge of the shoulder and be brought progressively closer to the pavement. Wing Barricades may be used as a mounting for the advance warning or guide signs or for flashers. When used on two-way roadways, the back of the wing barricade shall be painted reflectorized white.

**CLASS II BARRICADE:**

Class II Barricades may be used only where the hazard to traffic is relatively small, and for the more or less continuous delimiting of a restricted roadway, or for temporary daytime use.

**MATERIAL & FABRICATION:**

Lumber shall be of a grade structurally sound and sufficiently rigid to satisfactorily support and maintain the purpose and intent of a barricade facility. Metal shall be sufficiently rigid to satisfactorily support and maintain the purpose and intent of a barricade facility. The fabrication of the barricade shall be in accord with good pertinent woodworking and metalworking practices. All lumber or timber dimensions stated are nominal.

**PAINTING:**

All barricades shall be painted in alternate 4" or 6" black and white stripes at a 45° angle. The width of stripe shall be consistent for each complete barricade installation. Black stripes shall be painted with weather resistant and durable black paint. White stripes shall be primed, followed by two coats of white reflectorized paint or reflective wide angle sheeting.

**DIRECTION OF DIAGONAL STRIPES:**


Where a barricade extends entirely across the roadway with no vehicle access provision, the stripes shall slope downward toward the highway centerline. Where vehicle access is permitted, the stripes shall slope downward in the direction toward which vehicles must turn in detouring. Where both right and left turns are provided for, the stripes shall slope downward in both directions from the center. The stripes on wing barricades shall point downward toward the roadway.

**LIGHTING:**

Lighting devices for barricades shall conform to the requirements of the Standard Specifications.


**MEASUREMENT & PAYMENT:**

All barricades, unless otherwise provided for in the plans and/or special provisions shall be furnished, placed, and maintained as noted above, and no additional compensation will be allowed but shall be construed to be included in the price bid for other items.

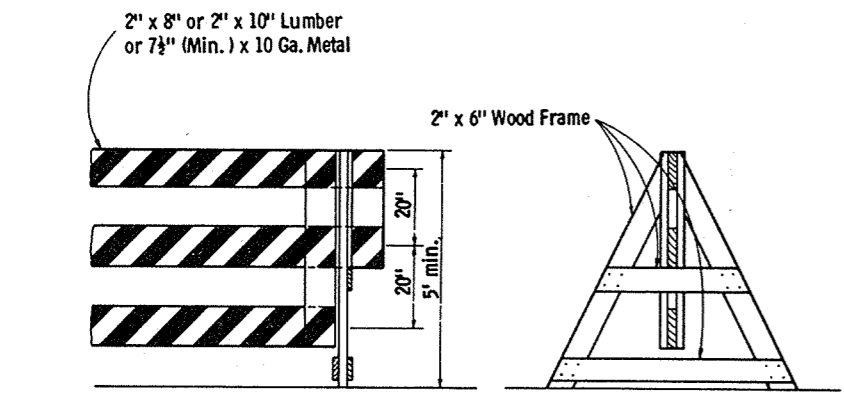


**ALTERNATE TYPE INSTALLATION (DEMOUNTABLE)**


**CLASS I BARRICADES**

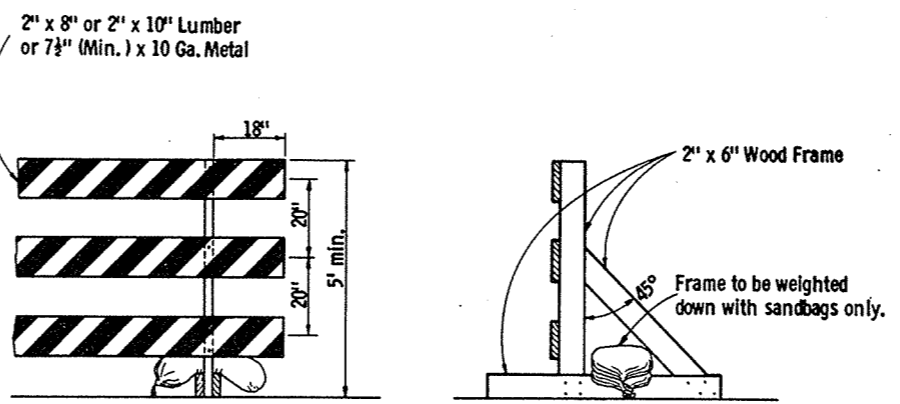


**ALTERNATE TYPE INSTALLATION (RIGID)**

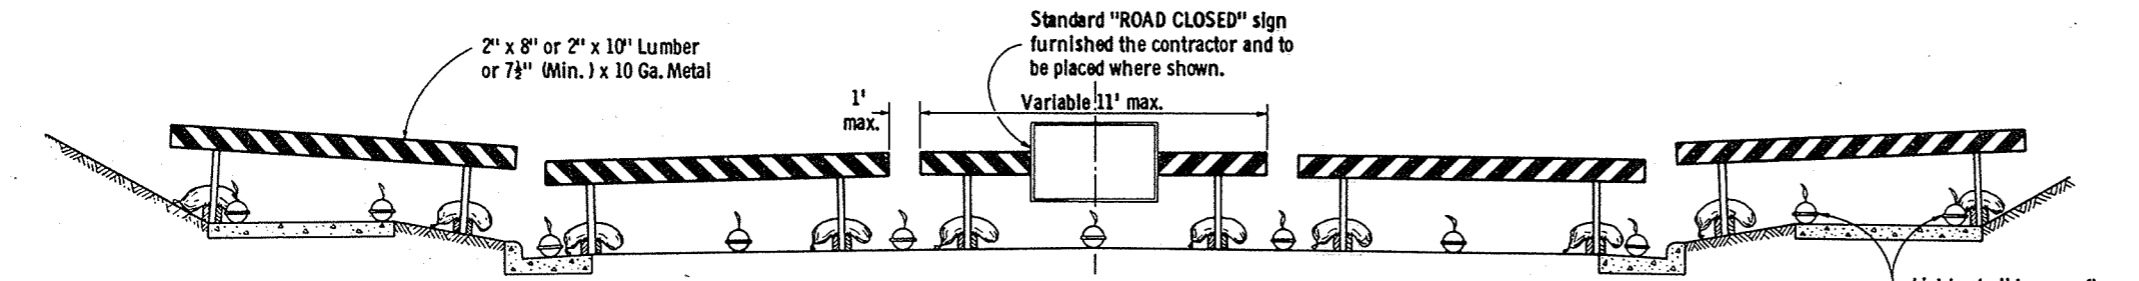

**TYPICAL INSTALLATION SHOWING RIGID BARRICADES**

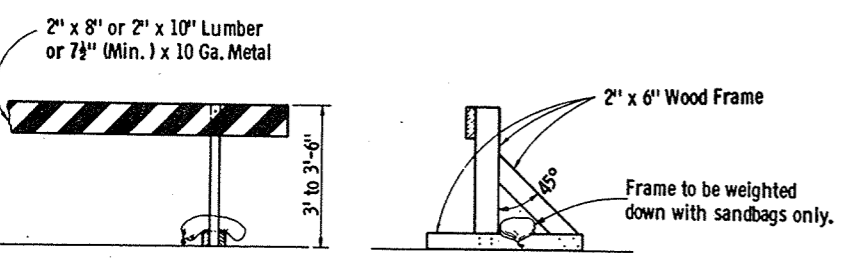


**ALTERNATE TYPE INSTALLATION (RIGID)**

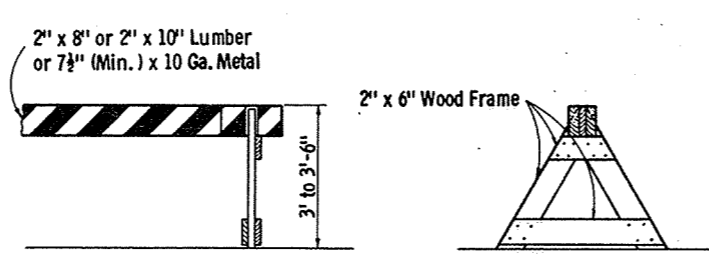


**ALTERNATE TYPE INSTALLATION (DEMOUNTABLE)**

**CLASS II BARRICADES**

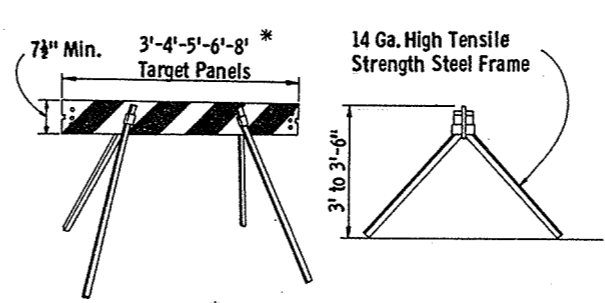

**ALTERNATE TYPE INSTALLATION (DEMOUNTABLE)**

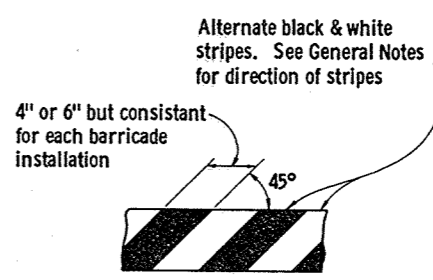

**TYPICAL DIAGONAL STRIPES**  
Applies to all Classes & Types of Barricades

S. D. D. 15C1-1

**CONSTRUCTION BARRICADE**

State Highway Commission of Wisconsin

RECOMMENDED FOR APPROVAL:

DATE: 1/16/67

DATE: 1/13/67



DESIGN ENGINEER: E. J. Gubit

STATE HIGHWAY ENGINEER: J. J. Lummata

**BENCH MARK**

NO.	STATION	DESCRIPTION	ELEV.
28	167+60	SPIKE IN 24" OAK STUB	225' RT. 757.35

PROJECT ID 6460-2-71	SHEET NUMBER 16	TOTAL SHEETS 91
FEDERAL PROJECT DESIGNATION 5 1260(3)		

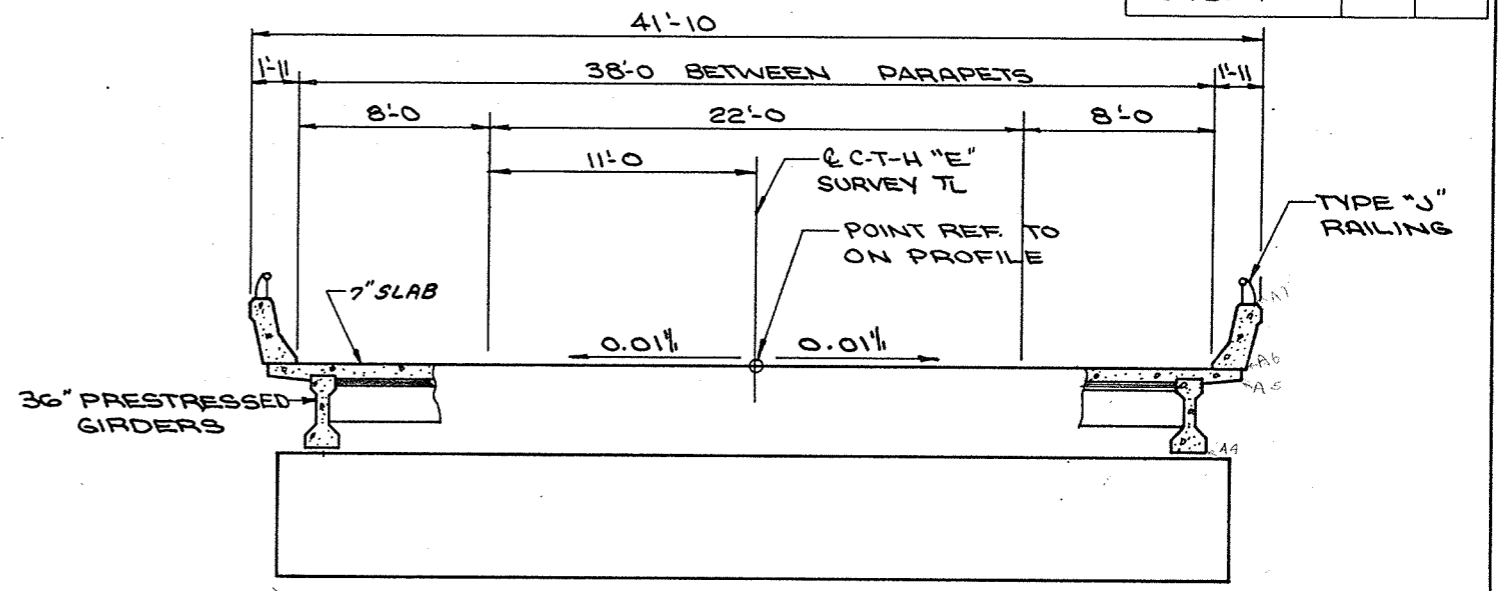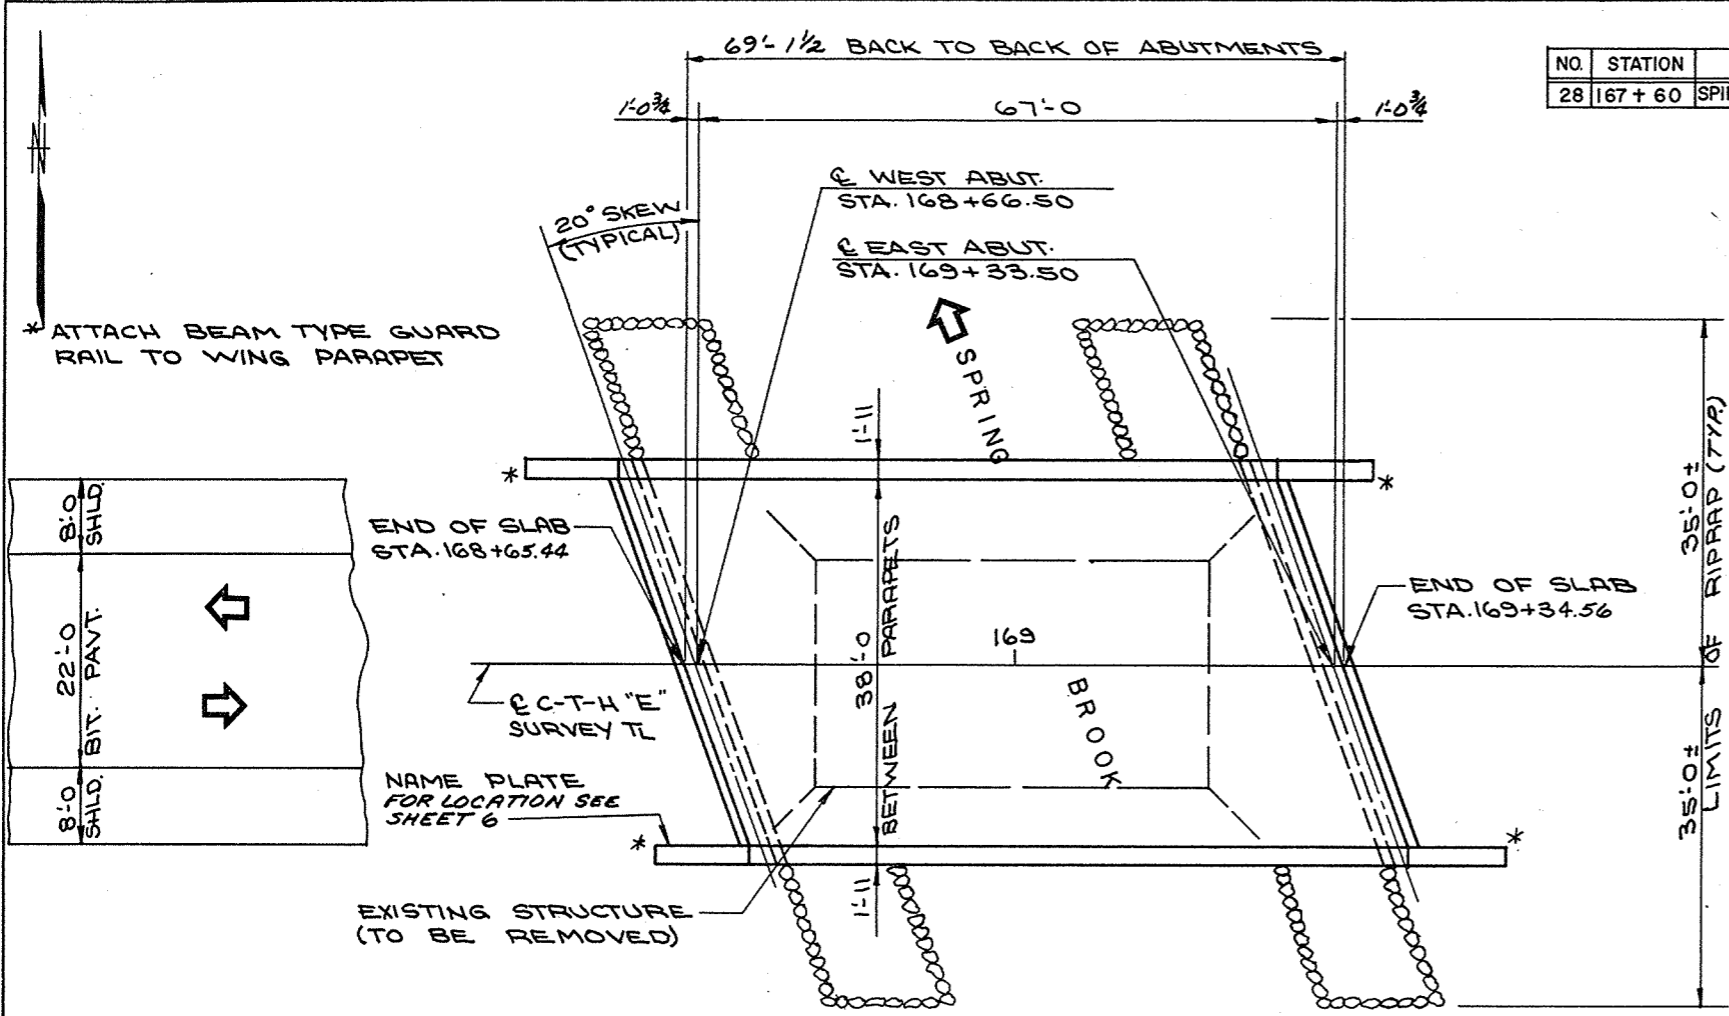

**CROSS SECTION THRU ROADWAY LOOKING EAST**

**DESIGN DATA**

LIVE LOAD: H20 - FUTURE WEARING SURFACE - 20 P.S.F.  
 ALLOWABLE DESIGN STRESSES:  
 CONCRETE MASONRY, GRADE "AA" SLAB -  $f_c = 1,200$  P.S.I.  
 ALL OTHER -  $f_c = 1,400$  P.S.I.  
 BAR REINFORCING -  $f_s = 20,000$  P.S.I.  
 $n = 10$   
 36" PRESTRESSED GIRDERS  
 CONCRETE MASONRY -  $f_c = 6,000$  P.S.I.  
 STRANDS:  $1/2$ "  $\phi$  WITH ULTIMATE TENSILE STRENGTH OF - 270,000 P.S.I.

**GENERAL NOTES**

DRAWINGS SHALL NOT BE SCALED.  
 BAR STEEL REINFORCEMENT SHALL BE IMBEDDED 2' CLEAR UNLESS OTHERWISE SHOWN OR NOTED.  
 ELASTOMERIC BEARING PADS NEED NOT BE INDIVIDUALLY MOLDED PROVIDED THE EDGES ARE SMOOTH AND TRUE.  
 THE SLOPE OF THE FILL IN FRONT OF THE ABUTMENTS SHALL BE COVERED WITH HEAVY RIPRAP TO THE EXTENT SHOWN ON THIS SHEET AND IN THE ABUTMENT DETAILS.  
 THE UPPER LIMITS OF EXCAVATION FOR STRUCTURES FOR THE ABUTMENTS SHALL BE THE BOTTOM OF SLOPE PROTECTION AND THE QUANTITIES WERE COMPUTED FROM THIS LINE.  
 AT ABUTMENTS ALL SPACES EXCAVATED AND NOT OCCUPIED BY THE NEW STRUCTURE SHALL BE BACKFILLED WITH GRANULAR BACKFILL. PAYMENT WILL BE MADE ONLY FOR MATERIAL ACTUALLY PLACED WITHIN THE LIMITS FOR EXCAVATION FOR STRUCTURES.  
 JOINT FILLER SHALL CONFORM TO THE REQUIREMENTS OF A.A.S.H.O. DESIGNATION M153 OR M213.

**FOUNDATION DATA**

ABUTMENTS TO BE SUPPORTED ON  $10\ 3/4$ " C.I.P. CONC. PILES DRIVEN TO A MIN. BRG. VALUE OF 55 TONS PER PILE. LENGTH = 45'-0"

**HYDRAULIC DATA**


$Q_{50}$  - 2,000 C.F.S.  
 VEL. - 7.4 F.P.S.  
 WATERWAY AREA - 270 SQ. FT.  
 H.W. - 756.0 (1971)  
 DRAINAGE AREA - 10.2 SQ. MI.

**TRAFFIC VOLUME**

A.D.T. - 800 (1973)  
 R.D.S. - 50 M.P.H.


**TOTAL ESTIMATED QUANTITIES**

BID ITEMS	UNIT	W.ABUT.	E.ABUT.	SUPER	TOTAL
REMOVING OLD BRIDGE - STA. 169+00.00	L.S.				1
EXCAVATION FOR STRUCTURES	C.Y.	10	10		20
GRANULAR BACKFILL	C.Y.	5	5		10
CONCRETE MASONRY	C.Y.	36.5	36.5	97.4	170.4
PRESTRESSED GIRDER, I TYPE, 36 INCH	L.F.			476	476
BAR STEEL REINFORCEMENT	LBS.	1910	1910	20,070	23,890
STRUCTURAL CARBON STEEL	LBS.			460	460
BEARING PADS, ELASTOMERIC	S.F.			14	14
CAST-IN-PLACE CONCRETE PILING, DELIVERED AND DRIVEN, $10\ 3/4$ INCH	L.F.	360	360		720
TUBULAR RAILING, TYPE J	L.F.			162	162
HEAVY RIPRAP	C.Y.	85	85		170
<b>NON-BID ITEM</b>					
1/8" ALUMINUM OR ZINC PLATE	S.F.			17	17
FILLER - 1/4" SIZE	S.F.			16	16
FILLER - 1/2" SIZE	S.F.			24	24
FILLER - 3/4" SIZE	S.F.			13	13
POLYVINYL CHLORIDE WATERSTOP	L.F.	40	40		80

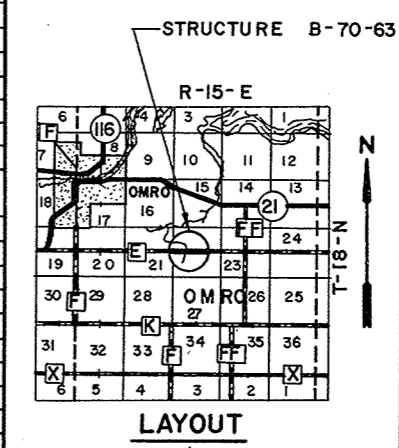


**LAYOUT**

**PLAN LAYOUT B-70-63**

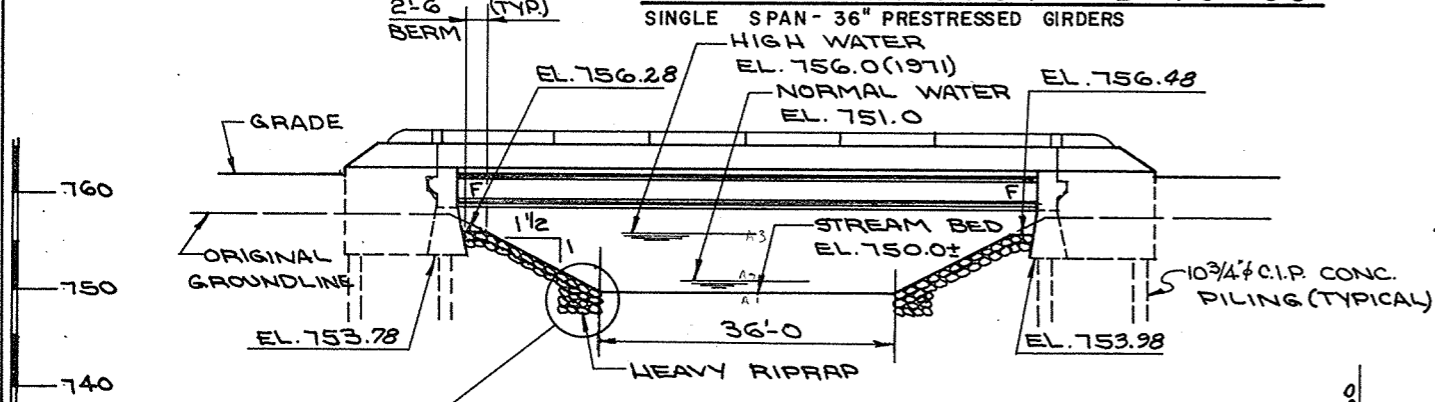

**ELEVATION**  
NORMAL TO SPRING BROOK

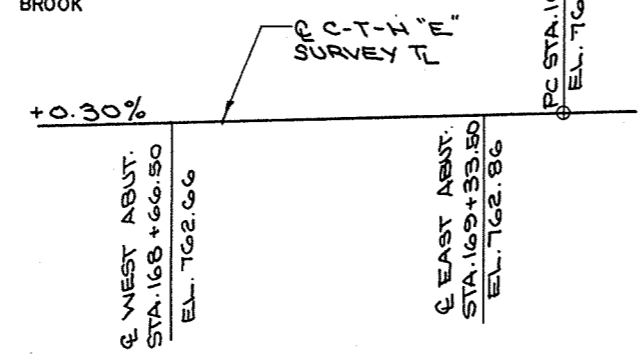

**PROFILE GRADE C-T-H 'E'**

**LIST OF DRAWINGS**

- 1. GENERAL PLAN - X 47281
- 2. SUBSURFACE EXPLORATION - X 47282
- 3. ABUTMENTS - X 47283
- 4. PRESTRESSED GIRDER DETAILS - X 47284
- 5. SUPERSTRUCTURE - X 47285
- 6. SLOPED FACE PARAPET "A" - X 47286
- 7. TUBULAR RAILING TYPE "J" - X 47287

No.	Date	Revision	By

STATE OF WISCONSIN  
 DEPARTMENT OF TRANSPORTATION  
 DIVISION OF HIGHWAYS

**STRUCTURE B-70-63**  
 C-T-H "E" OVER SPRING BROOK



County WINNEBAGO TN: OMRO  
 Design Spec. A.A.S.H.O. 1969 Load H20 Const. Spec. 1969  
 Designed By BEK Design Checked W.V. Drawn By R.J.J. Plans Checked SMH

Approved W.A. Kline 4-28-72  
 Chief Bridge Engineer Date

**GENERAL PLAN** SHEET 1 OF 7  
 X 47281



PROJECT NO. 6460-2-71	SHEET NUMBER 17	TOTAL SHEETS 91
FEDERAL PROJECT DESIGNATION 51260(3)		

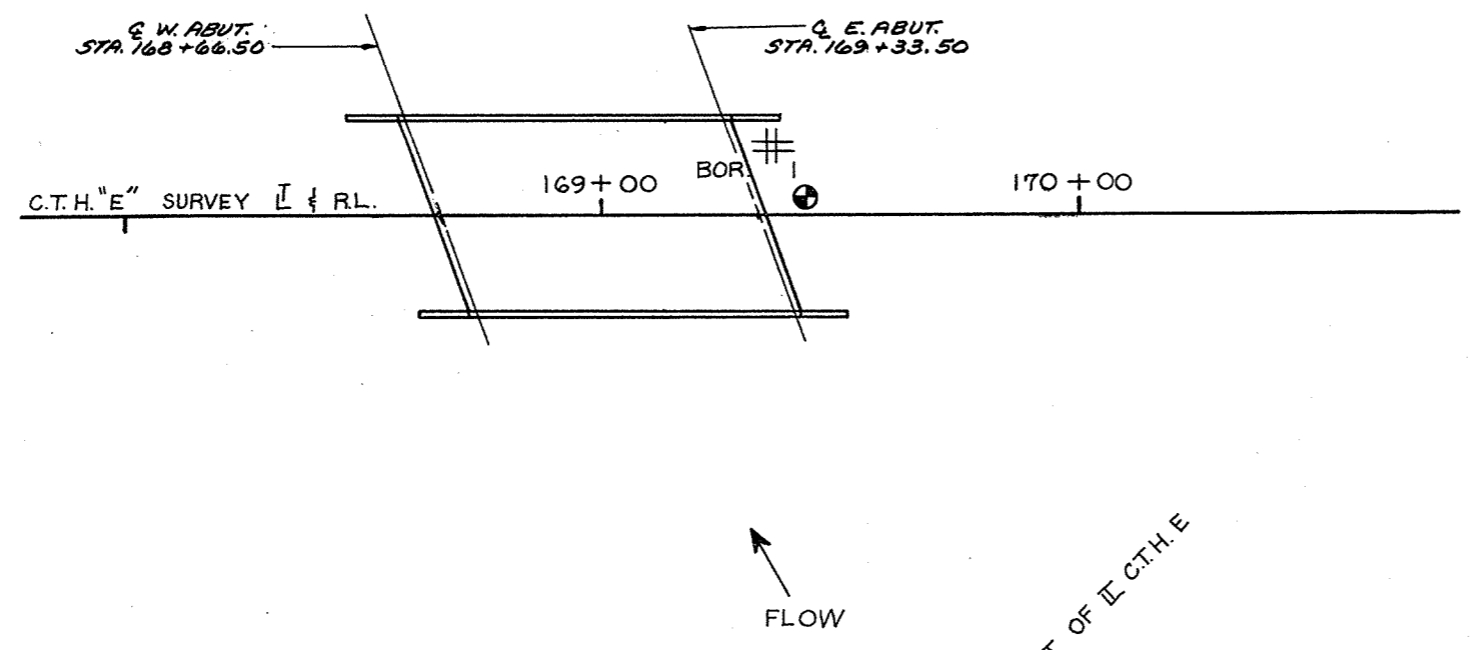
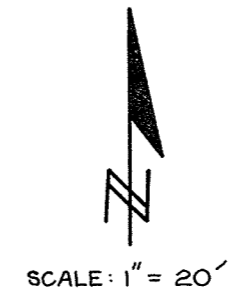


**ABBREVIATIONS**

F — Fine  
M — Medium  
C — Coarse  
Ws — Weathered  
So — Sound

**MATERIAL SYMBOLS**


Topsoil	Silt	Sandstone
Sand	Peat	Limestone
Gravel	Clay	Igneous Rock

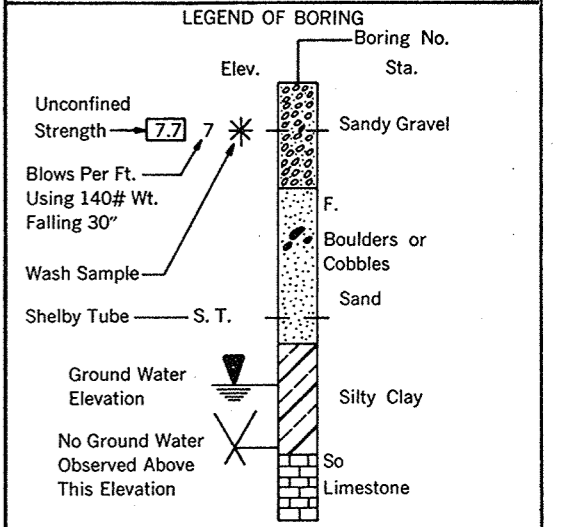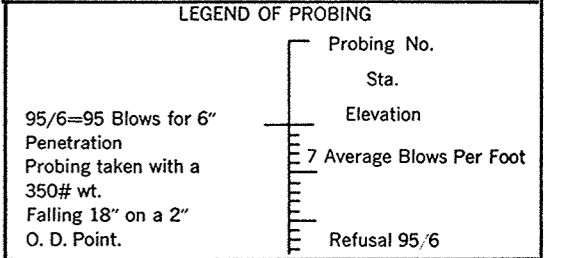

Unless otherwise specified, the blows per foot at the locations indicated are based on driving a 2" O. D. x 1.4" I. D. split spoon sampler with a 140# hammer having a free fall of 30". The blow count is taken in undisturbed soil immediately below a cased or open hole eliminating side friction on the drive pipe.

**SUBSURFACE EXPLORATION FOR FOUNDATION DESIGN AND BIDDERS INFORMATION**

To obtain relative data concerning the character of material in and upon which the foundation might be built, borings and/or soundings were made at points approximately as indicated on this drawing. The data presented herein represents the findings of the subsurface explorations made. However, because the depths investigated are limited and the area of the borings and/or soundings is very small in relation to the entire area, the Division of Highways does not warrant conditions below the depths investigated or that the classification of material encountered in these investigations is necessarily typical of the entire site.

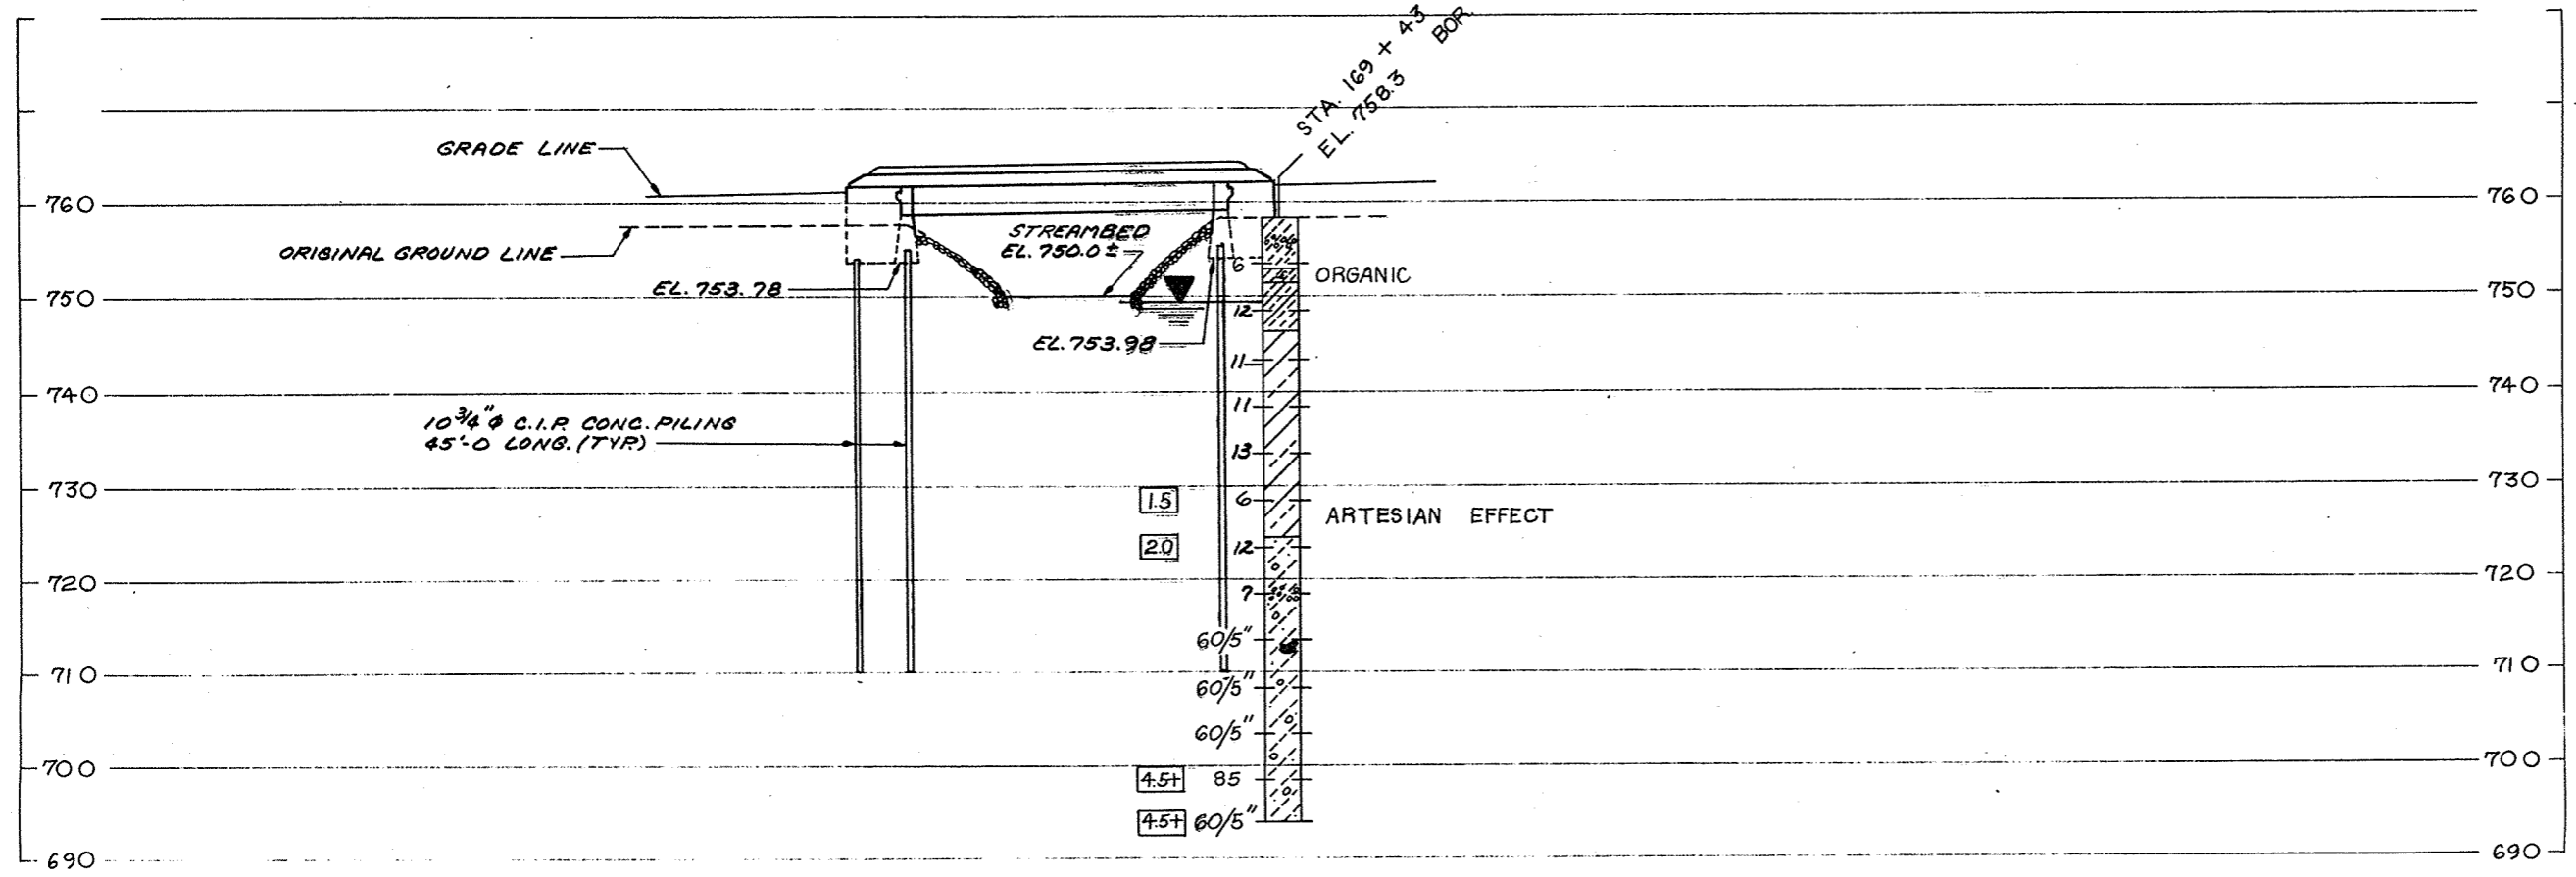


No.	Date	Revision	By
STATE OF WISCONSIN DEPARTMENT OF TRANSPORTATION DIVISION OF HIGHWAYS			
<b>STRUCTURE B-70-63</b>			
Const. Spec. 1969	Drawn By R.J.J.	Checked BMW	
<b>SUBSURFACE EXPLORATION</b>			SHEET 2 OF 7
			X 47282

W.A. - WEST ABUT.  
E.A. - EAST ABUT.  
RAIL PARAPET NOT SHOWN.  
FOR DETAILS, SEE SHEET 6.


KEYED CONST. JT. FORMED BY SURFACED,  
BEVELED 2:1. POUR CONC. ABOVE THIS JT.  
AFTER SUPER CONC. IS POURED.

SEAL ALL EXPOSED HORIZ. AND VERT. SURFACES  
OF 1/2" FILLER WITH NON-STAINING GRAY NON-  
BITUMINOUS JOINT SEALER. (1" DEEP & HOLD  
1/8" BELOW SURFACE OF CONCRETE.)

PROJECT NO.	6460-2-71	SHEET NUMBER	18	TOTAL SHEETS	91
FEDERAL PROJECT DESIGNATION	5 1260 (3)				

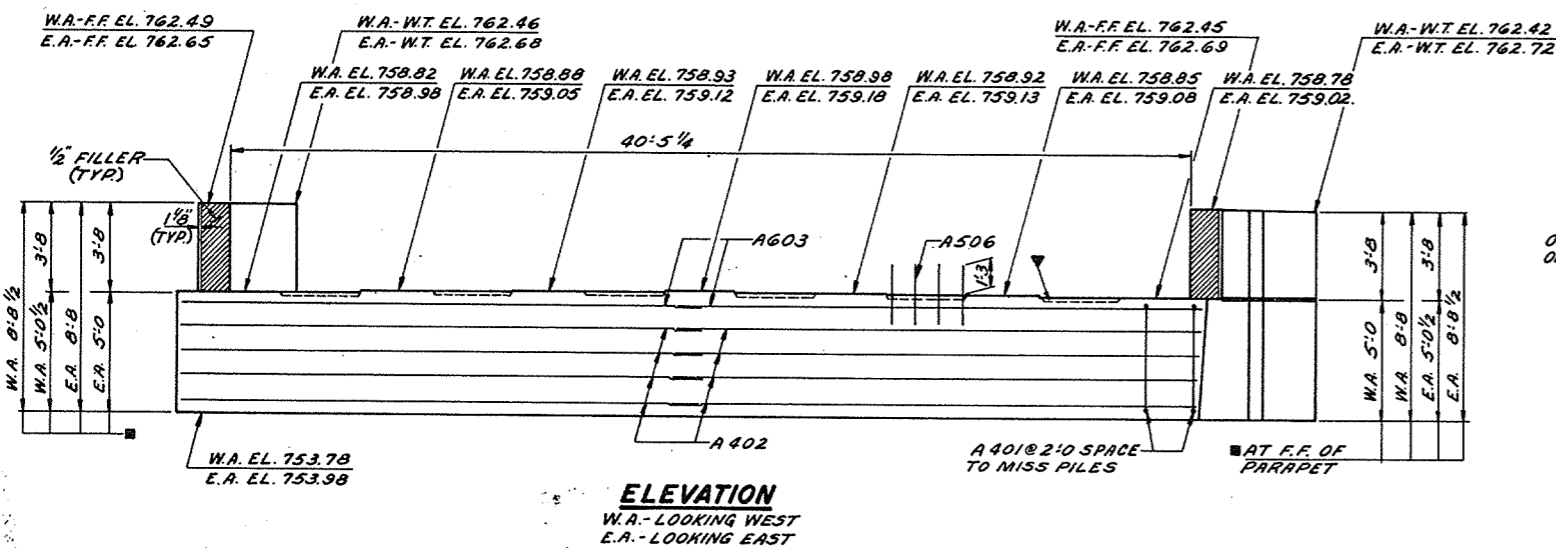

**ELEVATION**  
W.A. - LOOKING WEST  
E.A. - LOOKING EAST

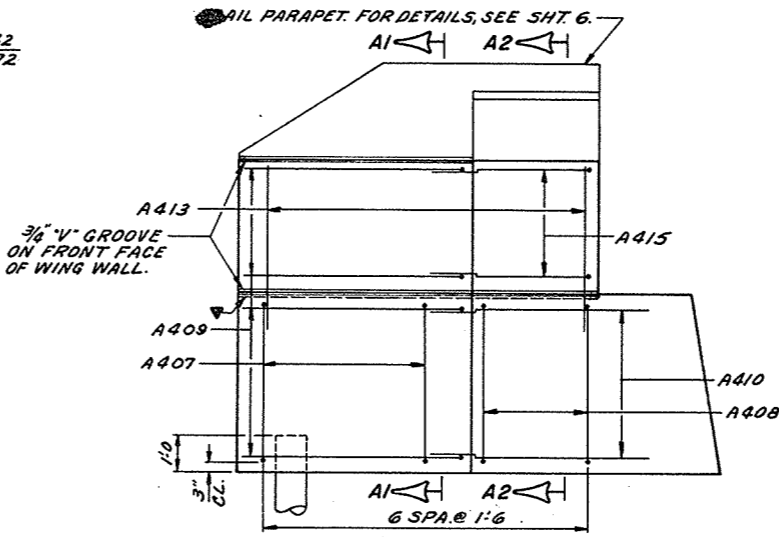


**TYPICAL WING ELEVATION**


**BILL OF BARS**  
**3,130 LBS.**

MARK	NO.	RECD.	W.A.	E.A.	LENGTH	BENT	LOCATION
A401	44	44			7-10	X	BODY-STIRRUPS-VERT.
A402	12	12			22-0		" - HORIZ.
A603	4	4			22-3		" "
A704	8	8			10-0		" @ WINGS-B.F.
A405	4	4			25-0		" - B.F.
A506	26	26			2-6		" - DOWELS
A407	16	16			7-7	X	WINGS-STIRRUPS
A408	12	12			7-0	X	" "
A409	14	14			7-1	X	" - HORIZ.-F.F.
A410	8	8			6-6		" "
A411	10	10			11-11		" - B.F.
A412	6	6			10-6	X	" "
A413	14	14			4-6		" - VERT.-F.F.
A514	14	14			4-9		" - B.F.
A415	6	6			5-2	X	" - F.F.

NOTE: THE FIRST DIGIT OF THE MARK SIGNIFIES THE BAR SIZE.  
ALL BAR DIMENSIONS ARE OUT TO OUT.

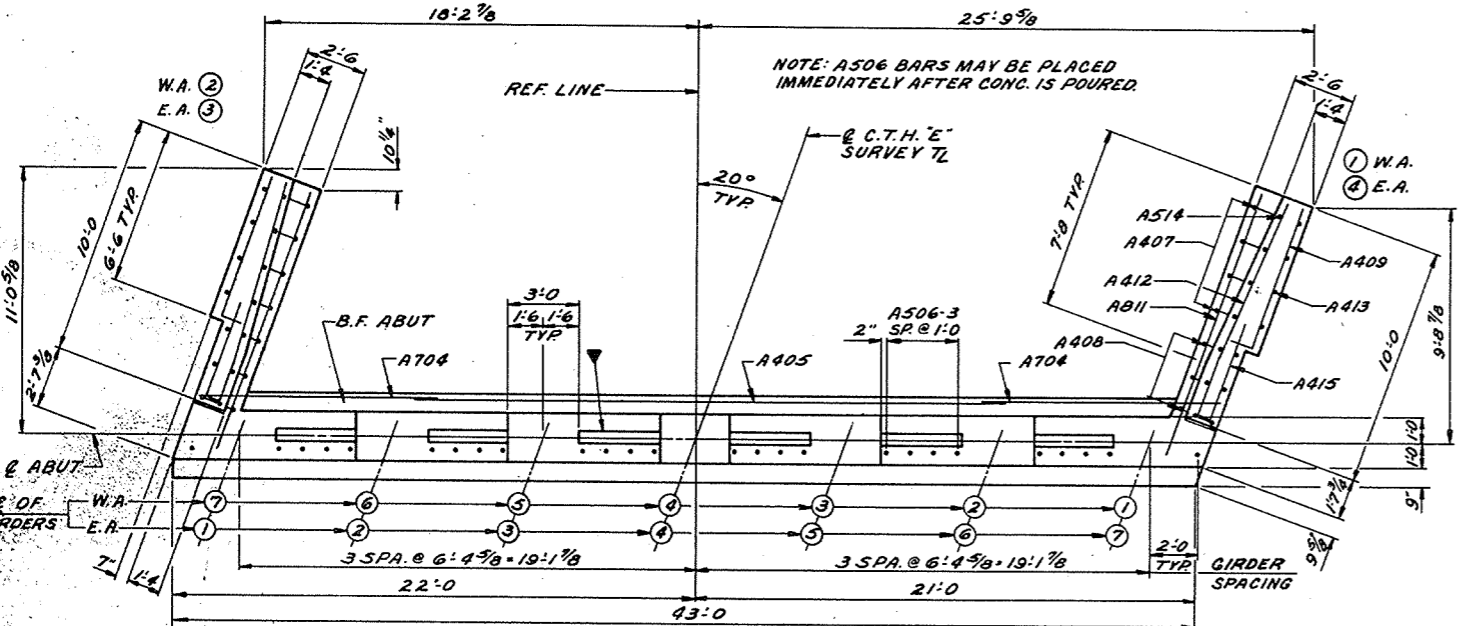


**PLAN**


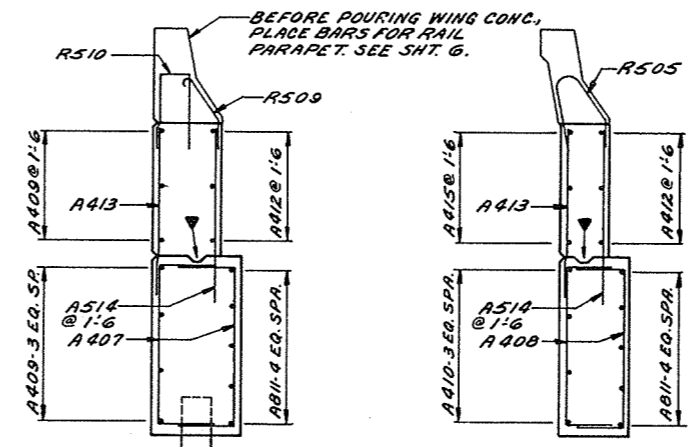


**SECTION A1**


**SECTION A2**

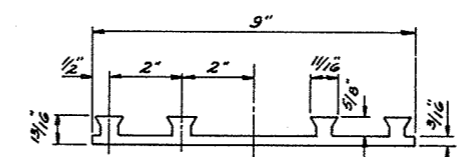


**POLYVINYL CHLORIDE WATERSTOP DETAILS**

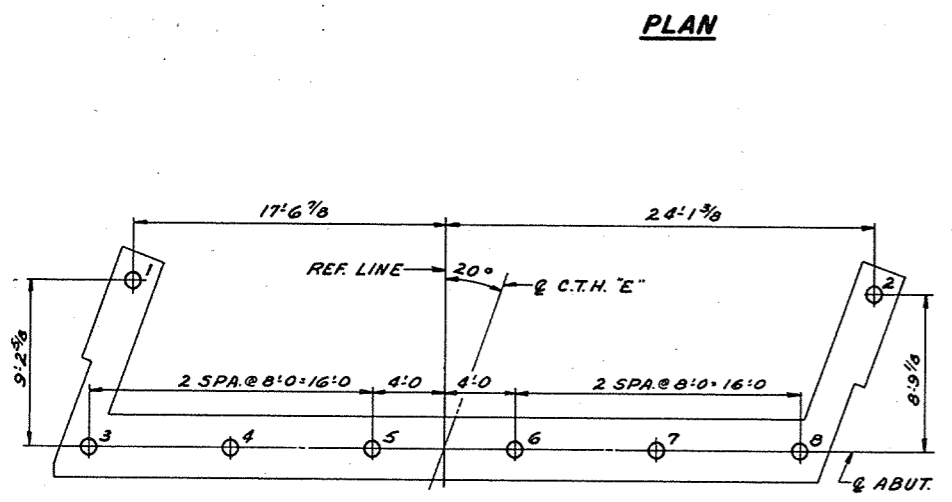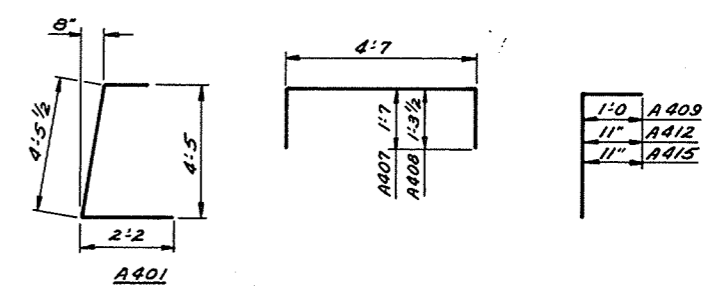

**PILE PLAN**

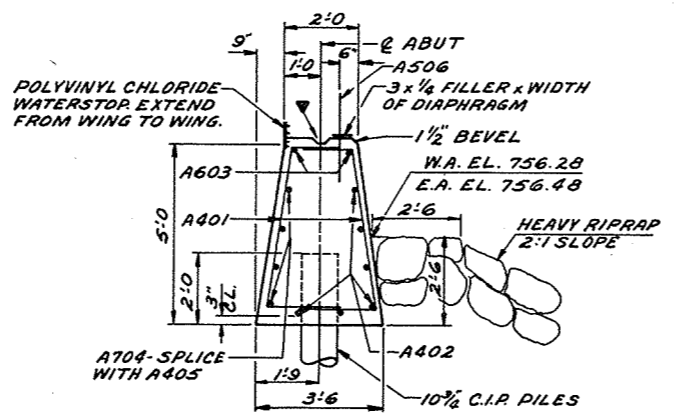

**SECTION THRU BODY**

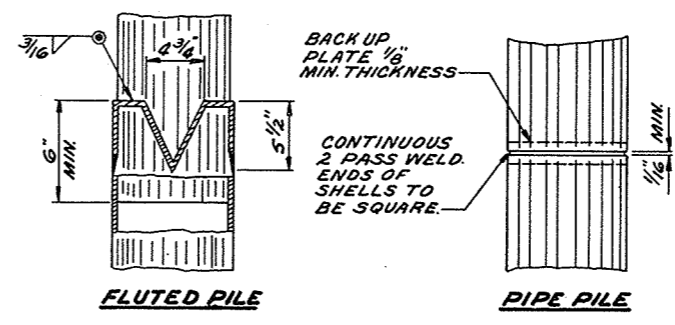

**FLUTED PILE**

**PIPE PILE**

**PILE SPLICE DETAILS**

No.	Date	Revision	By
STATE OF WISCONSIN DEPARTMENT OF TRANSPORTATION DIVISION OF HIGHWAYS			
<b>STRUCTURE B-70-63</b>			
Const. Spec. 1969	Drawn By SELVE	Plans Checked BMW	
<b>ABUTMENTS</b>			SHEET 3 OF 7
			X47283


B. P. R. Division	Project	Sheet Number	Total Sheets
4	6460-27 51260(3)	19	91

**NOTES**


TOP OF GIRDERS TO BE ROUGH FLOATED AND BROOMED TRANSVERSELY FOR BONDING TO THE SLAB.  
 THE GIRDER MANUFACTURER SHALL PROVIDE A SUITABLE LIFTING DEVICE FOR HANDLING AND ERECTING THE GIRDERS.

ALL GIRDERS SHALL BE CAST FULL LENGTH AS SHOWN. PRESTRESSING STRANDS SHALL HAVE AN ULTIMATE STRENGTH OF 270,000 psi AND SHALL BE FLUSH WITH THE ENDS OF THE GIRDER. INSERTS SHALL BE PLACED ON 6" CENTERS SYMMETRICALLY ABOUT THE  $\frac{1}{2}$  OF DIAPHRAGMS IN SPANS.  
 ALL STIRRUPS SHALL BE IN PAIRS AND THE SPACING SHOWN IN "SIDE VIEW" IS MAXIMUM. THE LOCATION SHALL BE SHOWN IN THE SHOP DRAWINGS. BEND EACH END OF NO.4 AND NO.5 STIRRUPS 6" AND NO.6 STIRRUPS 6 $\frac{1}{2}$ ".


TOP LONGITUDINAL BARS IN GIRDER MAY BE SPLICED BY USING 3S BAR DIAMETER LAPS. PLACE ONE LAP AT  $\frac{1}{4}$  OF GIRDER

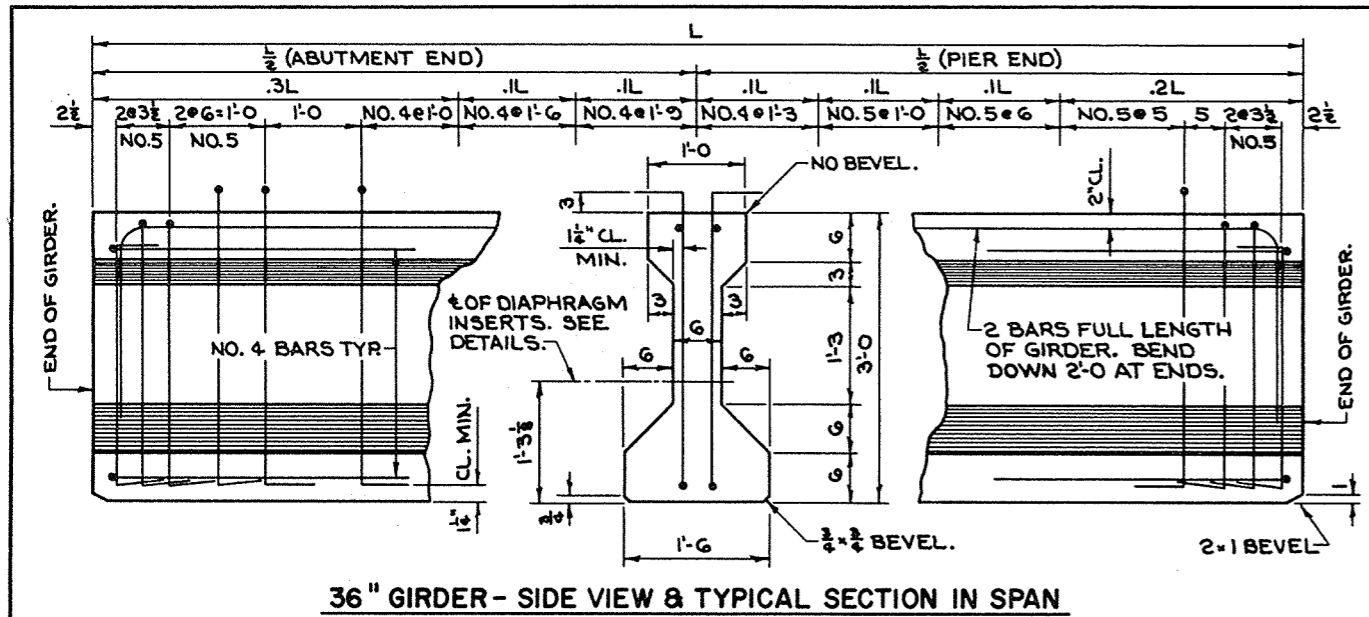


**36" GIRDER - SIDE VIEW & TYPICAL SECTION IN SPAN**

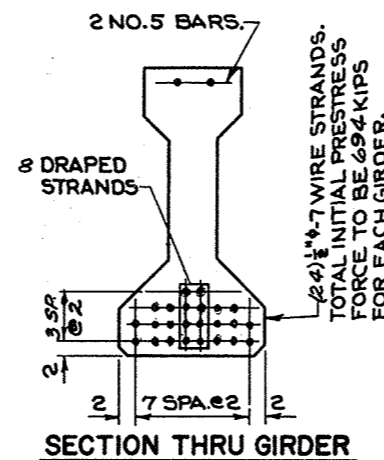



**SECTION THRU GIRDER**

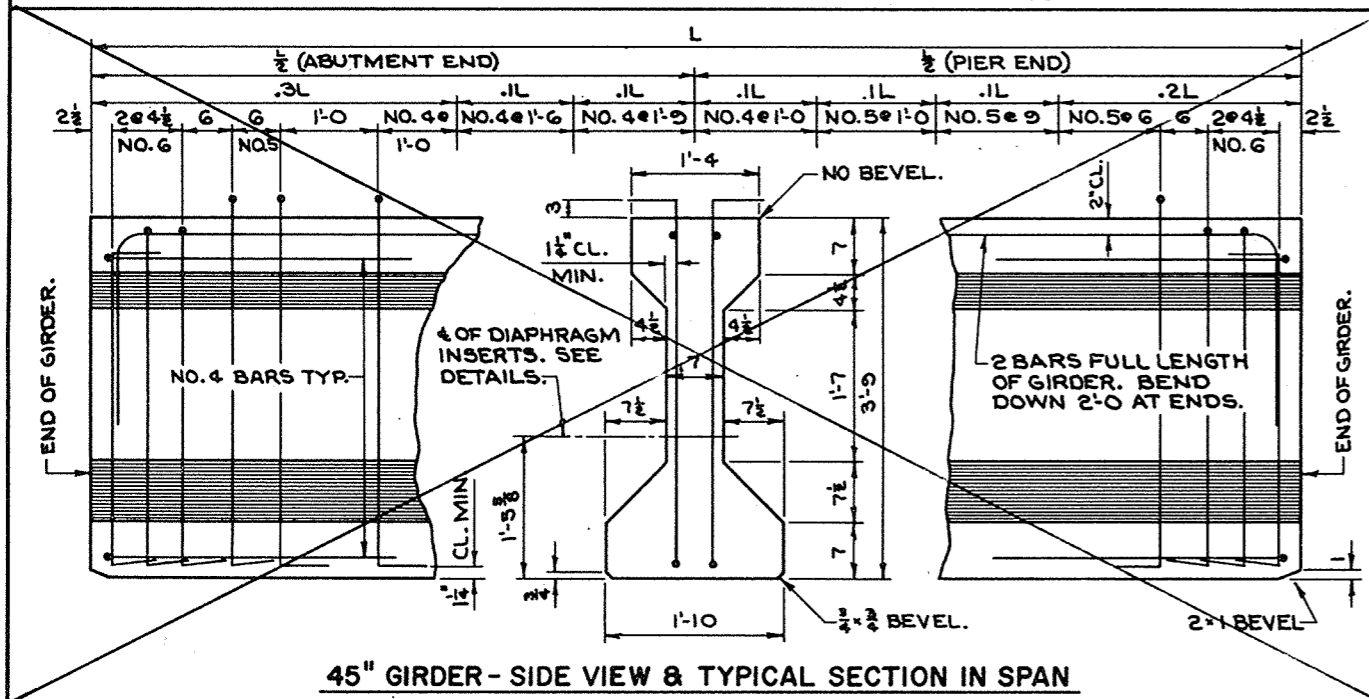


**45" GIRDER - SIDE VIEW & TYPICAL SECTION IN SPAN**

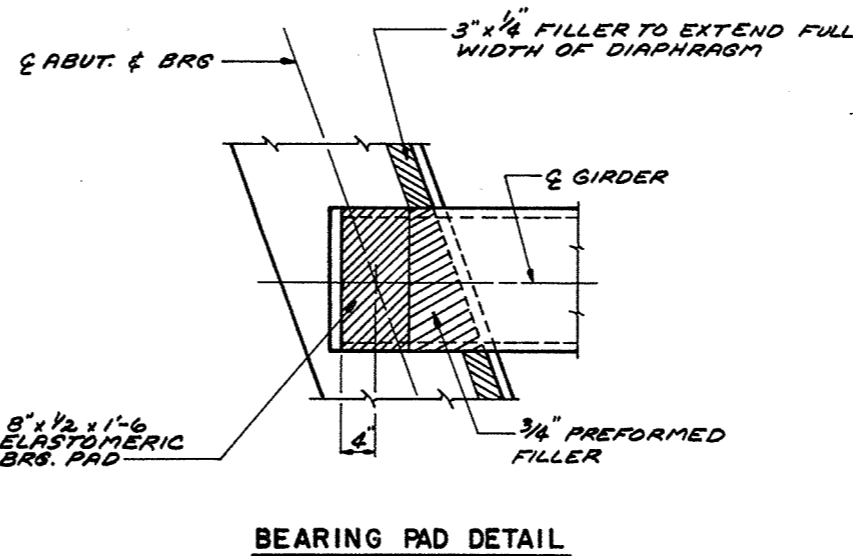

**BEARING PAD DETAIL**

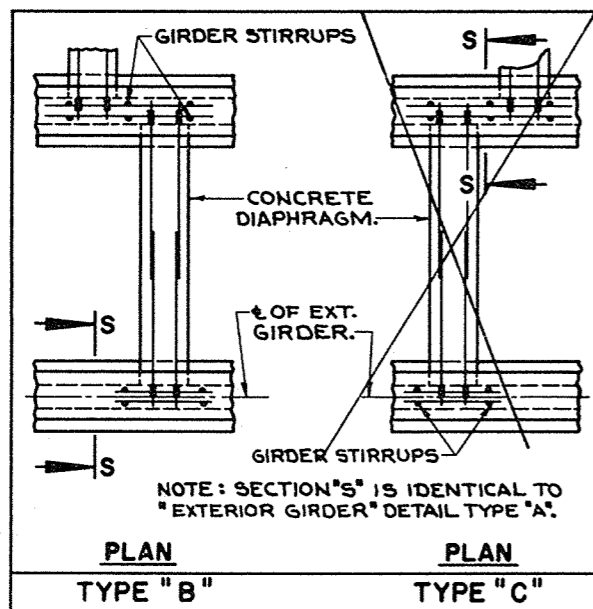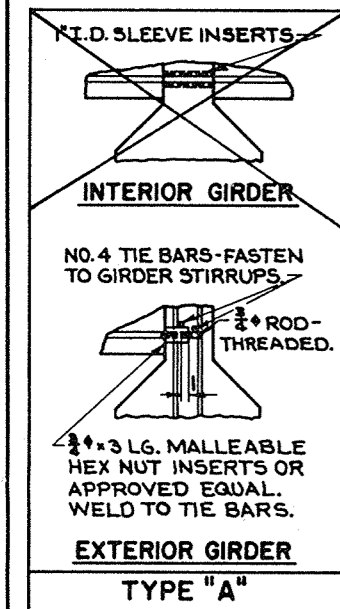


**DIAPHRAGM INSERT DETAILS**

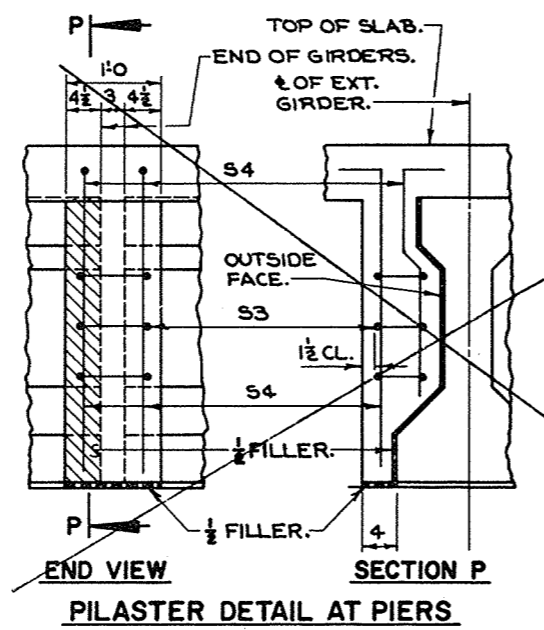


**PILASTER DETAIL AT PIERS**


\* MINIMUM CYLINDER STRENGTH OF CONCRETE AT TIME OF TRANSFER OF PRESTRESS FORCE.

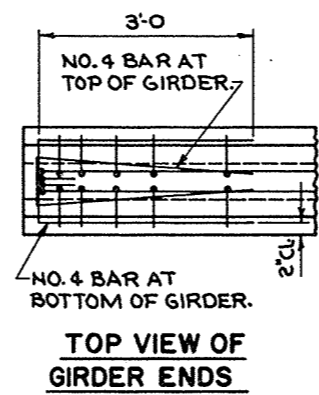

**TOP VIEW OF GIRDER ENDS**

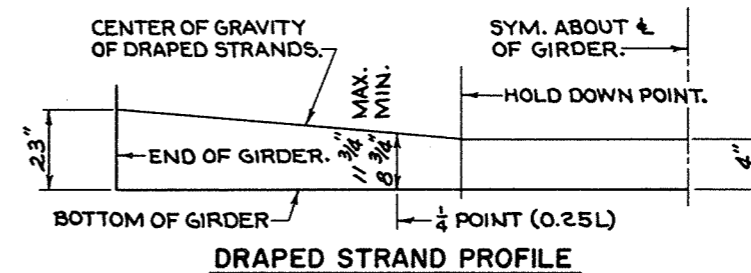

**DRAPED STRAND PROFILE**


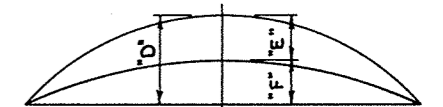


\*\* DATA SHOWN IS THEORETICAL AND MAY VARY WITH CONCRETE STRENGTH, VARIABLE PRESTRESS CONDITIONS AND PRESTRESS LOSSES.

GIRDER DATA	
<b>GIRDER SIZE REQUIRED 36"</b>	
GIRDER LENGTH "L" REQUIRED	68'-0"
f'ci (psi)*	DRAPED PATTERN
	SPREAD PATTERN
DEFLECTION DATA**	PRESTRESS CAMBER "D"
	DEAD LOAD DEFLECTION "E"
	RESIDUAL CAMBER "F"
USE DIAPHRAGM INSERT DETAIL TYPE "B"	

No.	Date	Revision	By
STATE OF WISCONSIN DEPARTMENT OF TRANSPORTATION DIVISION OF HIGHWAYS			
<b>STRUCTURE B-70-63</b>			
Const. Spec. 1969	Drawn By R.J.J.	Plans Checked	BMW
<b>PRESTRESSED GIRDER DETAILS</b>			SHEET 4 OF 7
			X47284


PROJECT ID 6460-2-71	SHEET NUMBER 20	TOTAL SHEETS 91
FEDERAL PROJECT DESIGNATION 51260(3)		

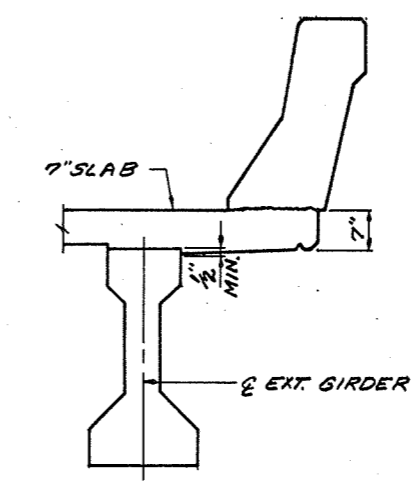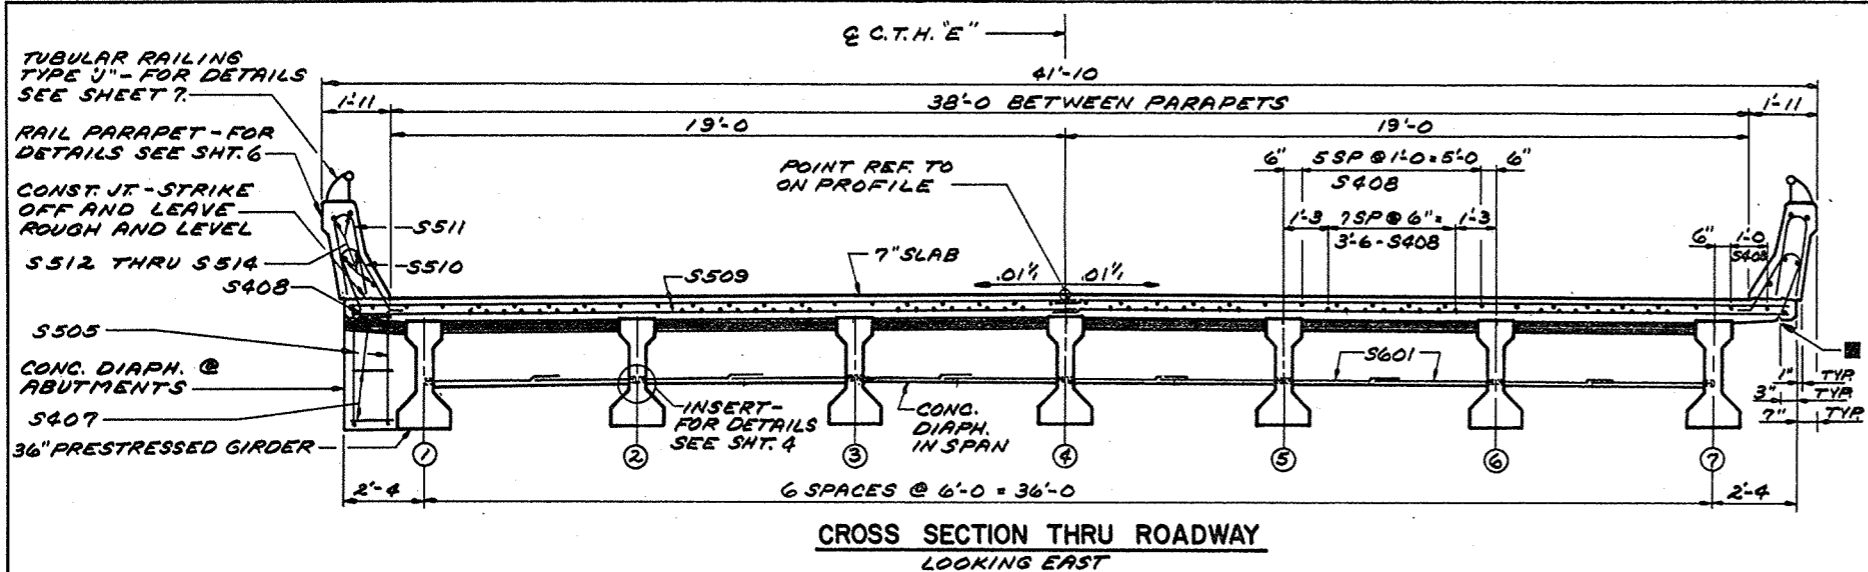

**BILL OF BARS** **20,070 LBS.**



MARK	NO. REQ'D	LENGTH	BENT	LOCATION
S601	24	3-9		DIAPH. @ MID-SPAN
S402	68	3-9	X	" @ ABUT.
S403	8	20-6		" " "
S404	12	22-0		" " "
S505	68	10-7	X	" " "
S406	36	4-8		" " " - BETW. GIRDERS
S407	12	1-4		" " " @ EXT. GIRDERS
S408	180	34-11		SLAB - LONG.
S509	534	22-1		" - TRANS.
S510	138	4-9	X	" @ RAIL PARAPET
S511	138	5-0	X	RAIL PARAPET
S512	20	17-4		" " "
S513	10	22-0		" " "
S514	10	10-10		" " "

THE FIRST DIGIT OF A THREE DIGIT MARK SIGNIFIES THE BAR SIZE.  
ALL DIMENSIONS ARE OUT TO OUT OF BAR.  
● - PLAIN BAR - THREAD ONE END 3"

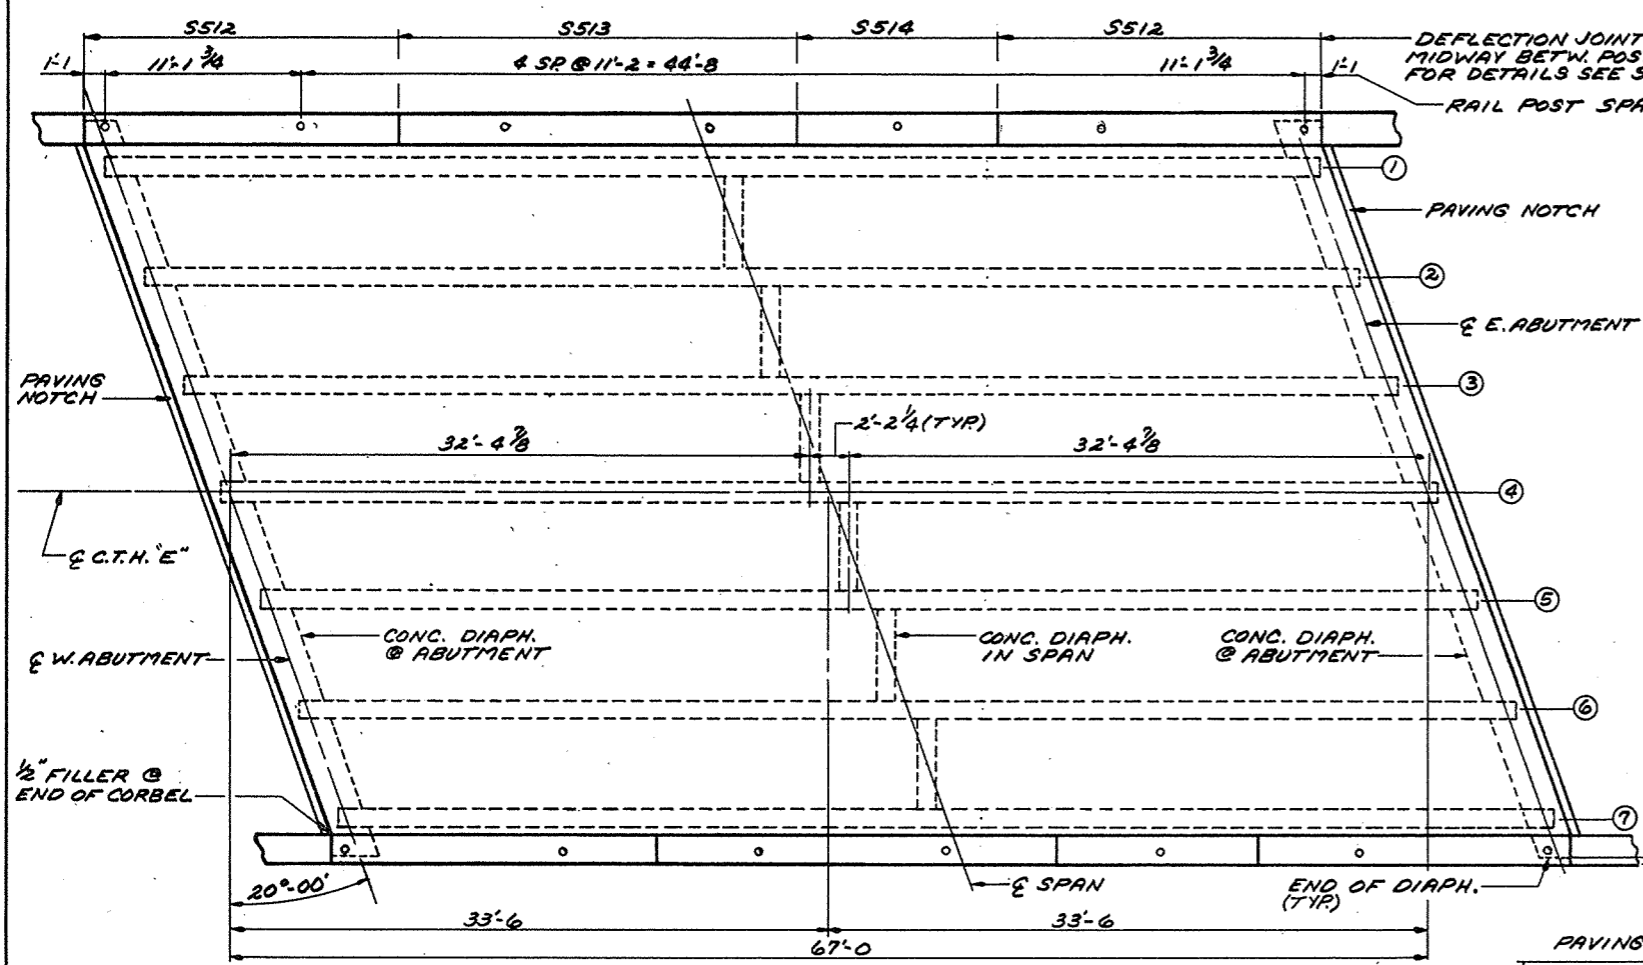


**NOTES**


- BOTTOM TRANSVERSE BARS IN SLAB SHALL BE SUPPORTED BY CONTINUOUS BAR CHAIRS ON OR ADJACENT TO EACH GIRDER AND BY INDIVIDUAL BAR CHAIRS AT 3'-0" CENTERS AT APPROXIMATELY MIDWAY BETWEEN GIRDERS.
- TOP LONGITUDINAL BARS IN SLAB SHALL BE SUPPORTED BY CONTINUOUS BAR CHAIRS AT APPROXIMATELY 4'-0" CENTERS.
- PLACE TRANSVERSE BAR STEEL REINFORCEMENT PARALLEL TO SUBSTRUCTURE UNITS.
- \*DIMENSION IS TAKEN NORMAL TO Q OF SUBSTRUCTURE UNIT.
- - 3/4" CONTINUOUS DRIP GROOVE

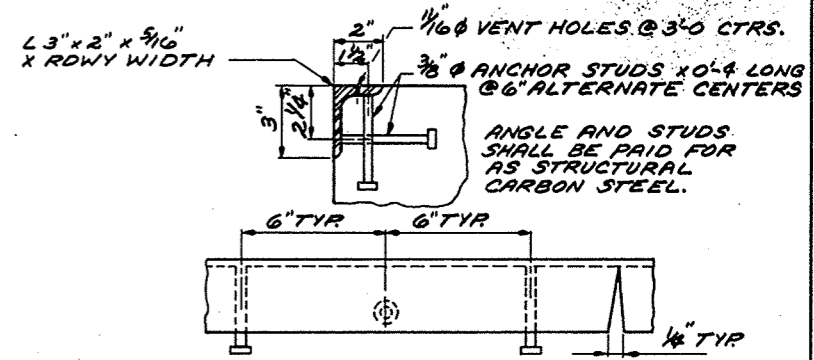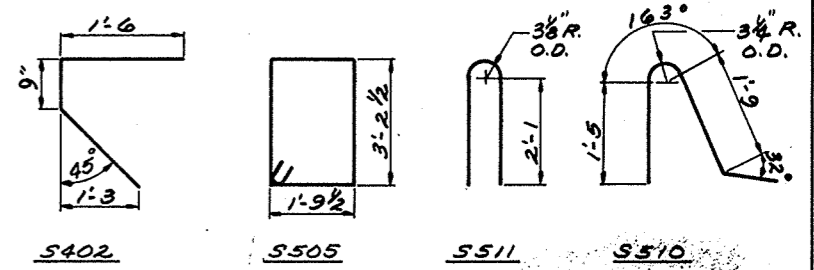

NOTE: FIELD CUT 3" LEG OF ANGLE AS REQ'D FOR BENDING ANGLE TO CONFORM TO RDWY CROWN. ONE CUT SHALL BE AT CROWN. ONE FIELD SPLICE WILL BE PERMITTED IN ANGLE.

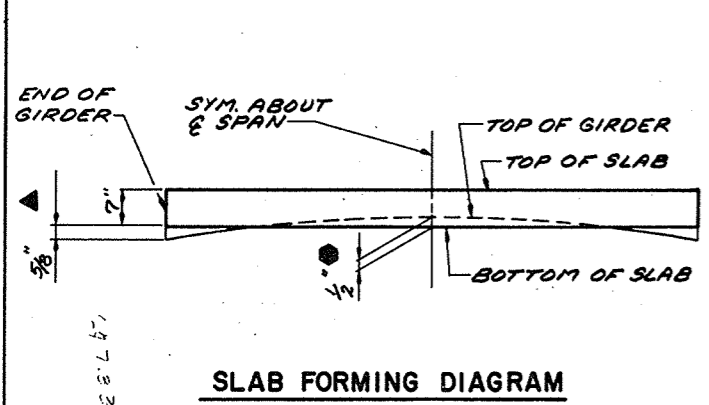

- - TO COMPENSATE FOR VARIATIONS IN PRESTRESS CAMBER AND OTHER MINOR CONSTRUCTION DISCREPANCIES, THE IMBEDMENT AT THE Q OF SPAN MAY BE VARIED WITH A MAXIMUM OF 1 1/2" ALLOWABLE IMBEDMENT AND THE SLAB HELD TO PLAN THICKNESS.
- ▲ - IF VARIATIONS IN PRESTRESS CAMBER AND OTHER CONSTRUCTION DISCREPANCIES ARE OF SUCH MAGNITUDE THAT THE MAXIMUM ALLOWABLE IMBEDMENT AS NOTED ABOVE SHALL BE EXCEEDED, THESE DIMENSIONS SHALL BE REVISED. THE 1 1/2" IMBEDMENT AND THE PLAN SLAB THICKNESS SHALL BE HELD WHILE THE GRADE LINE WILL BE REVISED.

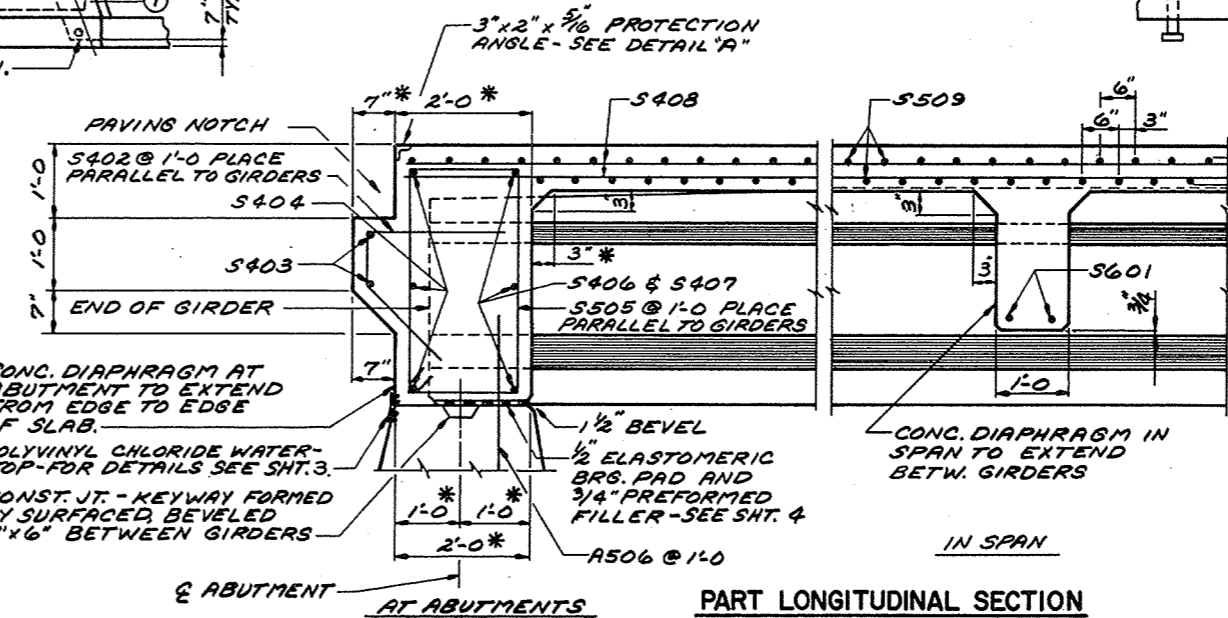

No.	Date	Revision	By

STATE OF WISCONSIN  
DEPARTMENT OF TRANSPORTATION  
DIVISION OF HIGHWAYS

**STRUCTURE B-70-63**




Const. 1969      Drawn By R.J.J.      Plans Checked BMW

**SUPERSTRUCTURE**




SHEET 5 OF 7  
**X47285**



PROJECT ID 6460-2-71	SHEET NUMBER 21	TOTAL SHEETS 91
FEDERAL PROJECT DESIGNATION 51260(3)		

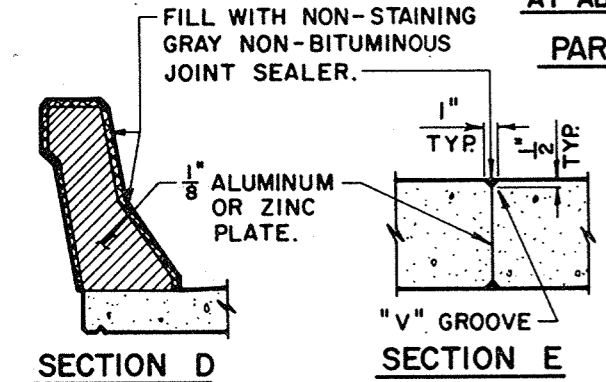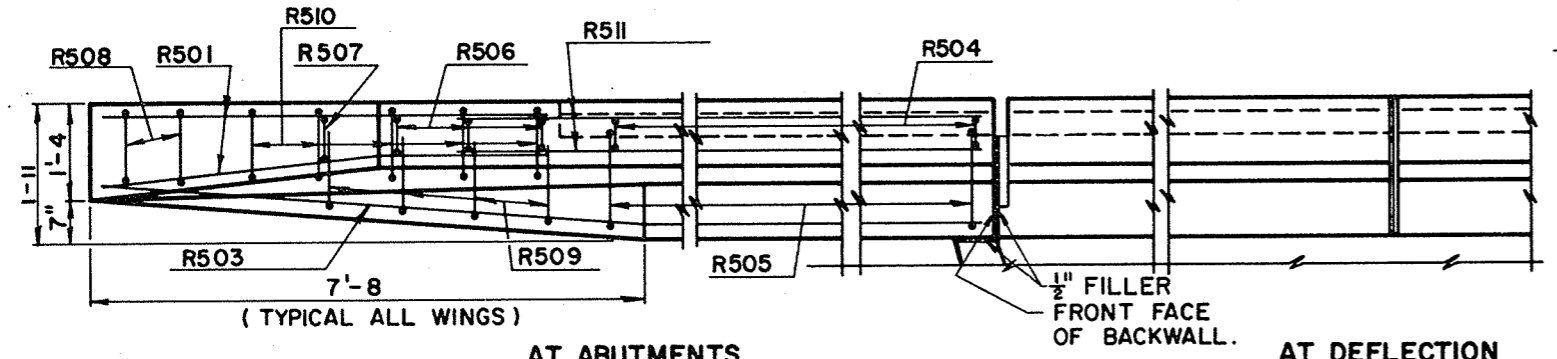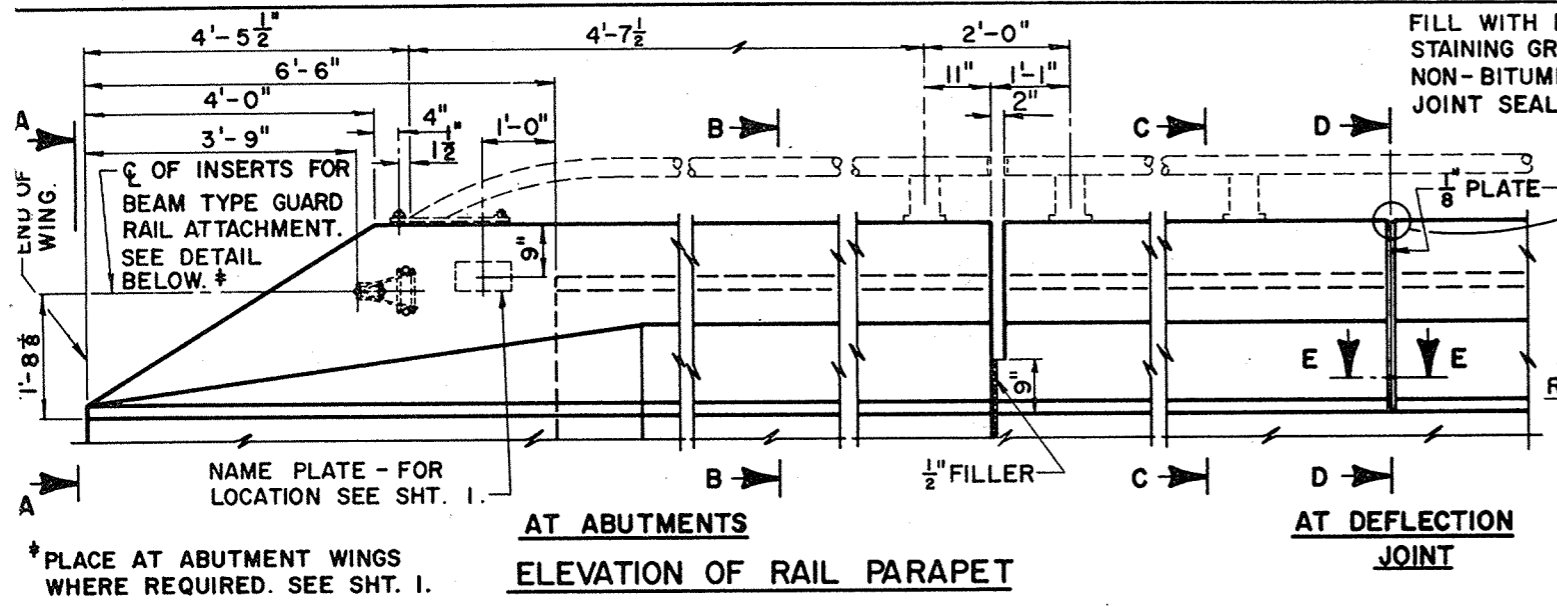

THREADED INSERTS FOR 7/8" x 0'-2" LONG GALVANIZED HEX. HEAD CAP SCREWS. CAP SCREWS TO BE THREADED A MINIMUM OF 1 7/8". INSERTS TO BE THREADED A MINIMUM OF 1 3/4".

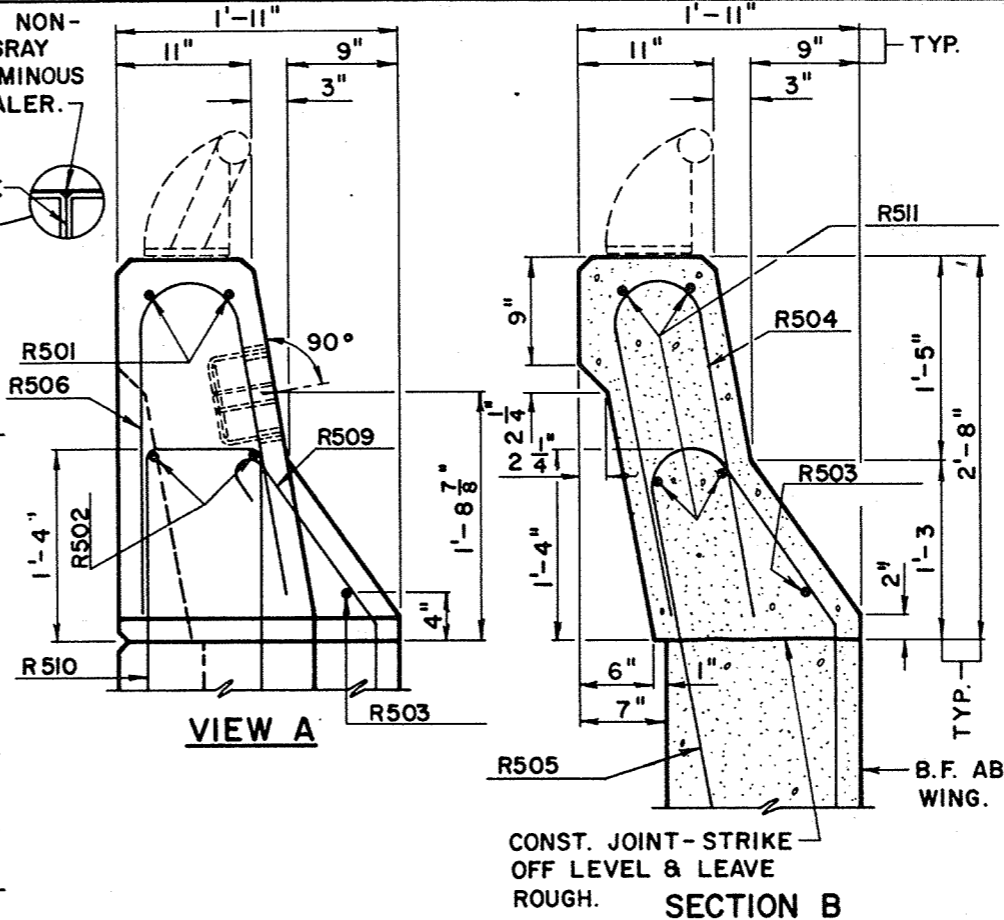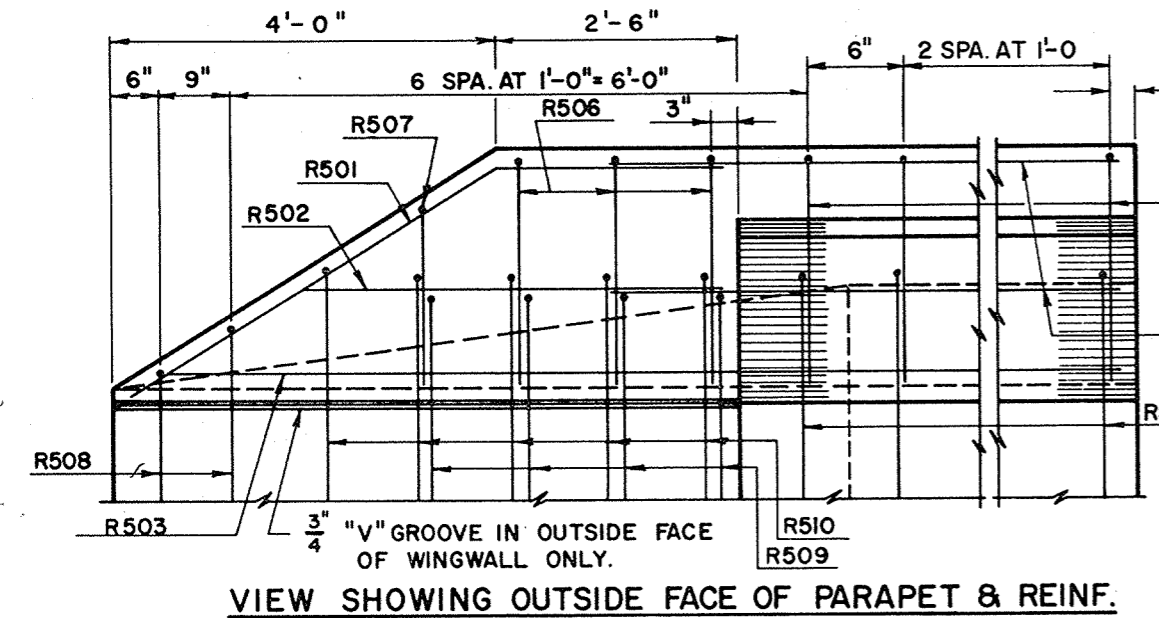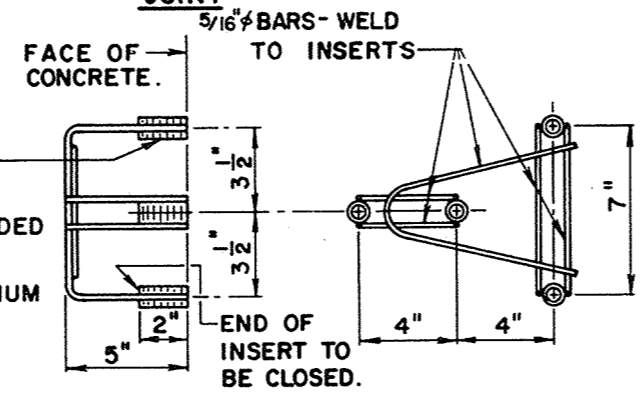


NOTE: BENDING DIMENSIONS ARE OUT TO OUT OF BAR. THE FIRST DIGIT OF A BAR MARK SIGNIFIES THE BAR SIZE.

**RAIL PARAPET BILL OF BARS @ ABUTS. 690 LBS. \*\***

MARK	NO. REQ'D.	LENGTH	BENT	LOCATION
R501	8	6-10	X	WINGS 1 THRU 4
R502	8	4-5		" " " 4
R503	4	9-6	X	" " " 4
R504	16	5-0	X	" " " 4
R505	16	5-10	X	" " " 4
R506	12	5-2	X	" " " 4
R507	4	4-2	X	" " " 4
R508	8	4-10	X	" " " 4
R509	16	3-3	X	" " " 4
R510	20	5-10	X	" " " 4
R511	16	4-8		" " " 4

\*\* WEIGHT IS INCLUDED IN ABUTMENT TOTALS ON SHEET 1.

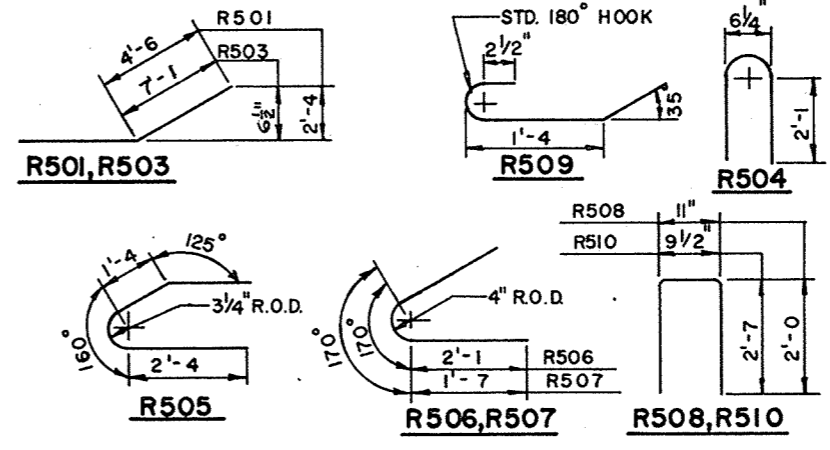


**NOTES**


WHEN PARAPETS ARE POURED CONTINUOUSLY FROM END TO END, THEY SHALL BE SEPARATED AT THE DEFLECTION JOINTS BY A PIECE OF 1/8" ZINC OR ALUMINUM PLATE CUT AS SHOWN IN SECTION "D" BY SHADED AREA. IF CONSTRUCTION JOINTS IN PARAPETS ARE USED AT THE DEFLECTION JOINTS, ONE SIDE OF JOINT SHALL BE COATED WITH BITUMINOUS PAINT AND PLATE SEPARATORS MAY BE OMITTED.

WORK THIS SHEET WITH SHEET TITLED "DETAILS FOR TYPE 'J' TUBULAR ALUMINUM OR STEEL RAILING".


No.	Date	Revision	By
STATE OF WISCONSIN DEPARTMENT OF TRANSPORTATION DIVISION OF HIGHWAYS			
<b>STRUCTURE B-70-63</b>			
Const. Spec. 1969	Drawn By SELJE	Plans Checked BMW	
<b>SLOPED FACE PARAPET "A"</b>			SHEET 6 OF 7
			X 47286

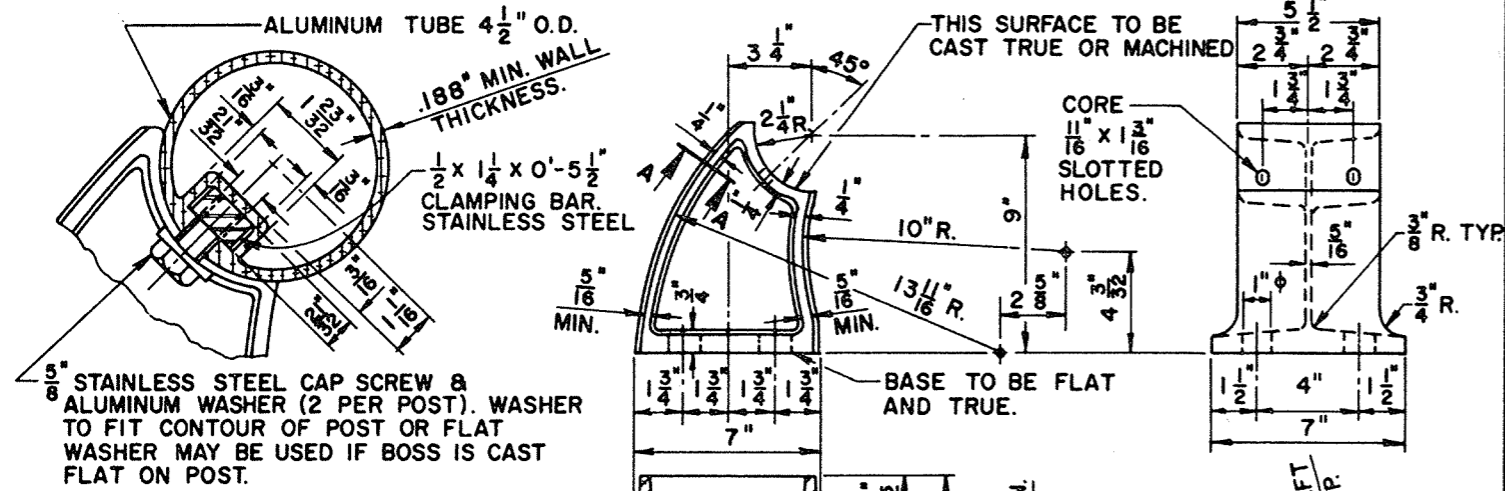

**DETAIL OF RAIL ATTACHMENT TO POST**

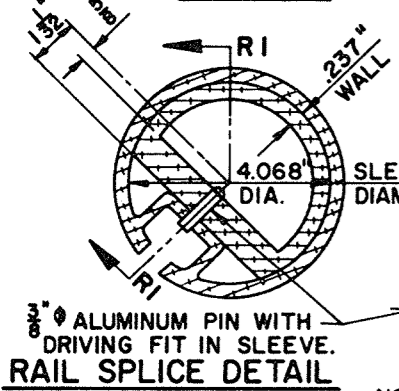


**RAIL SPICE DETAIL**

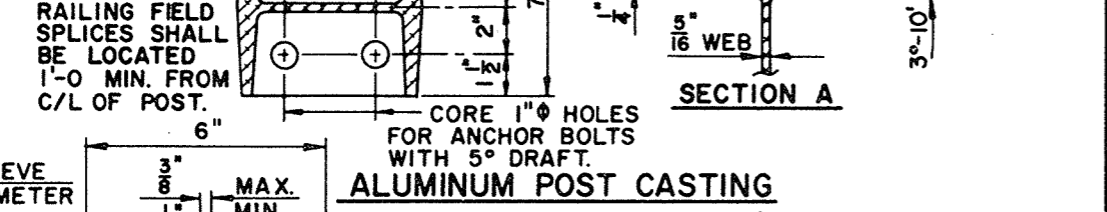


**ALUMINUM POST CASTING**

**NOTES:**  
 MAX. REDUCTION IN DIAMETER OF BENT SECTION SHALL BE 3%.  
 MAX. REDUCTION IN SLOT WIDTH IN BENT TUBING SHALL BE 3/16".  
 WALL THICKNESS OF TUBING ABOVE SHALL BE MIN. NOMINAL AVERAGE WALL THICKNESS.

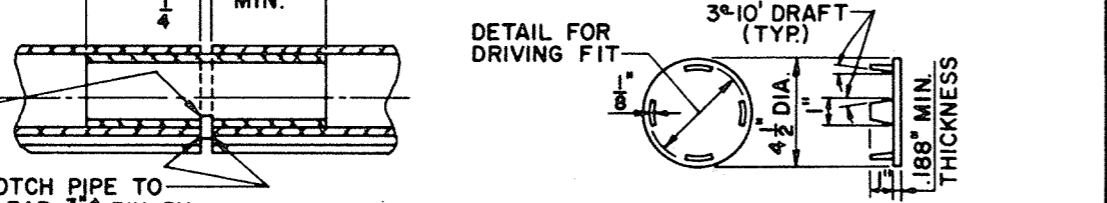


**RAIL CLOSURE CAP DETAIL**

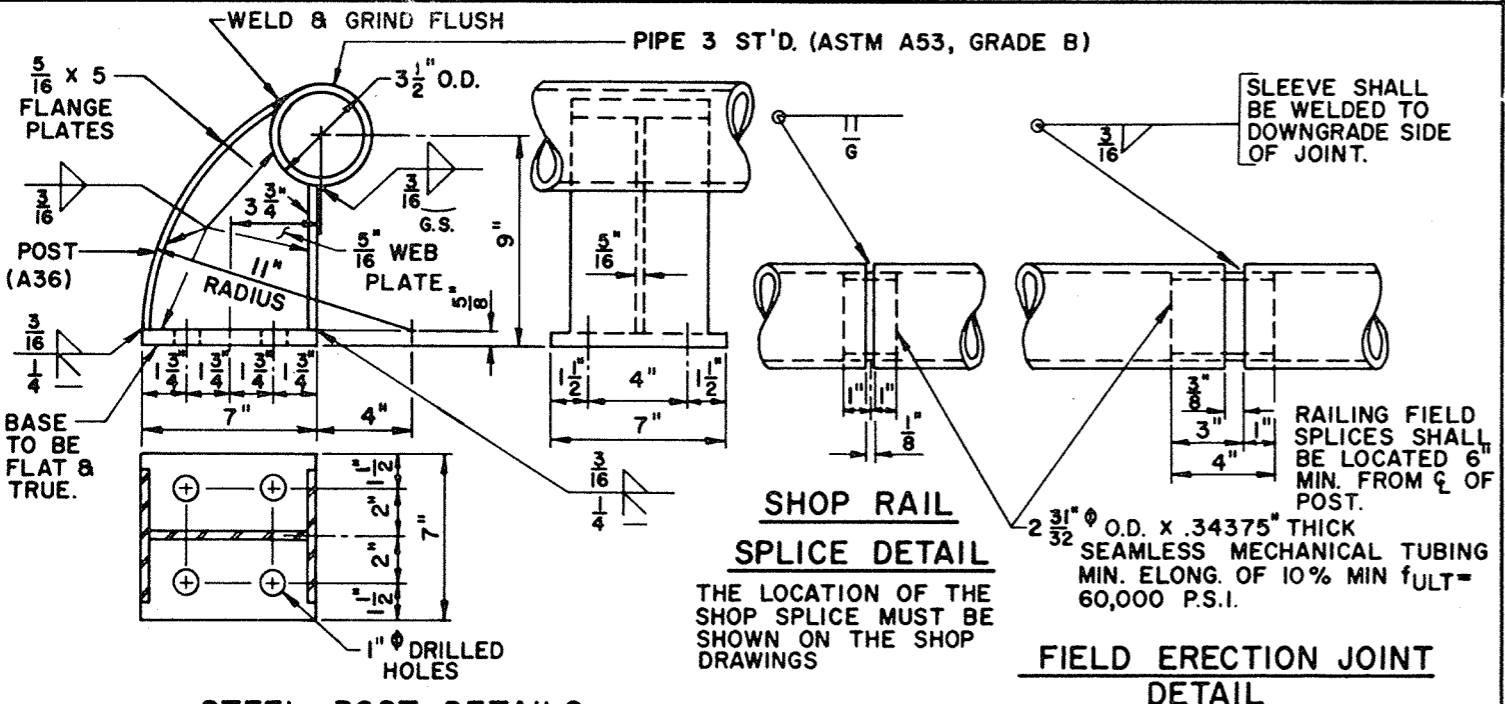


**STEEL POST DETAILS**


**NOTE:**  
 GALVANIZE ENTIRE RAILING AFTER FABRICATION INCLUDING SHIMS.

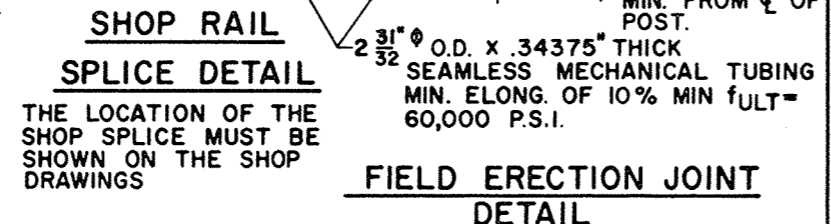


**FIELD ERECTION JOINT DETAIL**

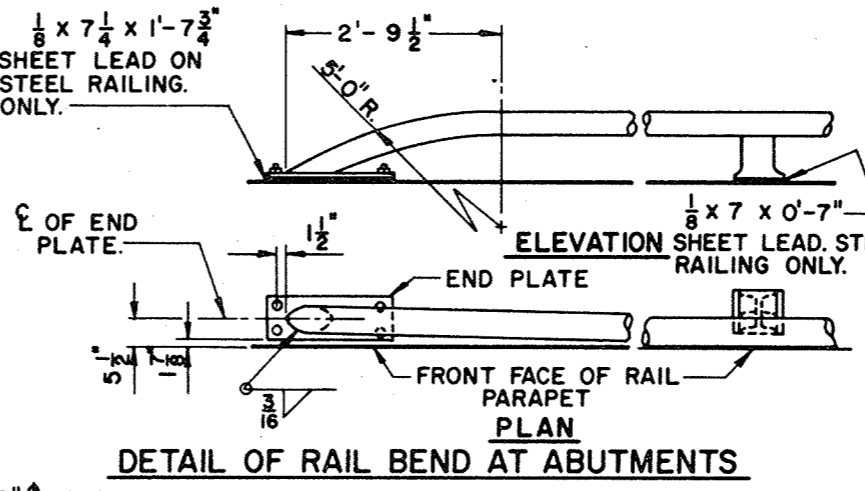


**DETAIL OF RAIL BEND AT ABUTMENTS**

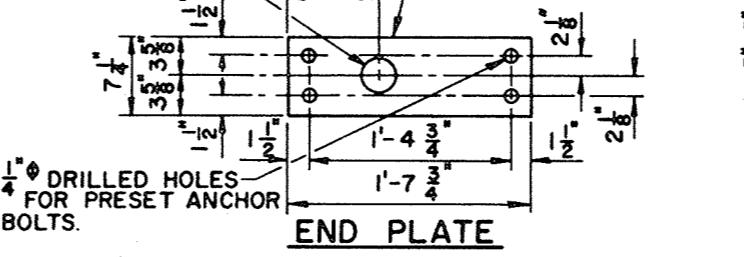


**END PLATE**

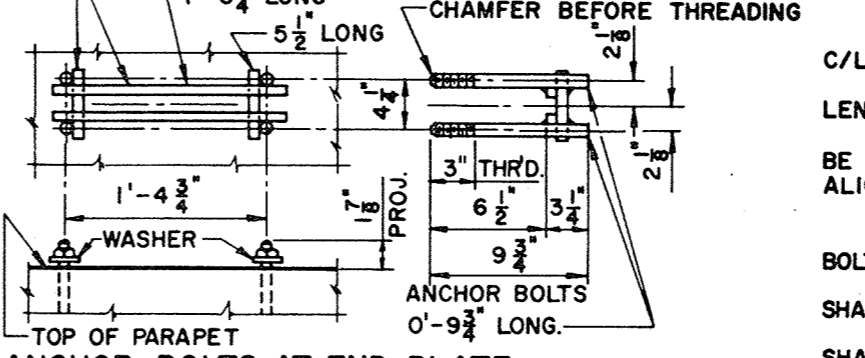


**ANCHOR BOLTS AT END PLATE**

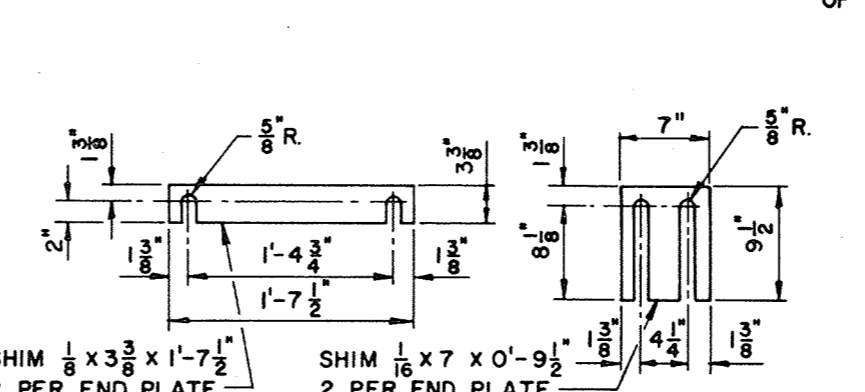

**END PLATE SHIM DETAILS**

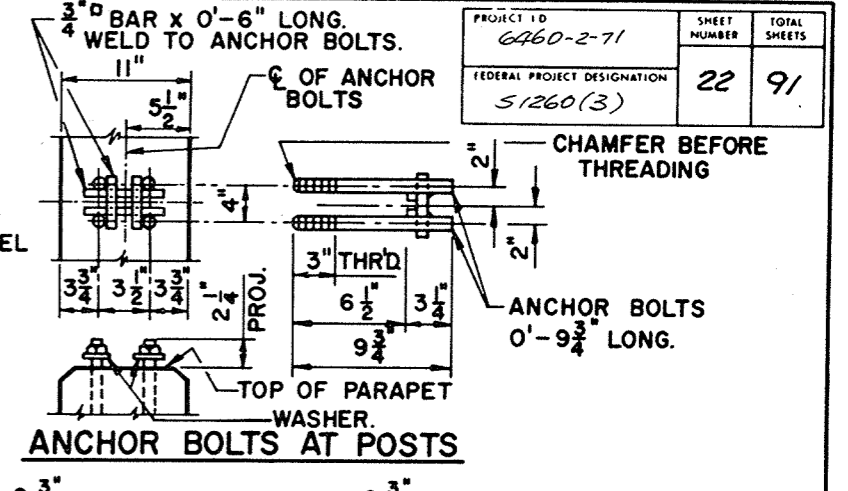


**ANCHOR BOLTS AT POSTS**

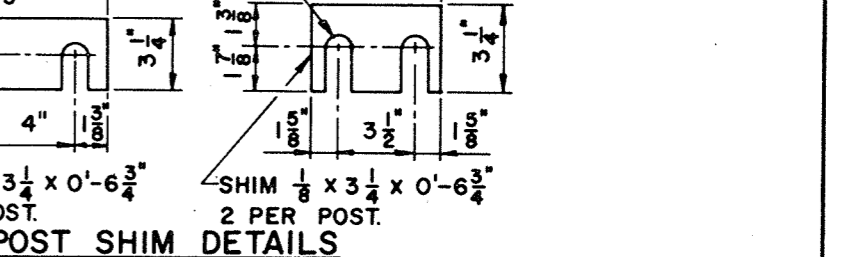

**POST SHIM DETAILS**

**GENERAL NOTES**  
 BID ITEM SHALL BE TUBULAR RAILING, TYPE 'J'.  
 ALL POST SPACINGS ARE TAKEN HORIZONTALLY ALONG C/L OF ANCHOR BOLTS.  
 RAILING SHALL BE FABRICATED IN TWO OR THREE PANEL LENGTHS.  
 SHIMS CONFORMING TO SAME MATERIAL AS POSTS SHALL BE USED UNDER POSTS AND END PLATES WHERE REQ'D FOR ALIGNMENT.  
 RAIL POSTS SHALL BE SET NORMAL TO GRADE.  
 THE SHANK AND ROOT OF THREAD DIAMETER FOR ANCHOR BOLTS SHALL BE A MIN. OF 0.62 INCHES.  
 ANCHOR BOLTS, NUTS & WASHERS FOR ALUMINUM RAILING SHALL BE STAINLESS STEEL.  
 ANCHOR BOLTS, NUTS & WASHERS FOR STEEL RAILING SHALL BE EITHER STAINLESS STEEL OR ASTM A307. IF A307 IS USED ELECTRO-GALVANIZE NUTS, WASHERS & TOP 3 1/2" OF ANCHOR BOLTS.

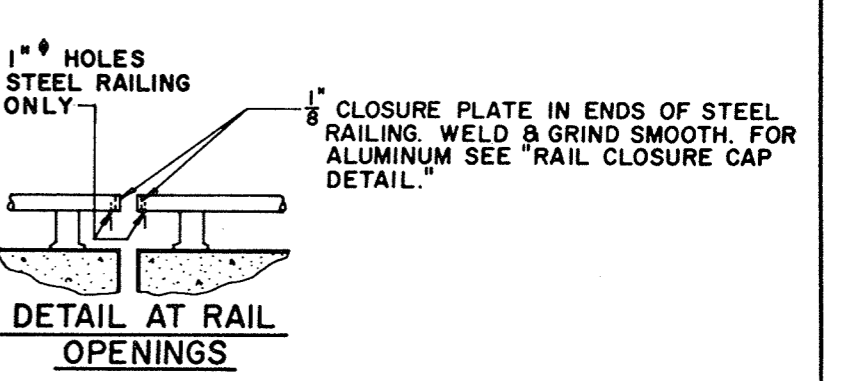

**DETAIL AT RAIL OPENINGS**

PROJECT NO.	6260-2-71	SHEET NUMBER	22	TOTAL SHEETS	91
FEDERAL PROJECT DESIGNATION	51260(3)				

No.	Date	Revision	By
STATE OF WISCONSIN DEPARTMENT OF TRANSPORTATION DIVISION OF HIGHWAYS			
<b>STRUCTURE B-70-63</b>			
Const. Spec. 1969	Drawn By SELJE	Plans Checked BMW	
<b>TUBULAR RAILING TYPE 'J'</b>			SHEET 7 OF 7
			X47287

**BENCH MARK**


NO.	STATION	DESCRIPTION	ELEV.
59	448+40	PT. MK TOP N.E. WINGWALL	20' LT. 767.20

PROJECT NO.	SHEET NUMBER	TOTAL SHEETS
6460-2-71	23	91

FEDERAL PROJECT DESIGNATION: S 1260(3)

**LIST OF DRAWINGS**

1. GENERAL PLAN	X47476
2. SUBSURFACE EXPLORATION	X47477
3. EAST & WEST ABUTMENTS	X47478
4. 45" PRESTRESSED GIRDER DETAILS	X47479
5. SUPERSTRUCTURE	X47480
6. SLOPED FACE PARAPET 'A'	X47481
7. TUBULAR RAILING TYPE 'J'	X47482

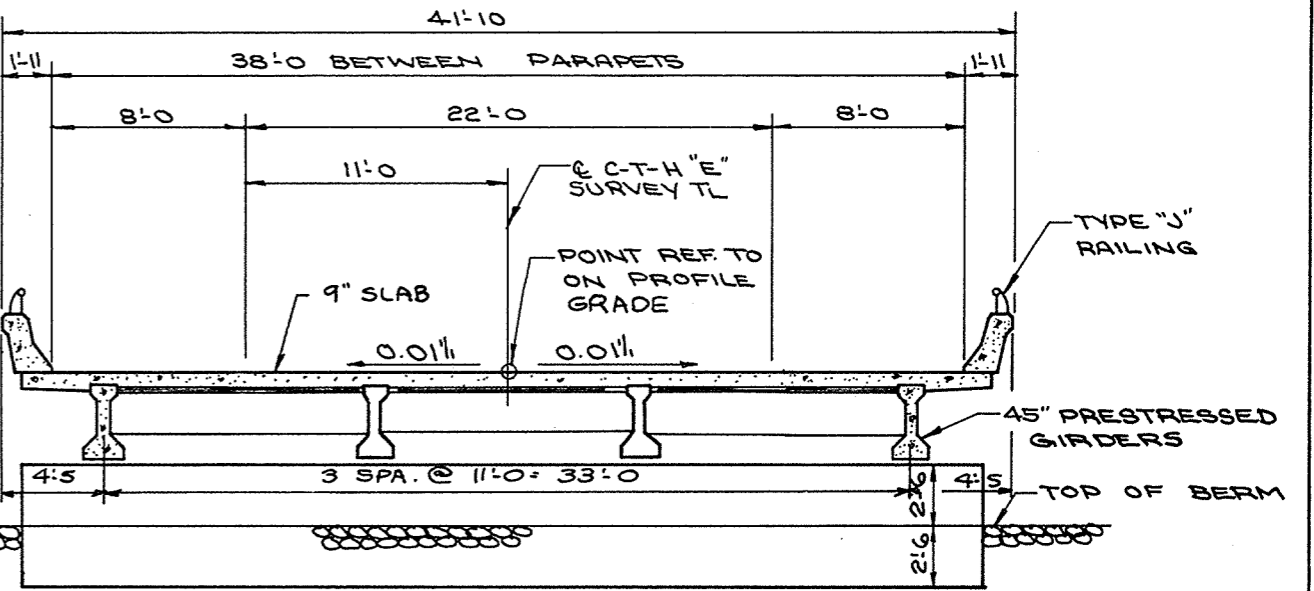

**CROSS SECTION THRU ROADWAY LOOKING EAST**

**GENERAL NOTES**

DRAWINGS SHALL NOT BE SCALED.  
 BAR STEEL REINFORCEMENT SHALL BE IMBEDDED 2" CLEAR UNLESS OTHERWISE SHOWN OR NOTED. ELASTOMERIC BEARING PADS NEED NOT BE INDIVIDUALLY MOLDED PROVIDED THE CUT EDGES ARE SMOOTH AND TRUE.  
 THE EXISTING GROUND LINE WAS USED AS THE UPPER LIMITS OF EXCAVATION FOR THE COMPUTATION OF EXCAVATION QUANTITIES.  
 AT ABUTMENTS ALL SPACES EXCAVATED AND NOT OCCUPIED BY THE NEW STRUCTURE SHALL BE BACKFILLED WITH GRANULAR BACKFILL. PAYMENT WILL BE MADE ONLY FOR MATERIAL ACTUALLY PLACED WITHIN THE LIMITS FOR EXCAVATION FOR STRUCTURES.  
 THE SLOPE OF THE FILL IN FRONT OF THE ABUTMENTS SHALL BE COVERED WITH HEAVY RIPRAP TO THE EXTENT SHOWN ON THIS SHEET AND IN THE ABUTMENT DETAILS.  
 FILLER SHALL CONFORM TO A.A.S.H.O. M 153 OR M 213.

**DESIGN DATA**

LIVE LOAD: H20  
 ALLOWABLE DESIGN STRESSES:  
 CONCRETE MASONRY, GRADE "AA" SLAB  $f'_c = 1,200$  P.S.I.  
 ALL OTHER  $f'_c = 1,400$  P.S.I.  
 BAR STEEL REINFORCEMENT  $f_s = 20,000$  P.S.I.  
 $n = 10$   
 45" PRESTRESSED GIRDERS  
 CONCRETE MASONRY  $f'_c = 6,000$  P.S.I.  
 STRANDS -  $\frac{1}{2}$ "  $\phi$  WITH ULTIMATE TENSILE STRENGTH OF 270,000 P.S.I.  
 STRUCTURE IS DESIGNED FOR FUTURE DEAD LOAD OF 20 POUNDS PER SQUARE FOOT.

**FOUNDATION DATA**

PLACE ABUTMENTS ON HP 10x42 STEEL PILING DRIVEN TO 50 TONS/PILE MINIMUM BEARING. ESTIMATED PILE LENGTH 40 FEET.

**HYDRAULIC DATA**


$Q_{50}$  1,400 C.F.S.  
 VEL. 5.4 F.P.S.  
 WATERWAY AREA 258 S.F.  
 HW EL. 763.9(1971)  
 DRAINAGE AREA 12 SQ. MI.

**TRAFFIC VOLUME**

A.D.T. 2150(1973)  
 P.D.S. 50 M.P.H.  
 D.H.V. 650(1993)


**TOTAL ESTIMATED QUANTITIES**

BID ITEMS	UNIT	SUPER.	W.ABUT.	E.ABUT.	TOTAL
REMOVING OLD BRIDGE - STA. 448+10.00	L.S.				1
EXCAVATION FOR STRUCTURES	C.Y.		42	40	82
GRANULAR BACKFILL	C.Y.		25	23	48
CONCRETE MASONRY	C.Y.	105	38	38	181
BAR STEEL REINFORCEMENT	L.B.	22,340	2,750	2,750	27,840
PRESTRESSED GIRDER, I TYPE, 45 INCH	L.F.	246			246
STRUCTURAL CARBON STEEL	L.B.	430			430
BEARING PADS, ELASTOMERIC	S.F.	10			10
STEEL PILING, DELIVERED & DRIVEN, HP 10 INCH x 42 POUND	L.F.		320	320	640
TUBULAR RAILING, TYPE 'J'	L.F.	157			157
HEAVY RIPRAP	C.Y.		103	107	210
<b>NON - BID ITEMS</b>					
FILLER	SIZE	$\frac{1}{4}$ " to $\frac{3}{4}$ "			$\frac{1}{4}$ " to $\frac{3}{4}$ "
$\frac{1}{8}$ " ALUMINUM OR ZINC PLATE	S.F.	18			18
POLYVINYL CHLORIDE WATERSTOP	L.F.		38	38	76

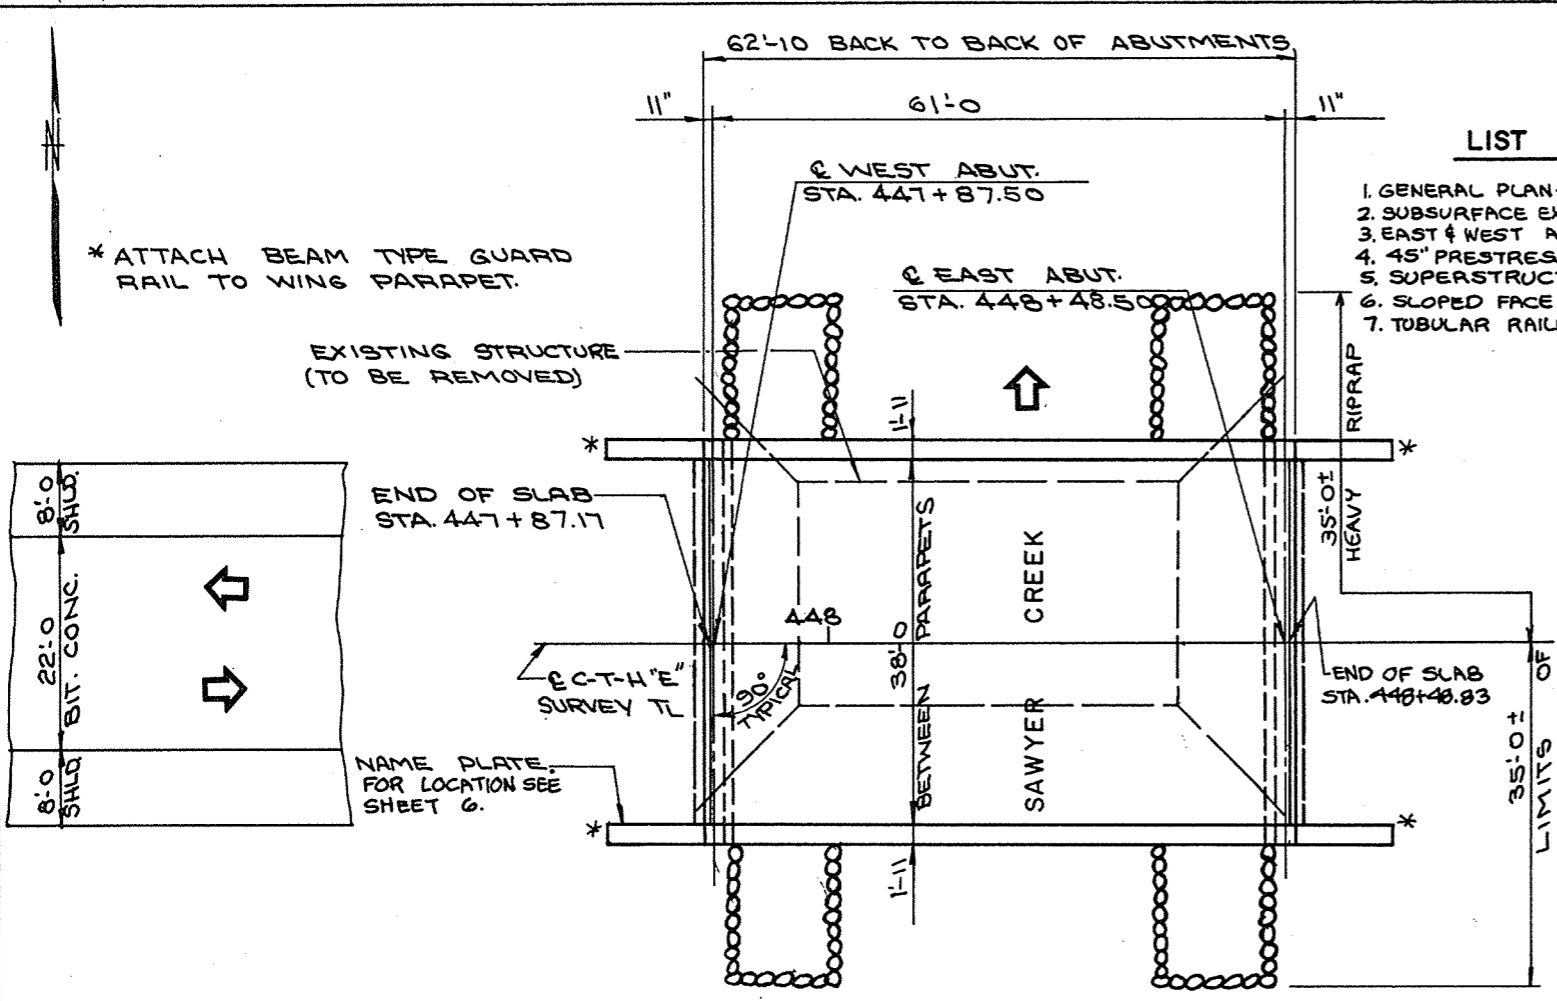


**PLAN LAYOUT B-70-64**

SINGLE SPAN - 45" PRESTRESSED GIRDER

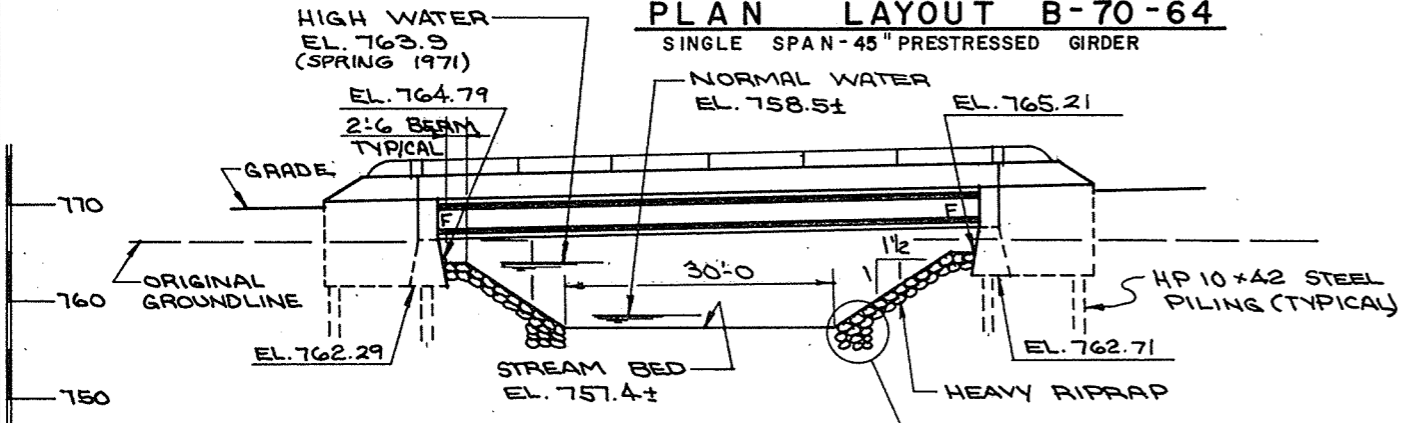


**ELEVATION**

NORMAL TO SAWYER CREEK

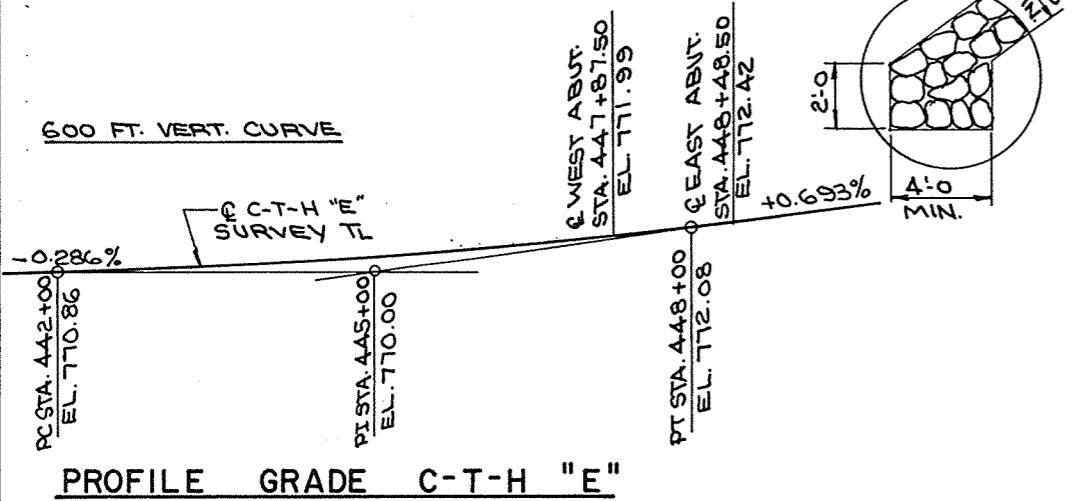

**PROFILE GRADE C-T-H "E"**

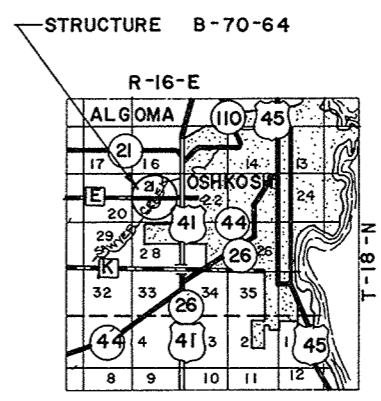

**LAYOUT**

No.	Date	Revision	By

STATE OF WISCONSIN  
 DEPARTMENT OF TRANSPORTATION  
 DIVISION OF HIGHWAYS


**STRUCTURE B-70-64**  
 C-T-H "E" OVER SAWYER CREEK

County WINNEBAGO City/Township TN: ALGOMA  
 Design Spec. A.A.S.H.O. 1969 Load H 20 Const. Spec. 1969  
 Designed By CRH Design Checked JRL Drawn By DB Plans Checked B.W.

Approved *W.A. Kline* 4-28-72  
 Chief Bridge Engineer Date

**GENERAL PLAN** SHEET 1 OF 7  
 X 47476

PROJECT NO. 6460-2-71	SHEET NUMBER 24	TOTAL SHEETS 91
FEDERAL PROJECT DESIGNATION 51260(3)		


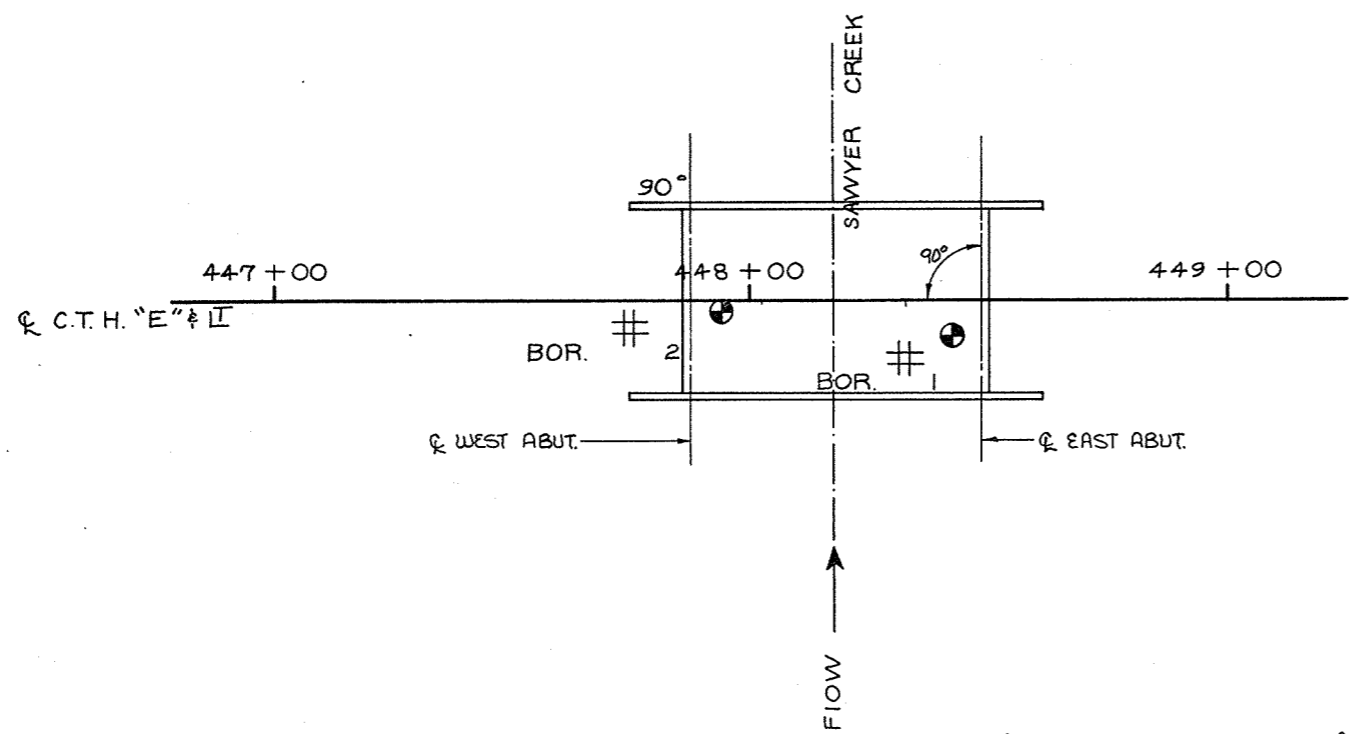


**ABBREVIATIONS**

F — Fine      M — Medium      C — Coarse  
 Ws — Weathered      So — Sound

**MATERIAL SYMBOLS**


Topsoil	Silt	Sandstone
Sand	Peat	Limestone
Gravel	Clay	Igneous Rock

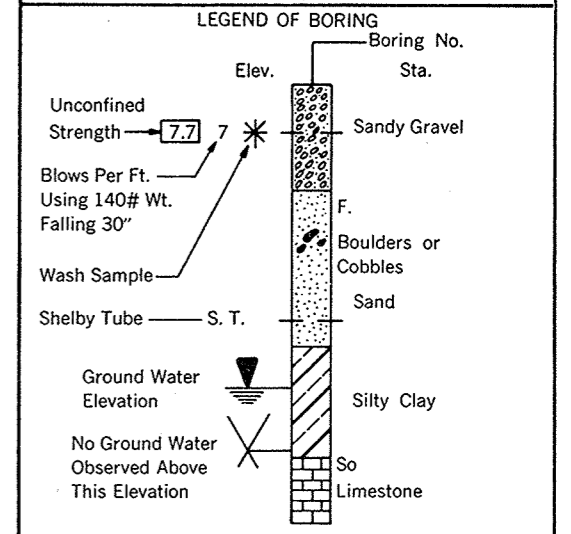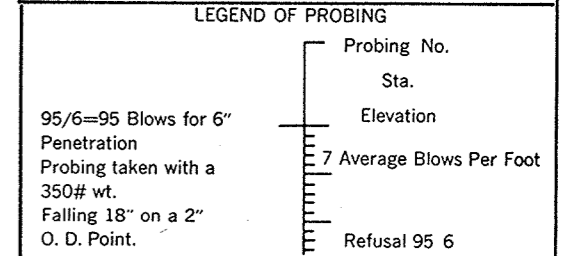

Unless otherwise specified, the blows per foot at the locations indicated are based on driving a 2" O. D. x 1.4" I. D. split spoon sampler with a 140# hammer having a free fall of 30". The blow count is taken in undisturbed soil immediately below a cased or open hole eliminating side friction on the drive pipe.

**SUBSURFACE EXPLORATION FOR FOUNDATION DESIGN AND BIDDERS INFORMATION**


To obtain relative data concerning the character of material in and upon which the foundation might be built, borings and/or soundings were made at points approximately as indicated on this drawing. The data presented herein represents the findings of the subsurface explorations made. However, because the depths investigated are limited and the area of the borings and/or soundings is very small in relation to the entire area, the Division of Highways does not warrant conditions below the depths investigated or that the classification of material encountered in these investigations is necessarily typical of the entire site.

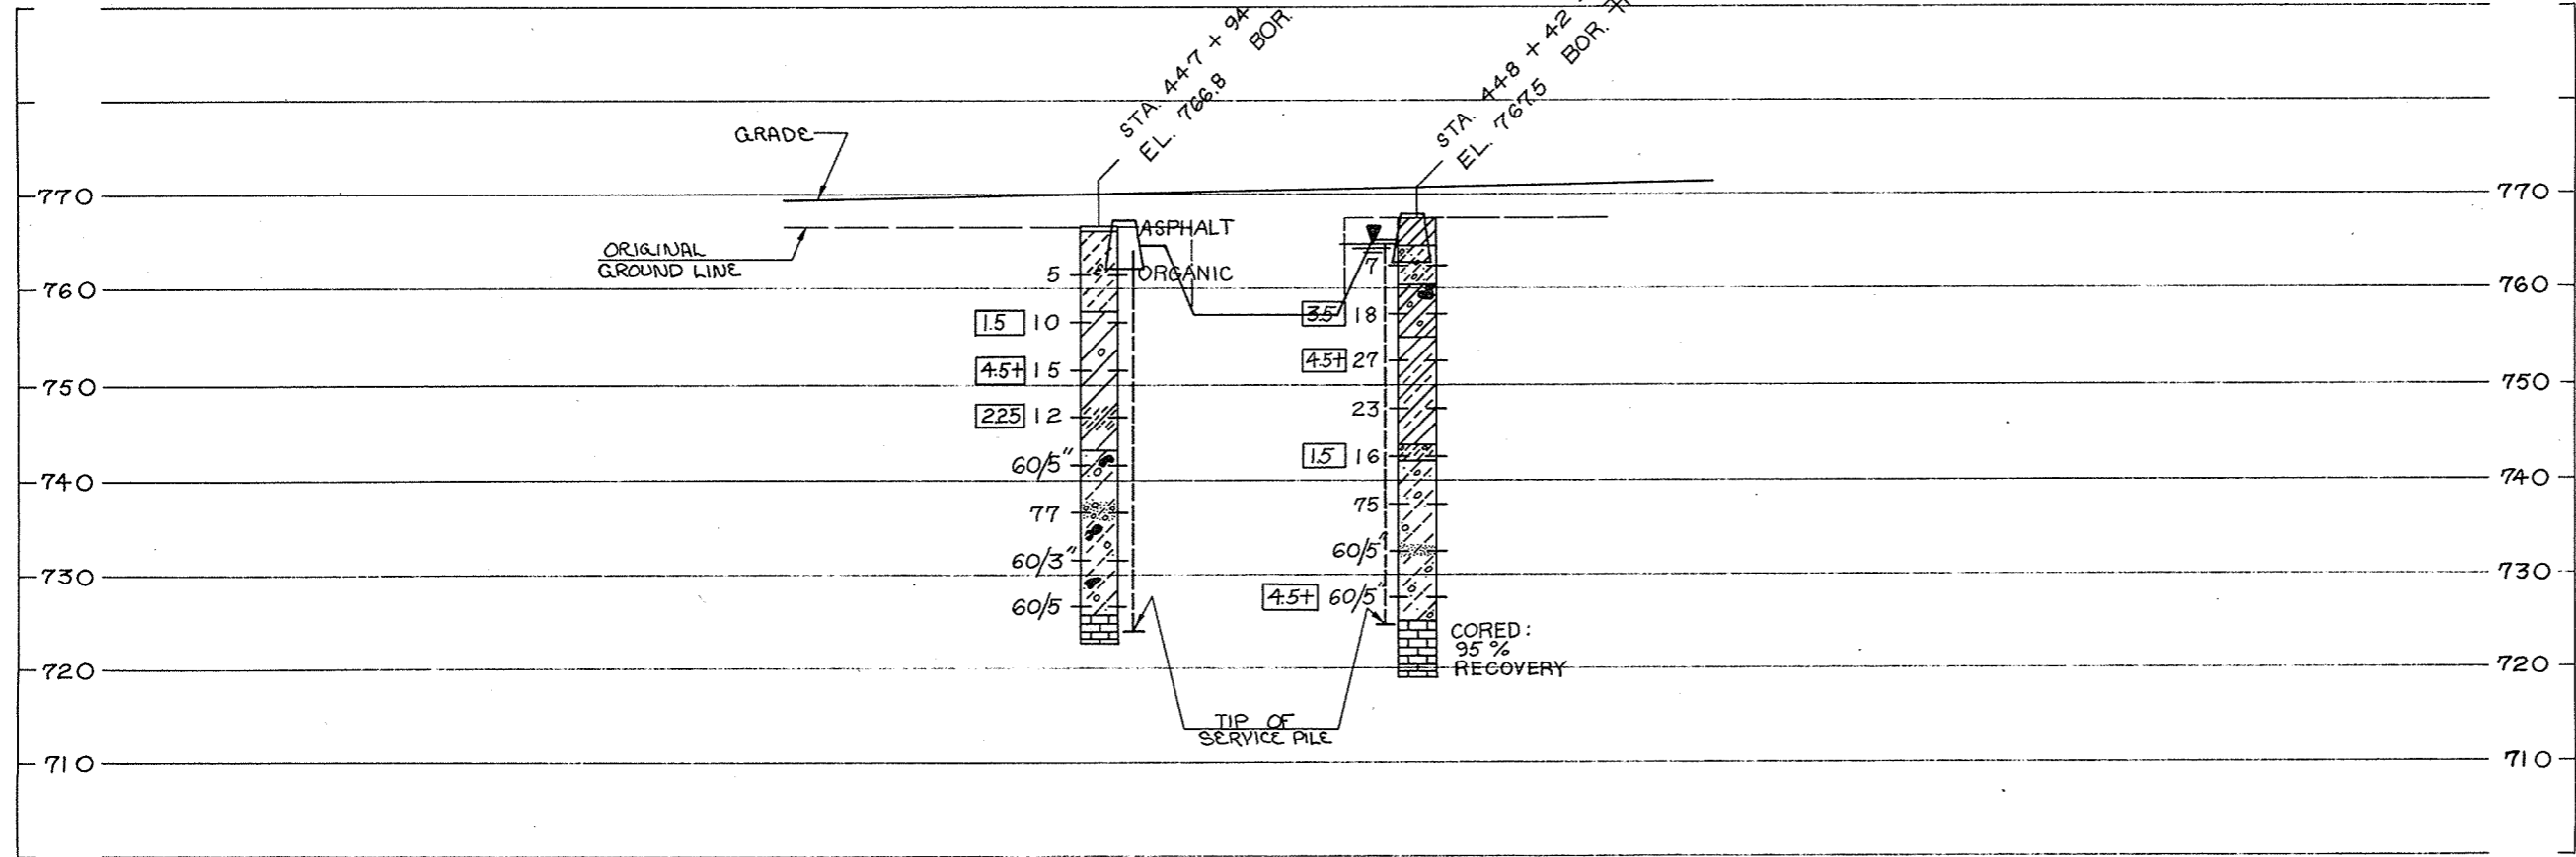


No.	Date	Revision	By
STATE OF WISCONSIN DEPARTMENT OF TRANSPORTATION DIVISION OF HIGHWAYS			
<b>STRUCTURE B-70-64</b>			
Const. Spec. 1969	Drawn By R.W.A.	Plans Checked B.W.	
<b>SUBSURFACE EXPLORATION</b>			SHEET 2 OF 7 X 47477






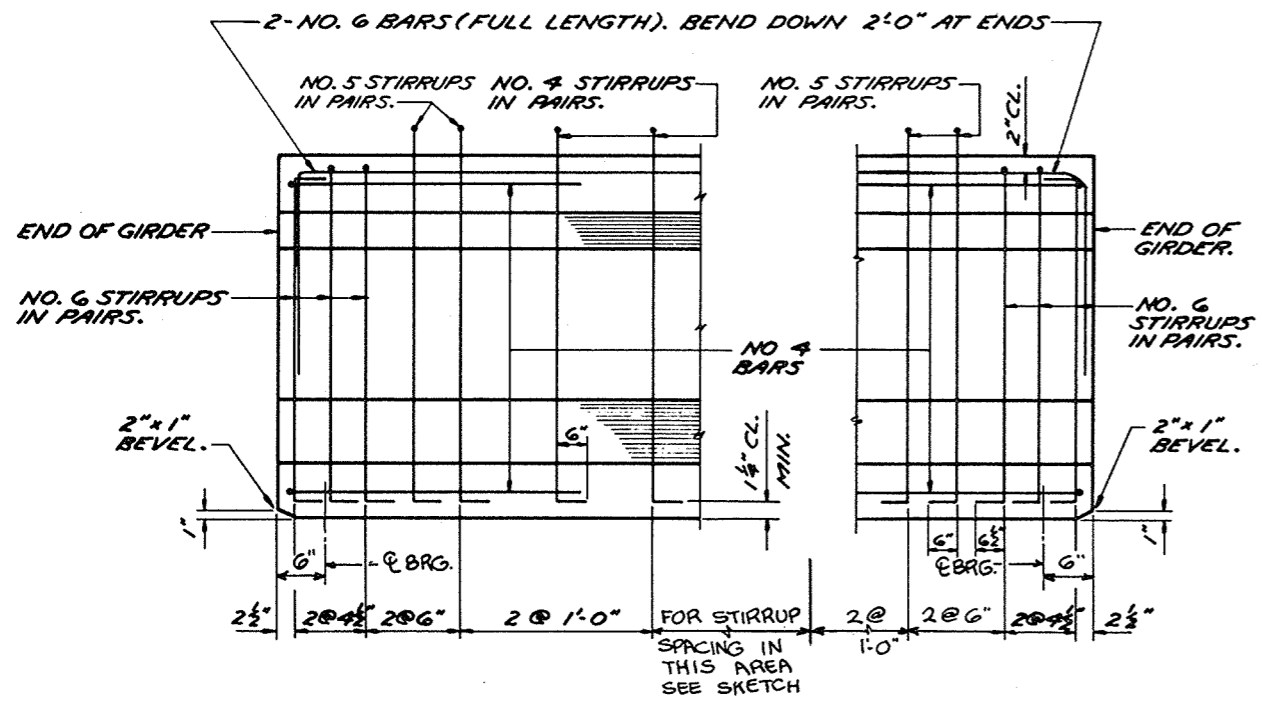


**SIDE VIEW OF GIRDER**

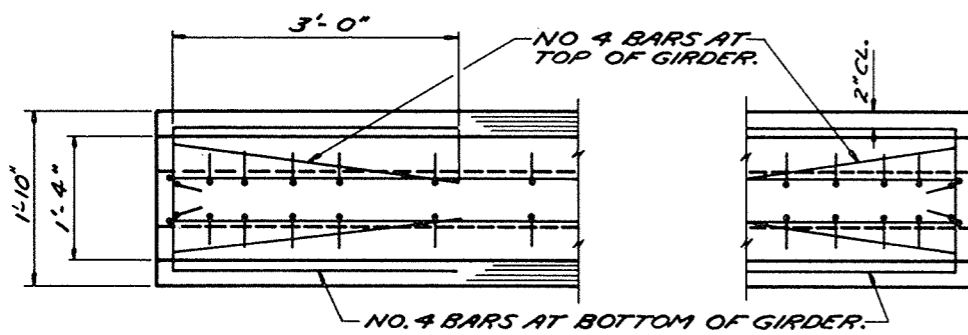


**TOP VIEW OF GIRDER**

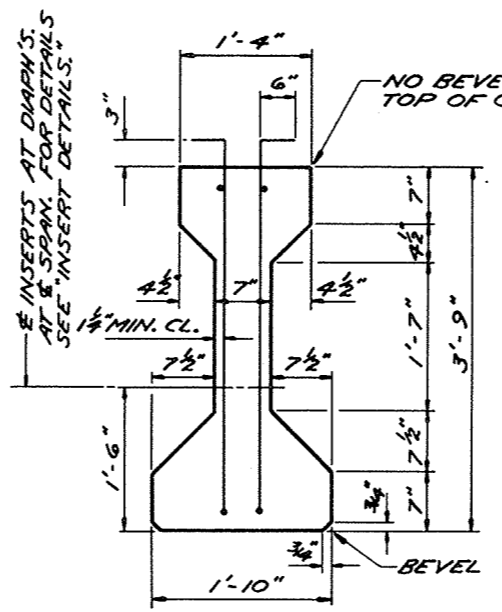


**SECTION THRU GIRDER**

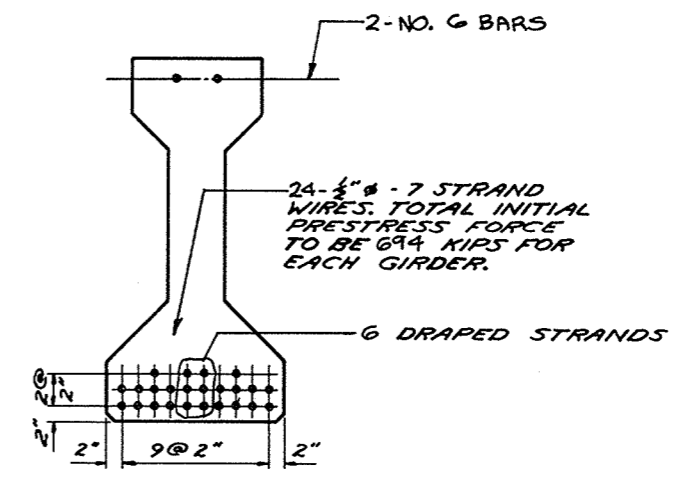


**SECTION THRU GIRDER TAKEN @ 1/2 OF SPAN**

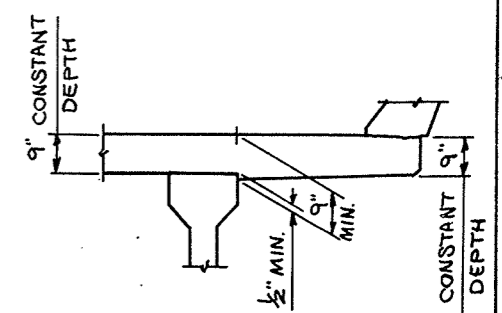

**SLAB FORMING DETAIL AT EXTERIOR GIRDER**

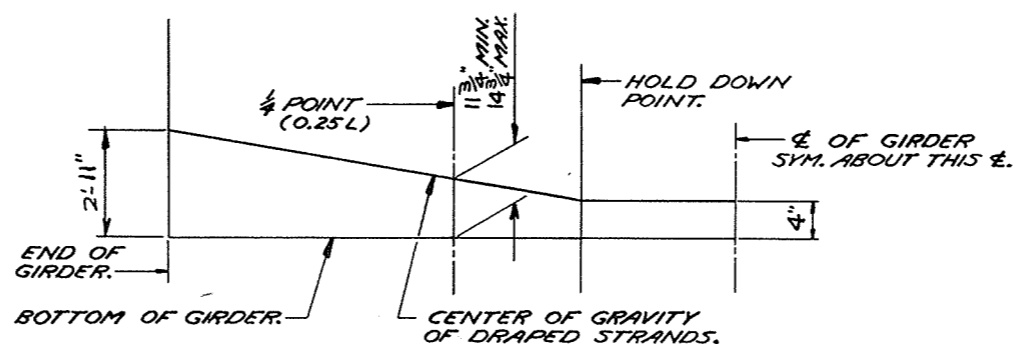

**DRAPED STRAND PROFILE**

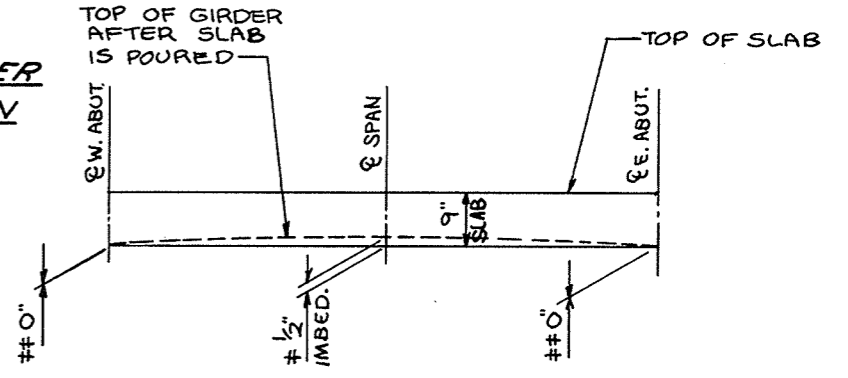


**SLAB FORMING DIAGRAM**

‡ TO COMPENSATE FOR VARIATIONS IN PRESTRESS CAMBER AND OTHER MINOR CONSTRUCTION DISCREPANCIES THE IMBEDMENT AT THE 1/2 OF SPAN MAY BE VARIED WITH A MAXIMUM OF 1/2" ALLOWABLE IMBEDMENT AND THE SLAB HELD TO PLAN THICKNESS. †† IF VARIATIONS IN PRESTRESS CAMBER AND OTHER CONSTRUCTION DISCREPANCIES ARE OF SUCH A MAGNITUDE SO THAT THE MAXIMUM ALLOWABLE IMBEDMENT AS NOTED ABOVE WILL BE EXCEEDED, THESE DIMENSIONS WILL BE REVISED. THE 1/2" IMBEDMENT AND THE PLAN SLAB THICKNESS WILL BE HELD WHILE THE GRADE LINE WILL BE REVISED.

MINIMUM CYLINDER STRENGTH OF CONCRETE AT TIME OF TRANSFER OF PRE-STRESS FORCE  $f_{ci}$  (psi).

GIRDER TYPE	STRENGTH
DRAPED PATTERN	4,800
SPREAD PATTERN	

2-1" I.D. SLEEVE INSERTS AT 6" CENTERS PLACED SYMMETRICAL ABOUT 1/2 DIAPH. IN SPANS.

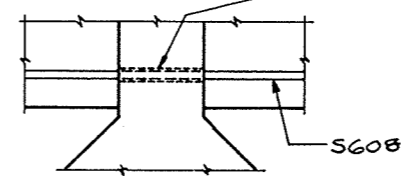


**INTERIOR GIRDER**

**GENERAL NOTES**

TOP OF GIRDERS TO BE ROUGH FLOATED AND BROOMED TRANSVERSELY FOR BONDING TO SLAB. THE GIRDER MANUFACTURER SHALL PROVIDE A SUITABLE LIFTING DEVICE FOR HANDLING AND ERECTING THE GIRDERS.

ALL GIRDERS SHALL BE CAST FULL LENGTH AS SHOWN. WIRES SHALL BE FLUSH WITH END OF GIRDERS.

PRESTRESSING WIRES SHALL HAVE AN ULT. STRENGTH OF 270,000 psi.

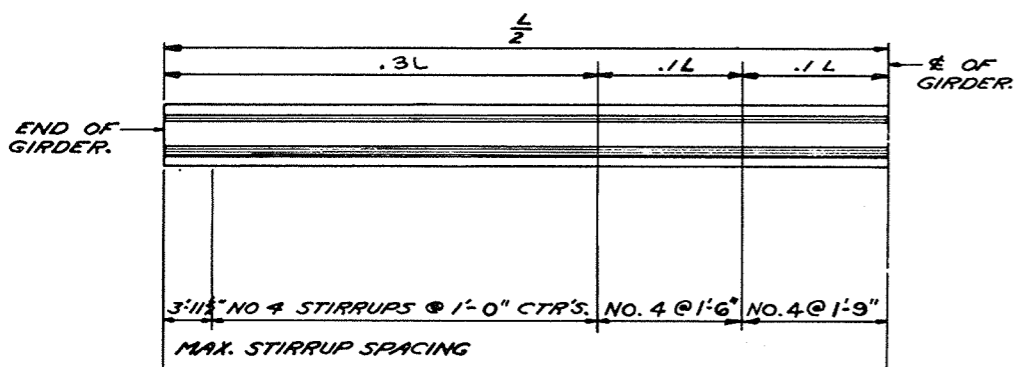

**SKETCH SHOWING MAXIMUM STIRRUP SPACING**


ALL STIRRUPS TO BE IN PAIRS AS SHOWN ABOVE. THE LOCATION OF STIRRUPS SHALL BE SUBMITTED FOR APPROVAL ON THE SHOP DRAWINGS. THE OVERALL LENGTH OF GIRDERS "L" IS 61'-4".

**DEFLECTION DATA**

CAMBER	
* A - PRE-STRESS CAMBER	1 1/8"
* B - DEAD LOAD DEFLECTION	5/8"
* C - RESIDUAL CAMBER	1/2"

\* PRE-STRESS CAMBER AND DEAD LOAD DEFLECTION DATA SHOWN ARE THEORETICAL AND MAY VARY WITH CONCRETE STRENGTH, VARIABLE PRESTRESSING CONDITIONS AND PRE-STRESS LOSSES.


NO. 4 TIE BARS (3'-0" LG.) FASTEN TO STIRRUPS.

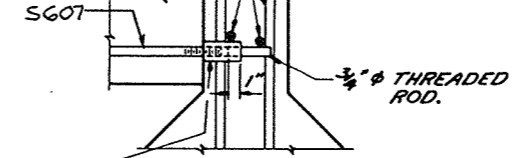

**EXTERIOR GIRDER INSERT DETAILS**

No.	Date	Revision	By
STATE OF WISCONSIN DEPARTMENT OF TRANSPORTATION DIVISION OF HIGHWAYS			
STRUCTURE B-70-64			
Const. Spec.	1969	Drawn By DB	Plans Checked B.W.
45" PRESTRESSED GIRDER DETAILS			SHEET 4 OF 7 X 47479




PROJECT ID 6460-2-71	SHEET NUMBER 27	TOTAL SHEETS 91
FEDERAL PROJECT DESIGNATION S 1260(3)		

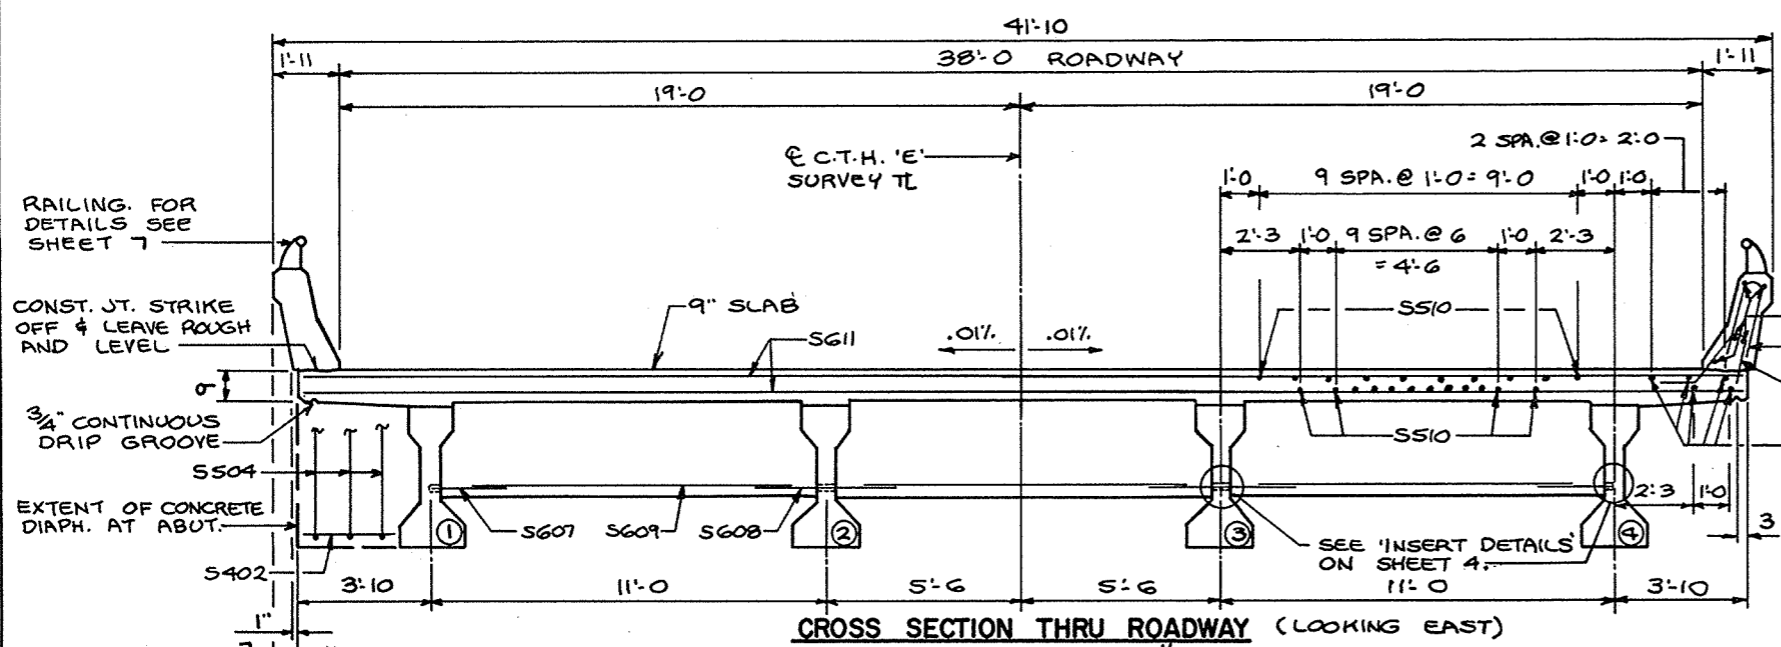



**BILL OF BARS** **22,340\***

MARK	NO.	LENGTH	BENT	LOCATION
S401	12	20-9		ABUT. DIAPH. - HORIZ.
S402	12	2-7		ABUT. DIAPH. - HORIZ.
S403	18	8-10		ABUT. DIAPH. - HORIZ.
S504	66	9-11	X	ABUT. DIAPH. - VERT.
S505	66	4-8	X	ABUT. DIAPH. - VERT.
S506	132	2-0		ABUT. DIAPH.
S607	4	2-0		DIAPH. AT MID-SPAN
S608	4	4-0		DIAPH. AT MID-SPAN
S609	6	10-0		DIAPH. AT MID-SPAN
SS10	152	31-4		SLAB - LONGIT. - TOP & BOTTOM
SG11	227	40-4		SLAB - TRANS. - TOP & BOTTOM
SS12	126	4-9	X	SLAB & RAIL PARAPET
SS13	126	5-0	X	RAIL PARAPET
SS14	10	15-8		RAIL PARAPET
SS15	10	19-10		RAIL PARAPET
SS16	10	9-9		RAIL PARAPET
SS17	10	15-10		RAIL PARAPET

**NOTE:**  
BOTTOM TRANS. BARS IN SLAB SHALL BE SUPPORTED BY CONTINUOUS BAR CHAIRS ON OR ADJACENT TO EACH GIRDER AND BY INDIVIDUAL BAR CHAIRS AT 3'-0" CENTERS AT APPROX. THE 1/3 POINTS BETWEEN GIRDERS.  
TOP LONGIT. BAR STEEL SHALL BE SUPPORTED BY CONTINUOUS BAR CHAIRS AT APPROX. 4'-0" CENTERS.

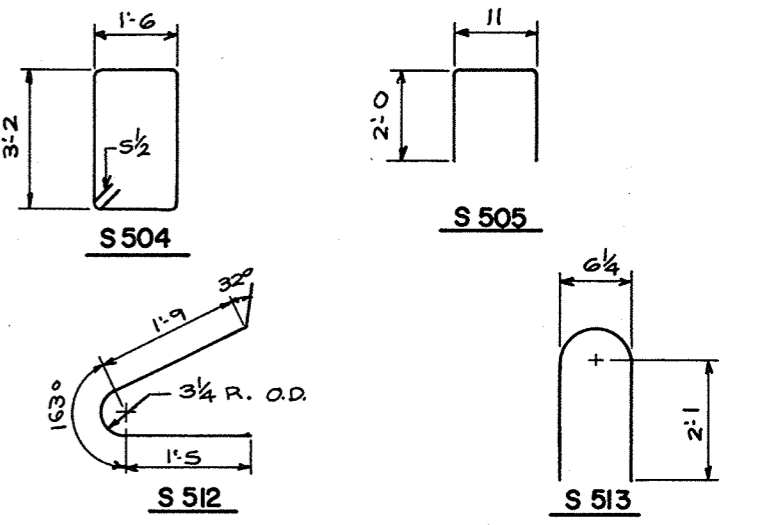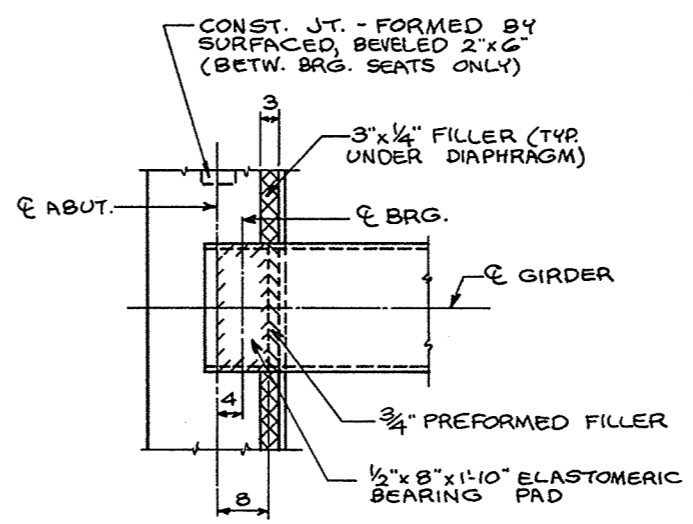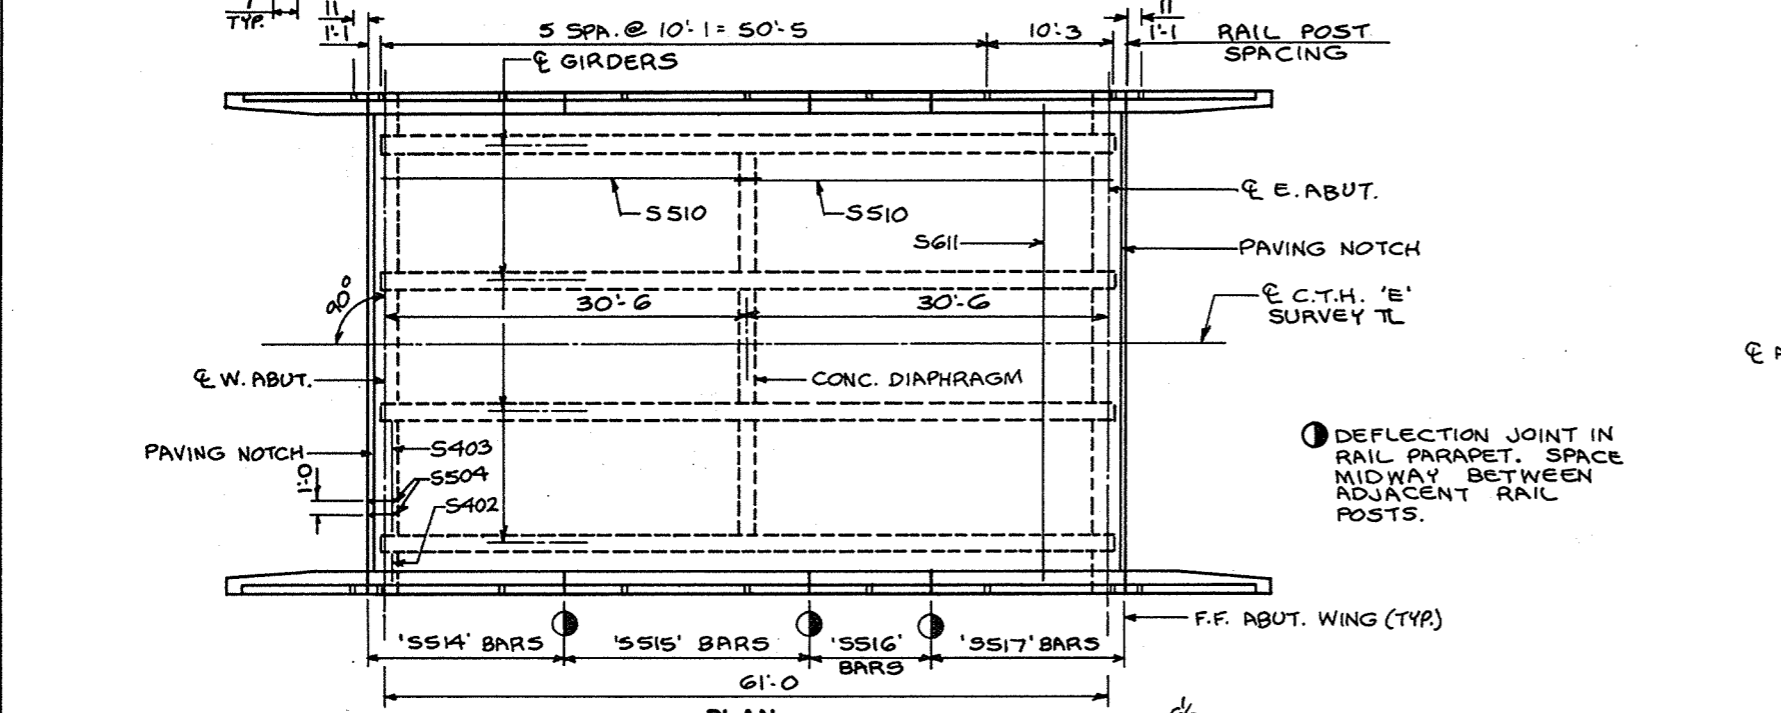

**NOTE:**  
THE FIRST DIGIT OF A MARK SIGNIFIES THE BAR SIZE.  
ALL BENDING DIMENSIONS ARE OUT TO OUT OF BAR.  
\* 3/4"  $\phi$  PLAIN BAR. THREAD ONE END 3".




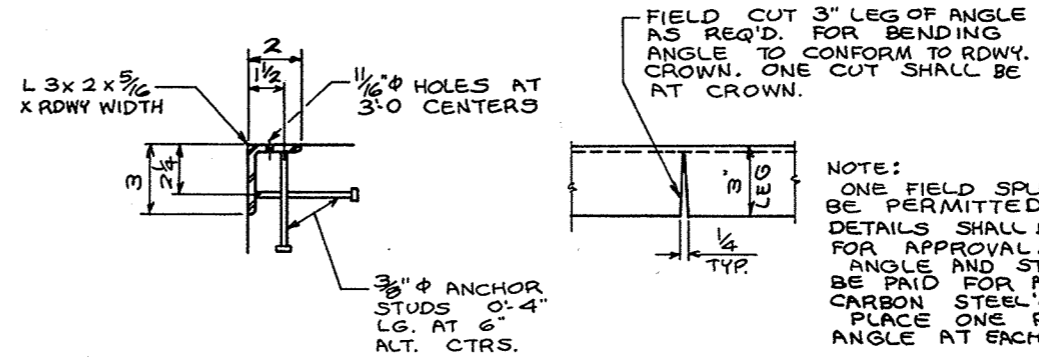
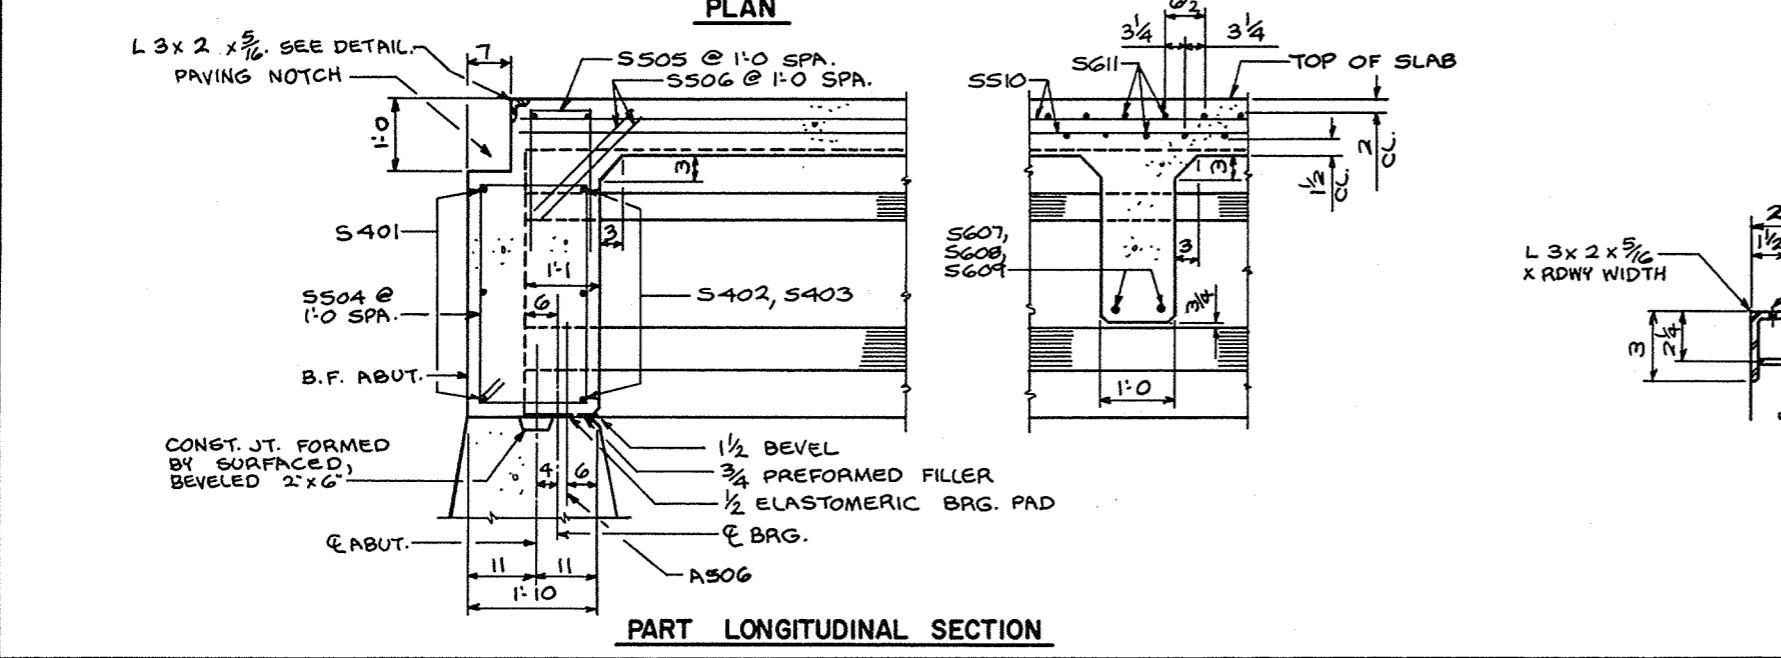


**NOTE:**  
ONE FIELD SPICE SHALL BE PERMITTED, IF USED, DETAILS SHALL BE SUBMITTED FOR APPROVAL.  
ANGLE AND STUDS SHALL BE PAID FOR AS STRUCTURAL CARBON STEEL.  
PLACE ONE PROTECTION ANGLE AT EACH ABUTMENT.

No.	Date	Revision	By
STATE OF WISCONSIN DEPARTMENT OF TRANSPORTATION DIVISION OF HIGHWAYS			
<b>STRUCTURE B-70-64</b>			
Const. Spec.	1969	Drawn By	DB
		Plans Checked	B.W.
<b>SUPERSTRUCTURE</b>			SHEET 5 OF 7
			X 47480





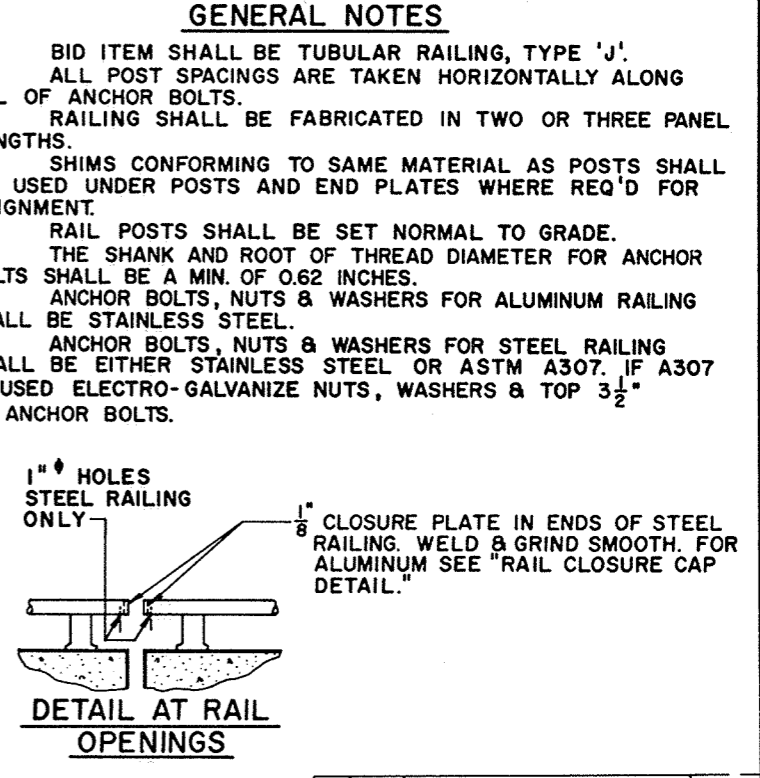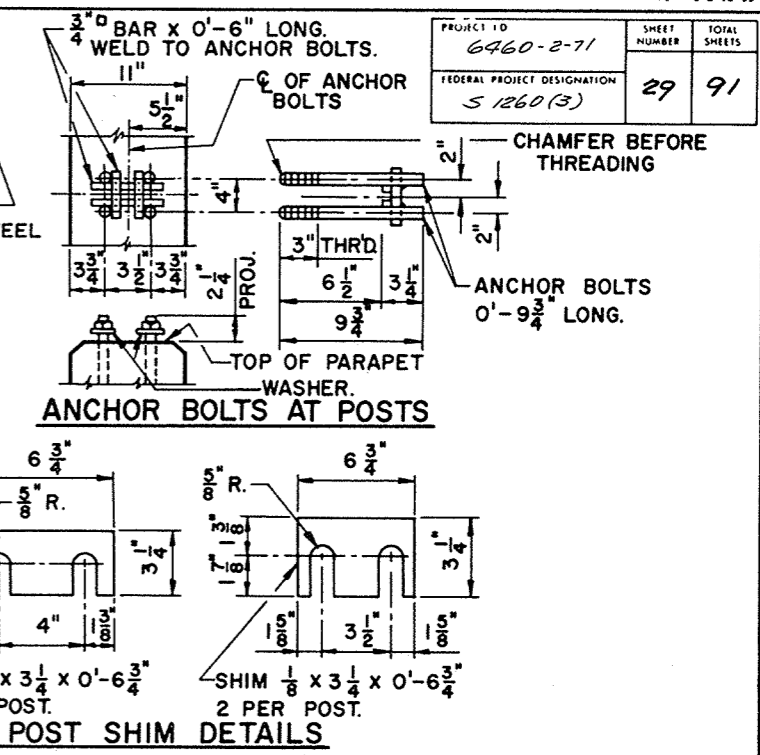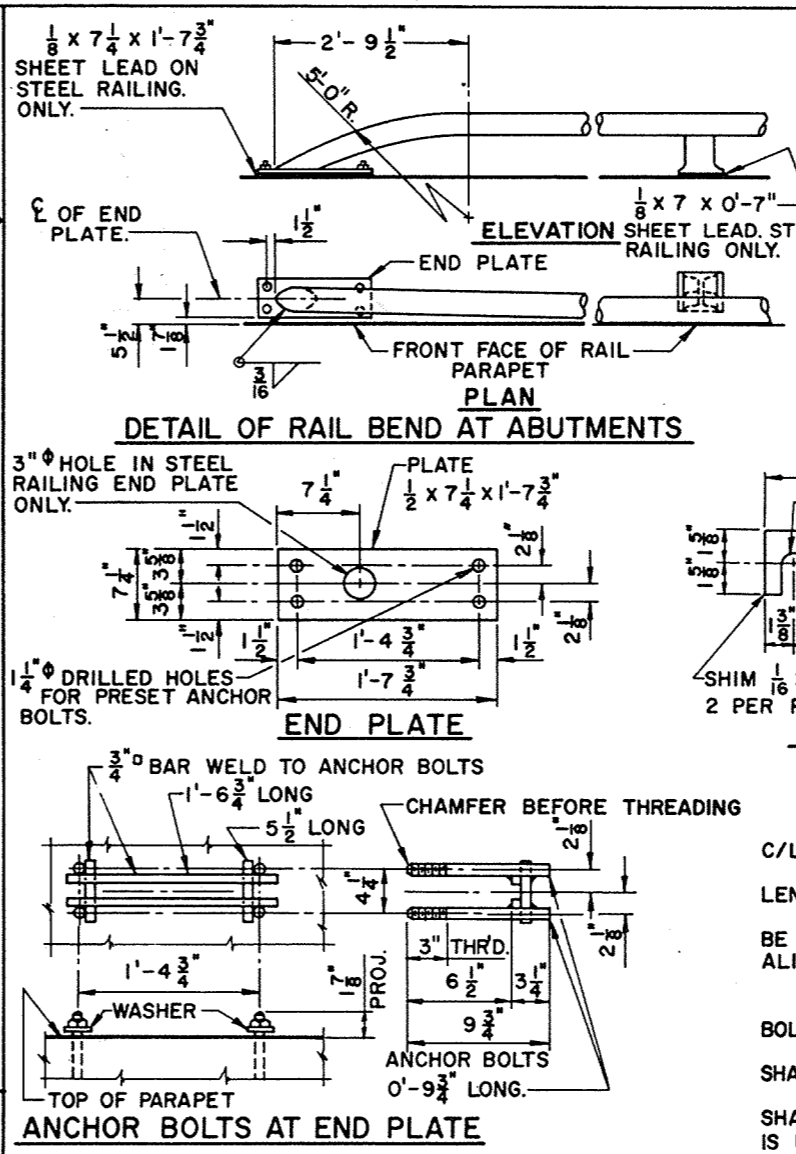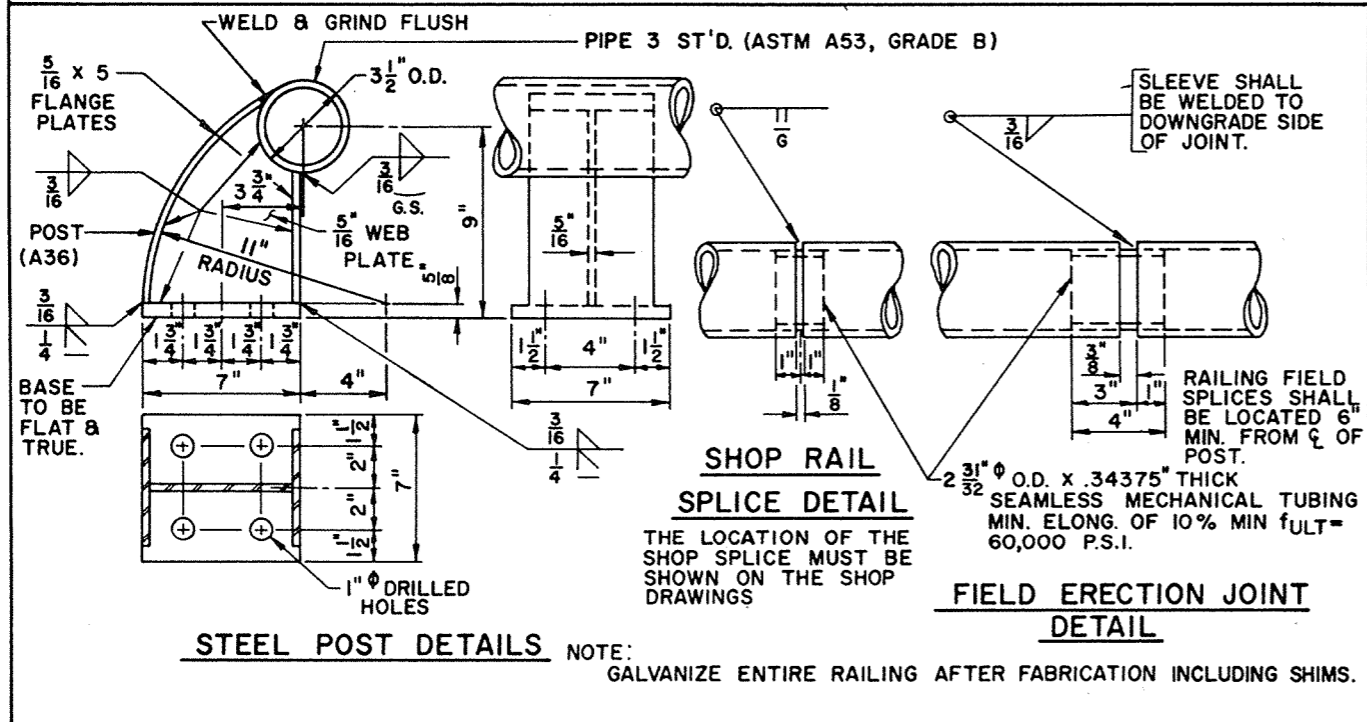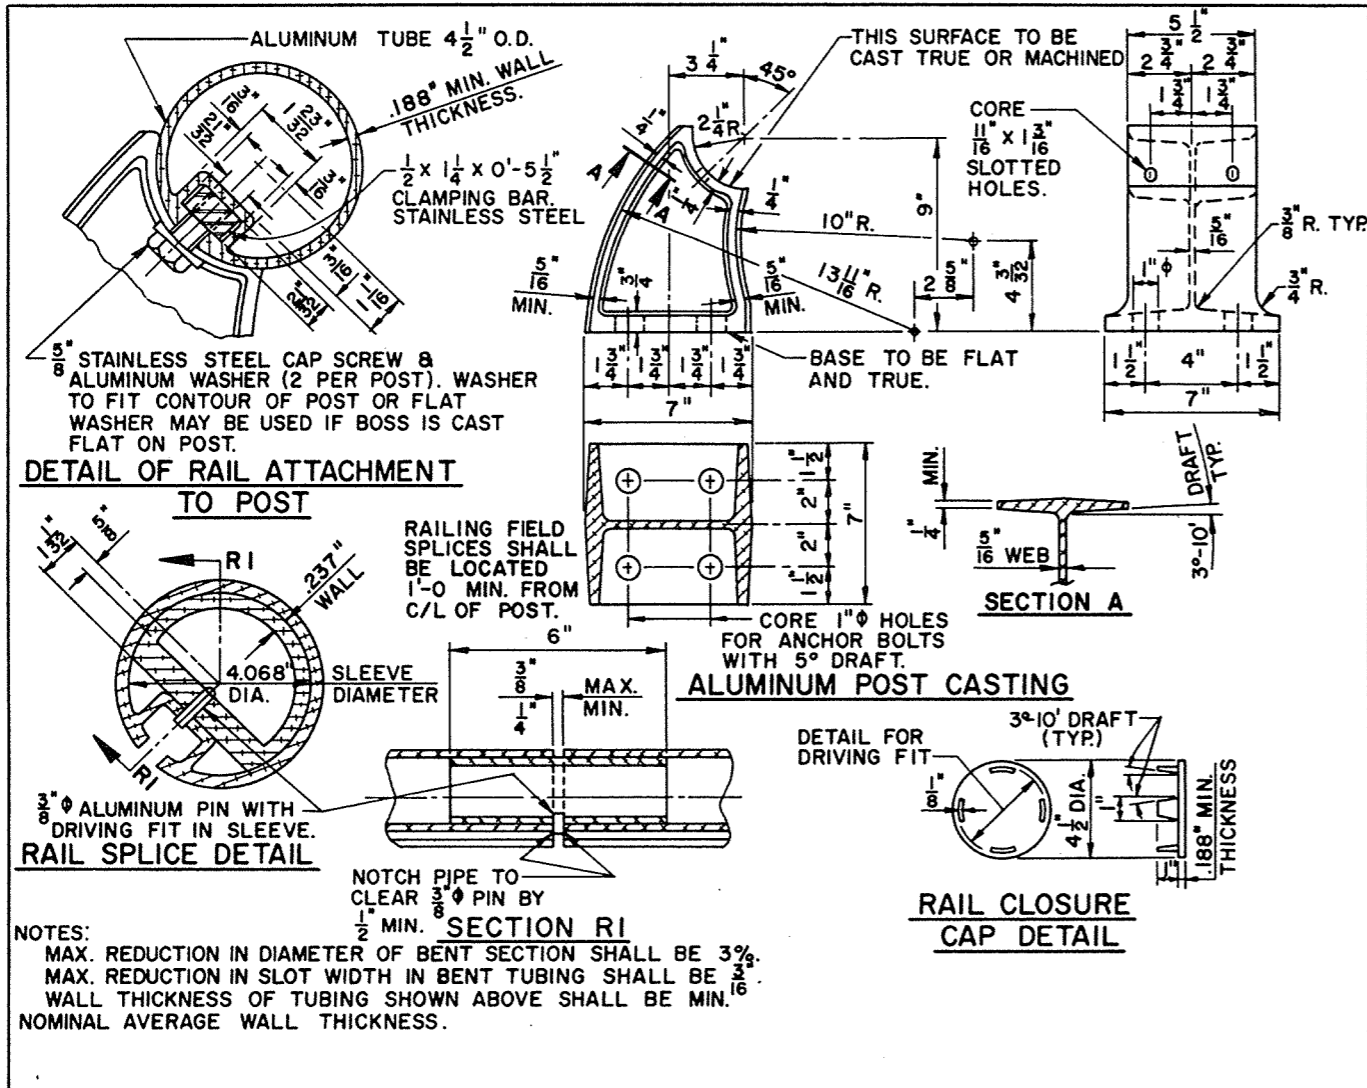

PROJECT ID 6460-2-71	SHEET NUMBER 29	TOTAL SHEETS 91
FEDERAL PROJECT DESIGNATION 5 1260(3)		

No.	Date	Revision	By
STATE OF WISCONSIN DEPARTMENT OF TRANSPORTATION DIVISION OF HIGHWAYS			
<b>STRUCTURE B-70-64</b>			
Const. Spec. 1969	Drawn By R.W.A.	Plans Checked B.W.	
<b>TUBULAR RAILING TYPE 'J'</b>			SHEET 7 OF 7 X 47482